

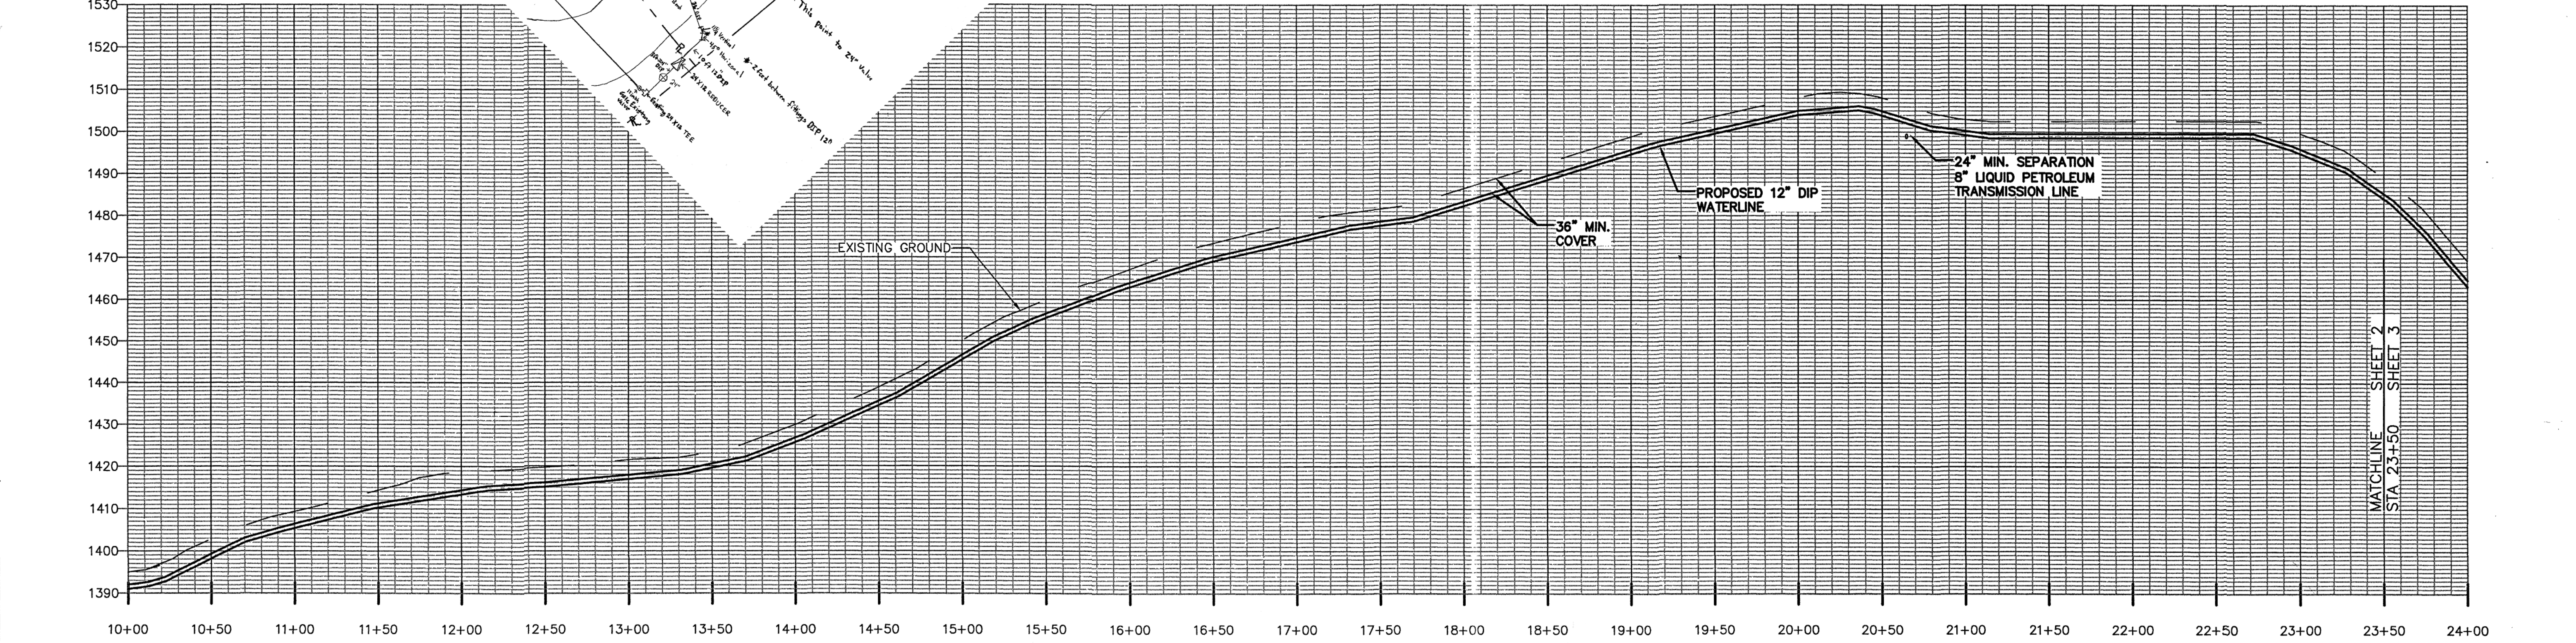


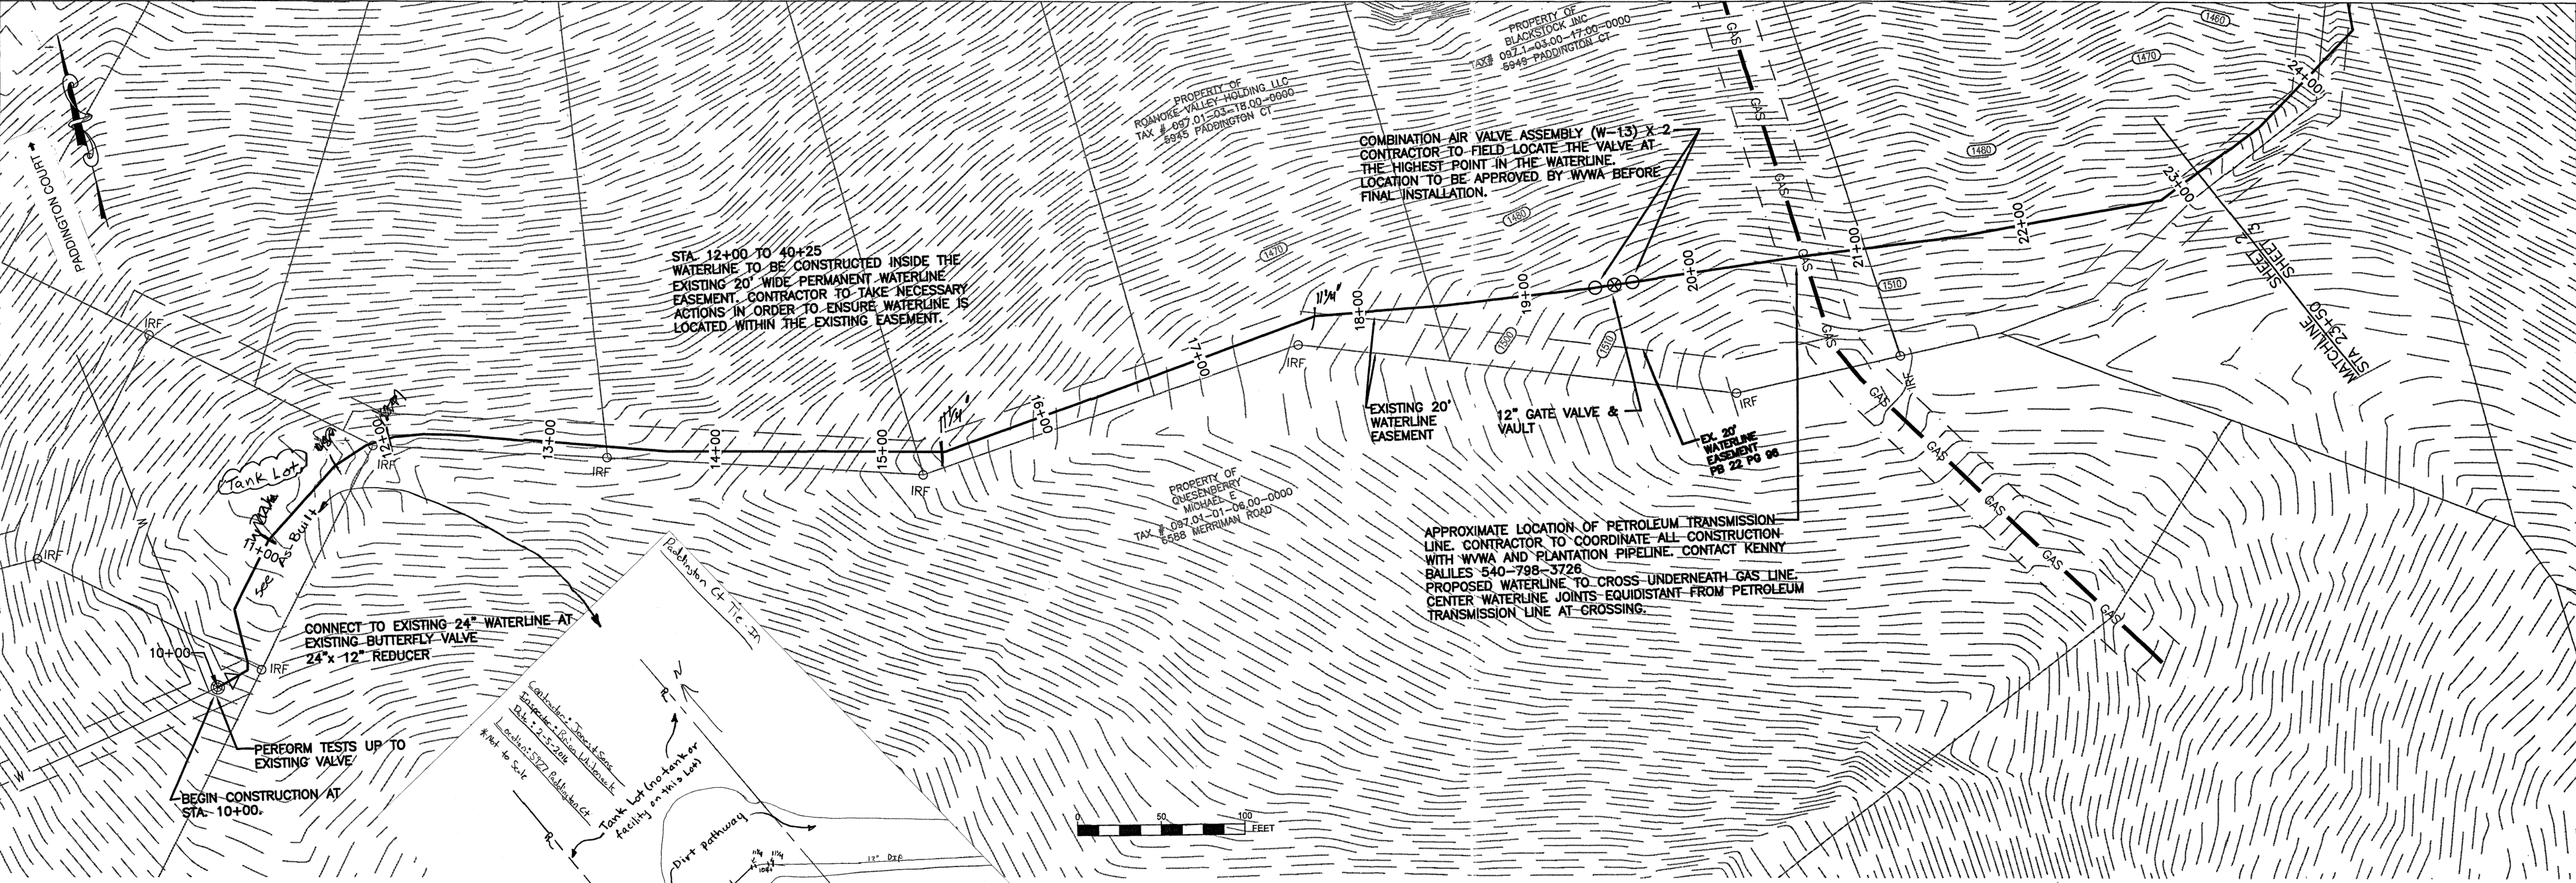

STA. 10+00 TO 23+50

SCALE
VERTICAL: 1"= 20'
HORIZONTAL: 1" = 50'

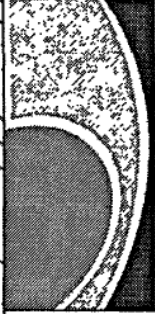

**WESTERN VIRGINIA
WATER AUTHORITY**
ENGINEERING SERVICES
601 S JEFFERSON ST, SUITE 300
ROANOKE, VA 24011
540-853-5641 or 540-853-5770

1550 ZONE CONNECTION
PROJECT-PHASE 1

AS-BUILT PLAN & PROFILE

Rev	Description	Date	By
1	REVISED PER AS-BUILT SURVEY	2/24/16	DRJ

Designed: TEC

Drawn: AAS, DRJ

Checked: TEC

Approved:

Date: 7-24-15

Project:

2

Sheet 2 of 7