
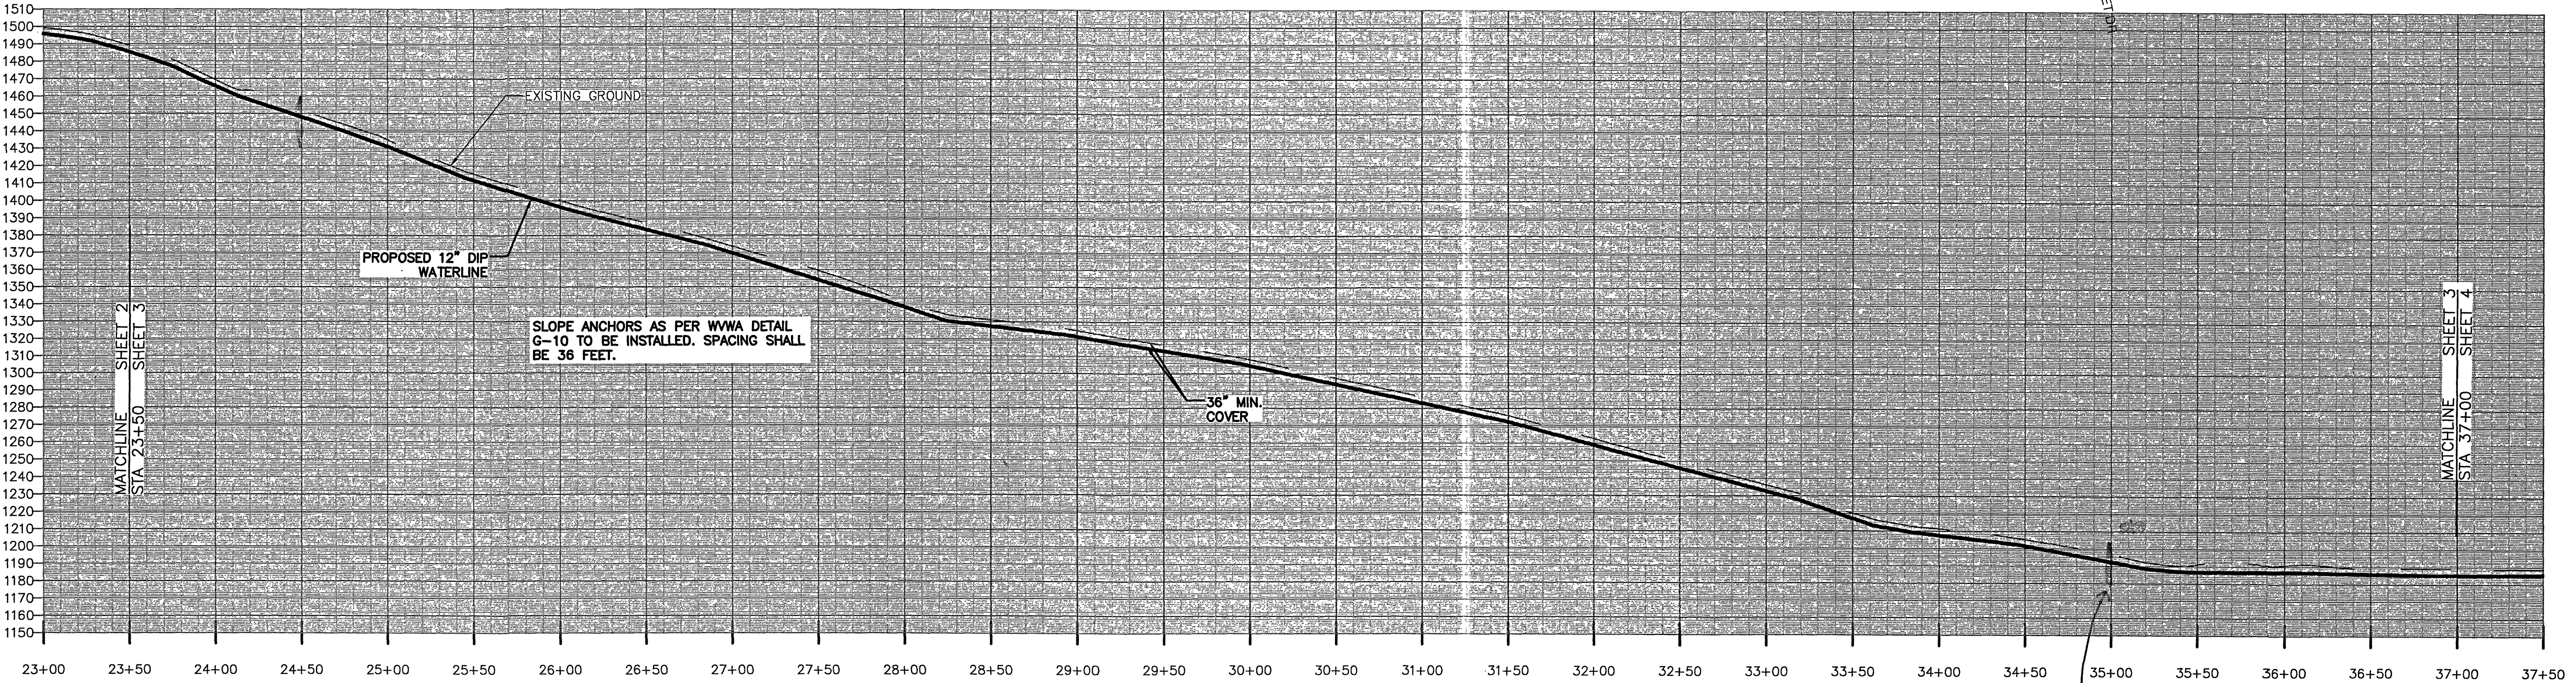


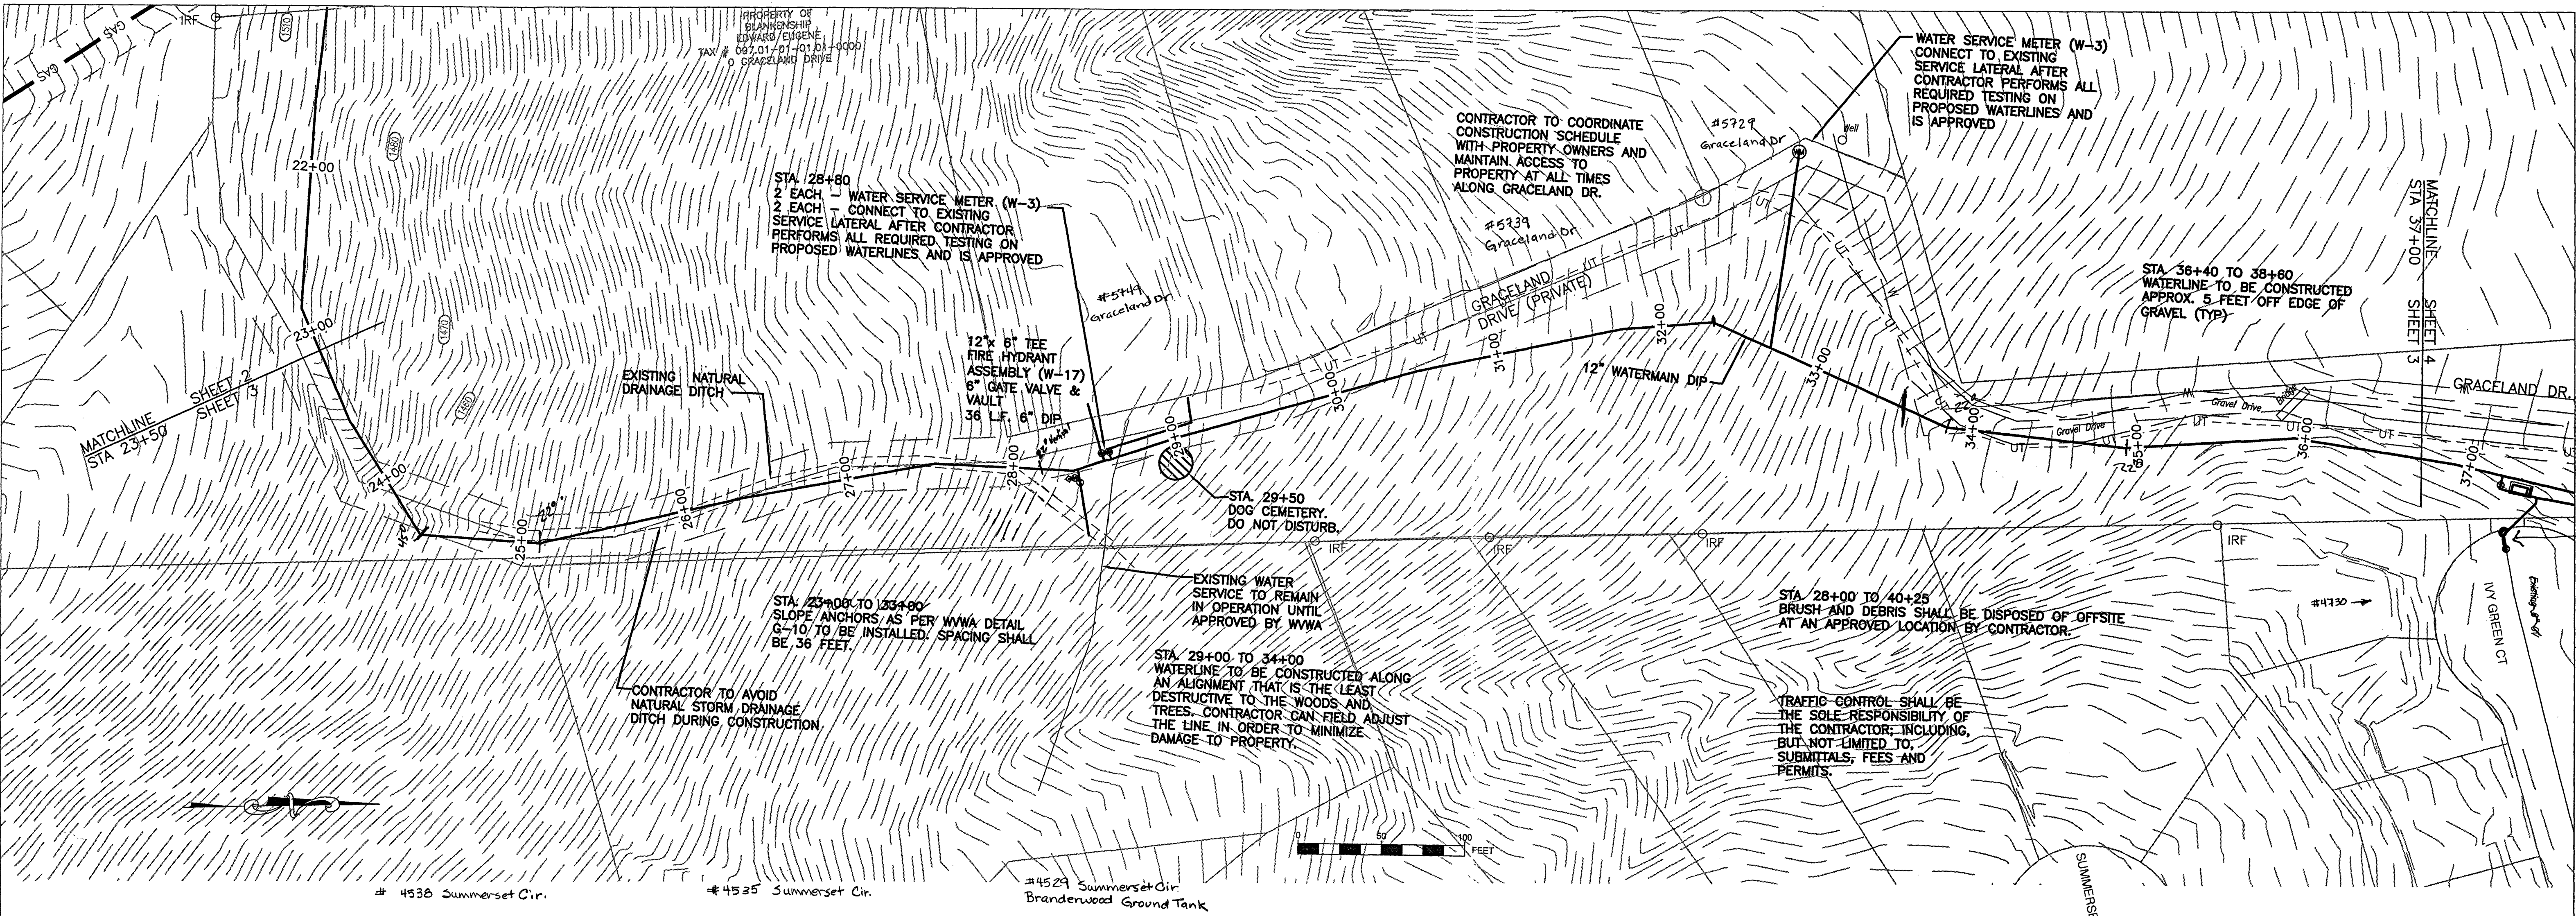

STA. 23+50 TO 37+00

SCALE
VERTICAL: 1" = 50'
HORIZONTAL: 1" = 50'

* Slope Anchors + Sure lock Gaskets
Installed from this point from 35+00 to 24+50
Every 36ft + Sure lock Gaskets Every Joint

WESTERN VIRGINIA

WATER AUTHORITY

ENGINEERING SERVICES
601 S JEFFERSON ST, SUITE 300
ROANOKE, VA 24011
540-853-5641 or 540-853-5770

1550 ZONE CONNECTION
PROJECT-PHASE 1

AS-BUILT PLAN & PROFILE

Rev	Description	Date	By
1	REVISED PER AS-BUILT SURVEY 2/24/16	2/24/16	DRJ

Designed: TEC
Drawn: AAS, DRJ
Checked: TEC
Approved:
Date: 7-24-15
Project:

3

Sheet 3 of 7