


This document, together with the concepts and designs presented herein, is an instrument of service and shall be without liability to Engineering Concepts, Inc. should be without liability to Engineering Concepts, Inc.

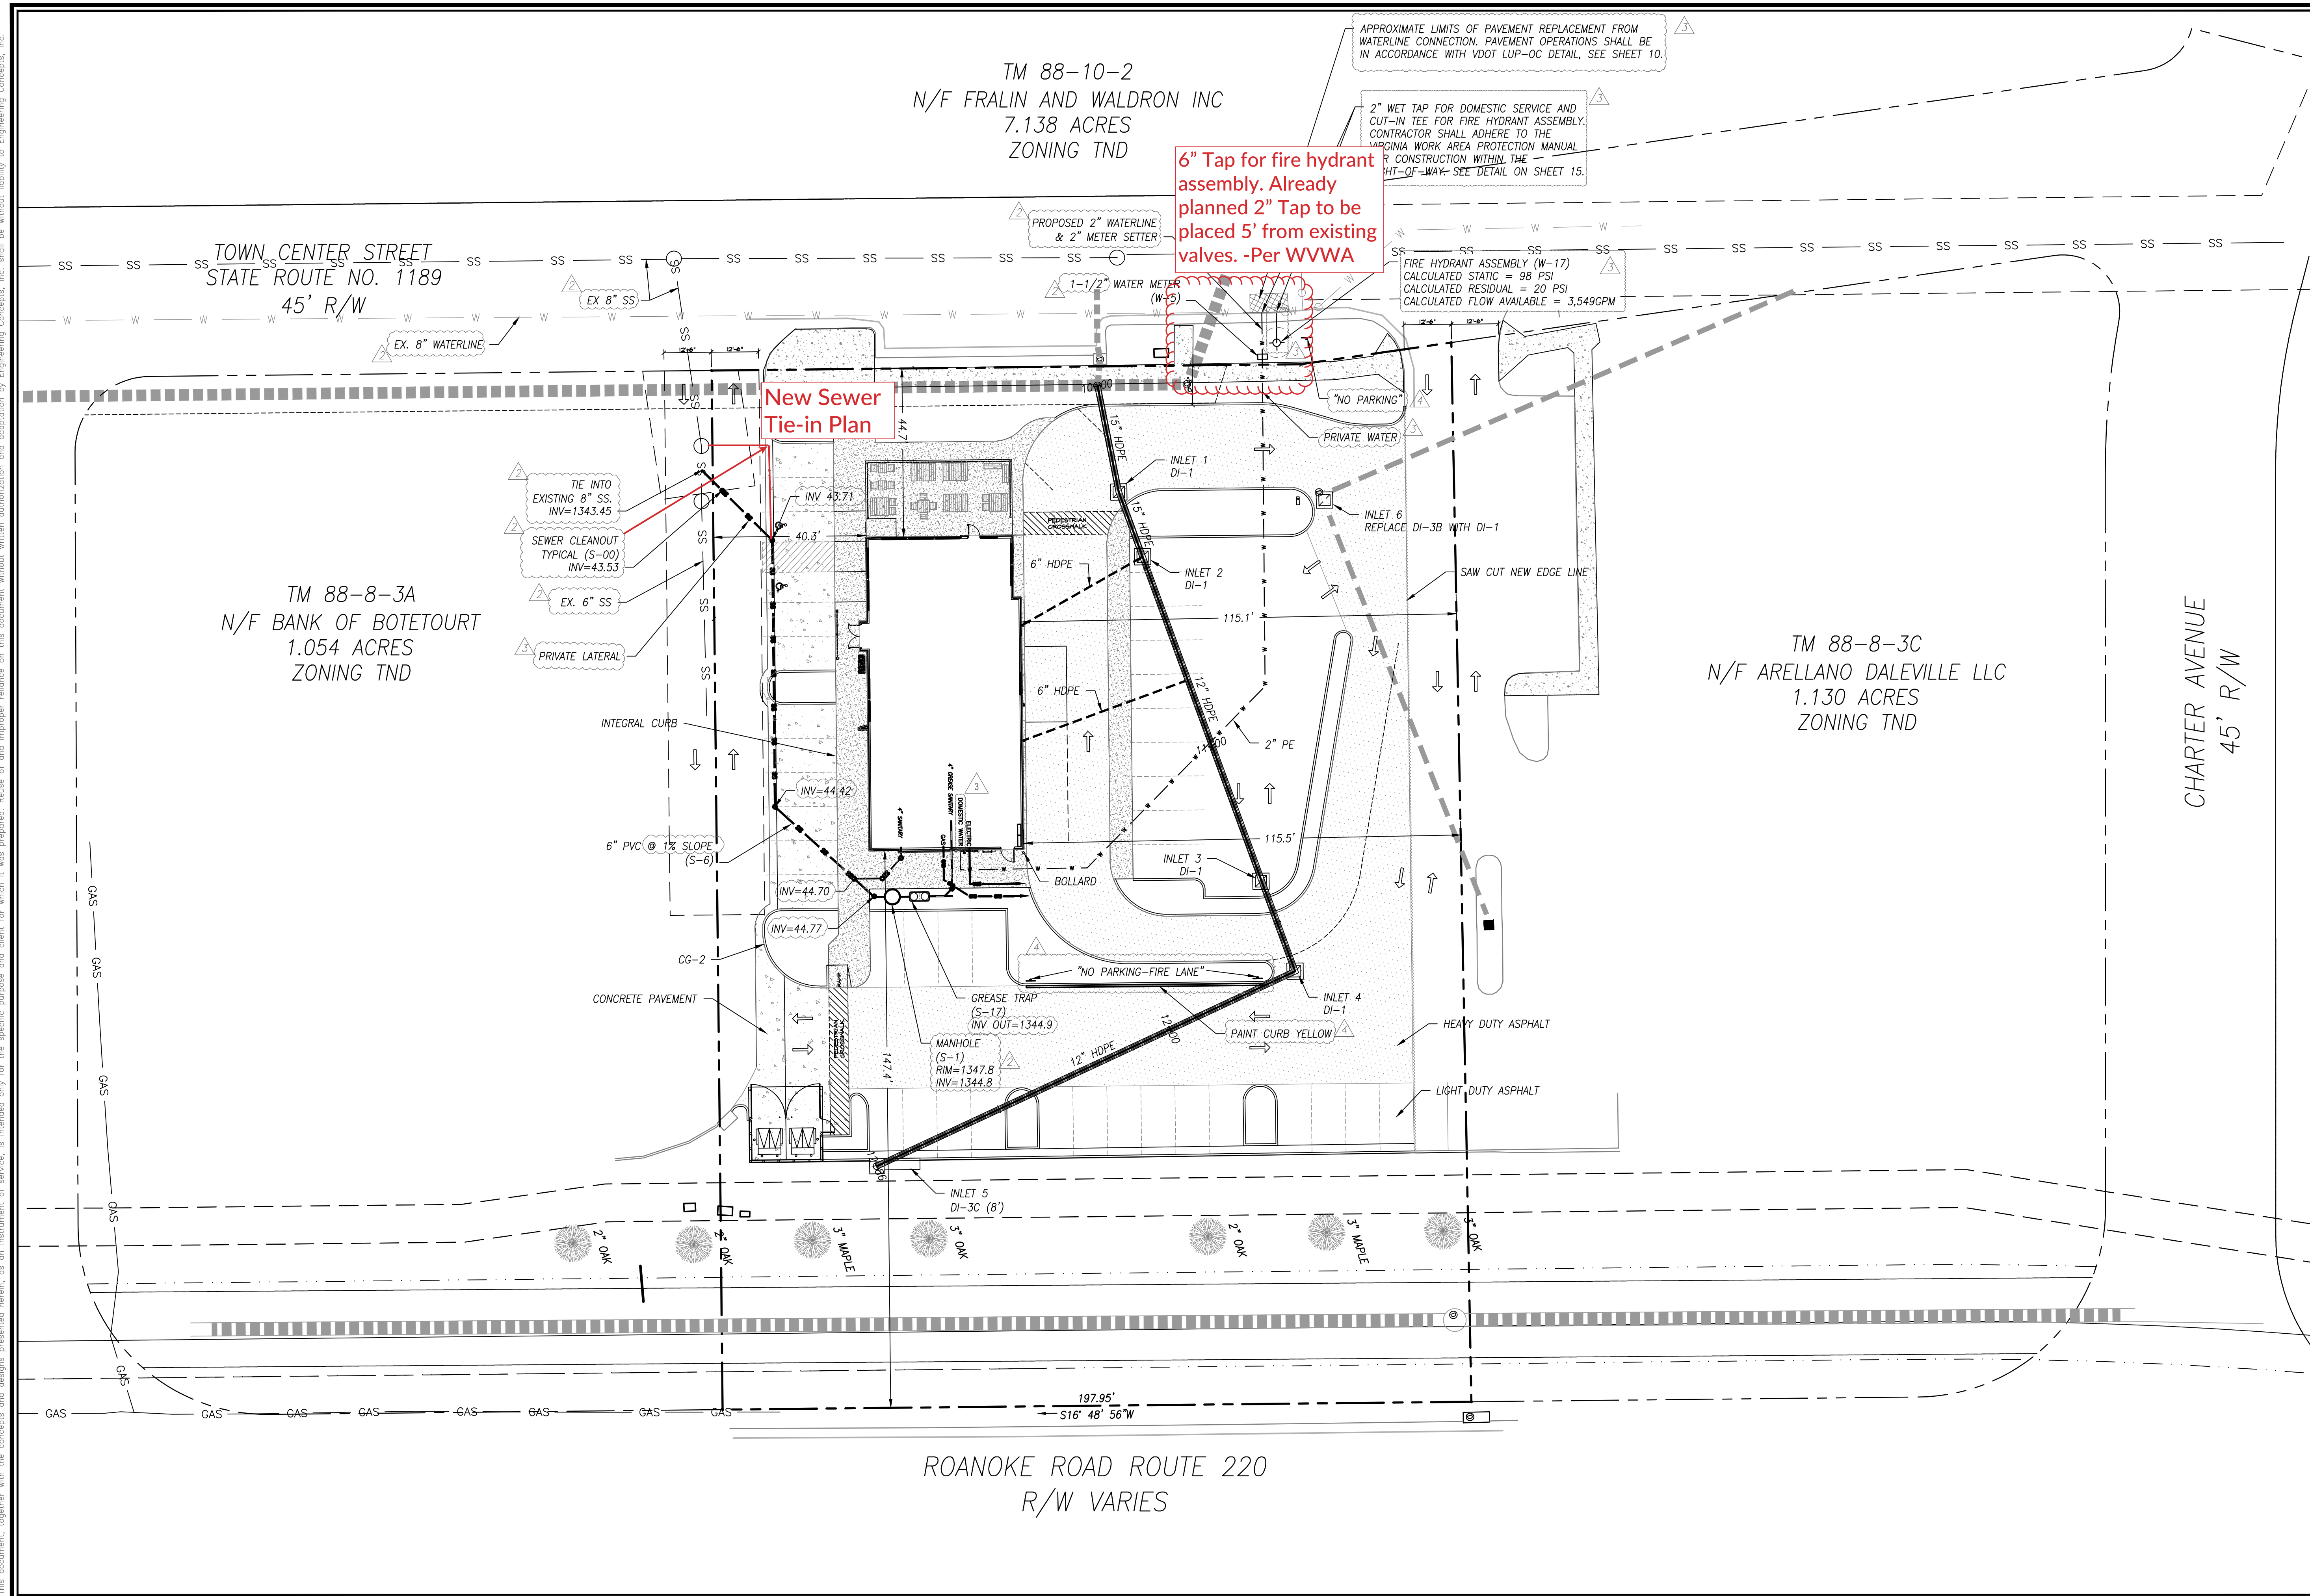


**ENGINEERING
CONCEPTS, INC.**

94 GREENFIELD STREET
DALEVILLE, VIRGINIA 24083
540.473.1253

No.	Description	Date
1	ADD SEWER INVERTS	10/25/21
2	REVIEW COMMENTS	01/04/22
3	REVIEW COMMENTS	11/3/22
4	REVIEW COMMENTS	12/08/22

**DAIRY QUEEN
DALEVILLE TOWN CENTER**
SITE DIMENSIONAL PLAN

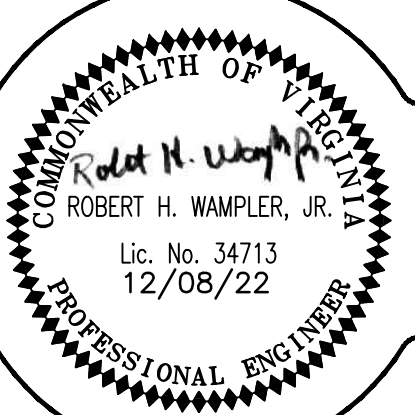

0 20 40
GRAPHIC SCALE

PROJECT: 21055