



HILL BEAR, LLC.
941 INDUSTRY AVENUE
WATER MAIN EXTENSION
INDUSTRY AVENUE OPTION

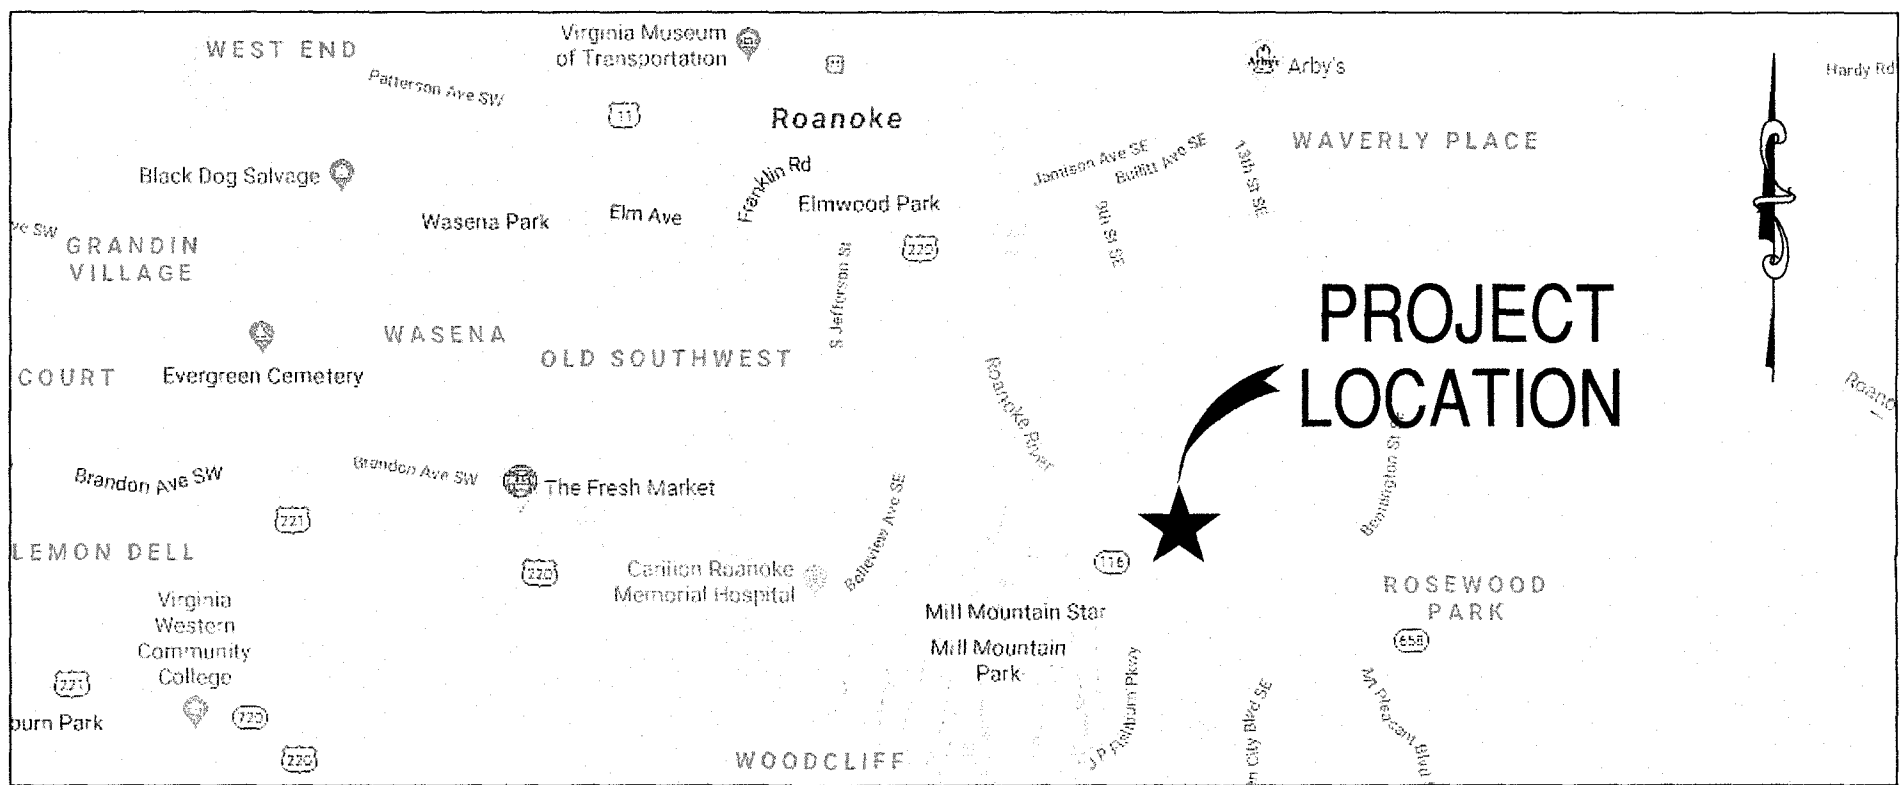

LOCATION MAP
NO SCALE

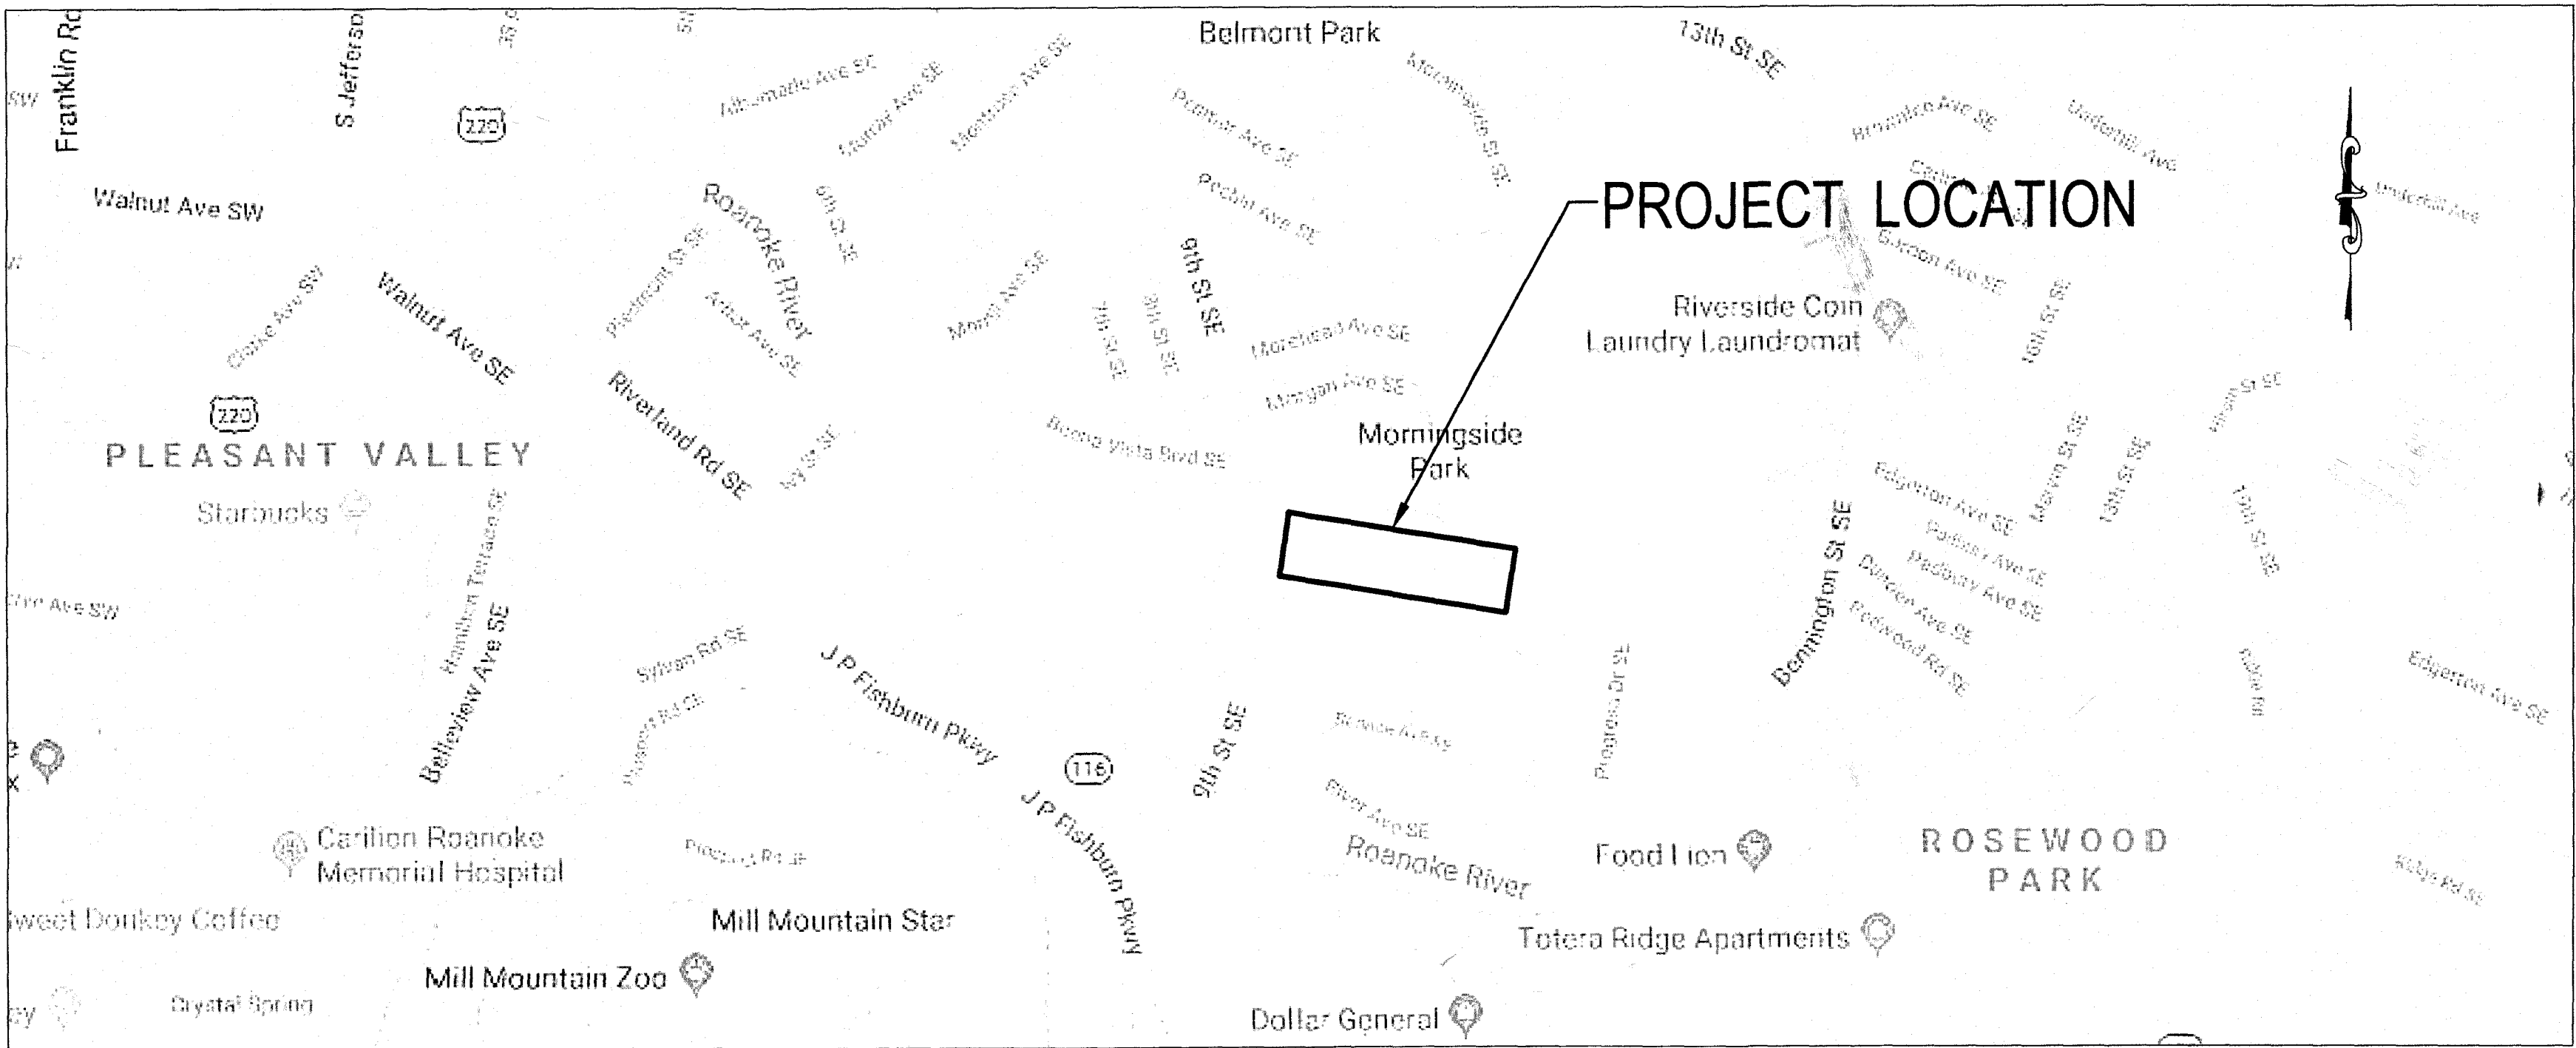

VICINITY MAP
NO SCALE

AUGUST 2019

All Installed Per 2017
standards. Restrained every 65' From
Valve each direction

Material
8" DIF U.S. Pipe CL350
6" DIF U.S. Pipe CL350

Valves
8" - AFC - 24 Turns to Right to close
6" - AFC - 18 Turns to Right to close

Contractor: EC PACE
Inspector: Brian Whitnack 2019
P.M. - Aaron Shearer

AS-BUILTS 2019

DRAWING TITLE	SHEET NUMBER
COVER	1
GENERAL NOTES & PROPOSED LEGEND	2
STANDARD DETAILS	3
STANDARD DETAILS	4
SURVEY SCHEDULES, NOTES, & EXISTING LEGEND	5
SHEET LAYOUT & FIRE HYDRANT COVERAGE MAP	6
PROPOSED 20' PERMANENT WATER MAIN EASEMENT	7
8" WATER MAIN PLAN - PROFILE, STA. 10+00 TO STA. 15+50	8
8" WATER MAIN PLAN - PROFILE, STA. 15+50 TO STA. 21+00	9
8" WATER MAIN PLAN - PROFILE, STA. 21+00 TO STA. 26+00	10
8" WATER MAIN PLAN - PROFILE, STA. 26+00 TO STA. 28+28	11

100% SUBMITTAL
NOT TO BE USED
FOR CONSTRUCTION



HILL BEAR, LLC.
1811 Hollins Road
Roanoke, Virginia 24012

DES: PJM
DRAWN: JES
CHECK: GWF
DATE: 8/16/19

SCALE: N/A
HORIZ: N/A
VERT: N/A

941 INDUSTRY AVENUE
WATER MAIN EXTENSION
INDUSTRY AVENUE OPTION

COVER

DRAWING

SHEET

1