



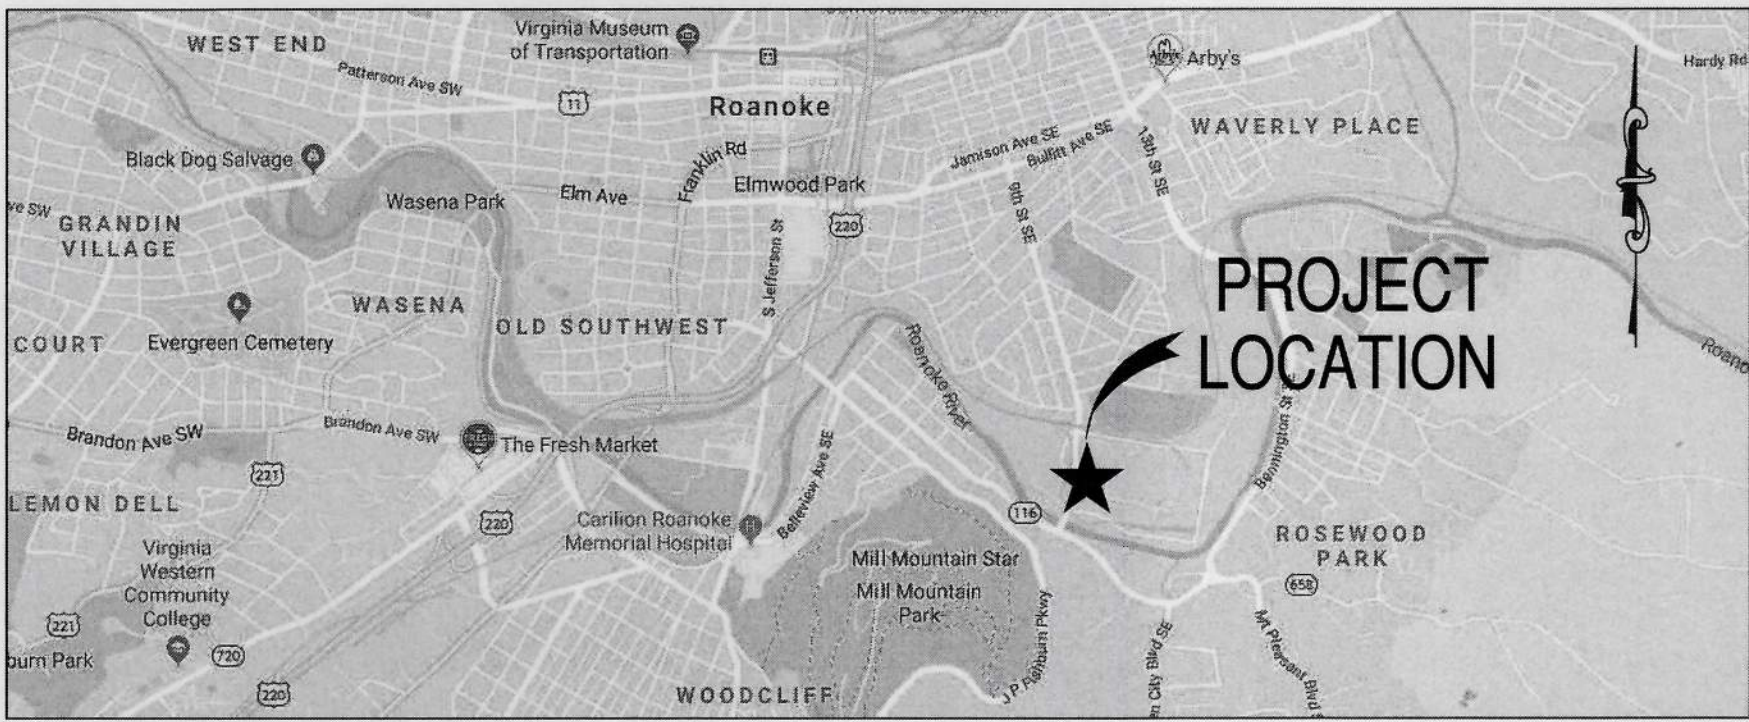

LOCATION MAP
NO SCALE

WESTERN VIRGINIA WATER AUTHORITY
9TH STREET, SE
WATER MAIN EXTENSION

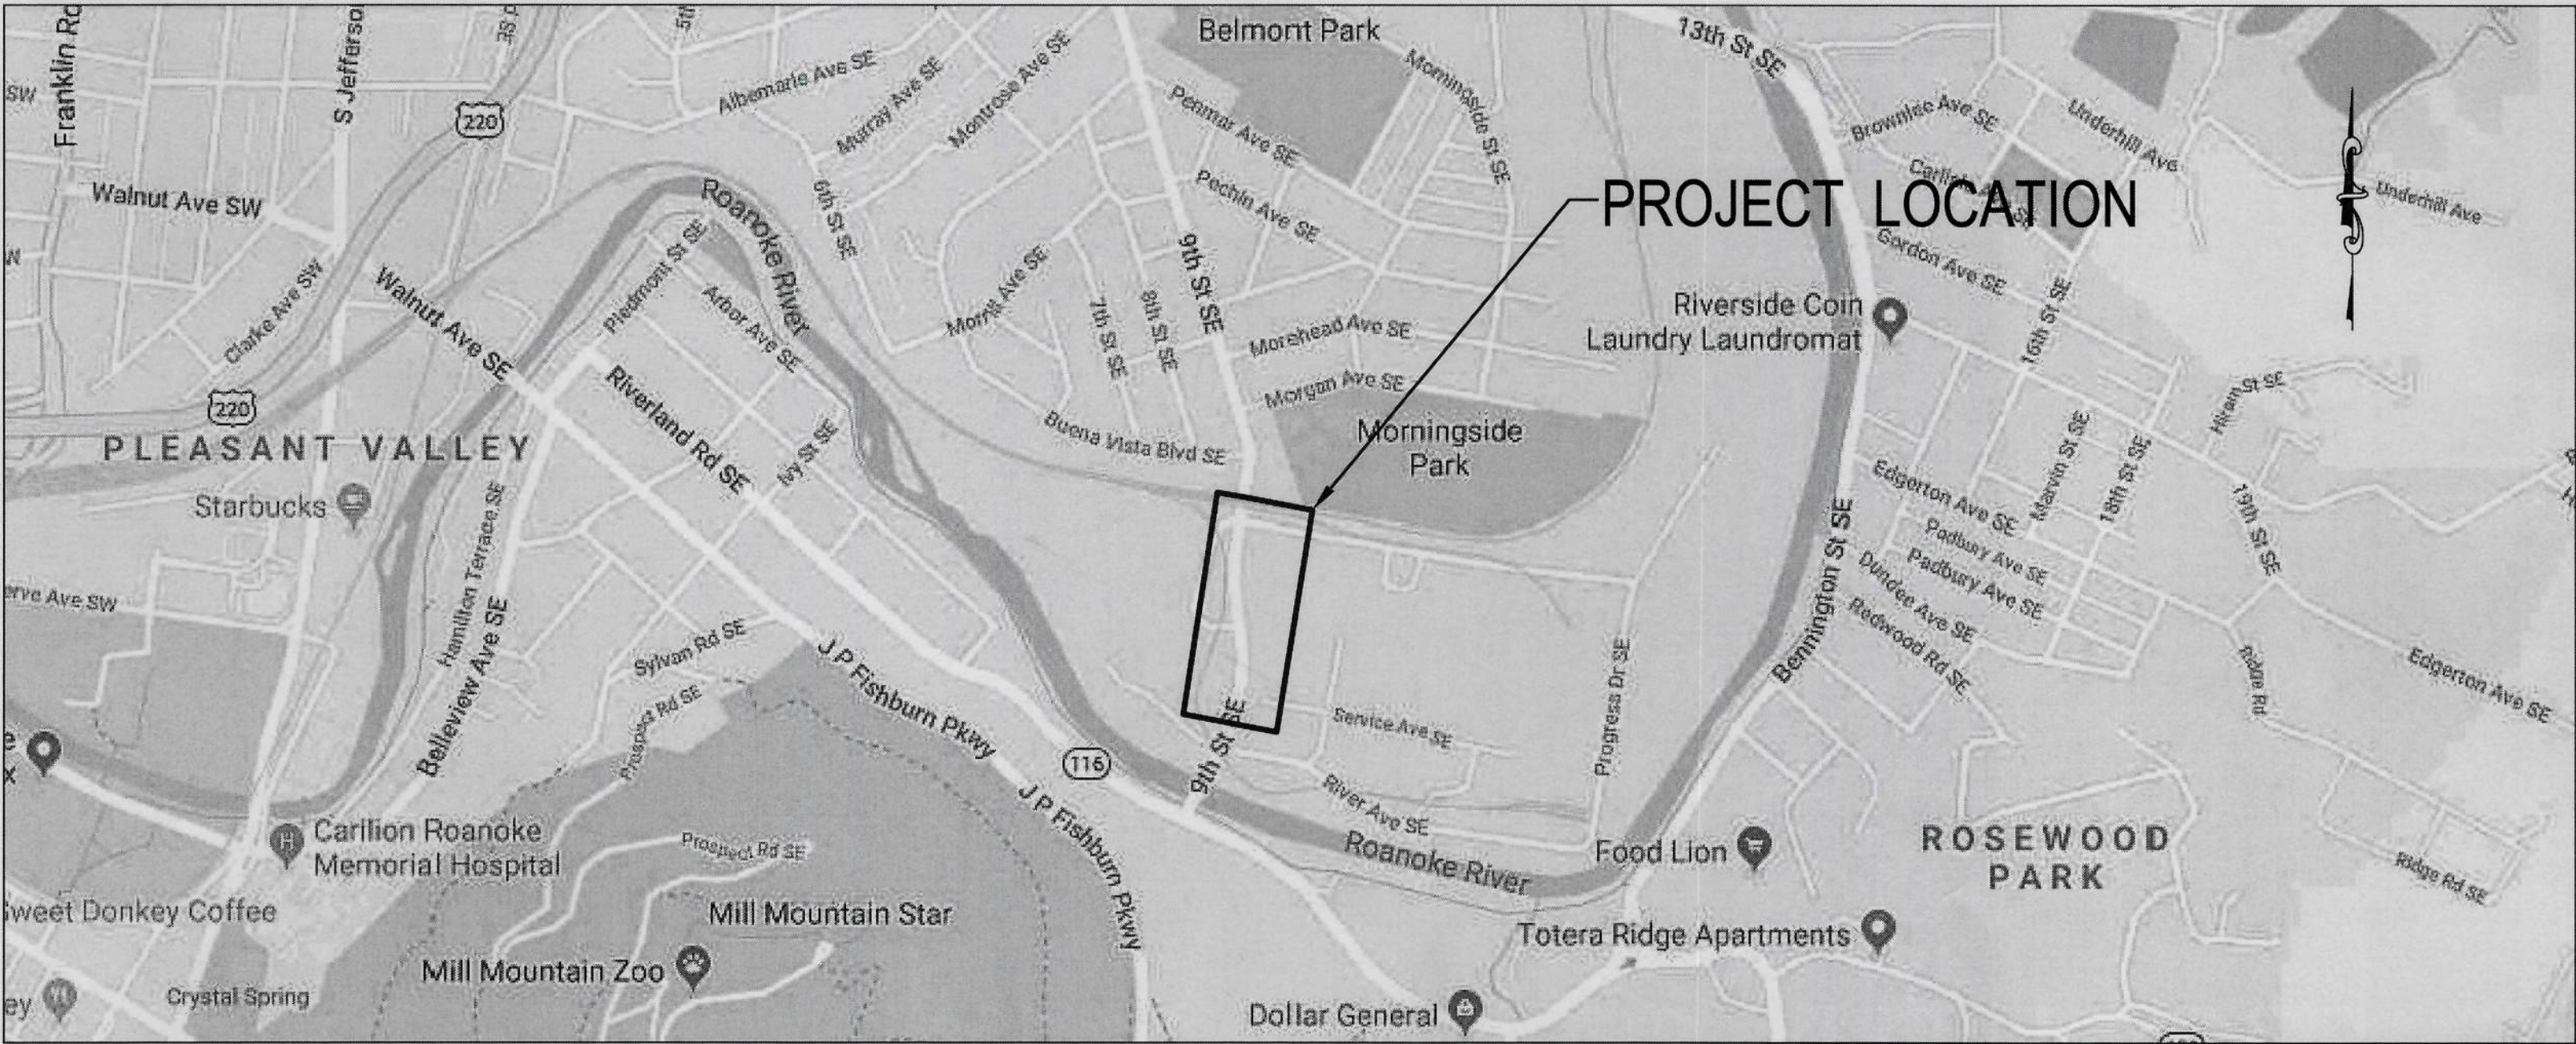

VICINITY MAP
NO SCALE


JUNE 2021

Material
8" Main - Sta 10+00 to Sta 16+80 = CLASS S2 McWane DIP
Sta 16+80 to Sta 20+83 = CLASS S0 McWane DIP

Hydrants = AVK, 2020, TAG #S
Sta 10+41 = 10206 = 95 PSI
Sta 17+00 = 10205 = 95 PSI

Valves = AVK
Turns to left to open
24 - 8" Gate Valves - Resilient Seat
18 - 6" Gate Valves - Resilient Seat (hydrants)

DRAWING TITLE	SHEET NUMBER
COVER	1
GENERAL NOTES & PROPOSED LEGEND	2
STANDARD DETAILS	3
STANDARD DETAILS	4
SURVEY SCHEDULES, NOTES, & EXISTING LEGEND	5
EROSION & SEDIMENT CONTROL NOTES	6
EROSION & SEDIMENT CONTROL DETAILS	7
SHEET LAYOUT & FIRE HYDRANT COVERAGE MAP	8
8" WATER MAIN PLAN - PROFILE, STA. 10+00 TO STA. 15+50	9
8" WATER MAIN PLAN - PROFILE, STA. 15+50 TO STA. 20+83	10

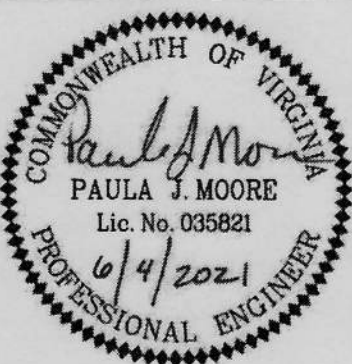

WESTERN VIRGINIA WATER AUTHORITY
601 South Jefferson Street, Suite 300
Roanoke, Virginia 24011

DES: PJM
DRAWN: JES
CHECK: PJM
DATE: 6/04/21

SCALE: N/A
HORIZ: N/A
VERT: N/A

WESTERN VIRGINIA WATER AUTHORITY
9TH STREET, SE
WATER MAIN EXTENSION

COVER

DRAWING
C1.01

SHEET
1

Contractor - P&C
Inspector - Brian Whitenuck
10/29/21
AS-BUILTS
Inspector Set