



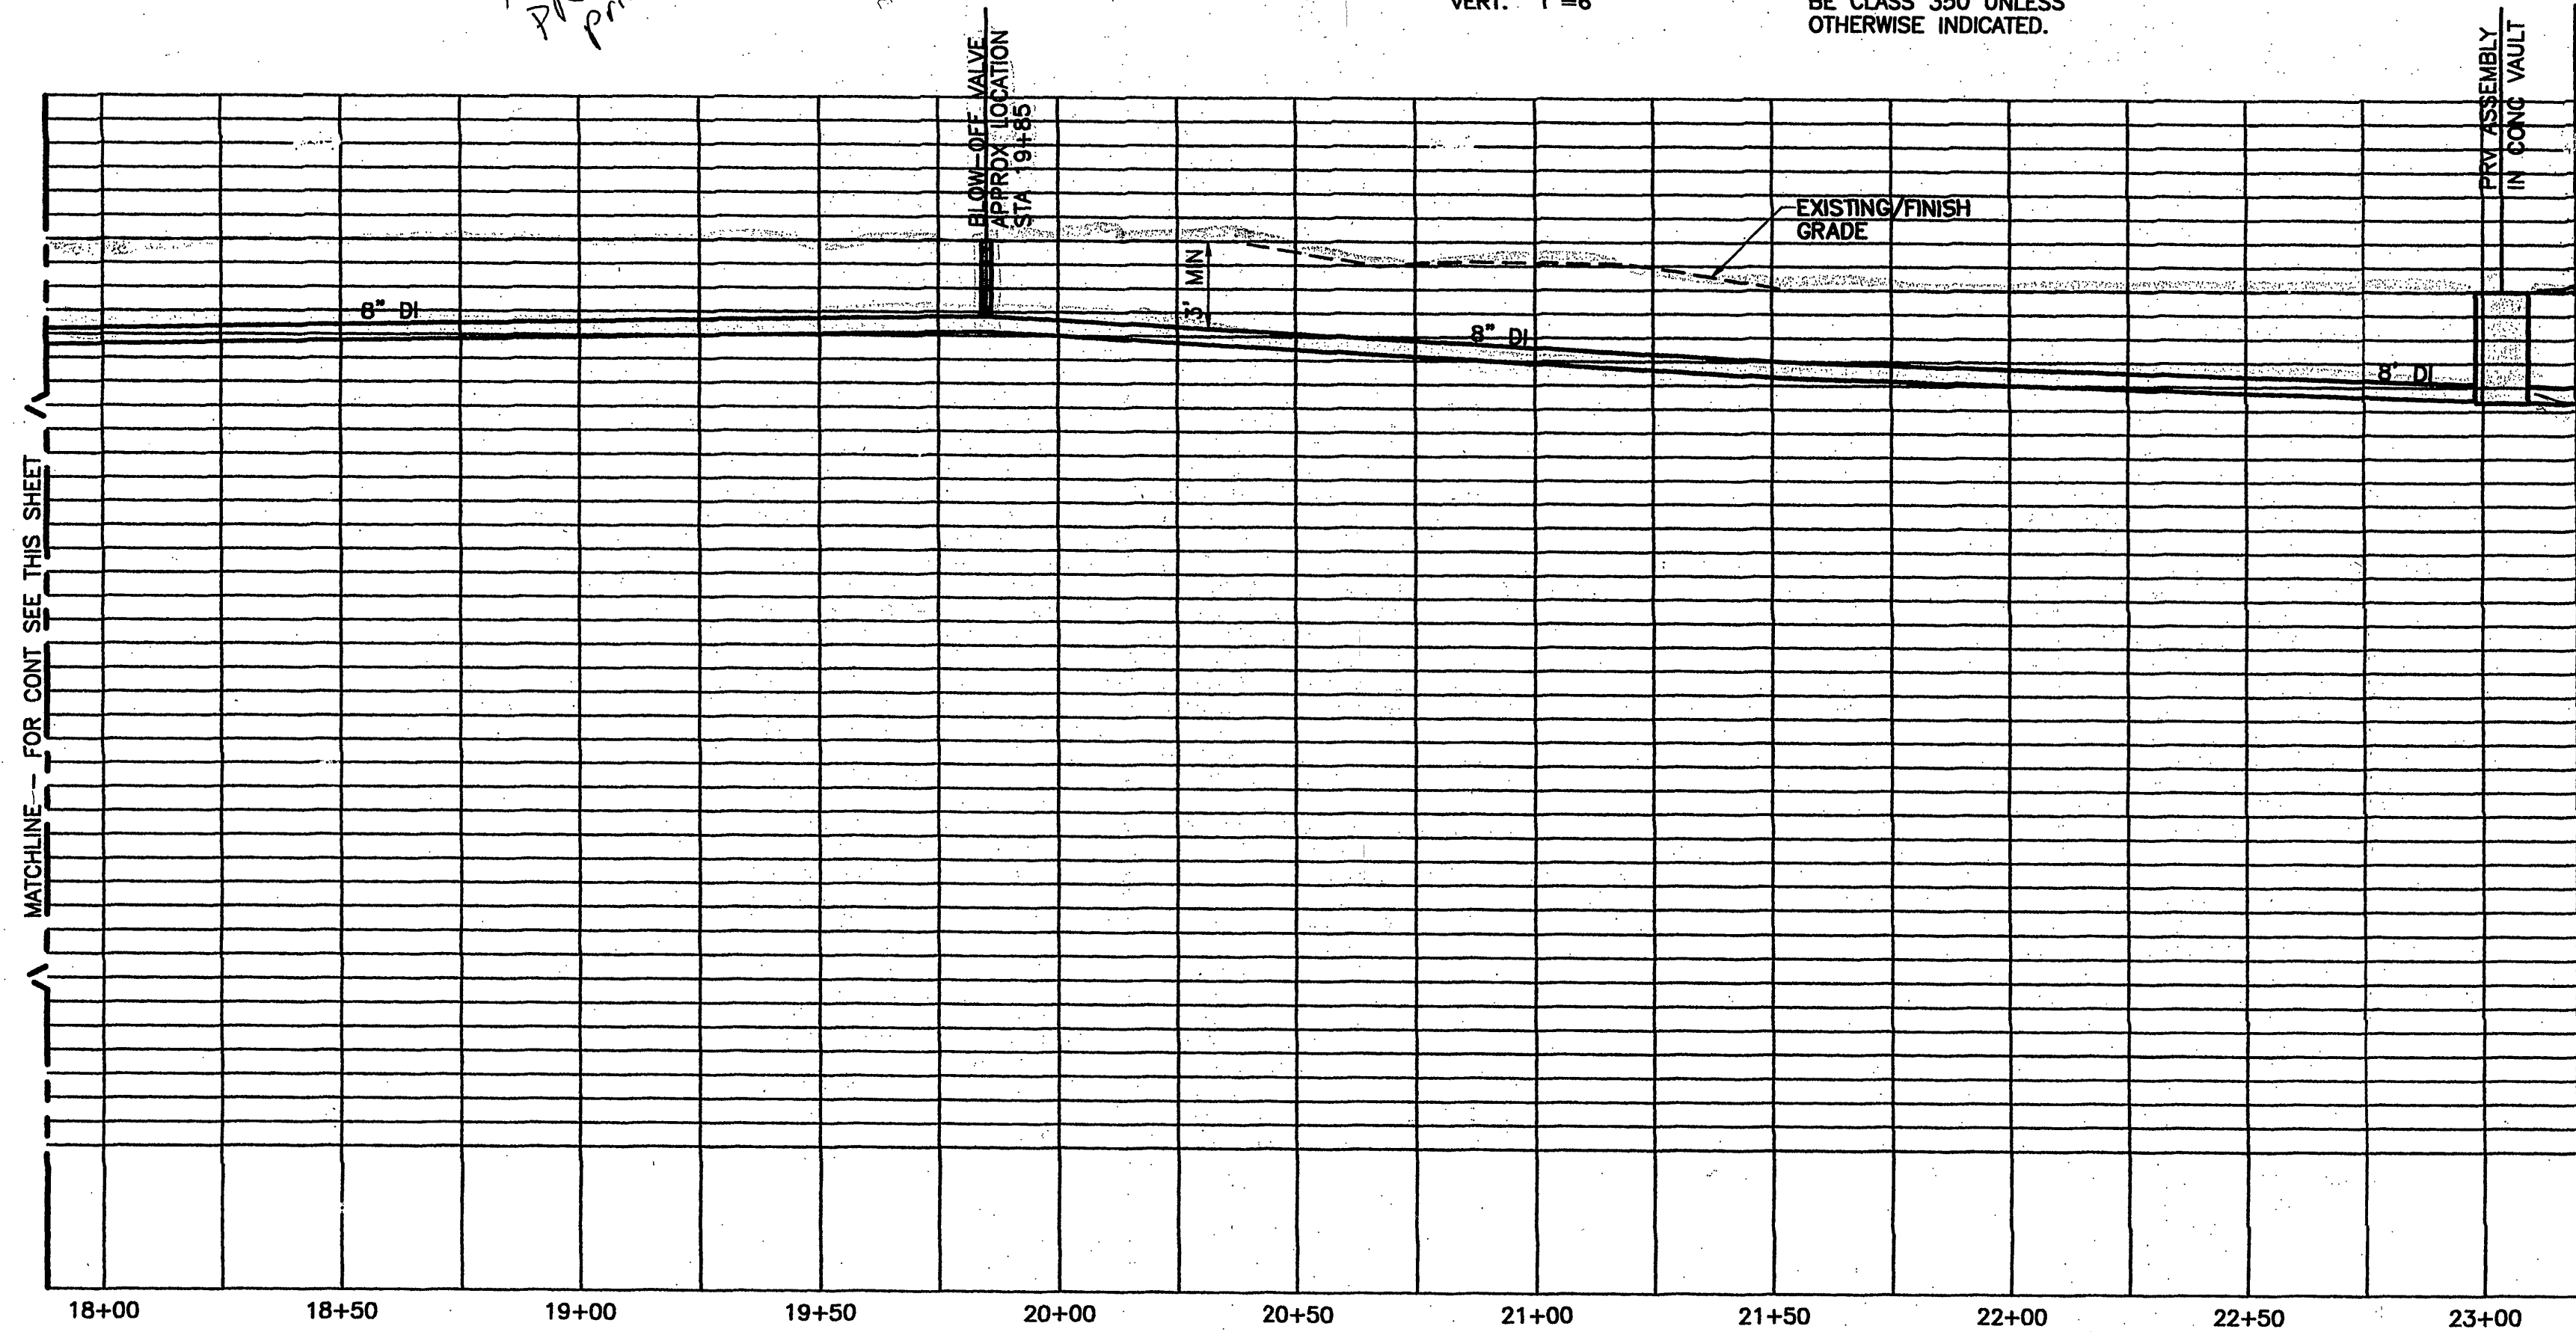

WATER LINE PROFILE

SCALE: HORIZ. 1"=30'
VERT. 1"=6'

NOTE: ALL DUCTILE IRON PIPE SHALL
BE CLASS 350 UNLESS
OTHERWISE INDICATED.

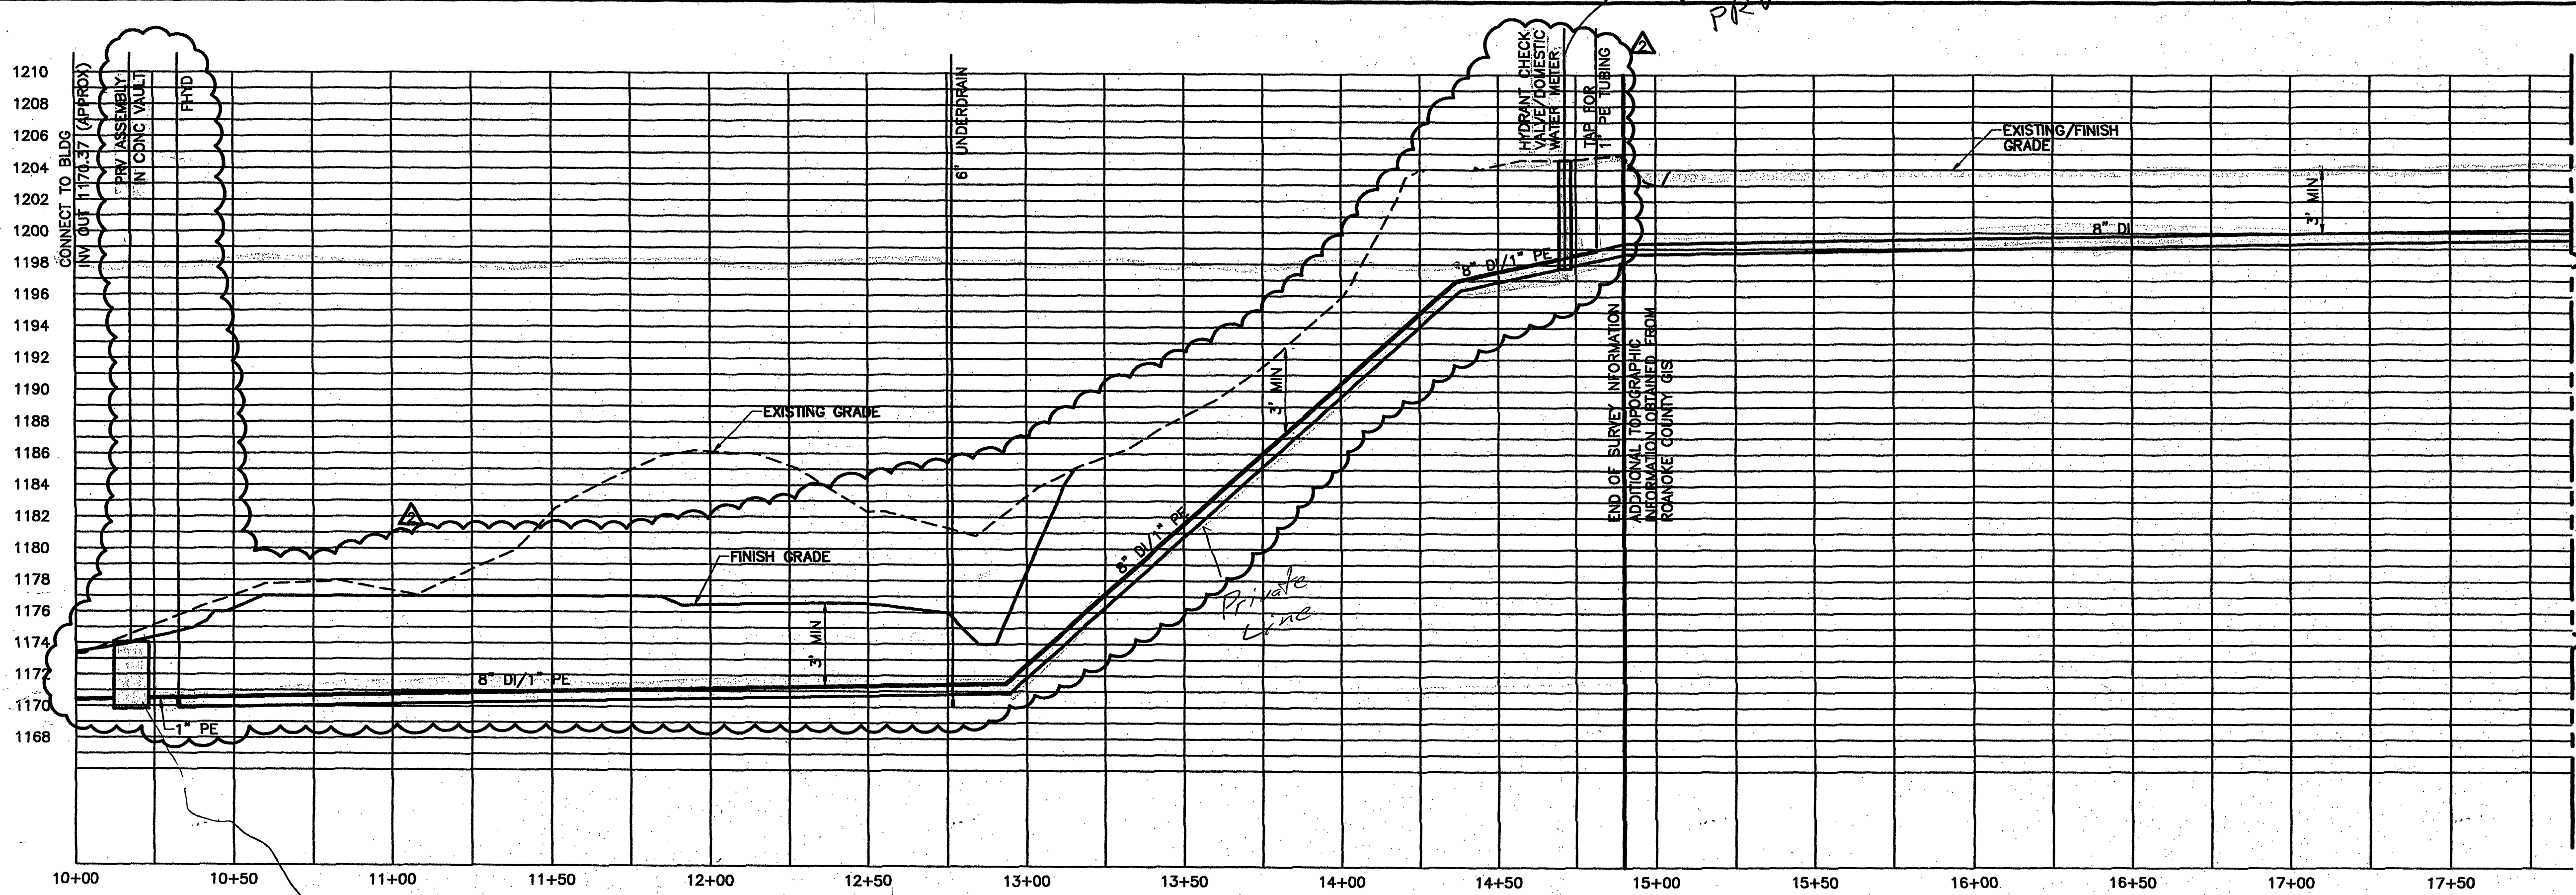

WATER LINE PROFILE

SCALE: HORIZ. 1"=30'
VERT. 1"=6'

NOTE: ALL DUCTILE IRON PIPE SHALL
BE CLASS 350 UNLESS
OTHERWISE INDICATED.


As-Built 1.20.11 K. Winslow

2
23+25
14+75
8+50

Set PRV 120 psi
Test @ 220 psi?

Existing Pressure $\approx$ 155psi with spikes at
175psi when pumps cut on.

1210
1202
1201

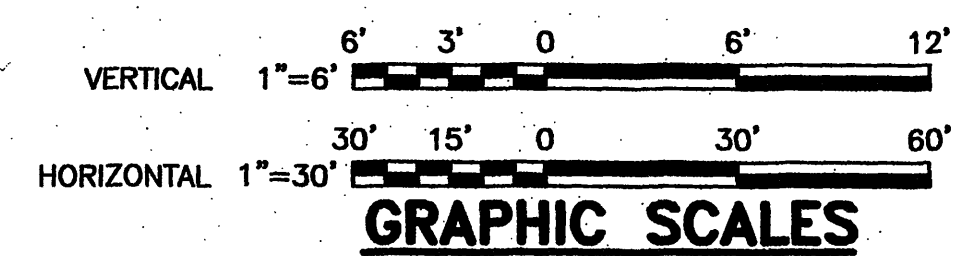

PROJECT NO: 60091000	
CAD DWG FILE: LLCS_204	
DESIGNED BY: NTG	
DRAWN BY: NTG	
DEPT CHECK: EPB	
PROJ CHECK: JSH	
DATE: APRIL 27, 2010	
SCALE: 1"=30'	
CS204	
SHEET 41 OF 51	

REVISIONS	
MARK	DATE
9/2/10	NTG
4/27/10	NTG
9/2/10	MLC
4/27/10	MLC
WYNA COMMENTS	
SHEET ADDED	
MADE BY (CHECKED)	
DESCRIPTION	

1318 FRANKLIN ROAD
PRINCETON, NJ 08540
PHONE (609) 981-1100

AECOM

COMMONWEALTH OF VIRGINIA
CONLEYA TAYLOR
Lic. No. 21318
09/03/10
PROFESSIONAL ENGINEER

FOXHALL PROPERTIES LLC
ADAMS CONSTRUCTION ASPHALT PLANT

WATER PROFILE