
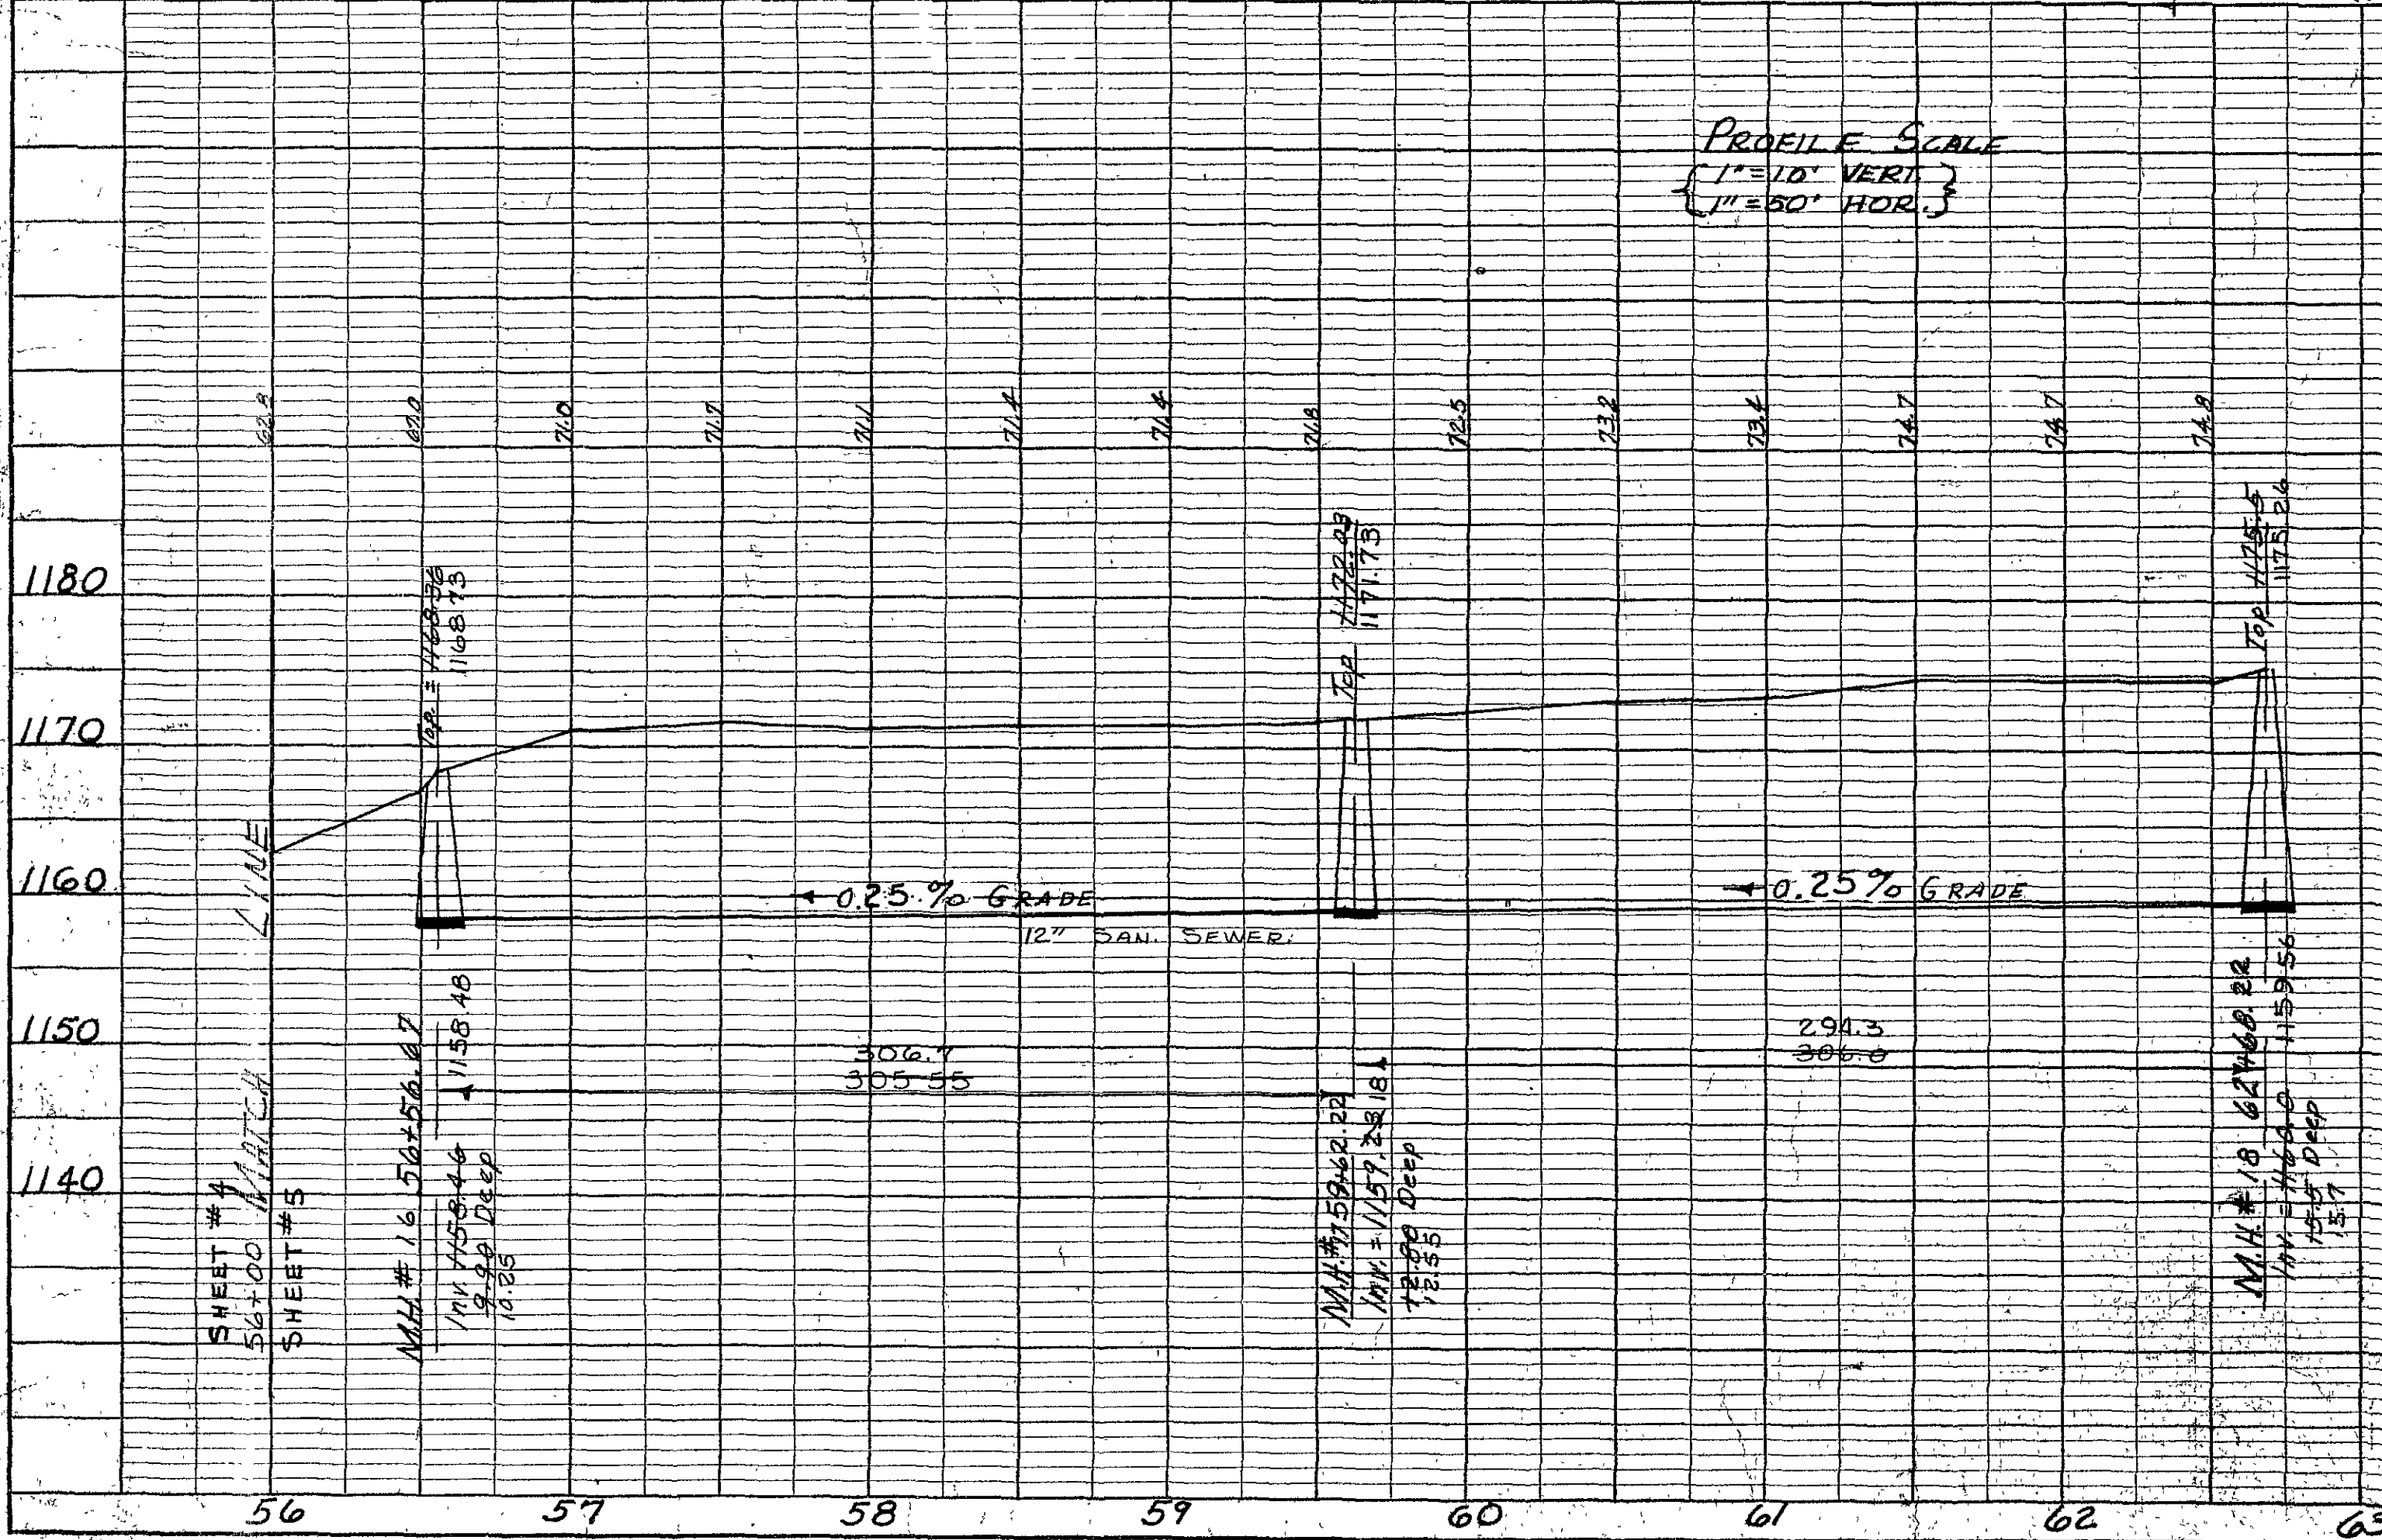


PLAN	SURVEYED	BY	DATE
	NOTED		
	NOTE BOOK		
	RT. OF WAY CHECKED		

PROFILE	SURVEYED	BY	DATE
	NOTED		
	NOTE BOOK		
	STRUCTURE NOTATION CHD		

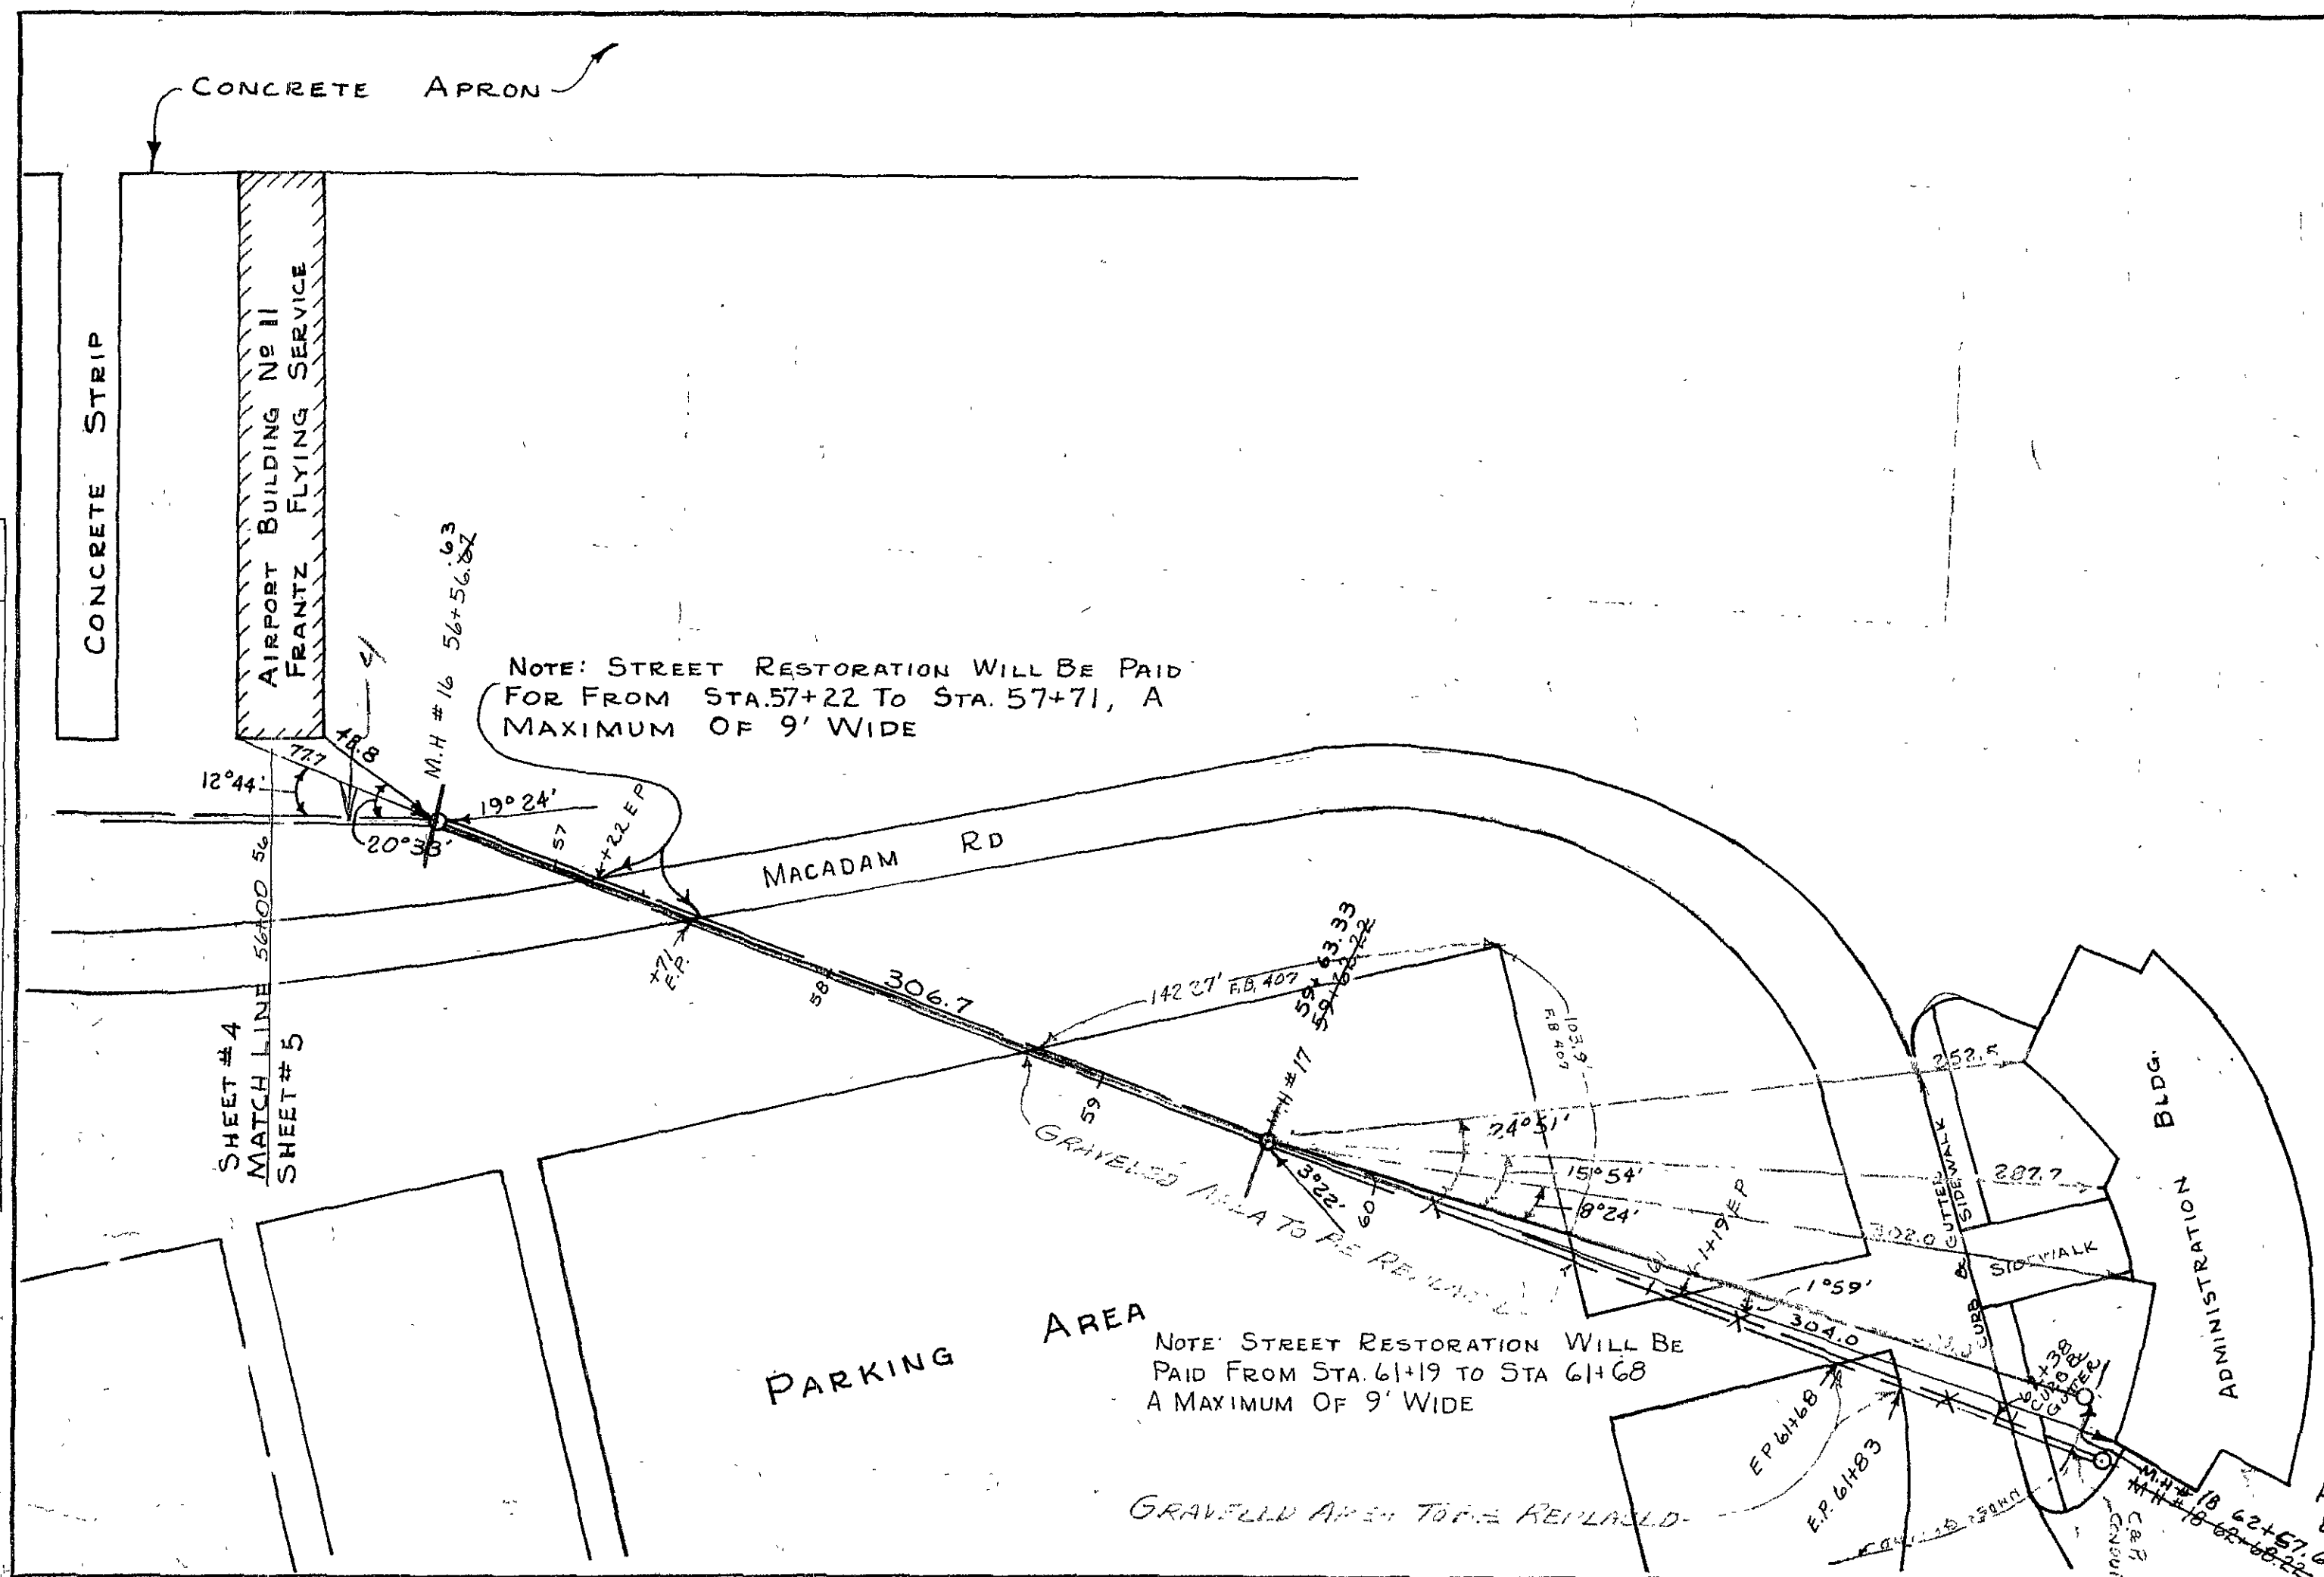

As Built Plotted
By Dat 11-13-61

AIRPORT TRUNK LINE SANITARY SEWER
PLAN N94563