

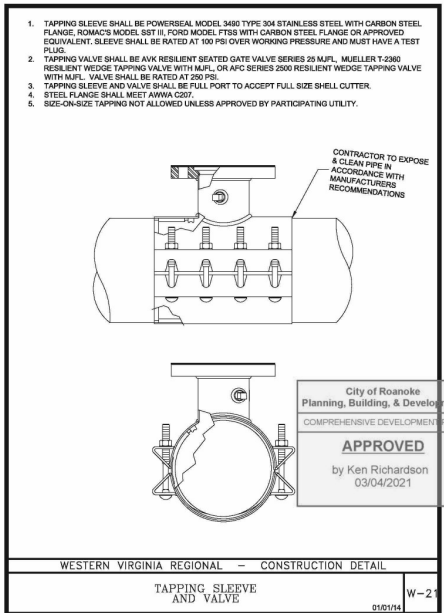
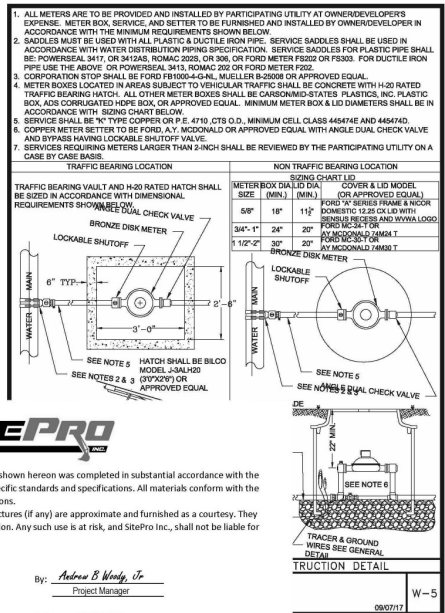
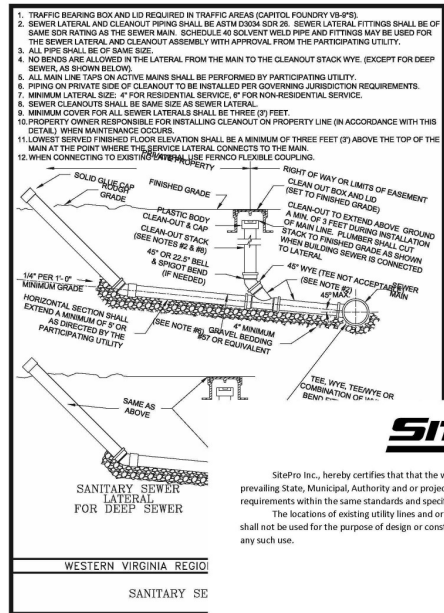
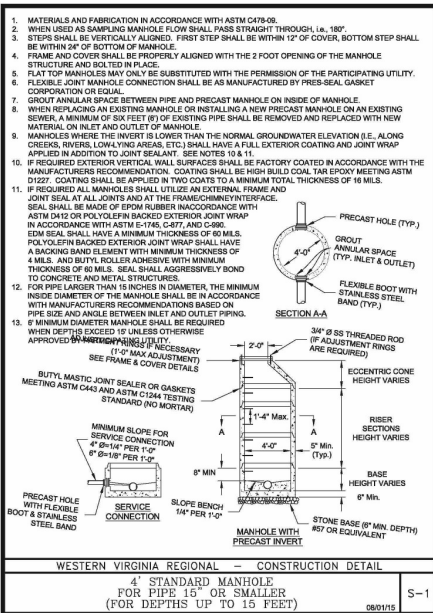


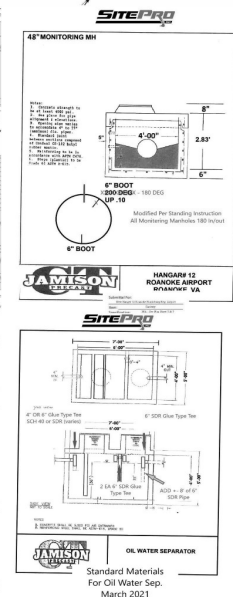

"Red Line" As Build Drawing & Certification
11 June 2021

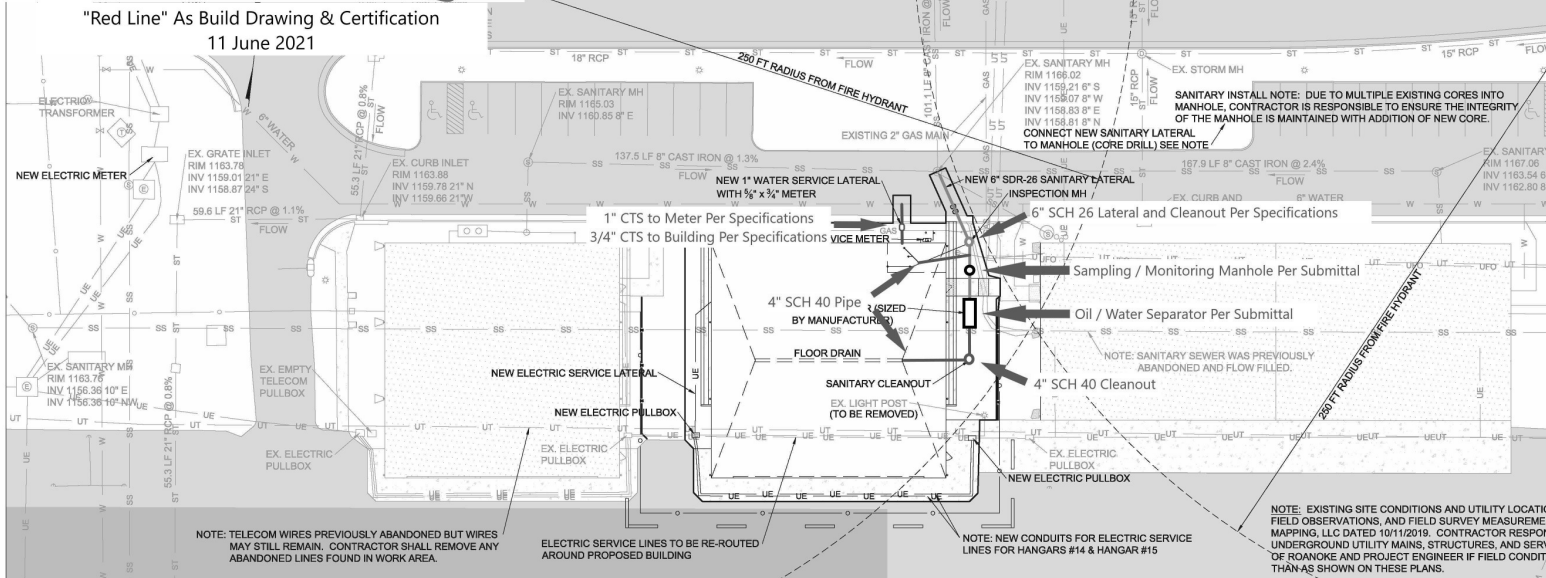

SITE DEVELOPMENT PLANS		FOR		HANGAR # 12		OWNER - ROANOKE REGIONAL AIRPORT COMMISSION		BUILDER - GAH CONTRACTING, INC.		TAX PARCEL ID: 6800101		CITY OF ROANOKE, VIRGINIA	
DATE		REVISIONS		#		1ST SUBMITTAL FOR CITY REVIEW		2ND SUBMITTAL FOR CITY REVIEW		1ST SUBMITTAL FOR CITY REVIEW		2ND SUBMITTAL FOR CITY REVIEW	
01/07/2021				1									
02/05/2021				2									

BME JOB #		19-024		SHEET NAME		UTILITY PLAN		SHEET NUMBER		5 OF 8	
-----------	--	--------	--	------------	--	--------------	--	--------------	--	--------	--