
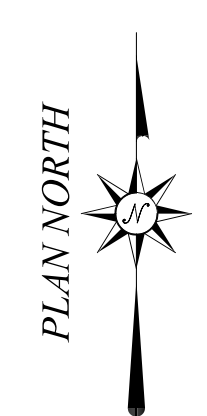


1. THIS MAP HAS BEEN PREPARED FROM AN ACTUAL FIELD SURVEY.
2. HORIZONTAL DATUM FOR THIS DRAWING IS VIRGINIA STATE PLANE COORDINATE
NAD83 VA SOUTH AND VERTICAL DATUM IS NAVD 88.

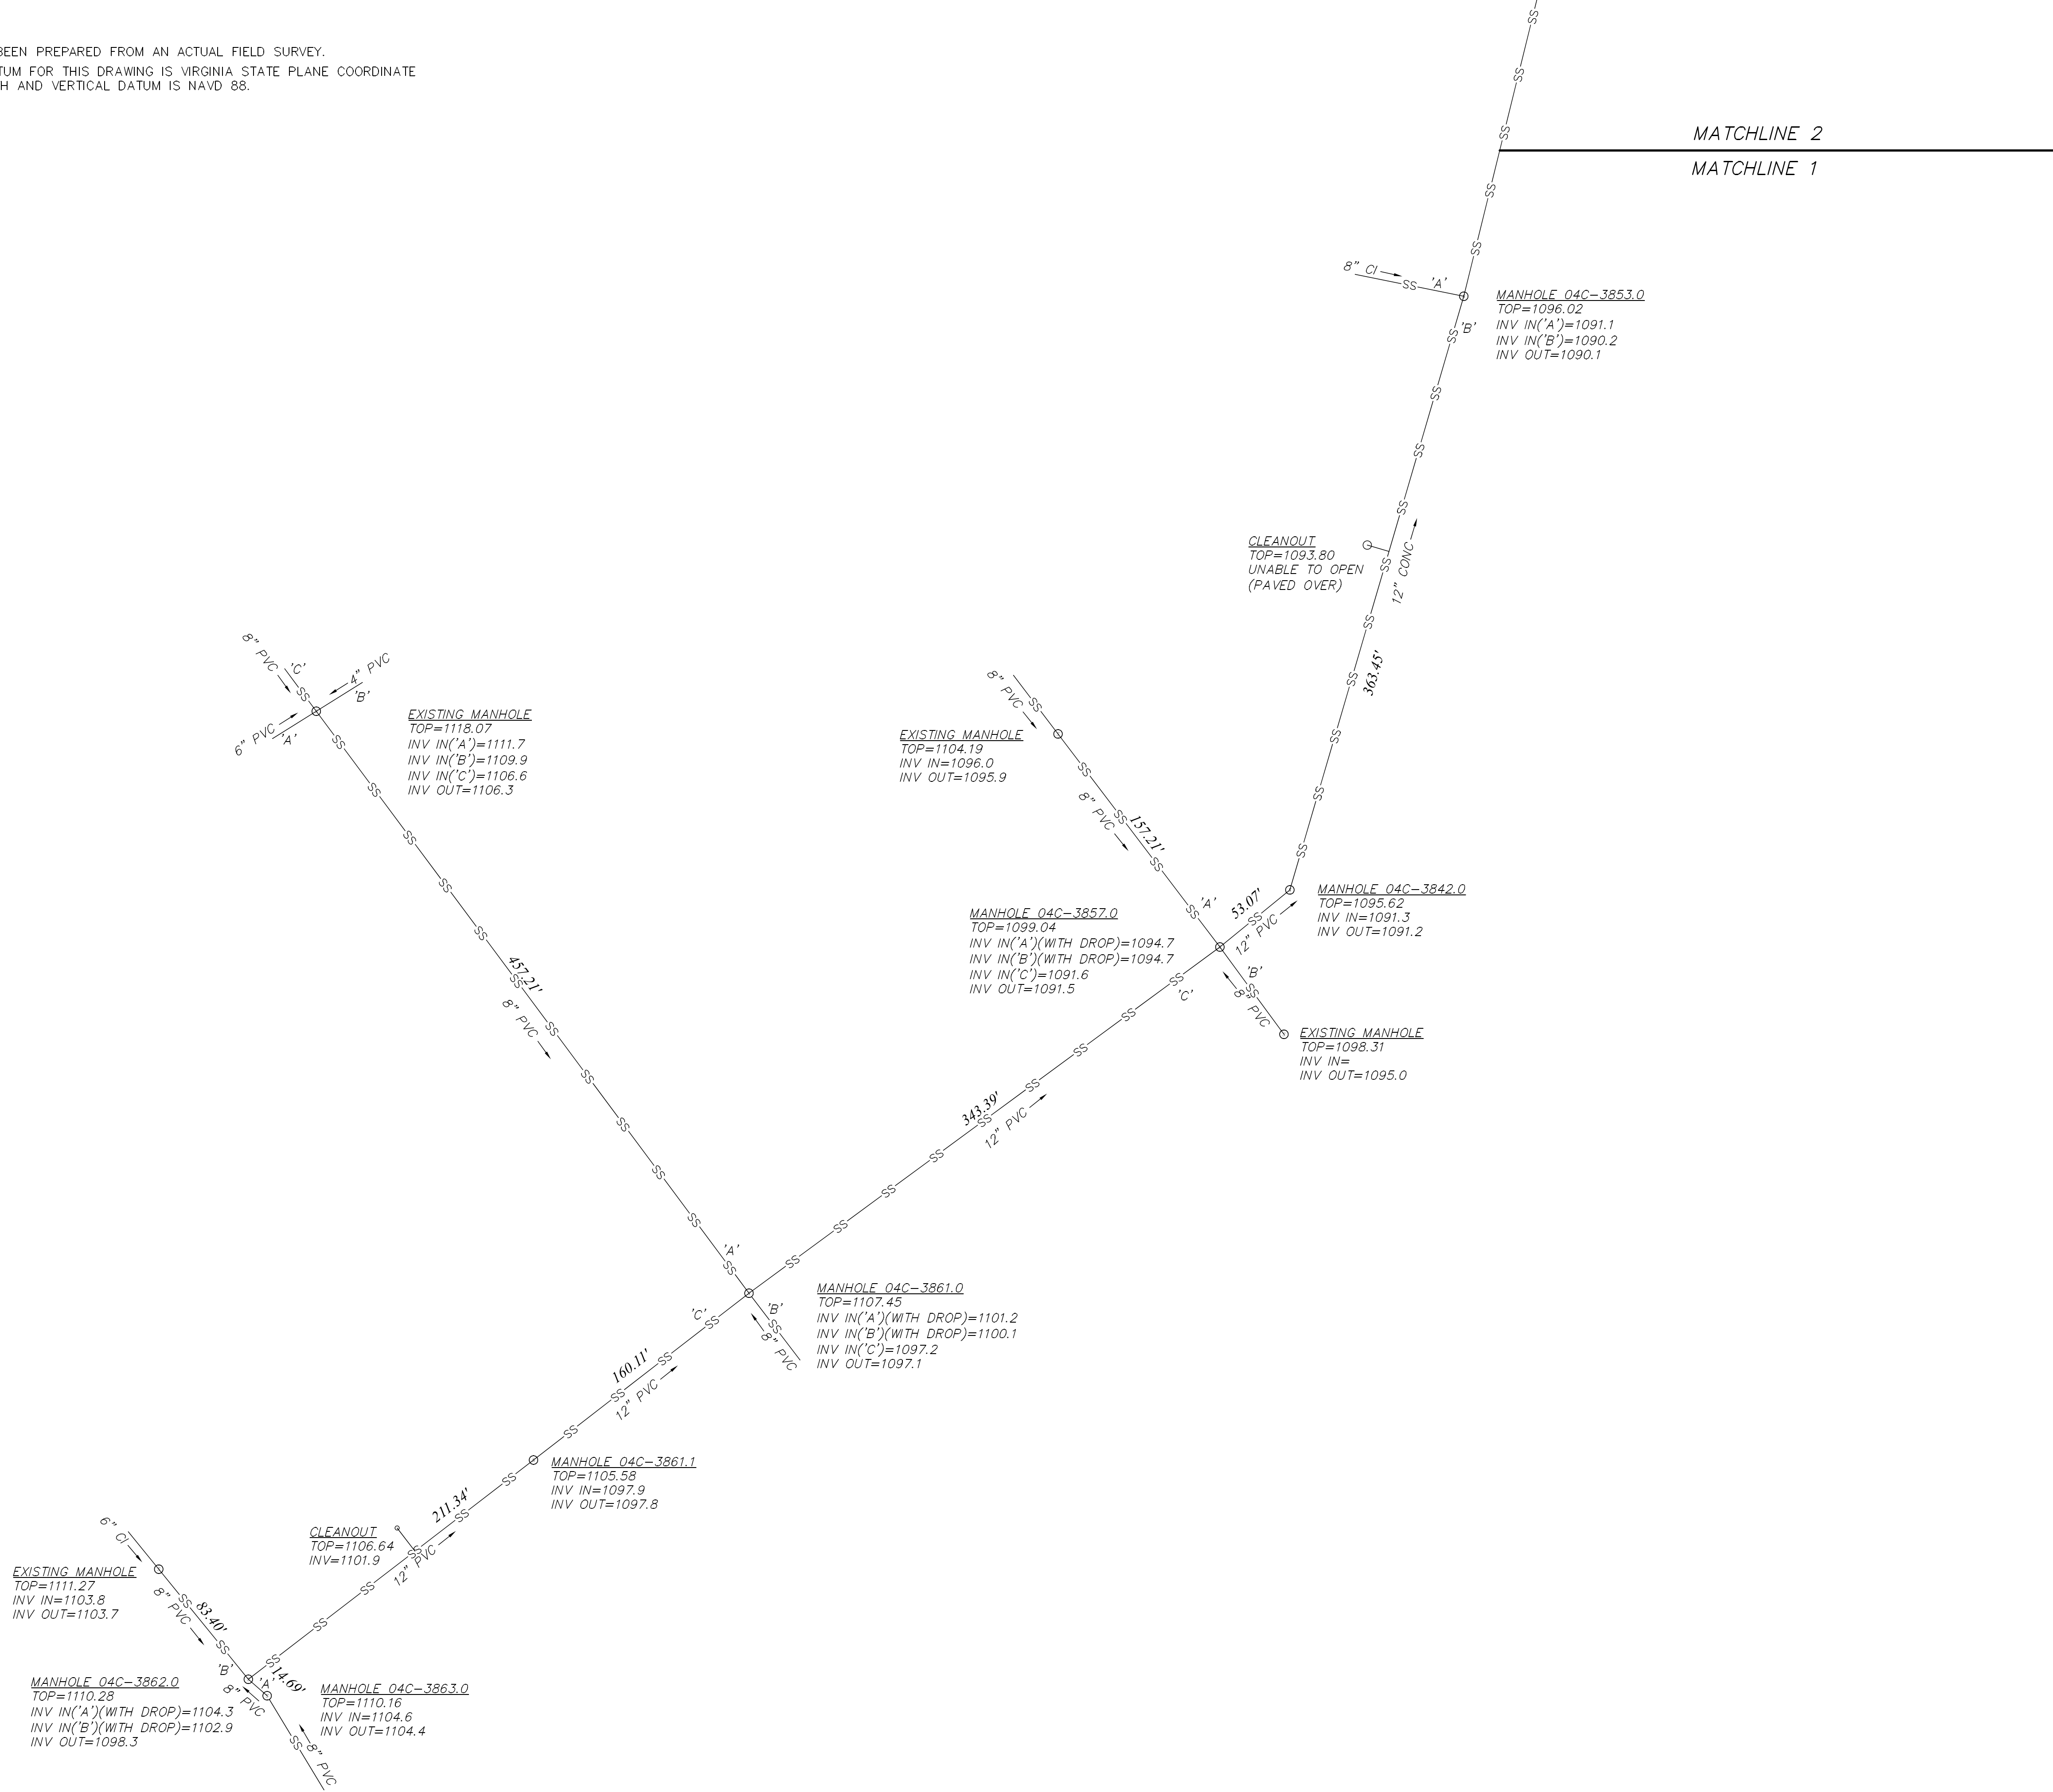

105 NORTH MAIN ST.
GRETNVA, VA 24557
434-656-1051

ARMSTRONG & ASSOCIATES
SURVEYING, PLANNING, DEVELOPMENT

ARMSTRONGANDASSOCIATES.NET
RUCH@ARMSTRONGANDASSOCIATES.NET

ASBUILT MAP FOR
WESTERN VIRGINIA WATER AUTHORITY
AIRPORT ROAD TO PALM VALLEY ROAD SANITARY SEWER REPLACEMENT
ROANOKE, VIRGINIA

PROJECT#:200168
DATE: 7-14-2021
DRAWN BY:JBT
SHEET 1 OF 3