


PLAN	SURVEYED	DATE
NO. 492	FLUSHED	
	ALIGNED	
	CHECKED	
	RT. OF WAY	
	CHECKED	

# AS BUILT

11-19-68  
 FB:492  
 PAGE:66 of 67

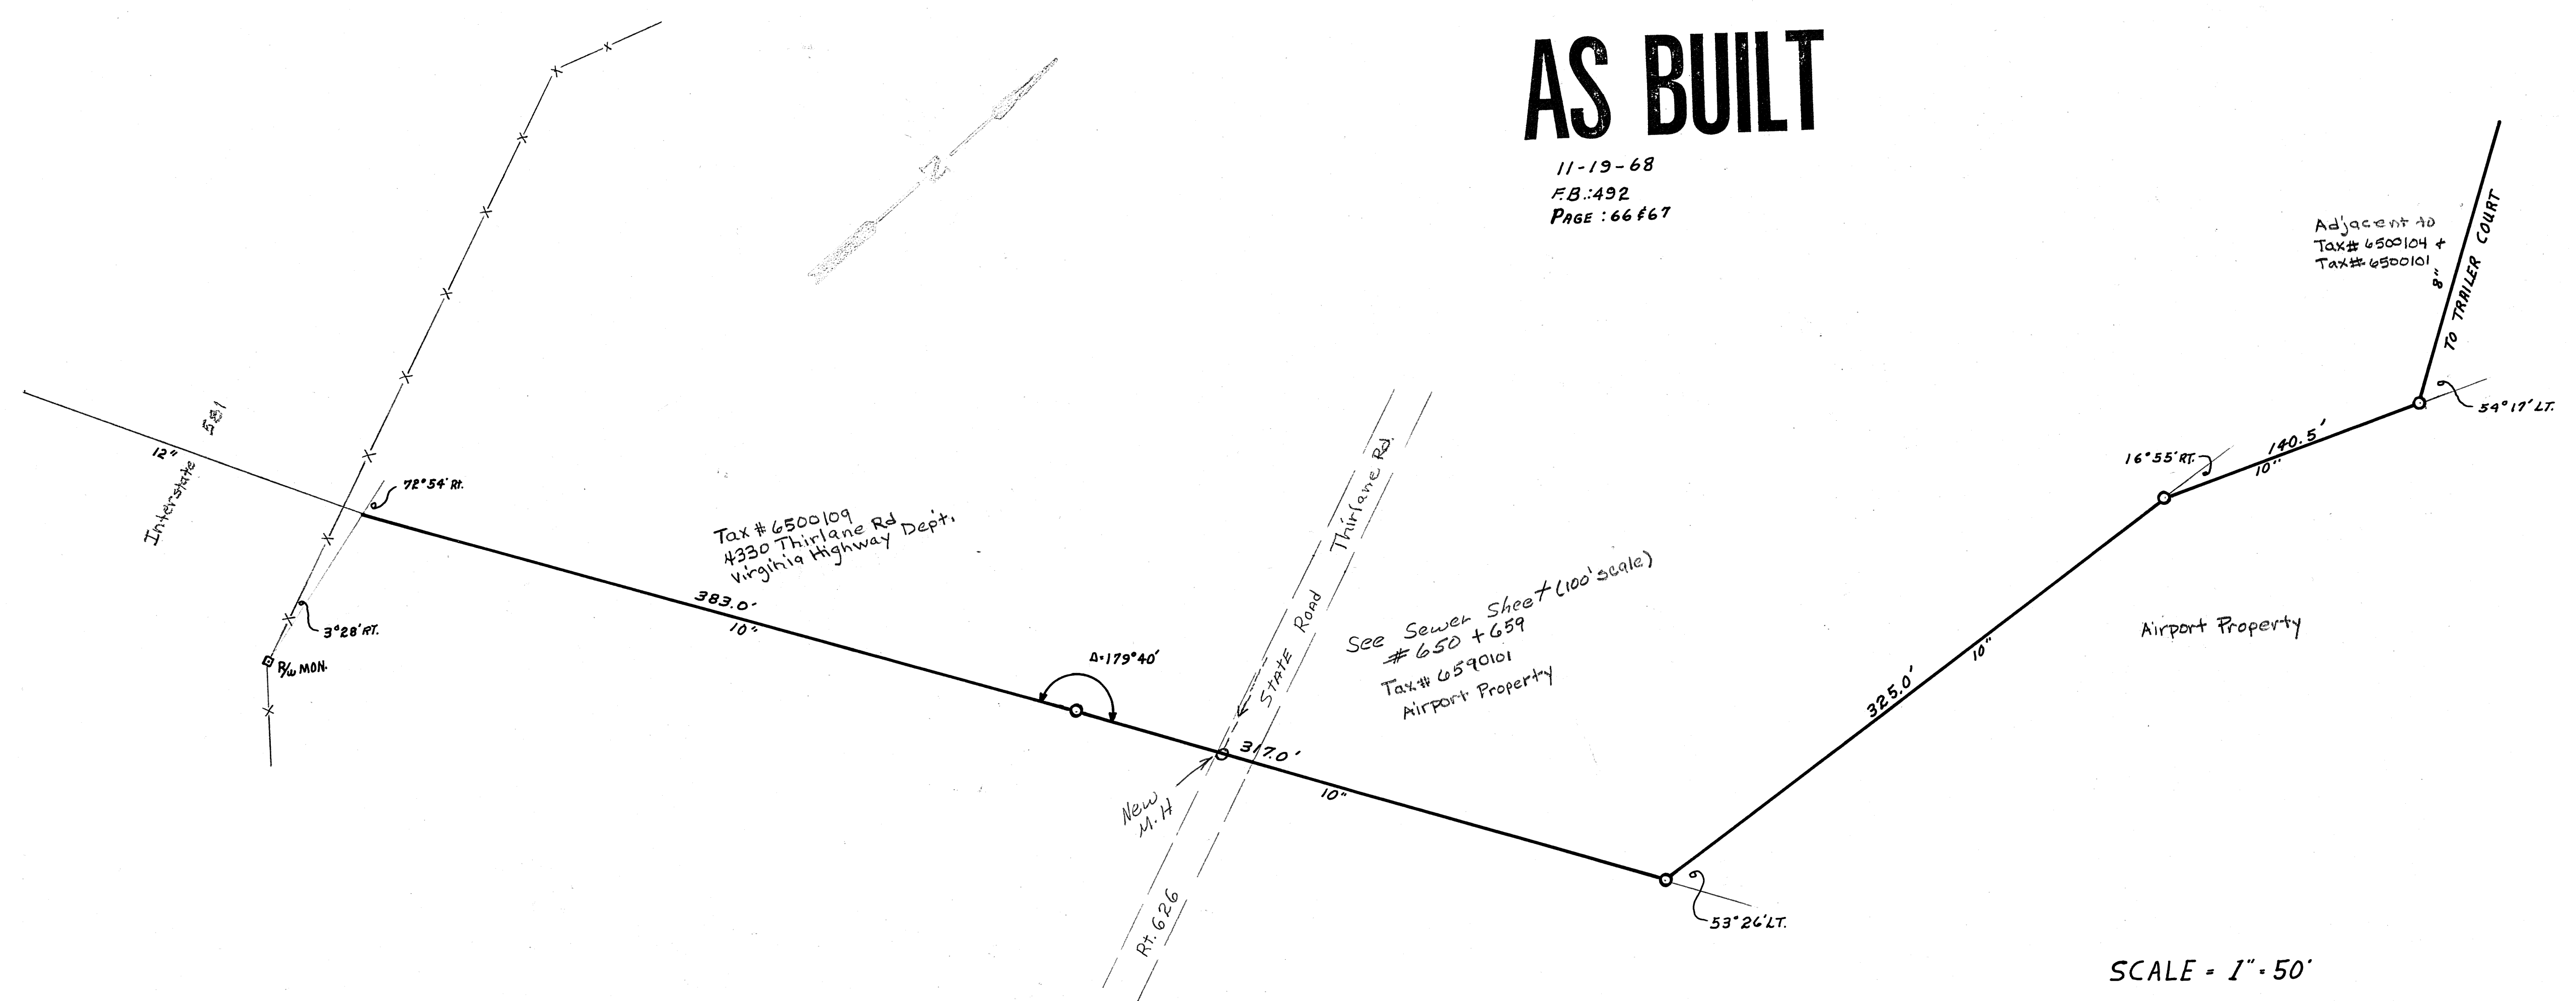

## AIRPORT TRAILER COURT SANITARY SEWER 11-19-68

SCALE = 1" = 50'

SCALE = 1" = 50' VERT.  
 1" = 10' HOR.

PROFILE	SURVEYED	DATE
NO. 492	FLUSHED	
	ALIGNED	
	CHECKED	
	STRUCTURE	
	NOTATIONS	
	CHKD.	

