

PLAN	DATE	BY
1/2/54		
1/2/54		
1/2/54		

E CURVE DATA
P.C. 240+92.57
P.T. 241+84.03
L 251.2
TAN. 46.54
RAD. 200.00
ARC. 91.46
CHD. 90.66
N. 71°19'E.

ADJOINING PROPERTY OF
LUTHER B. VAUGHN & WIFE

E CURVE DATA
P.C. 244+15.66
P.T. 245+77.81
L 245.71
TAN. 40.43
RAD. 150.00
ARC. 162.75
CHD. 159.89
N. 87°13'E.

E CURVE DATA
P.C. 246+07.56
P.T. 248+17.59
L 80°13'30"
TAN. 126.37
RAD. 150.00
ARC. 216.03
CHD. 193.29
N. 85°11'15"E.

E CURVE DATA
P.C. 257+81.19
P.T. 258+84.34
L 47°16'42"
TAN. 54.71
RAD. 125.00
ARC. 163.15
CHD. 165.24
N. 16°26'09"E.


E CURVE DATA
P.C. 260+81.86
P.T. 263+99.73
L 48°34'
TAN. 169.19
RAD. 375.00
ARC. 517.87
CHD. 508.44
N. 31°29'12"W.

PROPERTY OF
ARROW WOOD COUNTRY CLUB, INC.

PROPERTY OF
ARROW WOOD COUNTRY CLUB, INC.

AS BUILT

PROFILE	DATE	BY
1/2/54		
1/2/54		
1/2/54		

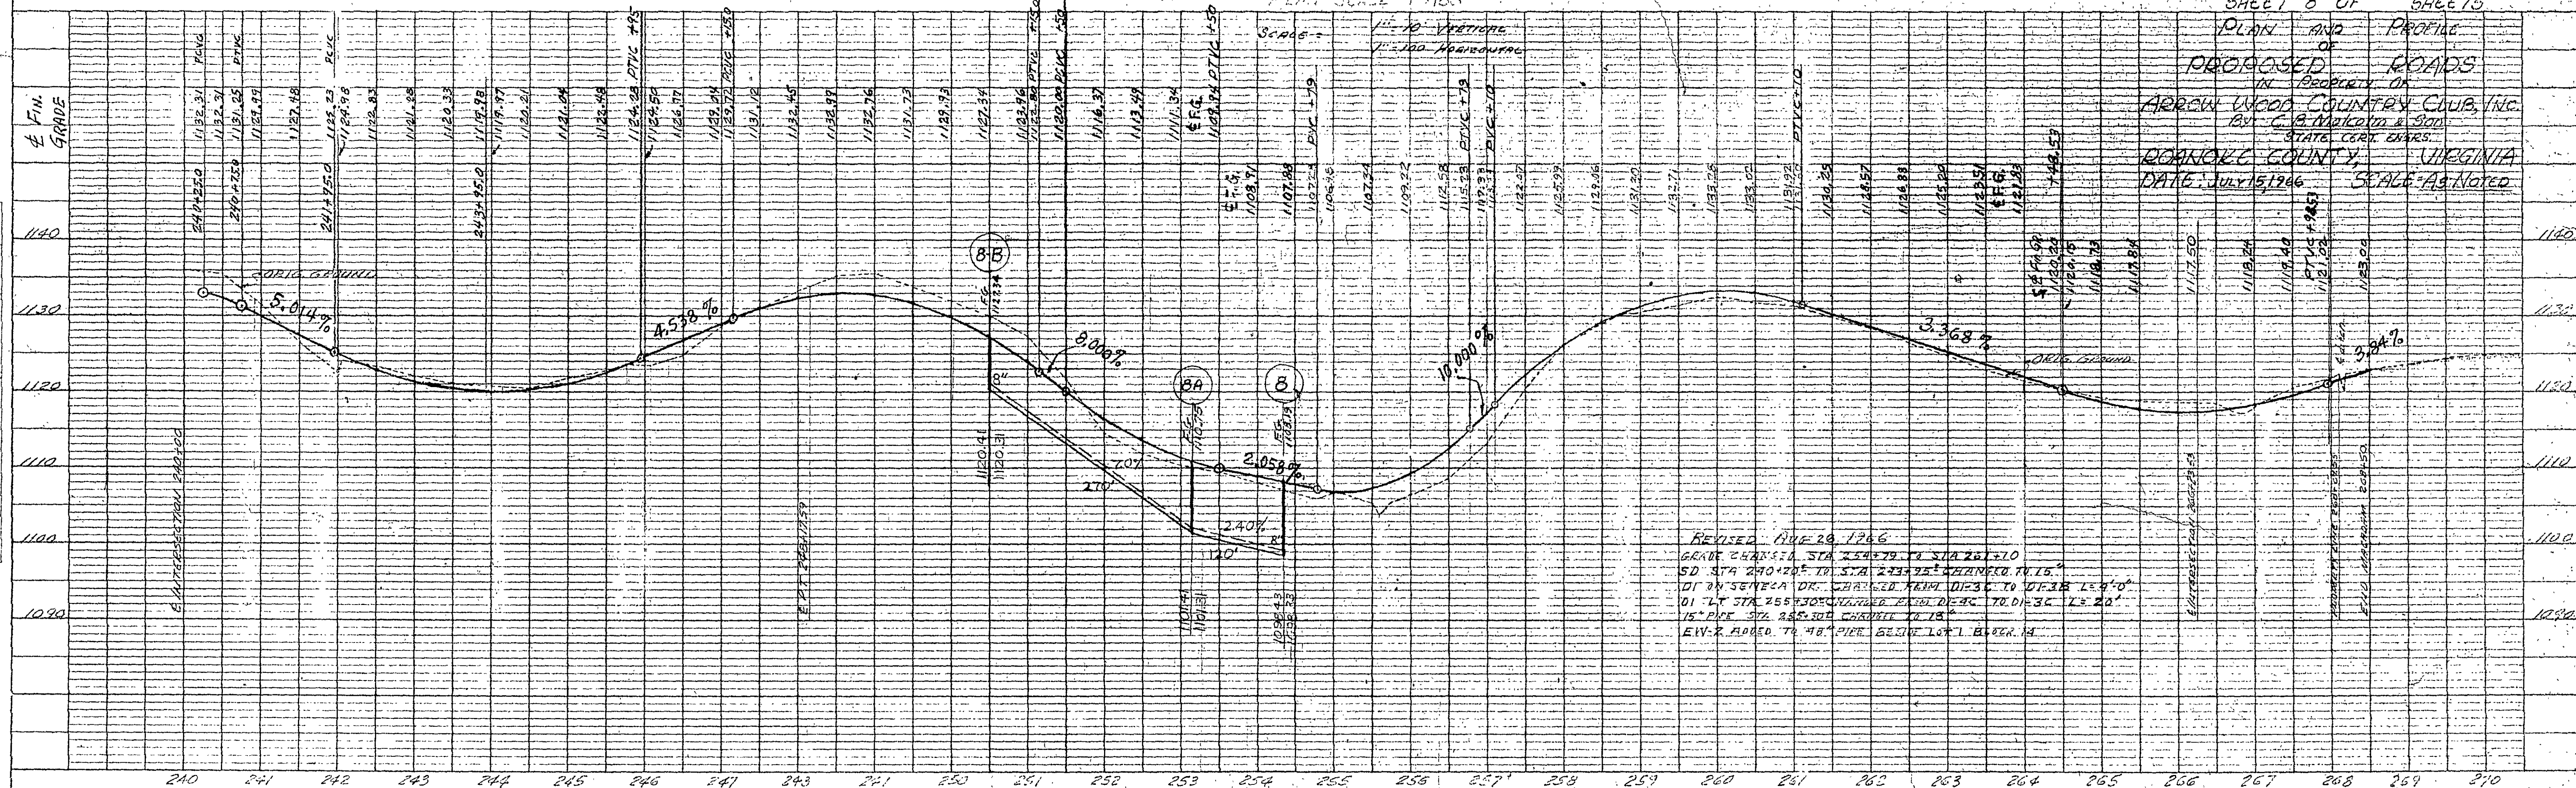

REVISED AUG 29, 1966
GRADE CHANGED STA 254+79 TO STA 261+10
SD STA 240+20 TO STA 243+72 CHANGED TO 15"
DI ON SENECA DR. CHANGED FROM DI-36 TO DI-36 L-4'-0"
DI LT STA 255+30 CHANGED FROM DI-36 TO DI-36 L-4'-0"
15" PIPE STA 265+30 CHANGED TO 18"
EW-2 ADDED TO 48" PIPE BEHIND LOT 1 BLOCK 14

SHEET 8 OF SHEETS
PLAN AND PROFILE
PROPOSED ROADS
IN PROPERTY OF
ARROW WOOD COUNTRY CLUB, INC.
BY C. B. McALPIN & SON
STATE CORP. ENGRS.
ROANOKE COUNTY, VIRGINIA
DATE: JULY 15, 1966 SCALE: AS NOTED