


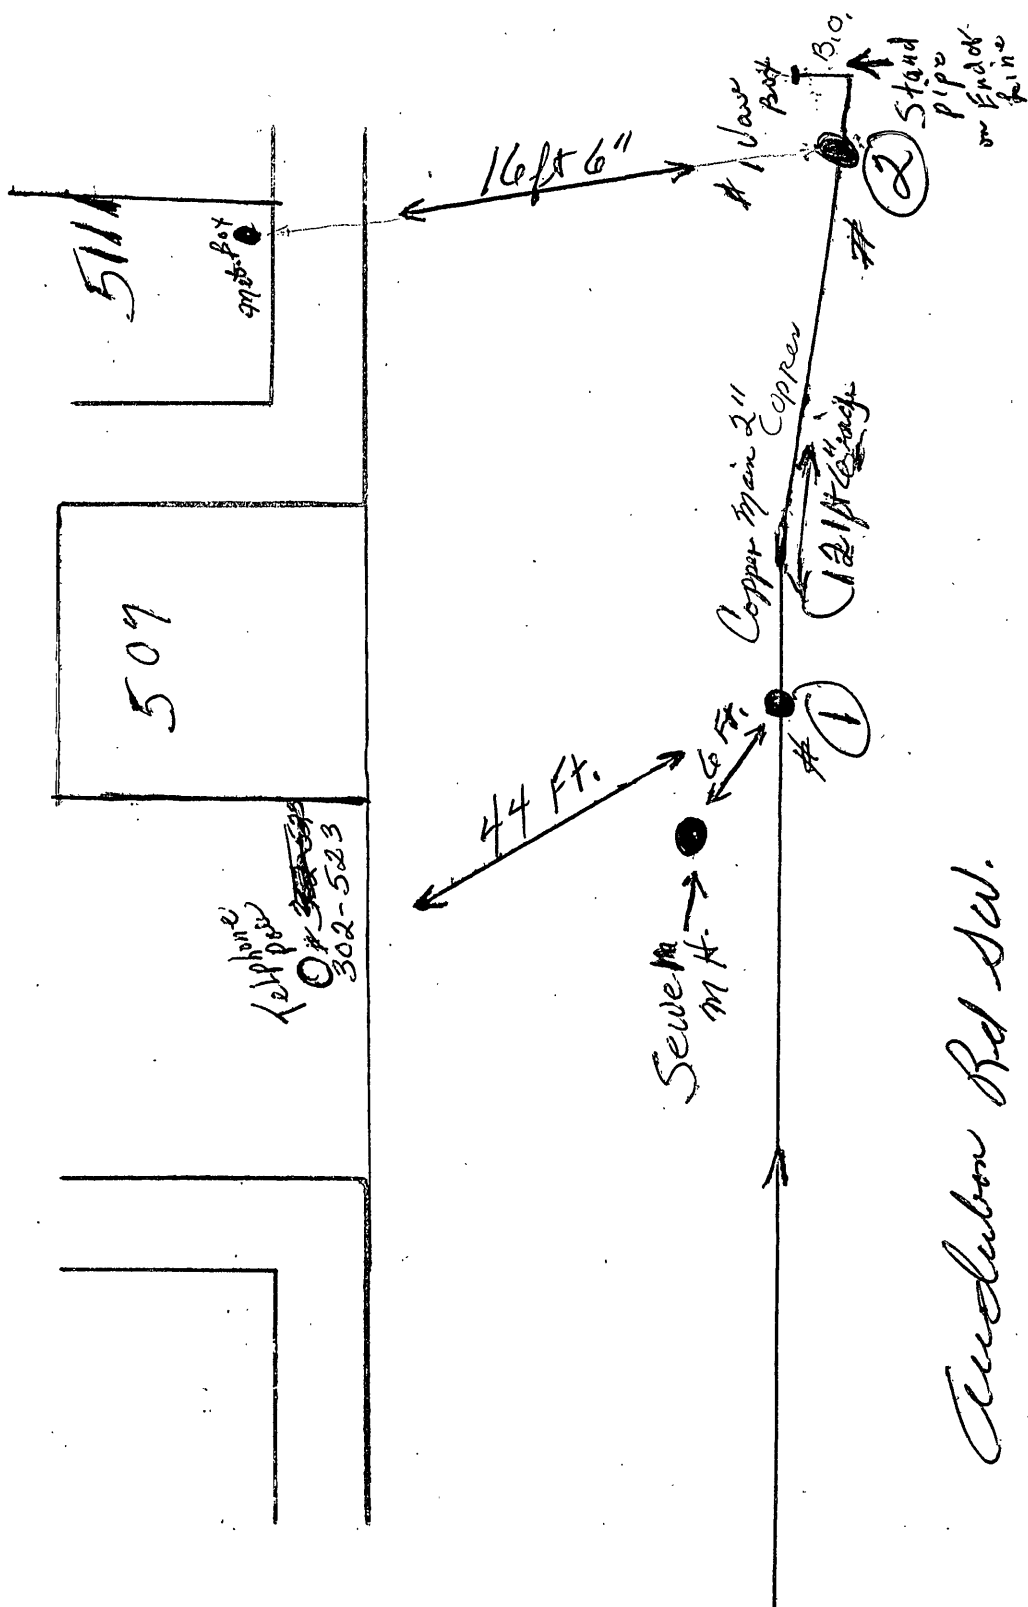

B.D. is 1' underground

Installed by Booth crew

DATE	NO.	SIZE	MAKE	OPEN	TURNS
5-13-91	1	2"	Date Valve Service	L	7
5-13-1991	2	2"	Date Valve Service	L	7

crossed over sewer

P. L. Measurements

No.	Distance	Direction
1	44 ft	South
2	6 ft. Sewer mt	Southeast
	ft. Meter Box	West

Note #1 Valve Box on each 2" Valve.

CITY OF ROANOKE - WATER DEPT.

VALVE DIAGRAM

511 Audubon Rd

SW

Sec. Map 107

Date

Page No.

Audubon Rd SW.