



**AUTUMN LANE SUBDIVISION
SITE DEVELOPMENT PLAN
CITY OF ROANOKE, VIRGINIA**

DRAWN BY: DME

DESIGNED BY: DME

CHECKED BY: _____

DATE: 4/15/03

SCALE: AS NOTED

REVISIONS

DATE	TIME	LOCATION	REMARKS
10/0			
9/0			
4/0			
9/0			
4/0			
20/0			

6	7	7	7	9	10				
---	---	---	---	---	----	--	--	--	--

1	2	3	466
---	---	---	---	---	---	---	---	---	----	----	-----	-----	
MMEN
ROKE
ROKE
RIMEN

C
R0
R0
DEPT

[illegible]

1	2	3	100
---	---	---	---	---	---	---	---	---	----	----	-----


RF	1	2	3	4	5	6		
----	---	---	---	---	---	---	--	--

SHEET NO. 1

613


LANDSCAPING & UTILITIES

03027

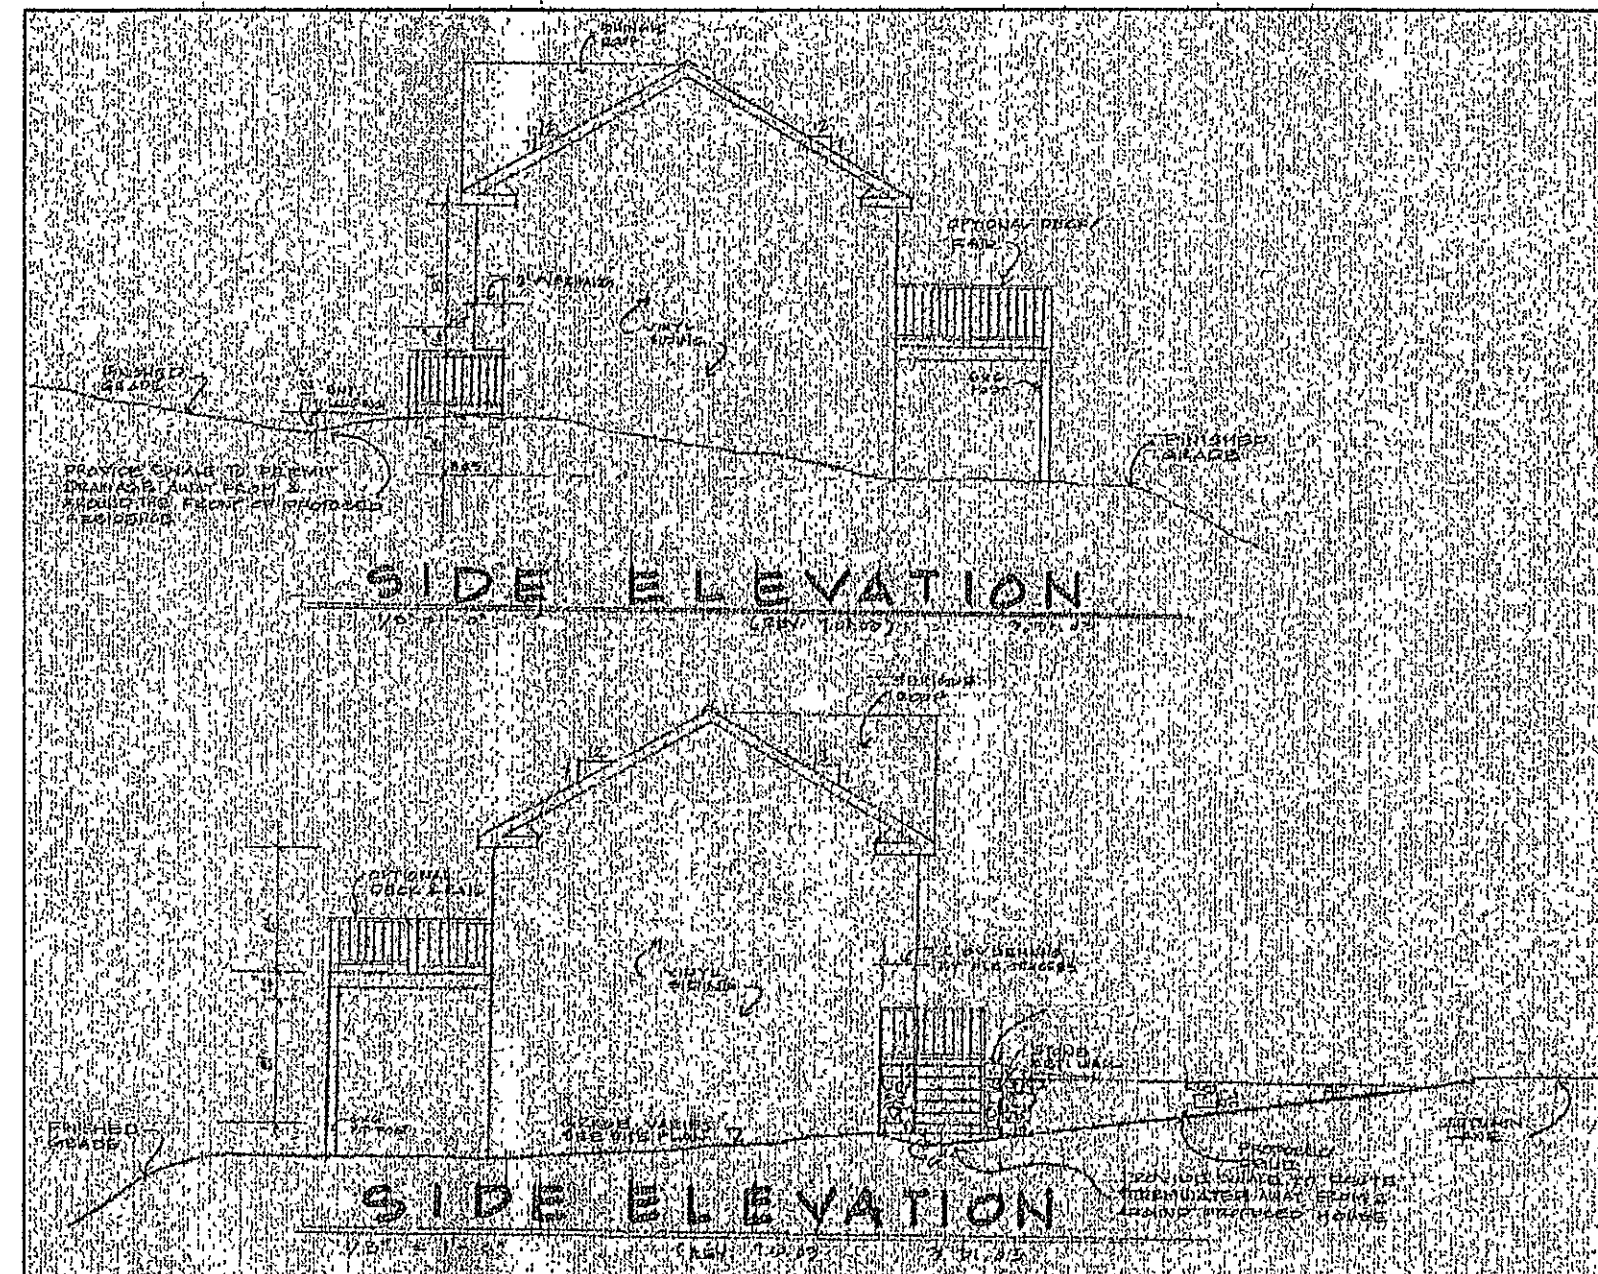


GENERAL NOTES:
1. BACKFILL FOR UTILITY TRENCHING IN THE RIGHT-OF-WAY SHALL BE VDOT STD 21A PLACED IN 6-INCH LOOSE LIFTS AND COMPACTED TO 95% STANDARD PROCTOR (+ OR - 20% OF OPTIMUM MOISTURE CONTENT. AS AN ALTERNATIVE, VDOT SPECIFIED FLOWABLE FILL WITH STRENGTH OF BETWEEN 30 AND 300 PSI AT 28 DAYS MAY BE USED.


SD-200 PROFILE

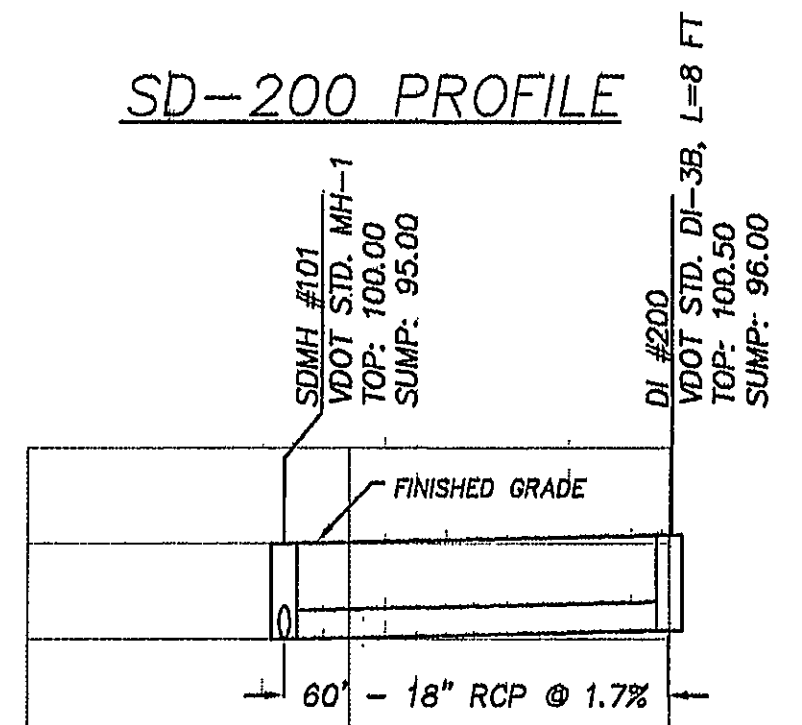

SD-100 PROFILE

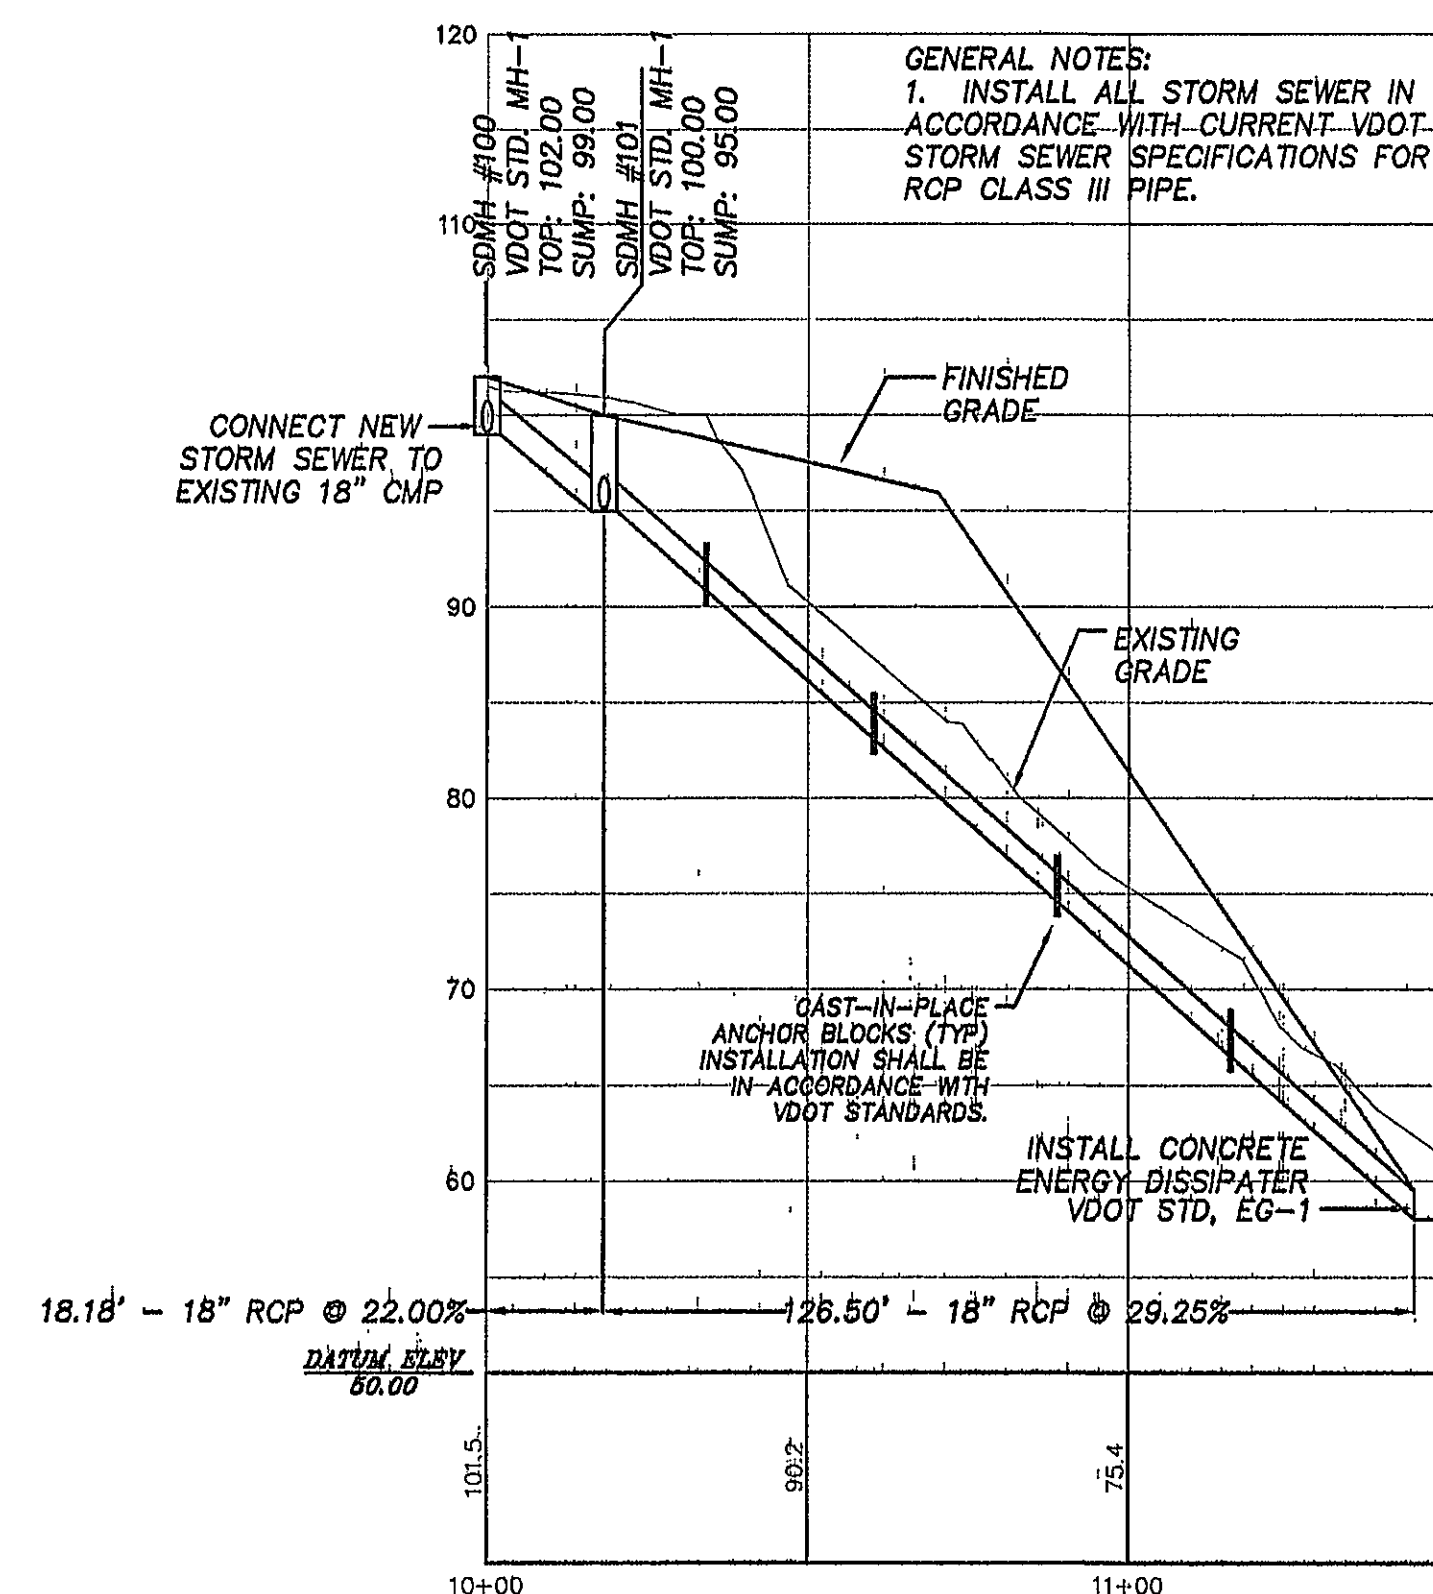

GENERAL NOTES:
1. USED REASONABLE CARE TO PROTECT EXISTING STREET TREES. RELOCATE STREET TREES ONLY AS NECESSARY.
2. THE EVERGREEN PLANTINGS SHOWN HEREON ARE INTENDED FOR SLOPE PROTECTION. THE CONTRACTOR SHALL INSTALL SEEDLINGS ON APPROXIMATE 15' CENTERS EACH WAY.
3. EVERGREEN SEEDLINGS SHALL BE INSTALLED WITH A 3'-FEET MINIMUM OFFSET FROM PROPOSED SEWER SERVICE CONNECTIONS.

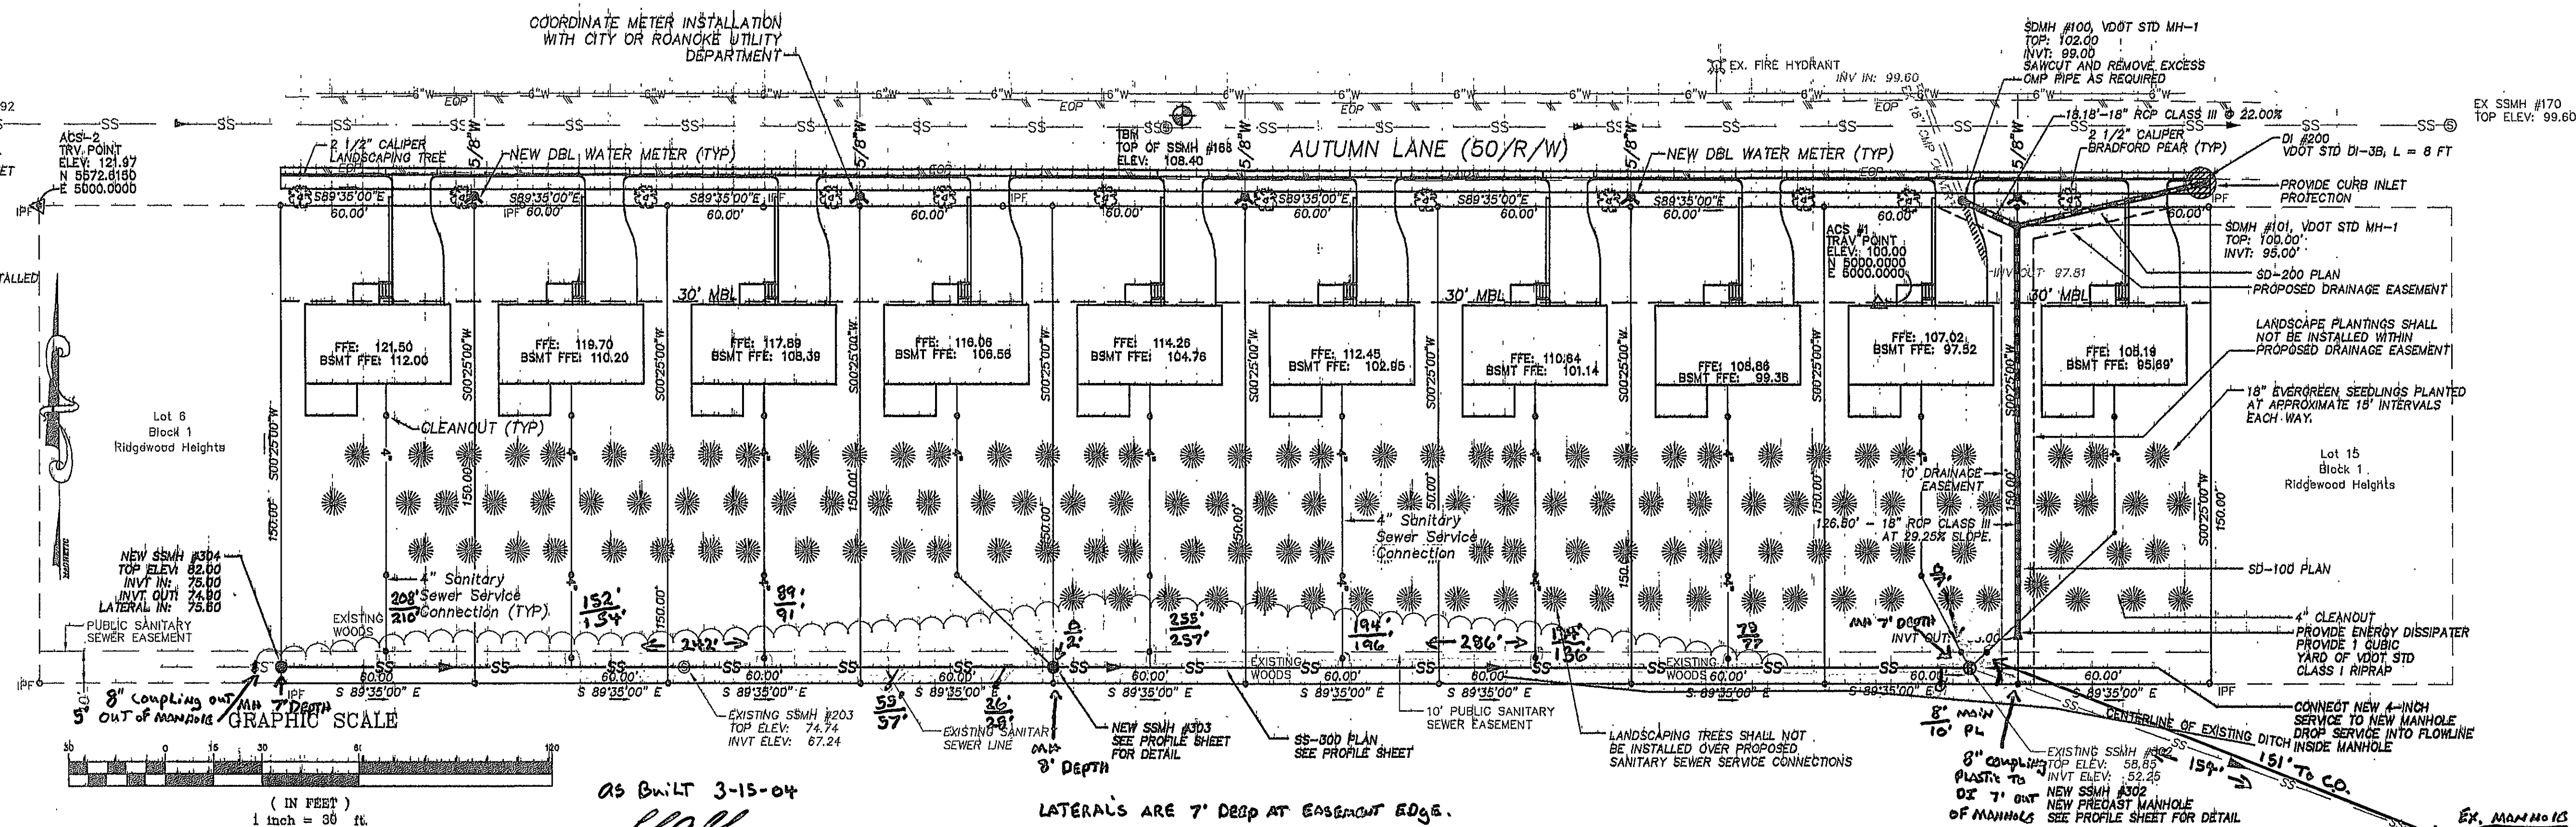

AS BUILT 3-15-04

LATERALS ARE 7' DEEP AT EASEMENT EDGE.



LANDSCAPING & UTILITIES

03027