

CONTRACTOR SHALL BE RESPONSIBLE FOR MAINTENANCE AND UNKEEP OF ALL EROSION AND SEDIMENT CONTROL MEASURES, SELF BENCE BARRIERS AND SLOTTED TUBES. TYPICAL TIE BACK CONTROLS, TIES, PERMANENT BARRIERS ARE IN PLACE. CULVERT RILE PROTECTION SHALL BE INSTALLED TO PROTECT ALL TIE BACKS FROM EROSION. ALL DISTURBED AREAS SHALL BE SEED, MULCH, AND RETURNED TO CONDITIONS BETTER THAN OR EQUAL TO PRIOR TO CONSTRUCTION.

2. ALL BACK SERVICES INCLUDING BACKFILL HAVE TO BE OPEN UP AND REPAIRS TO BE MADE.

3. CONTRACTOR SHALL COORDINATE CLEARING OF SITE WITH OWNER, NO TREES SHALL BE REMOVED WITHOUT PERMISSION OF OWNER.



4. UPON SITE INSPECTION, ADDITIONAL EROSION AND SEDIMENT CONTROL MEASURES MAY BE REQUIRED. IF ANY EROSION OR SEDIMENTATION IS OBSERVED, THE CONTRACTOR SHALL BE RESPONSIBLE FOR REPAIRS. IF INSTALLED MEASURES ARE DEEMED INADEQUATE.

5. BACKFILL HAVE TO BE RESTORED WITH A BASE LAYER OF STONE.

6. OWNER (WILSON PREMIER PROPERTIES) WILL BE RESPONSIBLE FOR PAYMENT OF RESTORATION.

7. TOPOGRAPHIC SURVEY DATA PREPARED BY CONESTOGUE LAND SURVEYING

SF	3.05 SILT FENCE
CIP	3.08 CULVERT INLET PROTECTION
PS	3.32 PERMANENT SEEDING

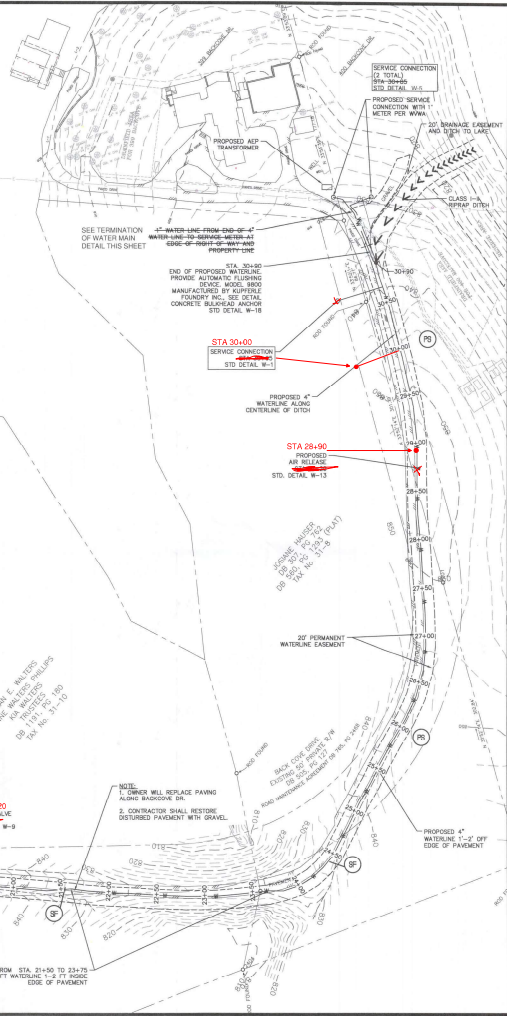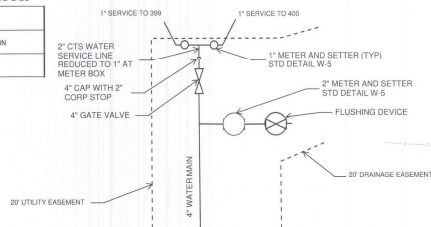

605 Wild Cherry RD.
Pilot VA, 24138
cfewster@blueidgeeks.com
(540) 392-4144

The drawing, design, and digital files relating to this project are the property of Foresight Design Services. The reproduction, copying, or other use of this drawing without FDS's written consent is prohibited.

FRANKLIN COUNTY, VIRGINIA

[illegible]