


WWVA WATER AND SEWER NOTES

1. ALL CONSTRUCTION METHODS AND MATERIALS SHALL CONFORM TO THE LATEST EDITION OF THE DESIGN AND CONSTRUCTION STANDARDS AND SPECIFICATIONS OF THE WESTERN VIRGINIA WATER AUTHORITY (WWVA) AVAILABLE AT WWW.WESTERNVAWATER.ORG OR BY CONTACTING THE AUTHORITY AT 540-853-5700. THE PROJECT SHALL ALSO COMPLY WITH THE GOVERNING JURISDICTION'S STANDARDS AND OTHER AGENCY STANDARDS (E.G., VDOT, DEQ, DCR, VDH, ETC.) WHERE APPLICABLE.
2. A MINIMUM COVER OF THREE (3) FEET IS REQUIRED ON ALL WWVA WATER AND SEWER LINES.
3. ALL EXISTING UTILITIES MAY NOT BE SHOWN IN THEIR EXACT LOCATIONS. THE CONTRACTOR SHALL NOTIFY MISS UTILITY AND SHALL VERIFY LOCATION AND ELEVATION OF ALL UNDERGROUND UTILITIES IN THE AREAS OF CONSTRUCTION PRIOR TO STARTING WORK.
4. PLEASE SHOW ALL WWVA WATER AND SEWER UTILITIES ON ANY DEVELOPMENT PLAN.
5. THE LOCATION OF EXISTING UTILITIES ACROSS OR ALONG THE LINE OF PROPOSED WORK ARE NOT NECESSARILY SHOWN ON THE PLANS AND WHERE SHOWN ARE ONLY APPROXIMATELY CORRECT. THE CONTRACTOR SHALL ON HIS OWN INITIATIVE AND AT NO EXTRA COST, LOCATE ALL UNDERGROUND LINES AND STRUCTURES AND POTHOLE AS NECESSARY. THE CONTRACTOR SHALL BE RESPONSIBLE FOR ANY DAMAGE TO UNDERGROUND STRUCTURES. ALL DAMAGE INCURRED TO EXISTING UTILITIES DURING CONSTRUCTION SHALL BE REPAIRED AT THE CONTRACTOR'S EXPENSE.
6. PLAN APPROVAL BY THE WWVA DOES NOT REMOVE THE CONTRACTOR'S RESPONSIBILITY TO REMOVE OR RELOCATE ANY EXISTING CONFLICTS FOUND DURING CONSTRUCTION.
7. ALL PRIVATE UTILITY CONSTRUCTION, I.E. PIPING, VALVES, HYDRANTS, METERS AND BOXES, CLEAN OUTS, SANITARY SEWER MANHOLES, BEDDING, ETC. SHALL COMPLY WITH THE CURRENT VIRGINIA STATEWIDE BUILDING CODE (INCLUDING AMENDMENTS).
8. THE CONTRACTOR SHALL MAINTAIN A MINIMUM OF 18" CLEARANCE VERTICALLY AND TWO (2) FOOT MINIMUM HORIZONTALLY FROM THE OUTSIDE OF PIPE TO OUTSIDE OF PIPE WITH ALL OTHER UNDERGROUND UTILITIES. WHERE THIS CANNOT BE ACHIEVED, ADDITIONAL MEASURES IN ACCORDANCE WITH WWVA STANDARDS SHALL BE ENFORCED.
9. ALL UTILITY GRADE ADJUSTMENTS SHALL BE IN ACCORDANCE WITH WWVA STANDARDS AND ARE THE RESPONSIBILITY OF THE CONTRACTOR.
10. FIELD CHANGES SHALL BE SUBMITTED BY THE ENGINEER OF RECORD TO THE LOCALITY AND APPROVED BY THE WWVA.
11. PRIOR TO REQUESTING SUBSTANTIAL COMPLETION INSPECTION BY THE WWVA, THE DEVELOPER MUST SUBMIT AS BUILTS FOR REVIEW AND APPROVAL.


Everything installed as per plans
and Specs - Red Dots are only
changes made

Richard Longenecker

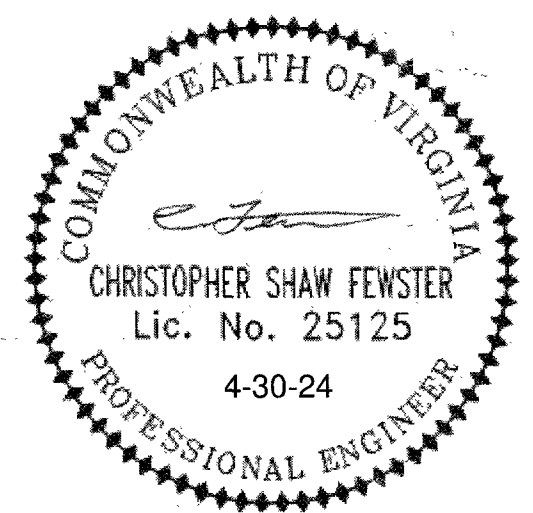

Blue Ridge Engineering &
Construction Services, LLC

406 Wild Cherry Rd.
Pilot VA 24138
cfewster@blueridgecs.com
(540) 392-4144

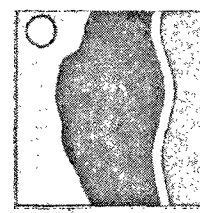

The drawing, design, and digital files relating to this project are the property of Foresight Design Services. The reproduction, copying, or other use of this drawing without FDS's written consent is prohibited.

BACK COVE DRIVE
WATERLINE EXTENSION
WILSON PREMIERE PROPERTIES
FRANKLIN COUNTY, VIRGINIA

REVISIONS		
NO.	COMMENTS	DATE
1	WWVA COMMENTS	4-30-24
PROJECT TEAM		
PRC	CHRIS S. FEWSTER, PE	
PW	CHRIS S. FEWSTER, PE	
DESIGN	SEC	
ISSUE DATE		
03/12/2024		
JOB NUMBER		
1090		
SHEET TITLE		
PROFILES		
SHEET NUMBER		
5 OF 7		