


DATE STARTED 2-17-04			
DATE COMP. 3-23-04			
FEET MAIN	SIZE	VALVE	VAULT BOX
1644	8"	YES	#2
4'	6"	NO	#1
F.H. COMP.	4 1/2'	6'	2 YES #2 2 NO #1
F.H. STUB ONLY			
SERV. INS. BY: [Signature]			
MAIN INS. BY: R. Weeks			
NO. 3" SERV. INS.			
CITY OR CO.			
DEPT. INSP. [Signature]			

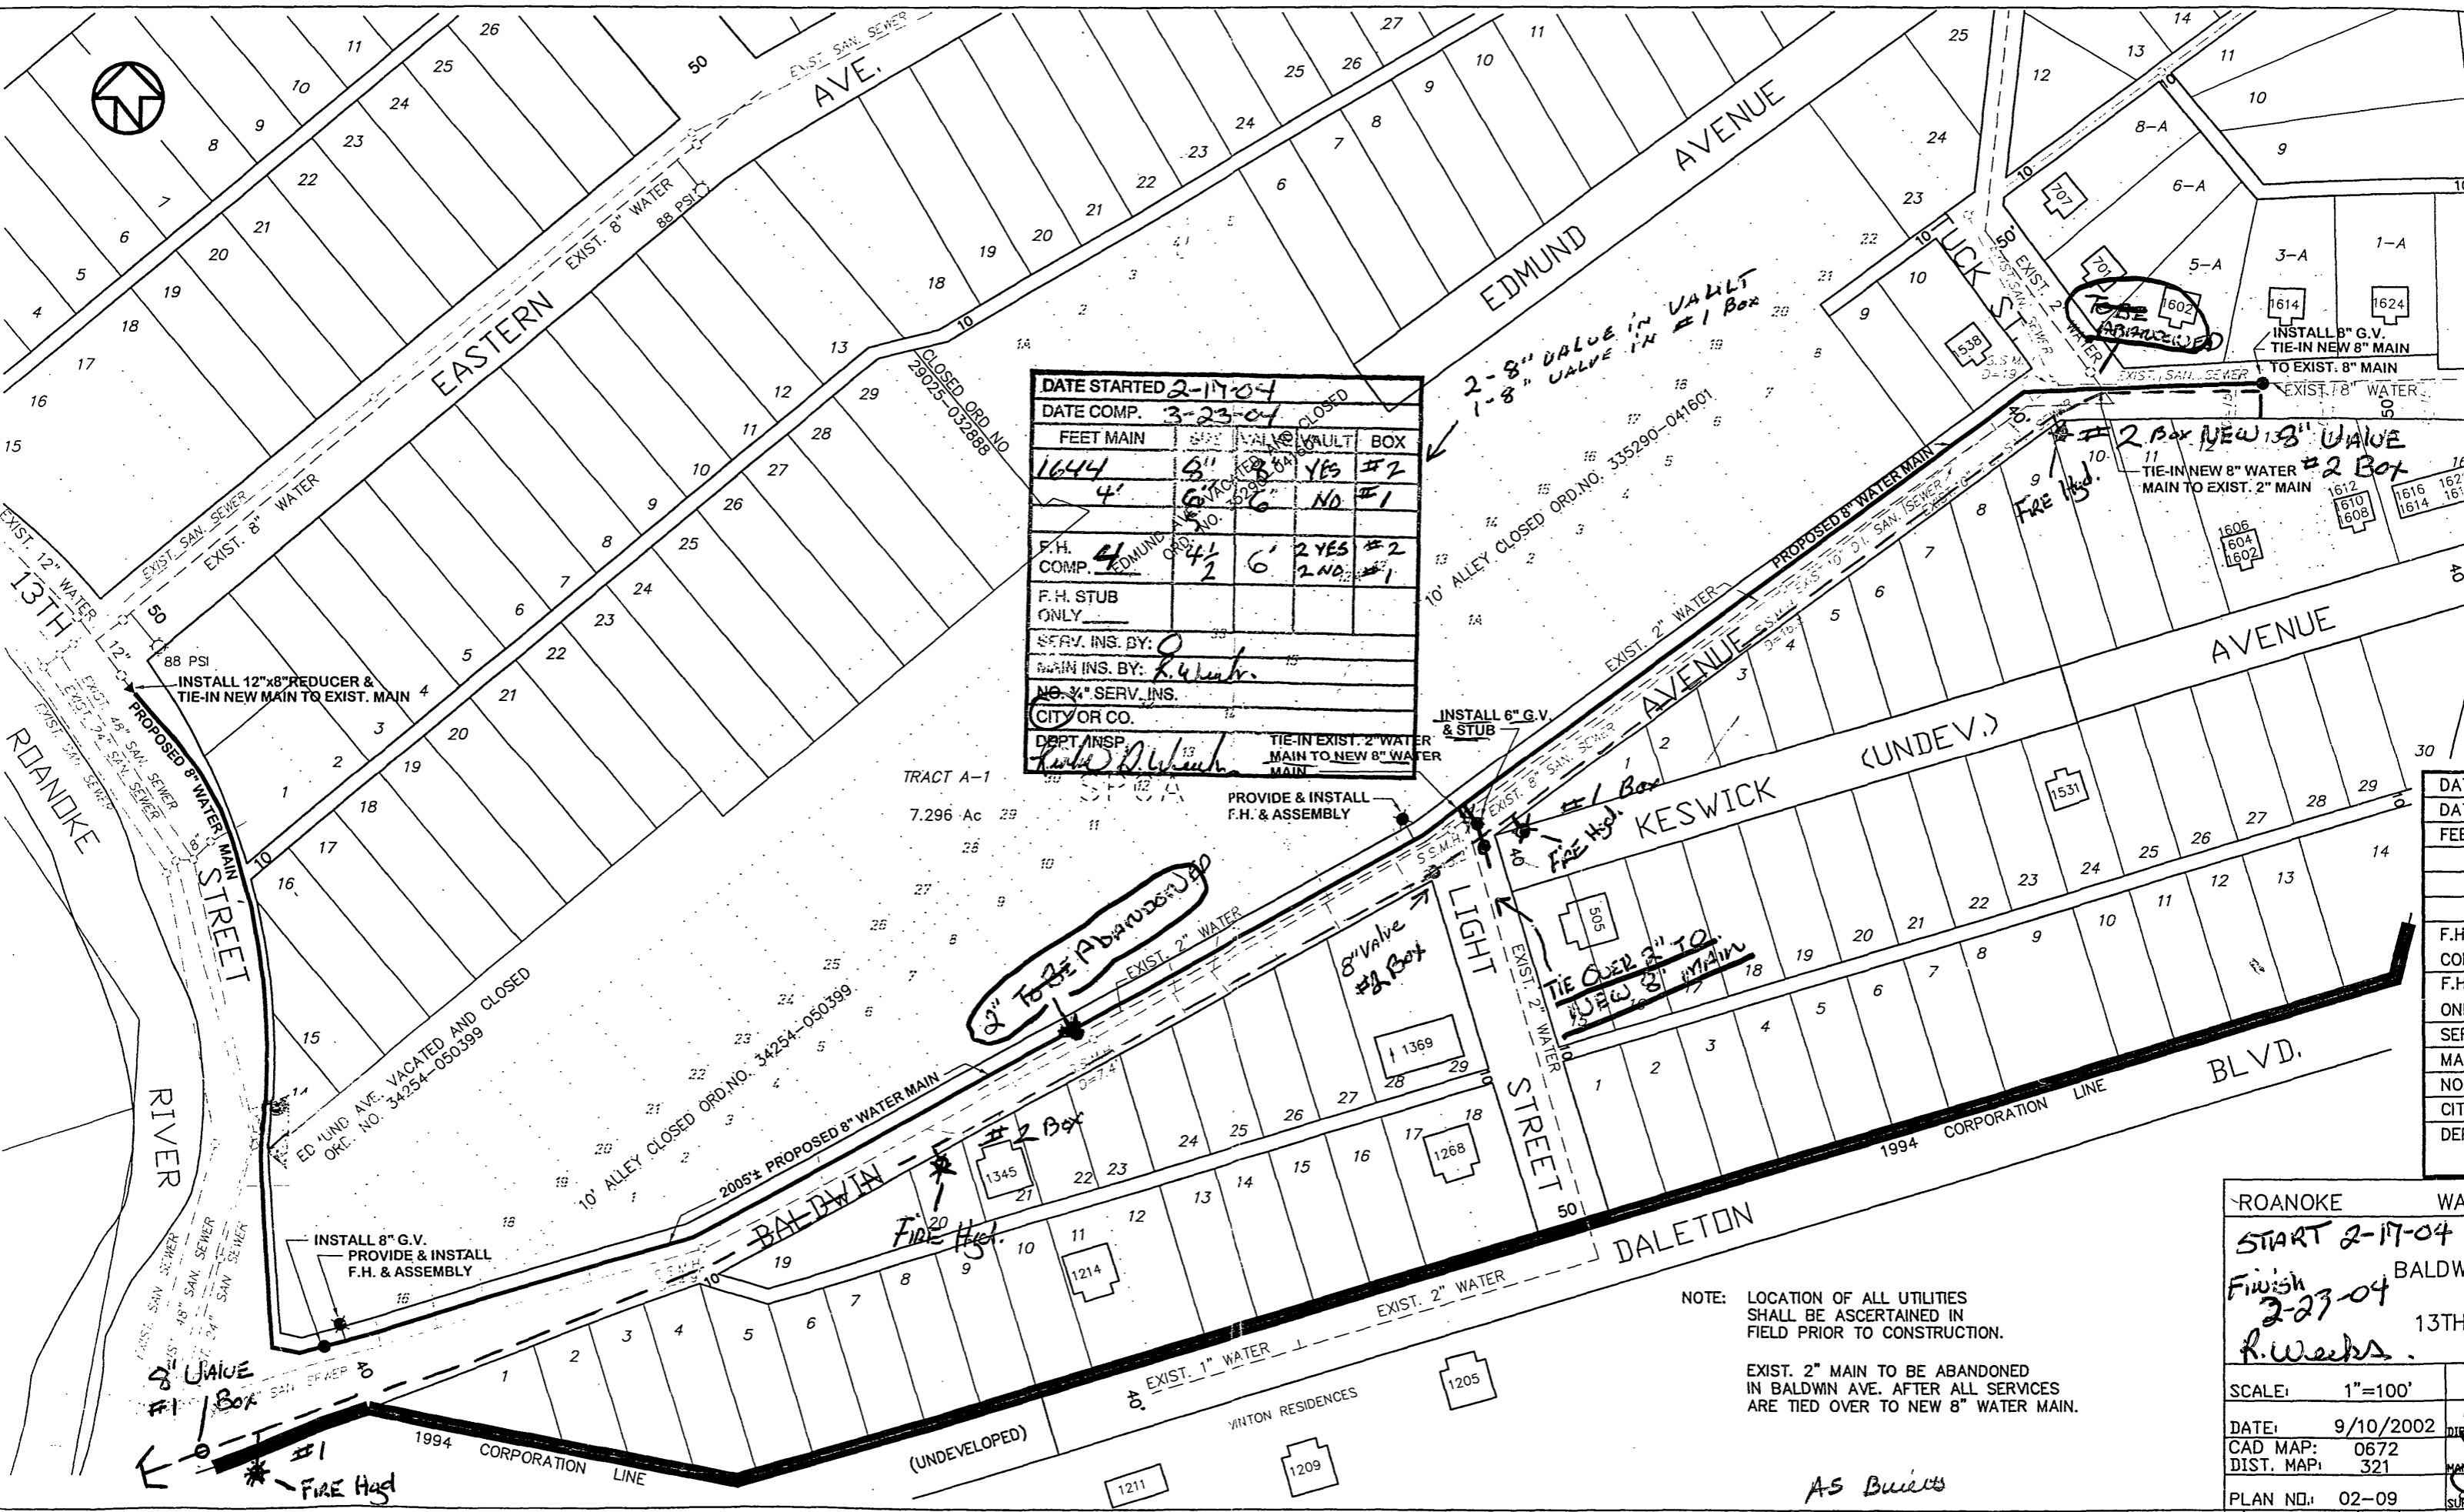

NOTE: LOCATION OF ALL UTILITIES SHALL BE ASCERTAINED IN FIELD PRIOR TO CONSTRUCTION.

EXIST. 2" MAIN TO BE ABANDONED IN BALDWIN AVE. AFTER ALL SERVICES ARE TIED OVER TO NEW 8" WATER MAIN.

DATE	
DATE	
FEET	
F.H.	
COM	
F.H.	
ONLY	
SERV	
MAIN	
NO.3	
CITY	
DEPT	

ROANOKE	WAT
START 2-17-04	BALDWIN
Finish 2-23-04	13TH S
R. Weeks	
SCALE: 1"=100'	
DATE: 9/10/2002	DIRECT
CAD MAP: 0672	MANAGE
DIST. MAP: 321	SUPER
PLAN NO: 02-09	

AS Built

done 14-26-04 JBR