




PLAN	DATE	
	DIV	
	SURVEY	
	NOTE BOOK	

PROFILE	DATE	
	DIV	
	SURVEY	
	NOTE BOOK	

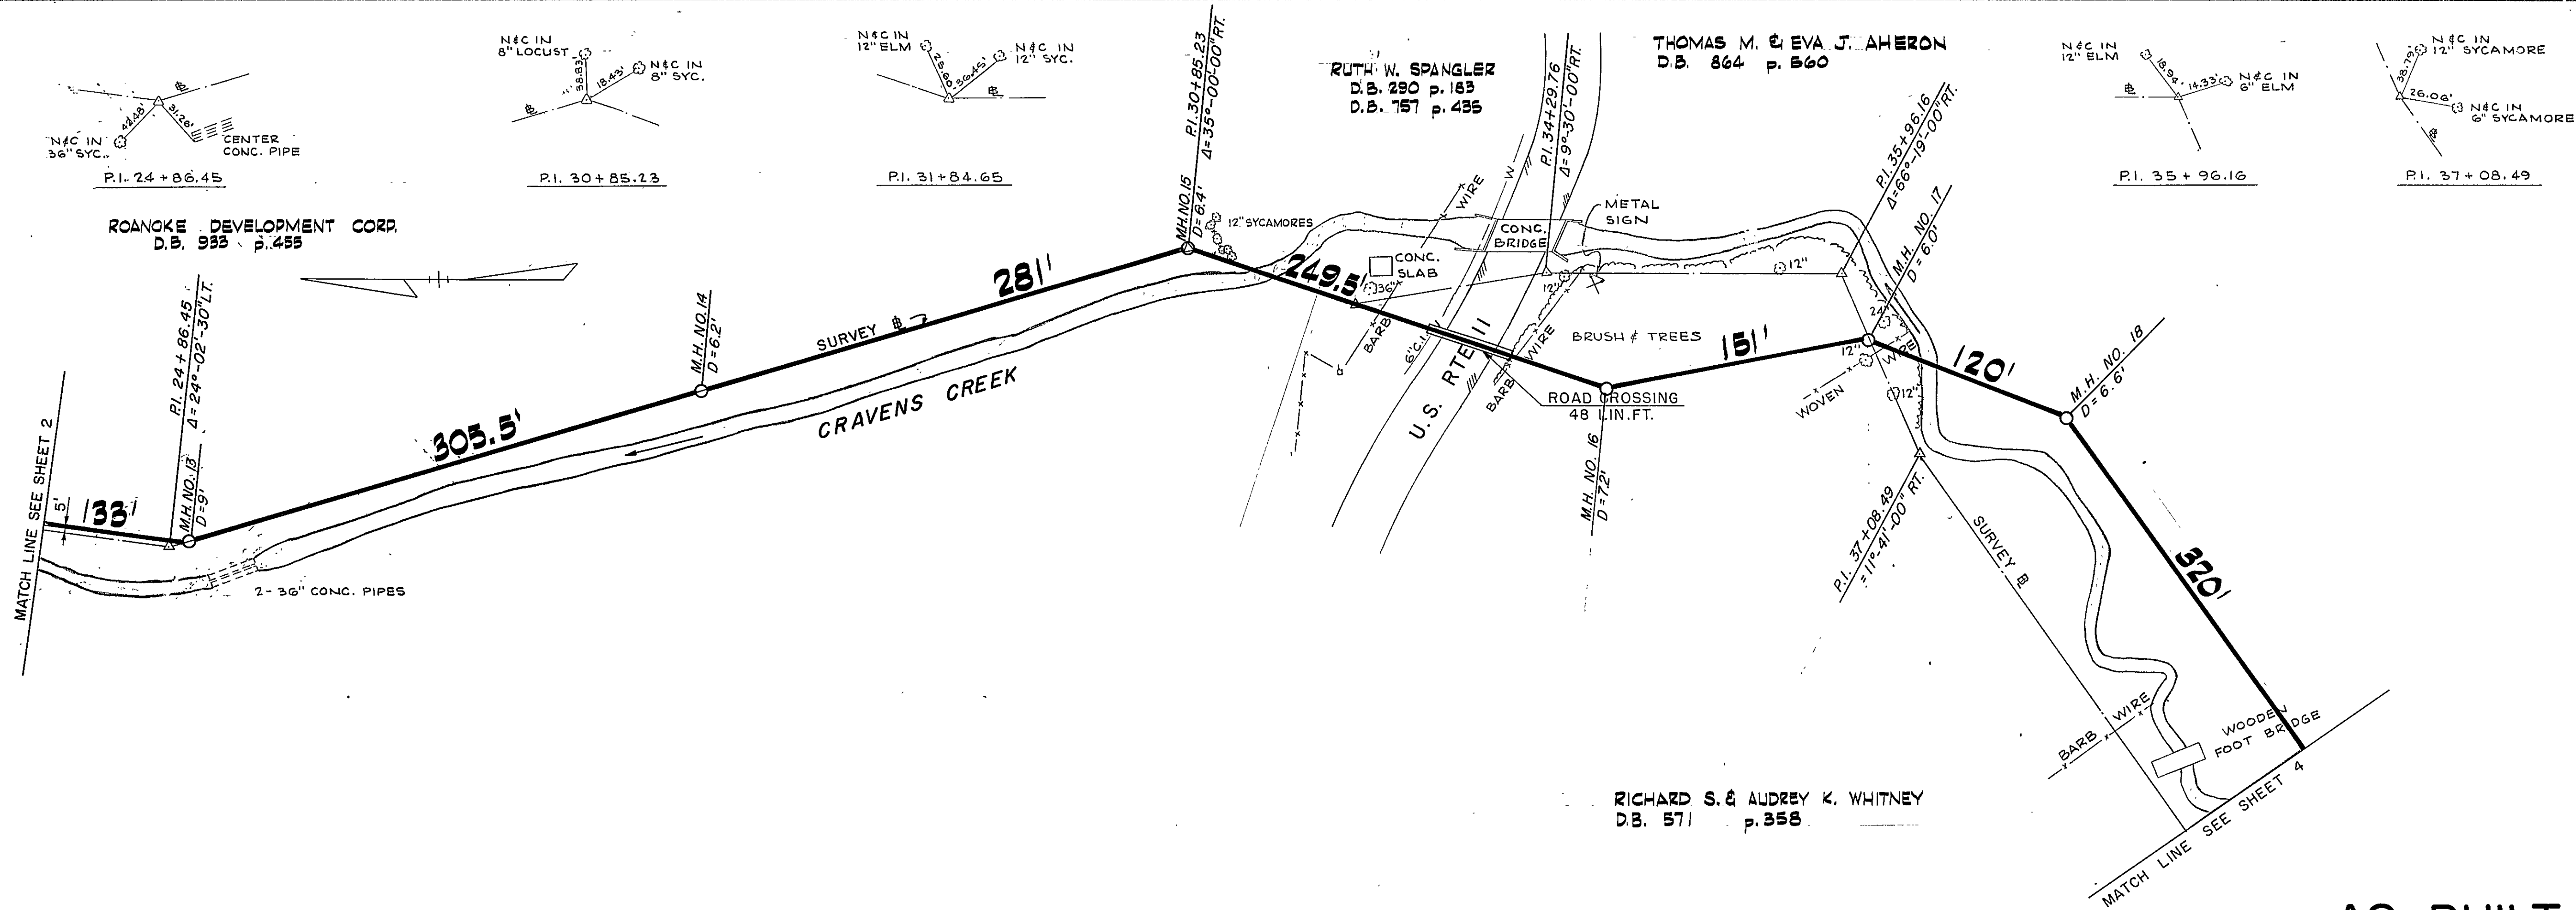

SCALE: 1 IN. = 50 FT.

AS BUILT

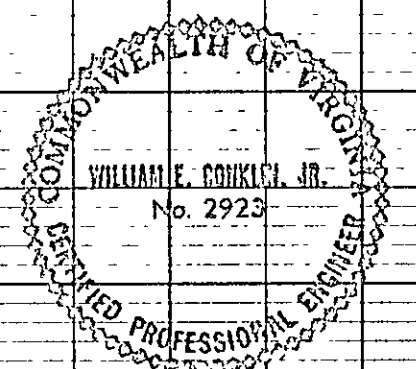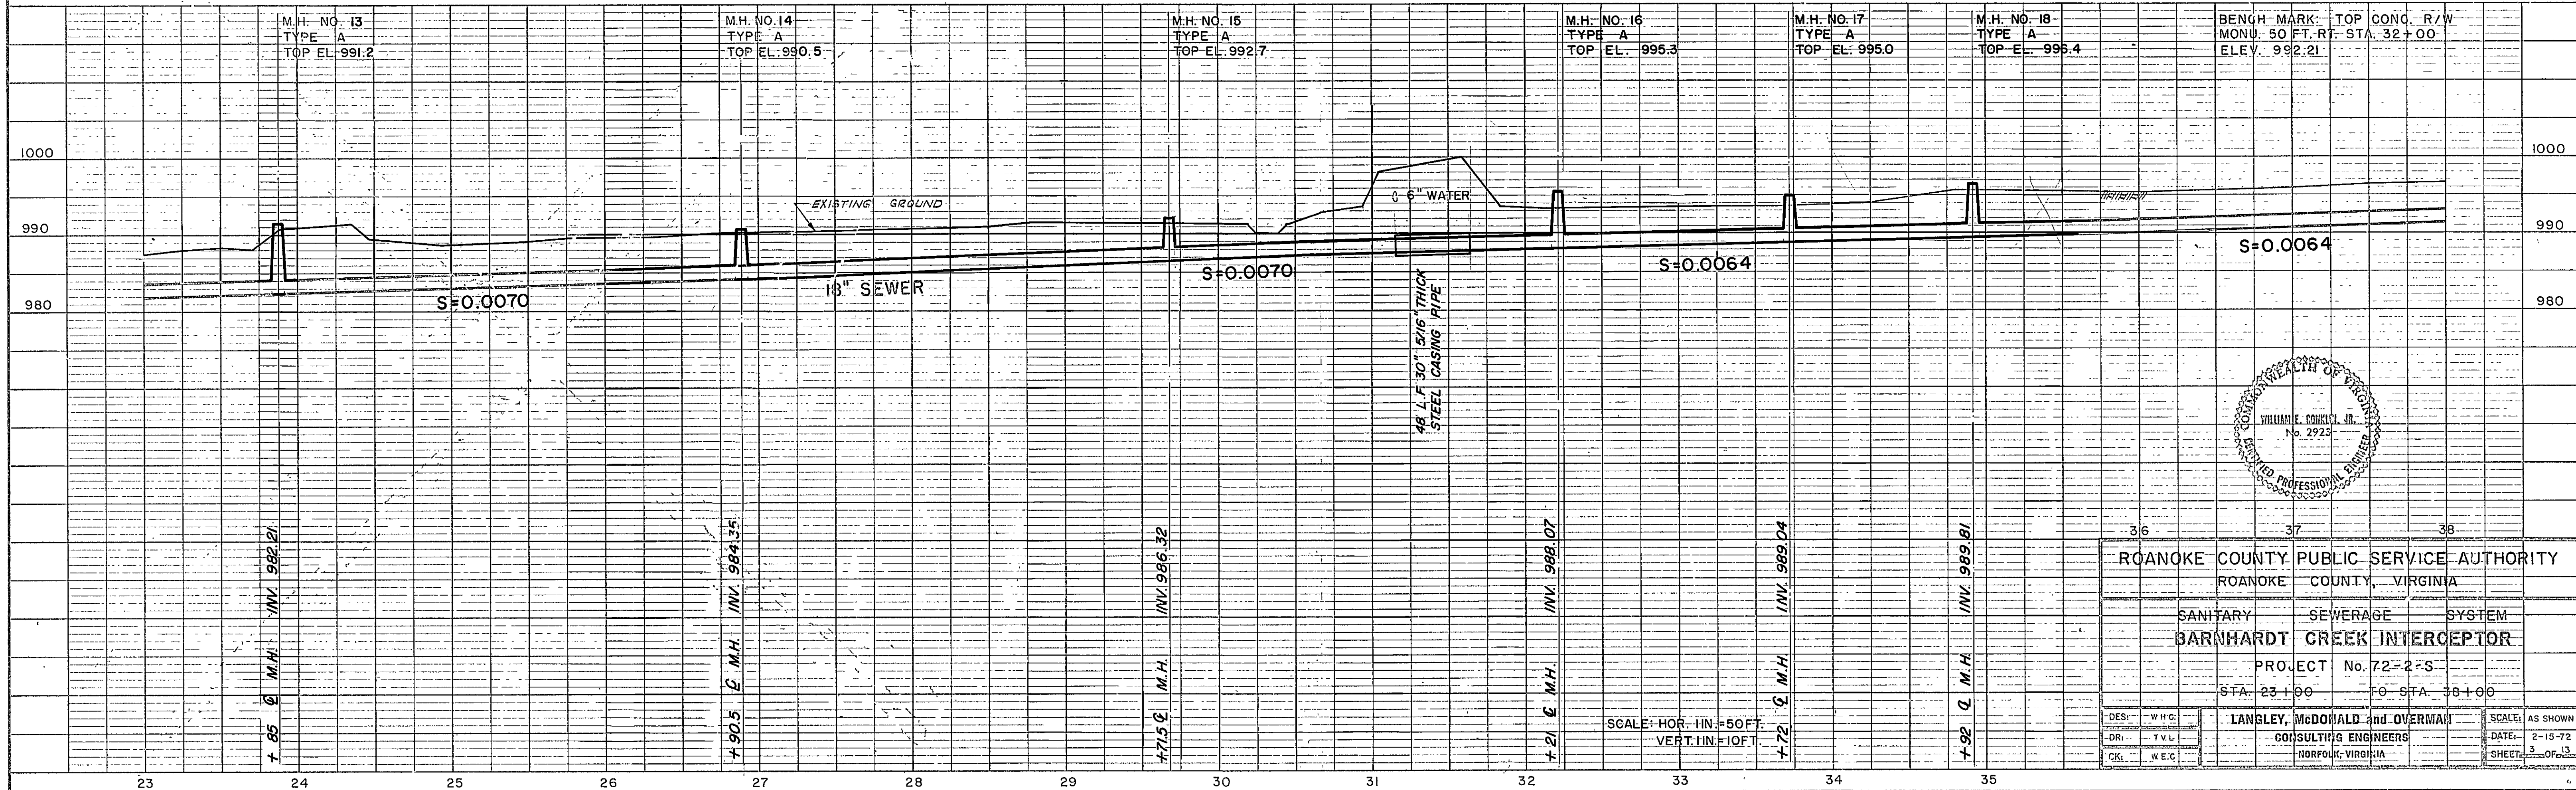

ROANOKE COUNTY PUBLIC SERVICE AUTHORITY		
ROANOKE COUNTY, VIRGINIA		
SANITARY	SEWERAGE	SYSTEM
BARNHARDT CREEK INTERCEPTOR		
PROJECT No. 72-2-S		
STA. 23+00	TO STA. 38+00	
DES: W.H.C.	LANGLEY, McDONALD and OVERMAN	SCALE: AS SHOWN
DR: T.M.	CONSULTING ENGINEERS	DATE: 2-15-72
CHK: W.E.C.	NORFOLK, VIRGINIA	SHEET 3 OF 13