




PLAN	DATE	
	BY	
	SURVEYED	
	NOTED	

PROFILE	DATE	
	BY	
	SURVEYED	
	NOTED	

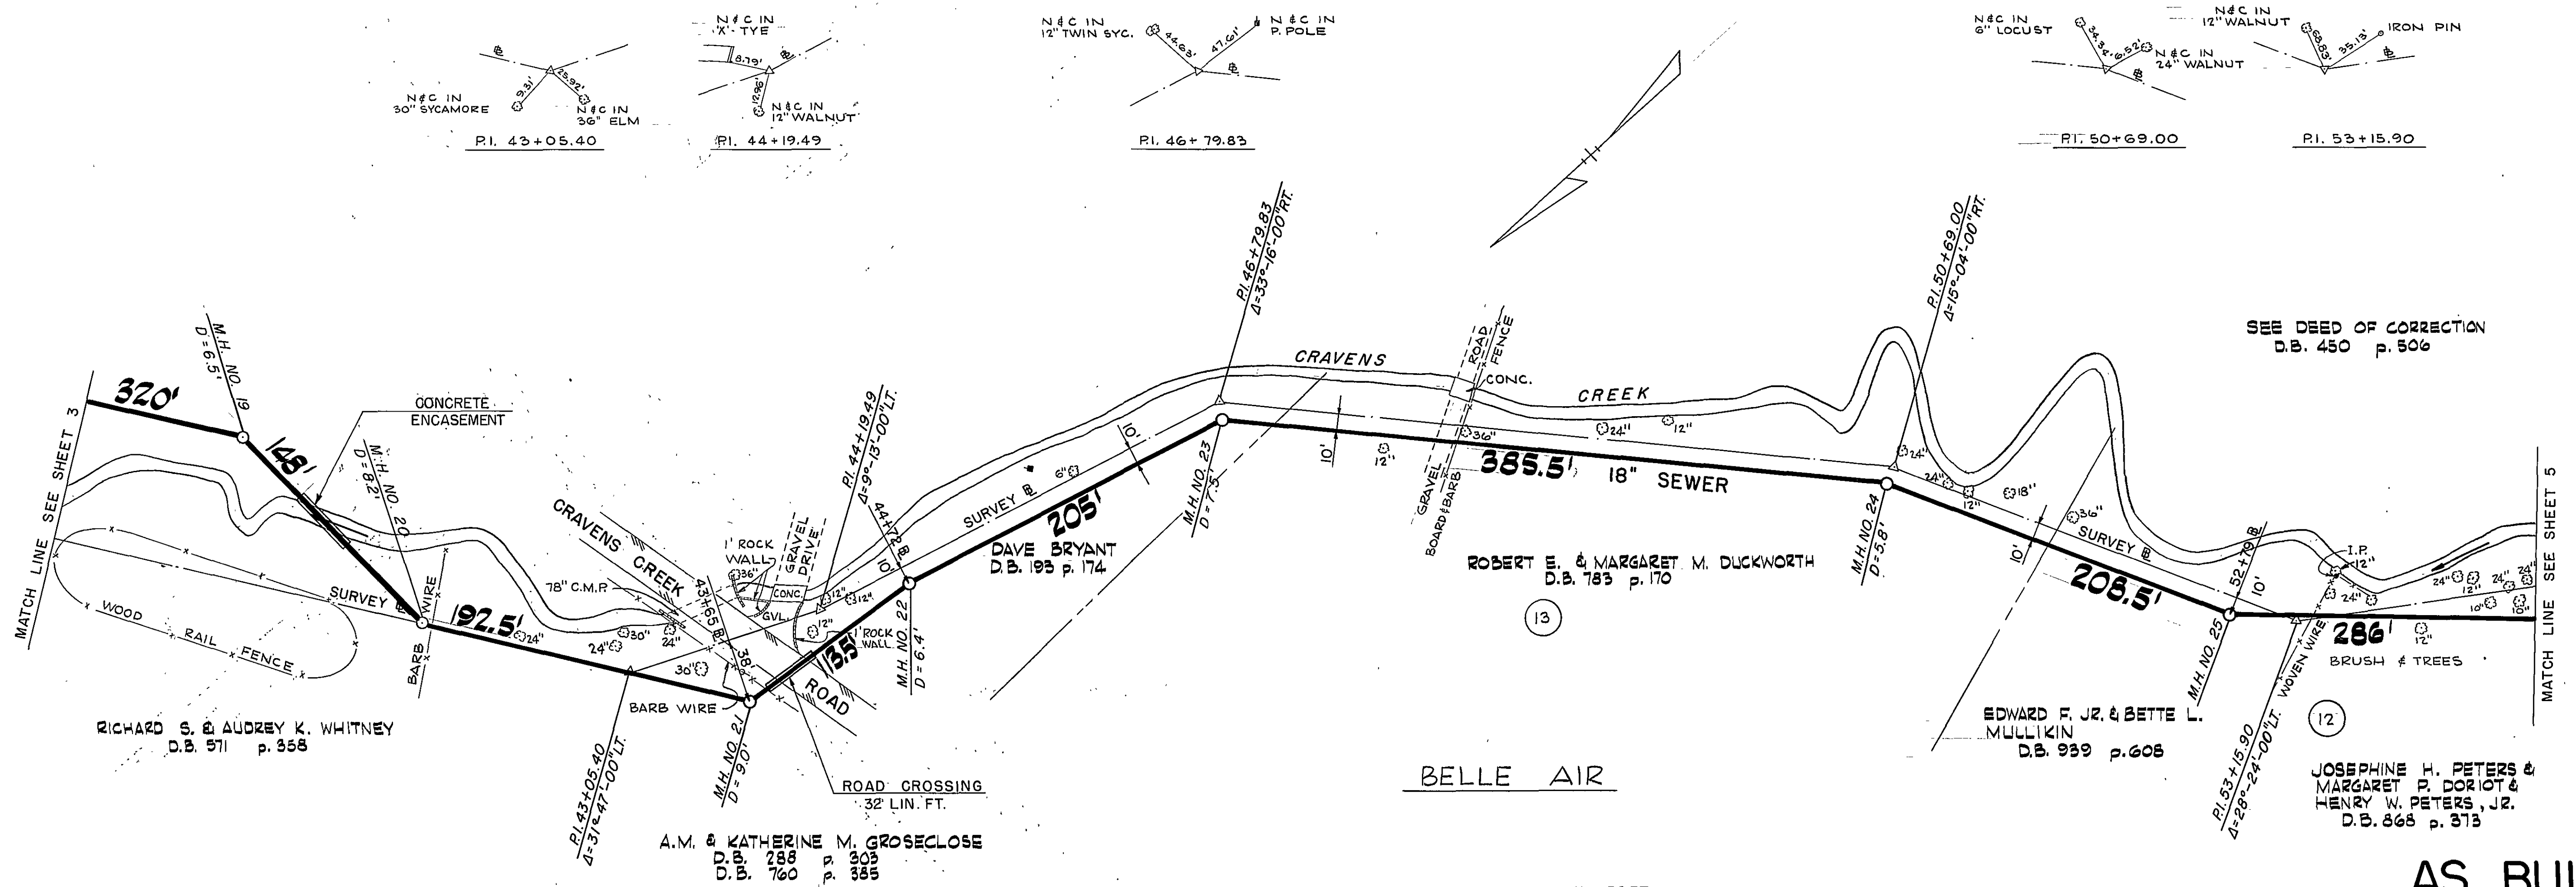

SCALE: 1 IN. = 50 FT.

AS BUILT

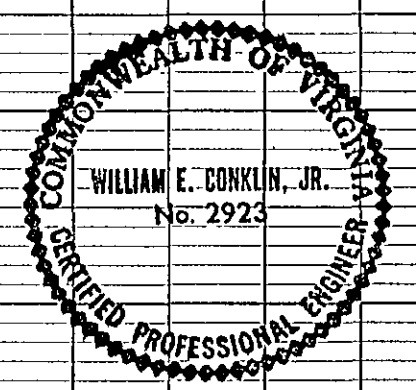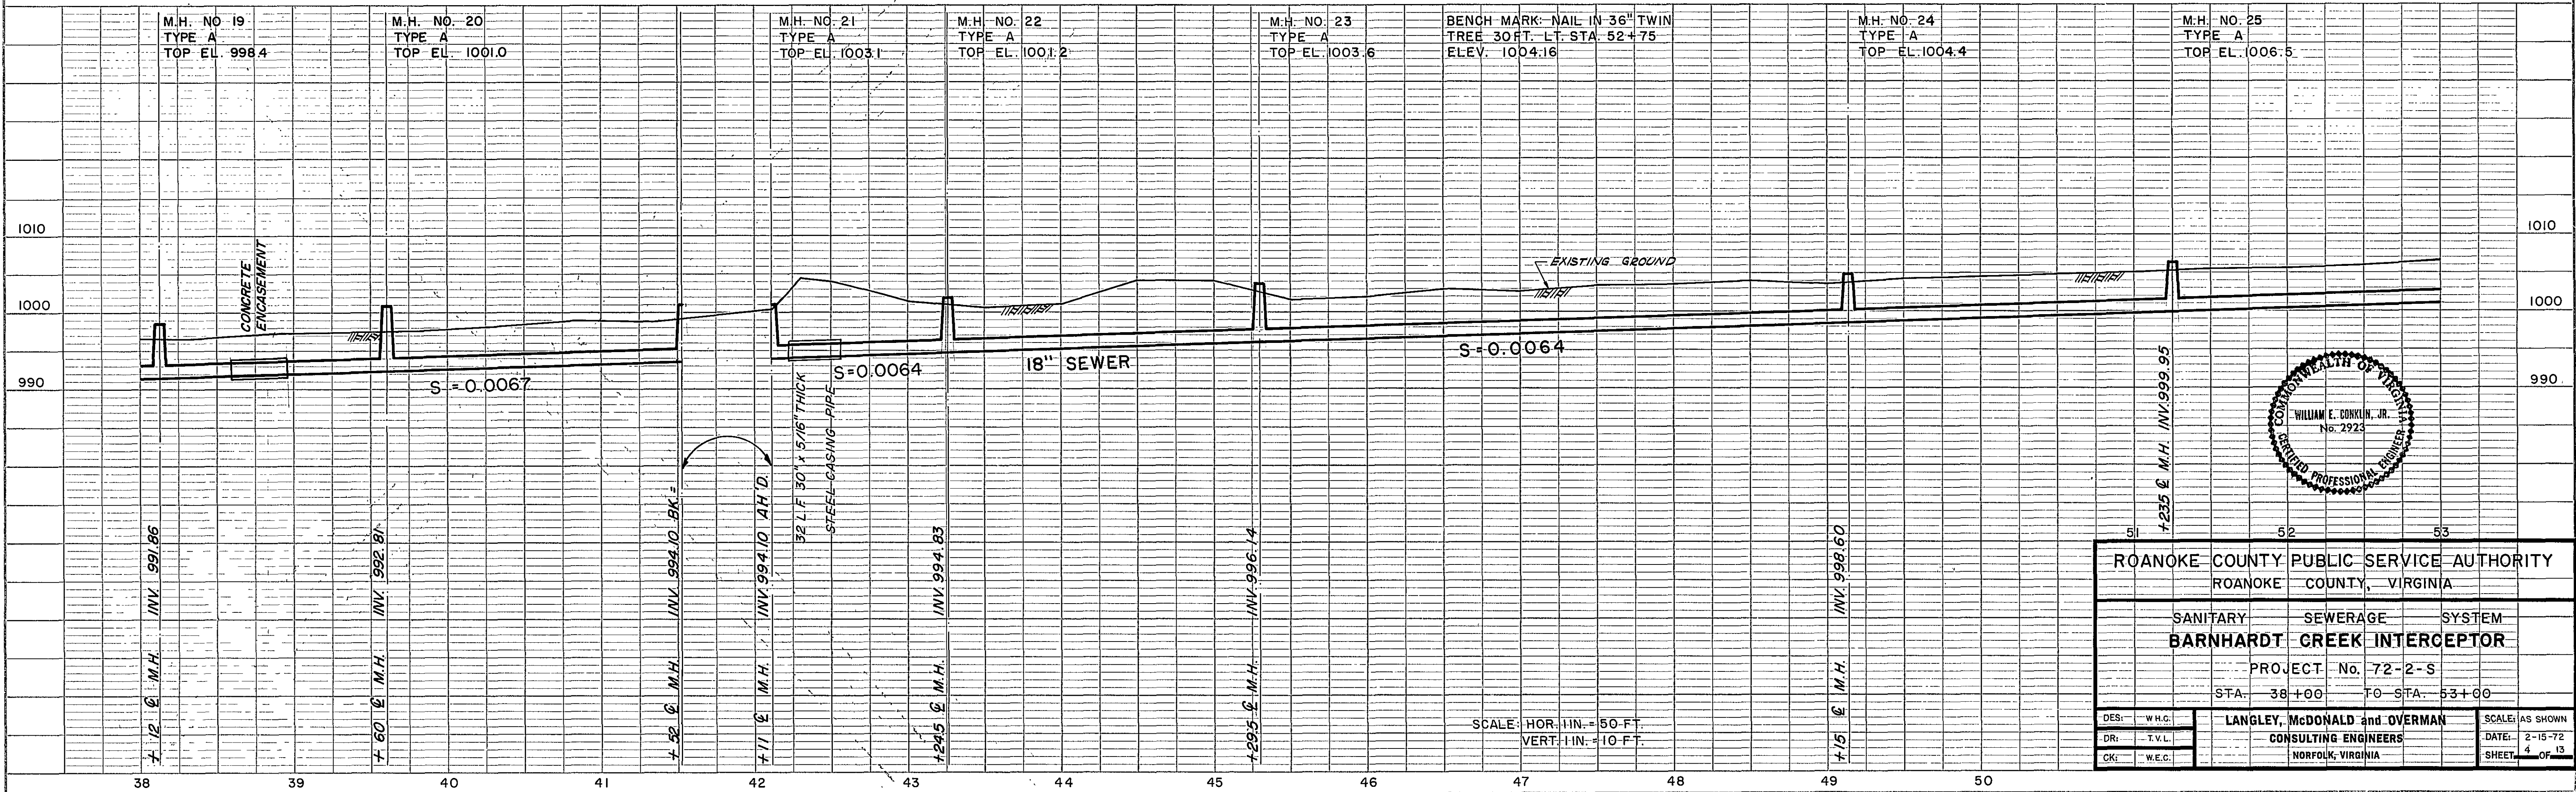

ROANOKE COUNTY PUBLIC SERVICE AUTHORITY		
ROANOKE COUNTY, VIRGINIA		
SANITARY	SEWERAGE	SYSTEM
BARNHARDT CREEK INTERCEPTOR		
PROJECT No. 72-2-S		
STA. 38+00	TO STA. 53+00	
DES: W.H.C.	LANGLEY, McDONALD and OVERMAN	
DR: T.V.L.	CONSULTING ENGINEERS	
CK: W.E.C.	NORFOLK, VIRGINIA	
SCALE: AS SHOWN		DATE: 2-15-72
		SHEET 4 OF 13