


PLAN	DATE	
	BY	
	SURVEYED	
	NOTED	
NOTE BOOK	DATE	
	BY	
	SURVEYED	
	NOTED	



PROFILE	DATE	
	BY	
	SURVEYED	
	NOTED	
NOTE BOOK	DATE	
	BY	
	SURVEYED	
	NOTED	

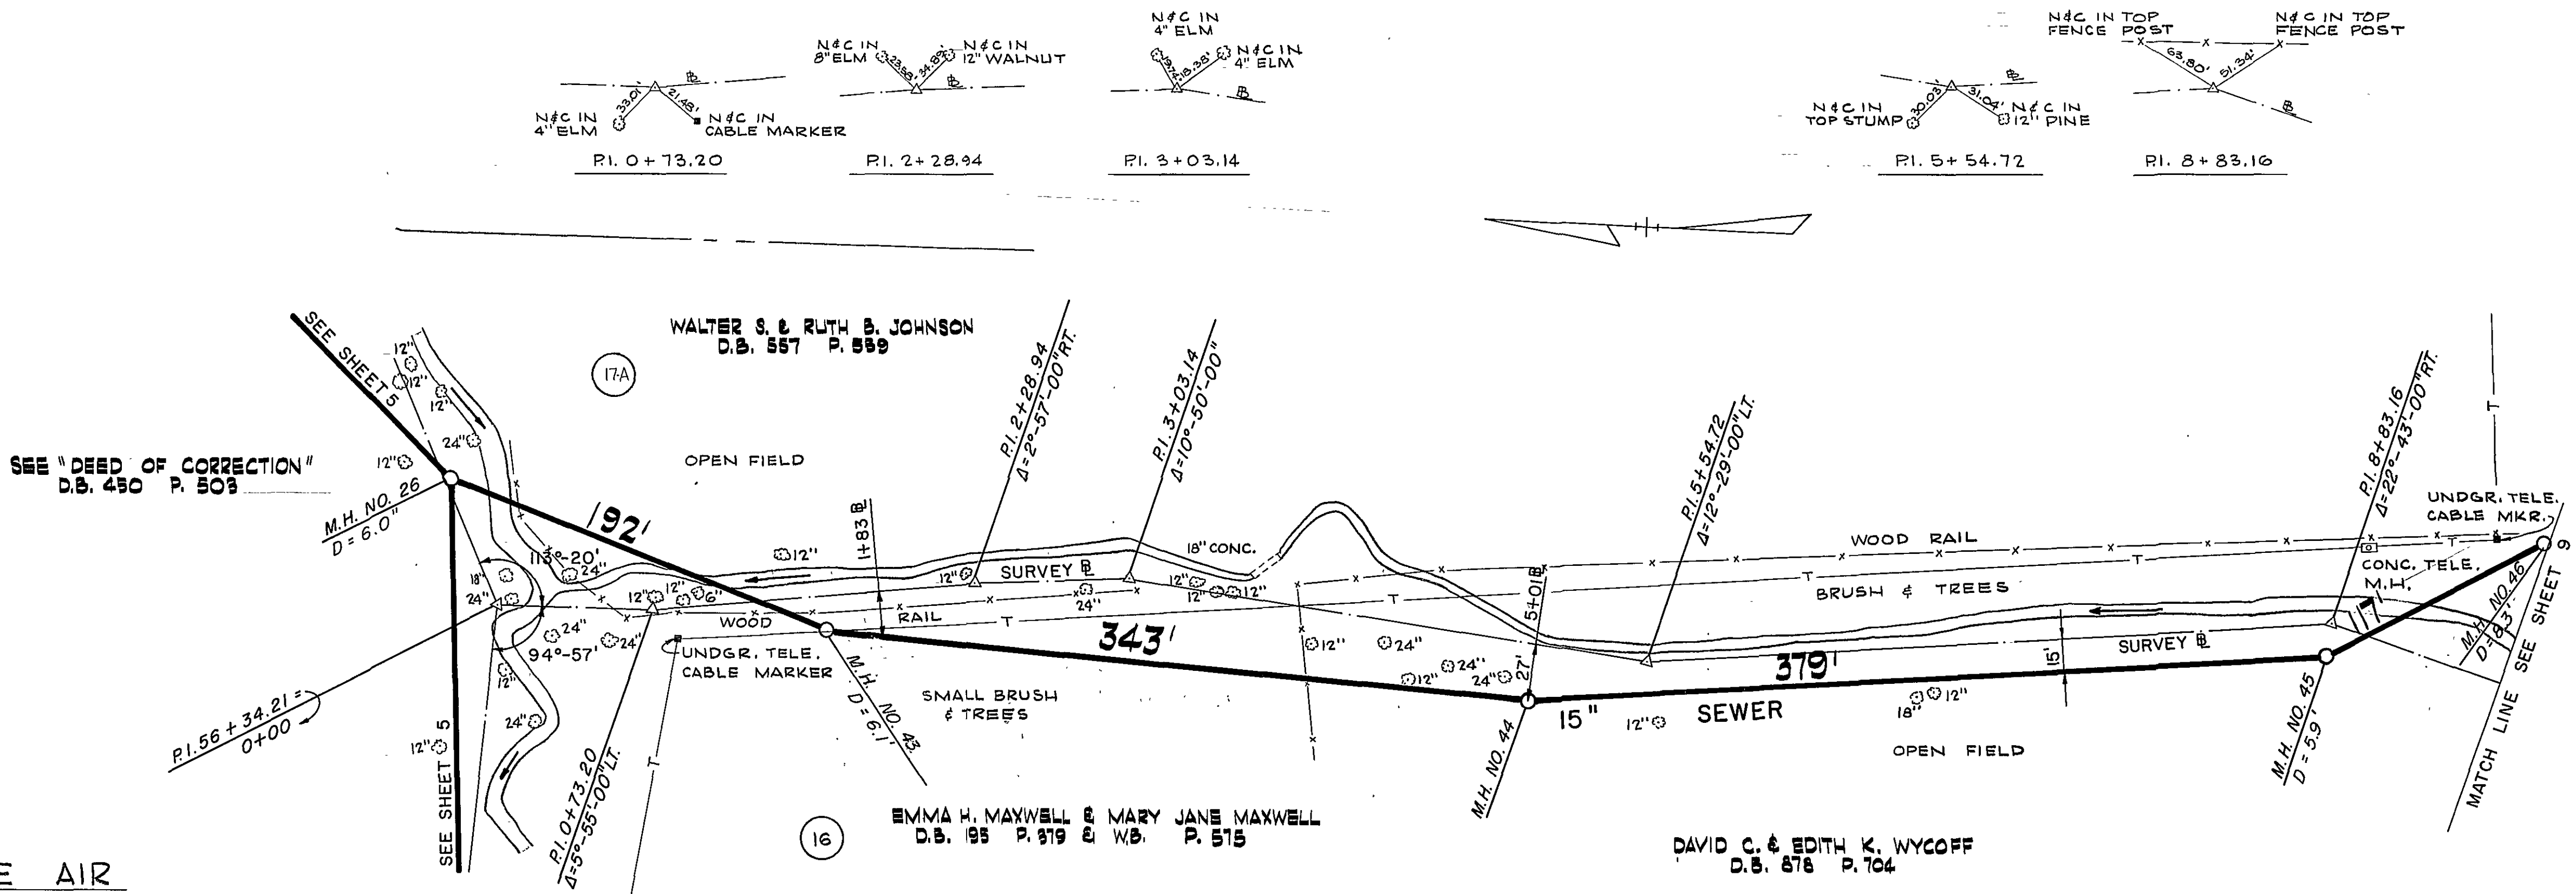

BELLE AIR

SCALE: 1 IN. = 50 FT.

AS BUILT

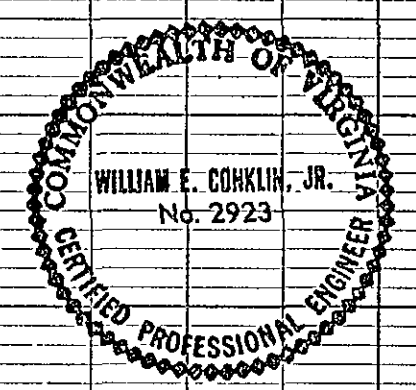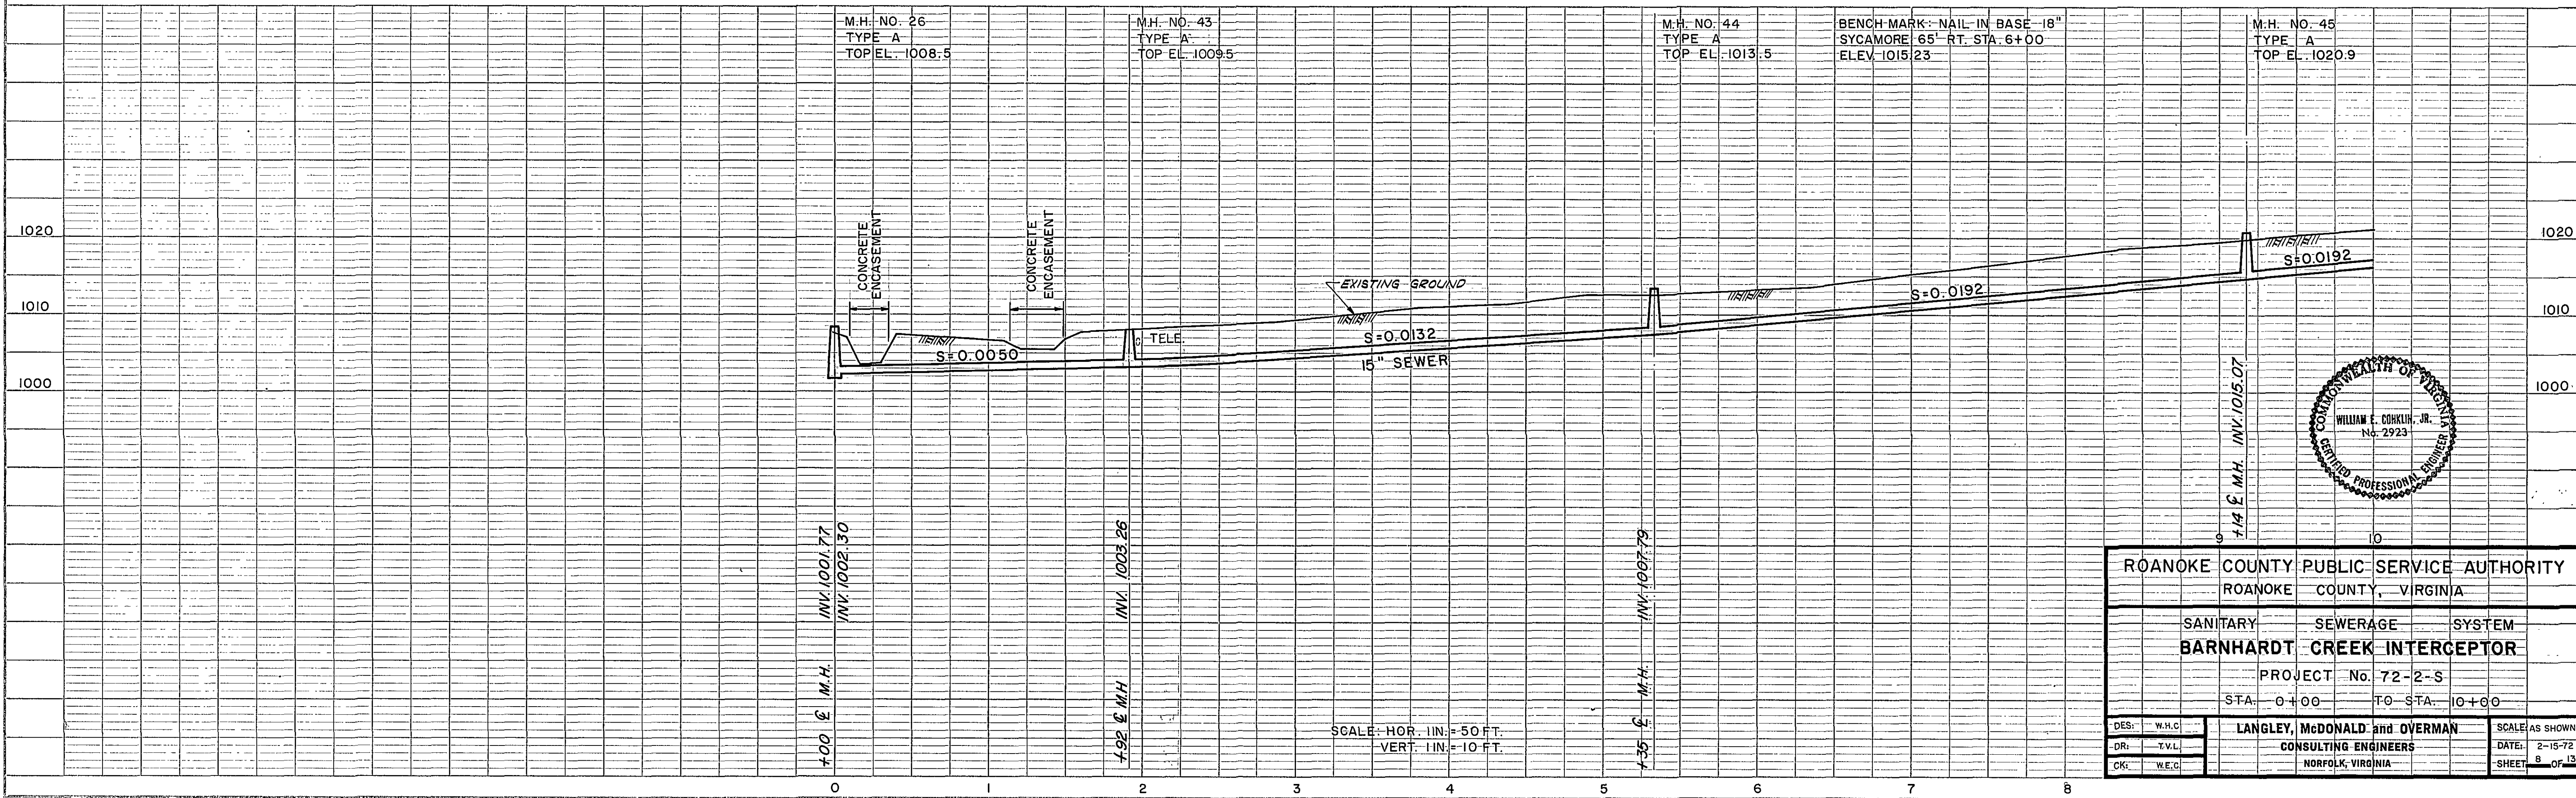

ROANOKE COUNTY PUBLIC SERVICE AUTHORITY		
ROANOKE COUNTY, VIRGINIA		
SANITARY	SEWERAGE	SYSTEM
BARNHARDT CREEK INTERCEPTOR		
PROJECT No. 72-2-S		
STA. 0+00	TO STA. 10+00	
DES: W.H.C.	LANGLEY, McDONALD, and OVERMAN	SCALE: AS SHOWN
DR: T.V.L.	CONSULTING ENGINEERS	DATE: 2-15-72
OK: W.E.C.	NORFOLK, VIRGINIA	SHEET 8 OF 13