



DATE	BY	
		SURVEYED
		PLOTTED
		GRADES CHECKED
		B. M.'s NOTED

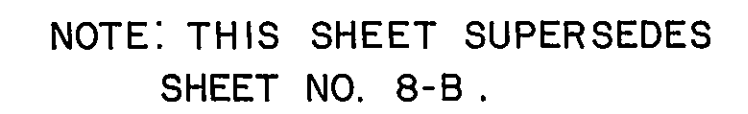

AS BUILT

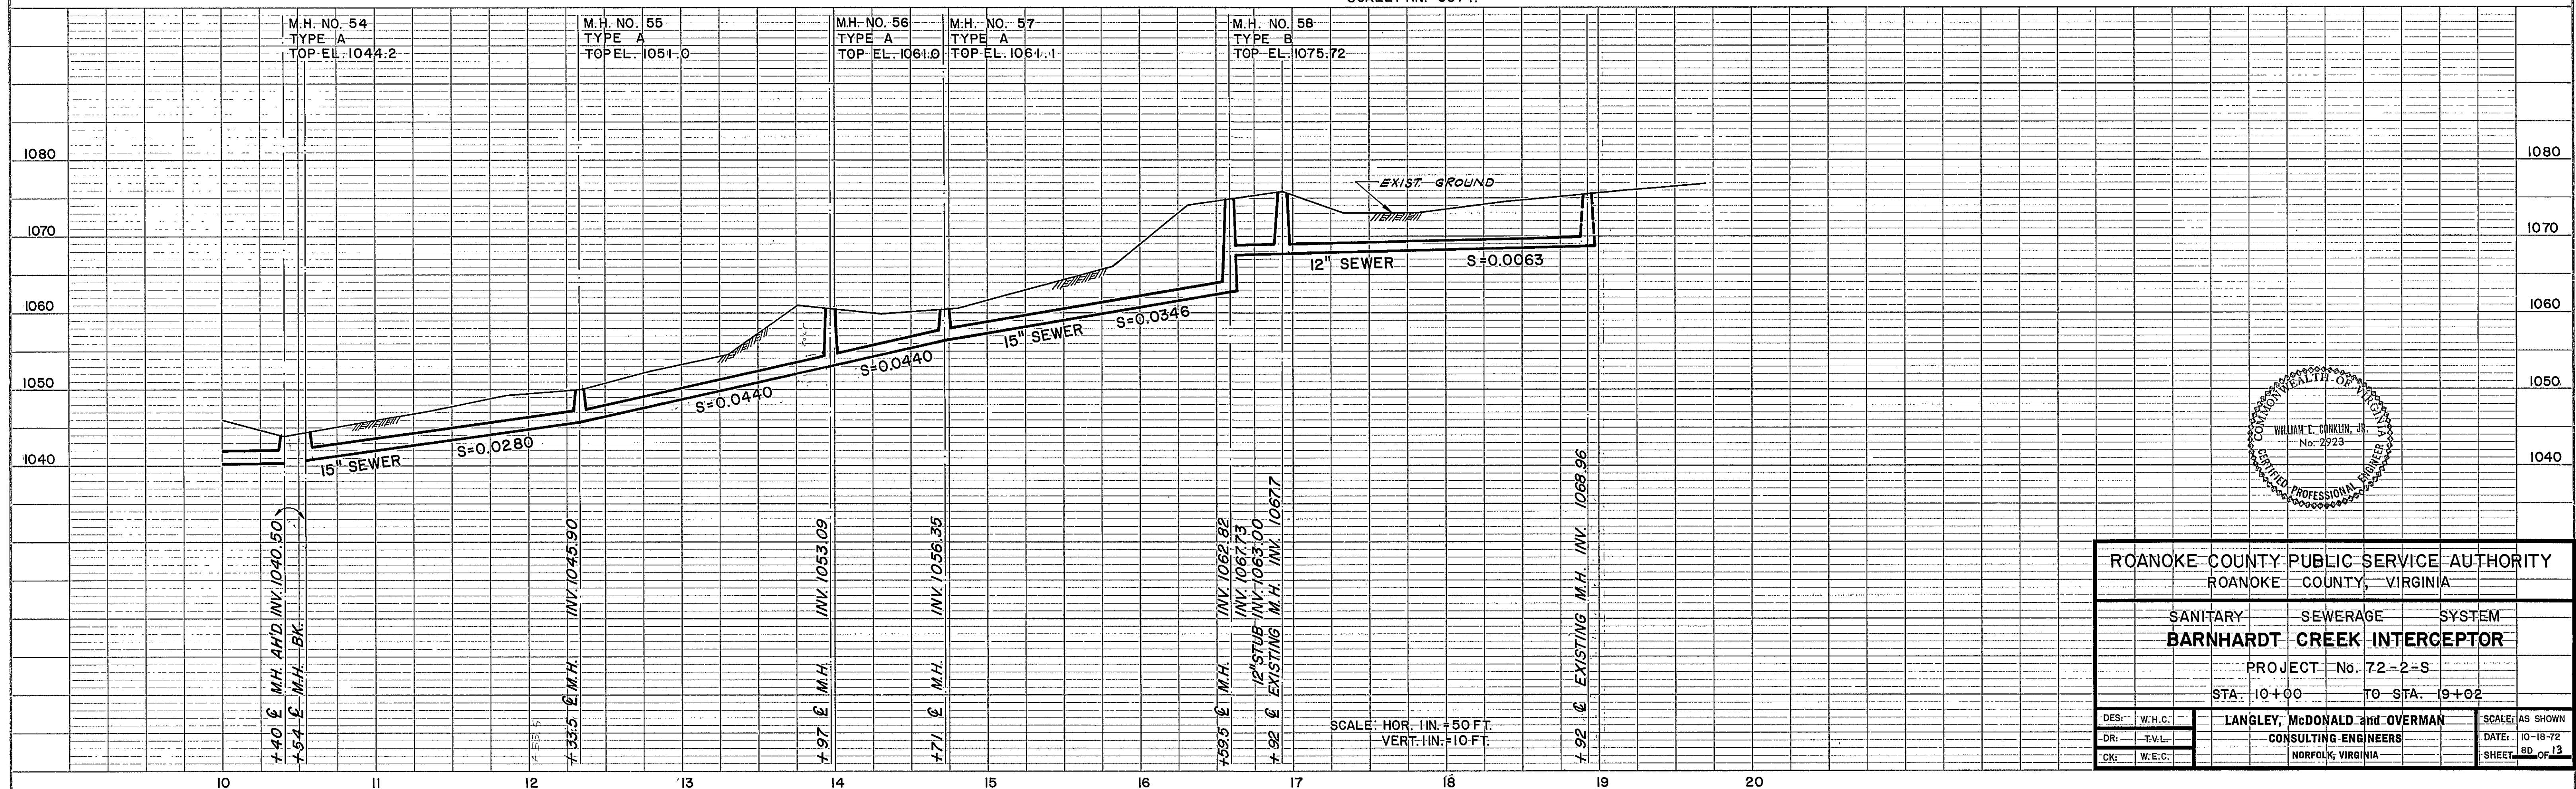

K $\div$ Σ PLATE 1, PLAN-PROFILE
KEUFFEL & ESSER CO.

48 7008 MADE IN U.S.A.