


PLAN	DATE	
	BY	
	REVISION	
	NOTE BOOK	


PROFILE	DATE	
	BY	
	REVISION	
	NOTE BOOK	

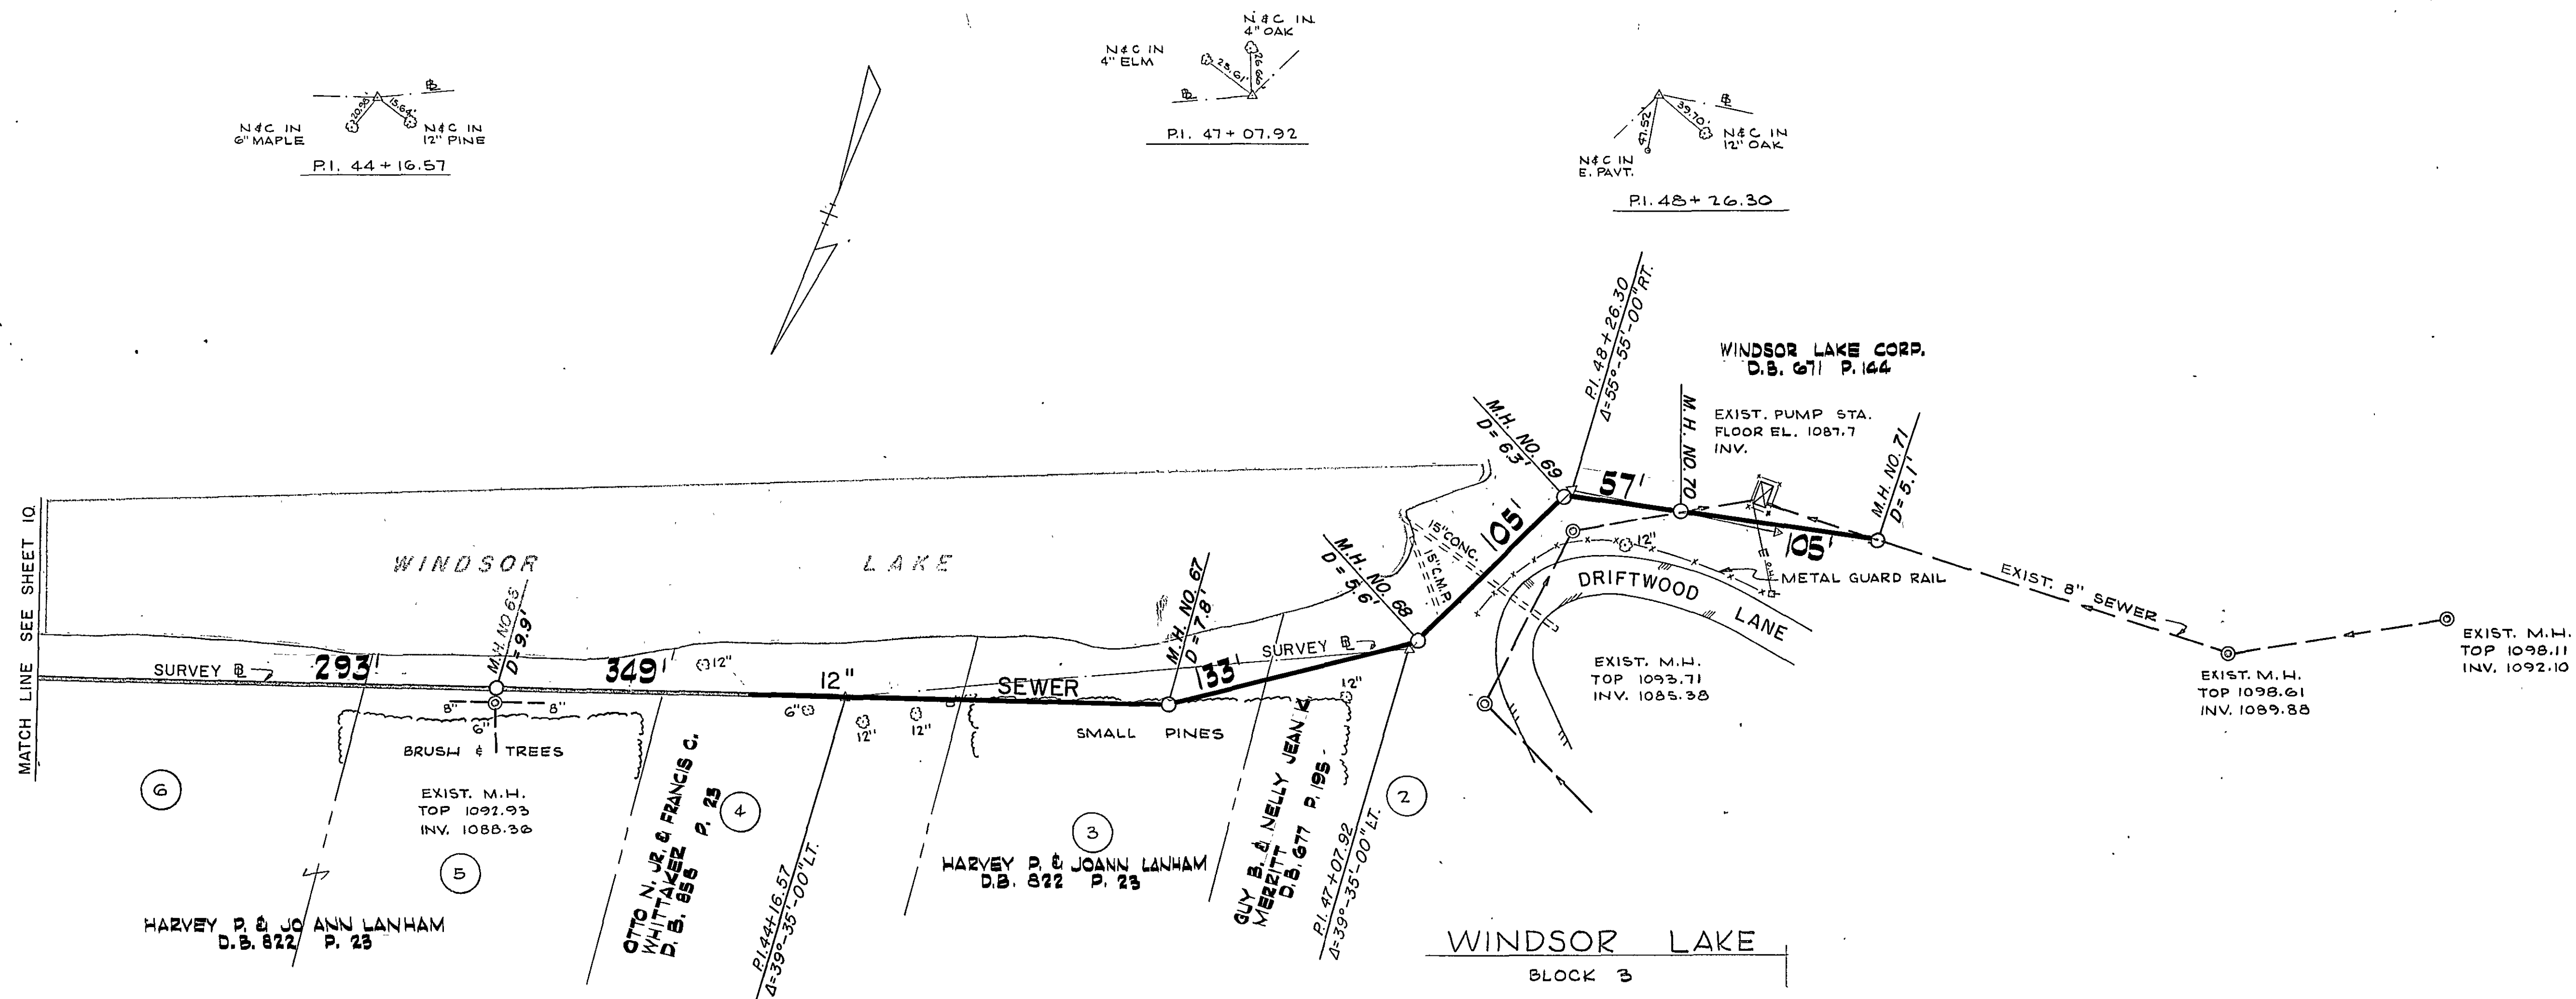


SCALE: 1 IN. = 50 FT.

WINDSOR LAKE
BLOCK 3

AS BUILT

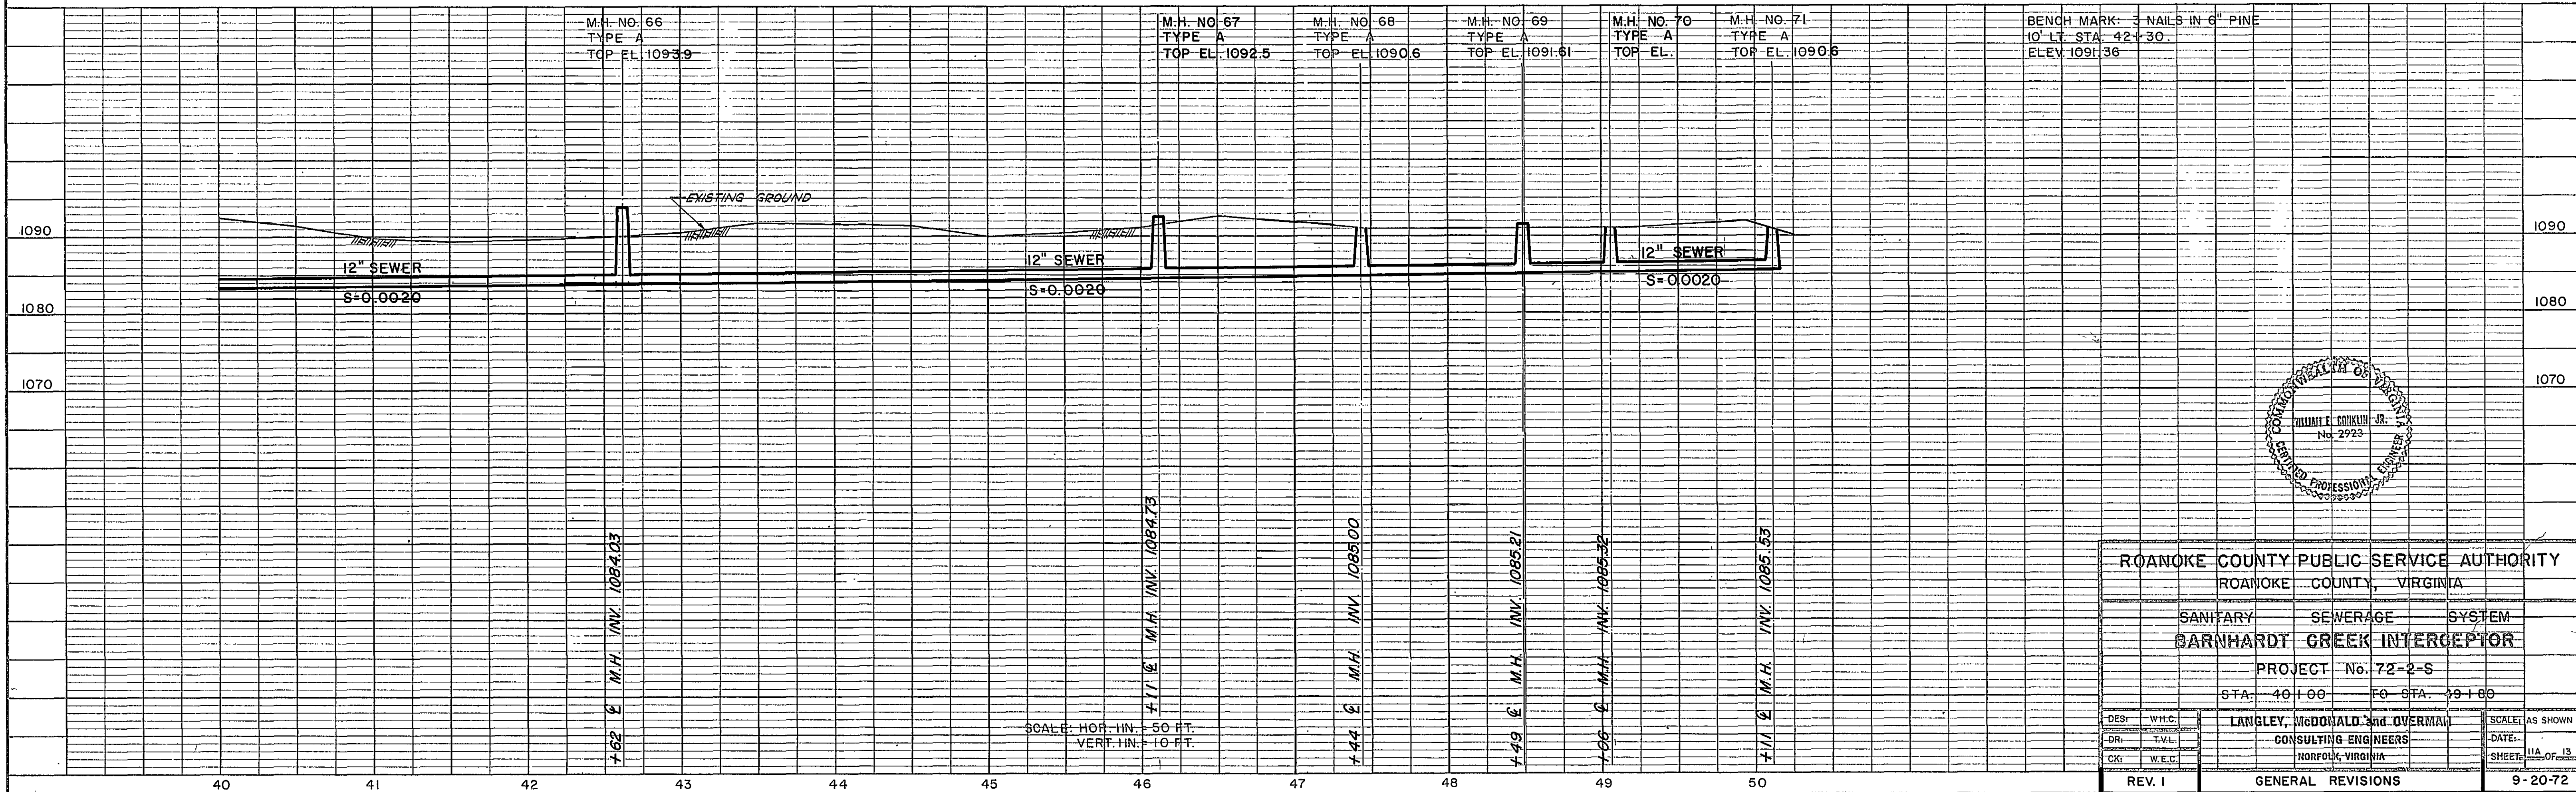

SCALE: HOR. 1 IN. = 50 FT.
VERT. 1 IN. = 10 FT.

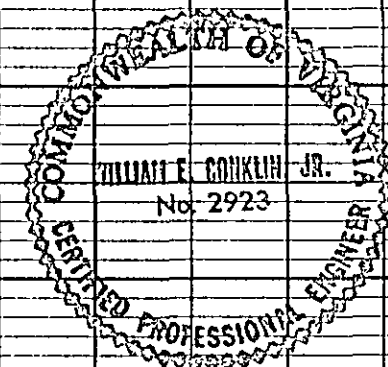

ROANOKE COUNTY PUBLIC SERVICE AUTHORITY ROANOKE COUNTY, VIRGINIA		
SANITARY	SEWERAGE	SYSTEM
BARNHARTT CREEK INTERCEPTOR		
PROJECT No. 72-2-S		
STA. 40+00	TO STA. 42+30	
DES: W.H.C.	LANGLEY, McDONALD and OVERMAN	
DR: T.V.L.	CONSULTING ENGINEERS	
CK: W.E.C.	NORFOLK, VIRGINIA	
REV. 1	GENERAL REVISIONS	