




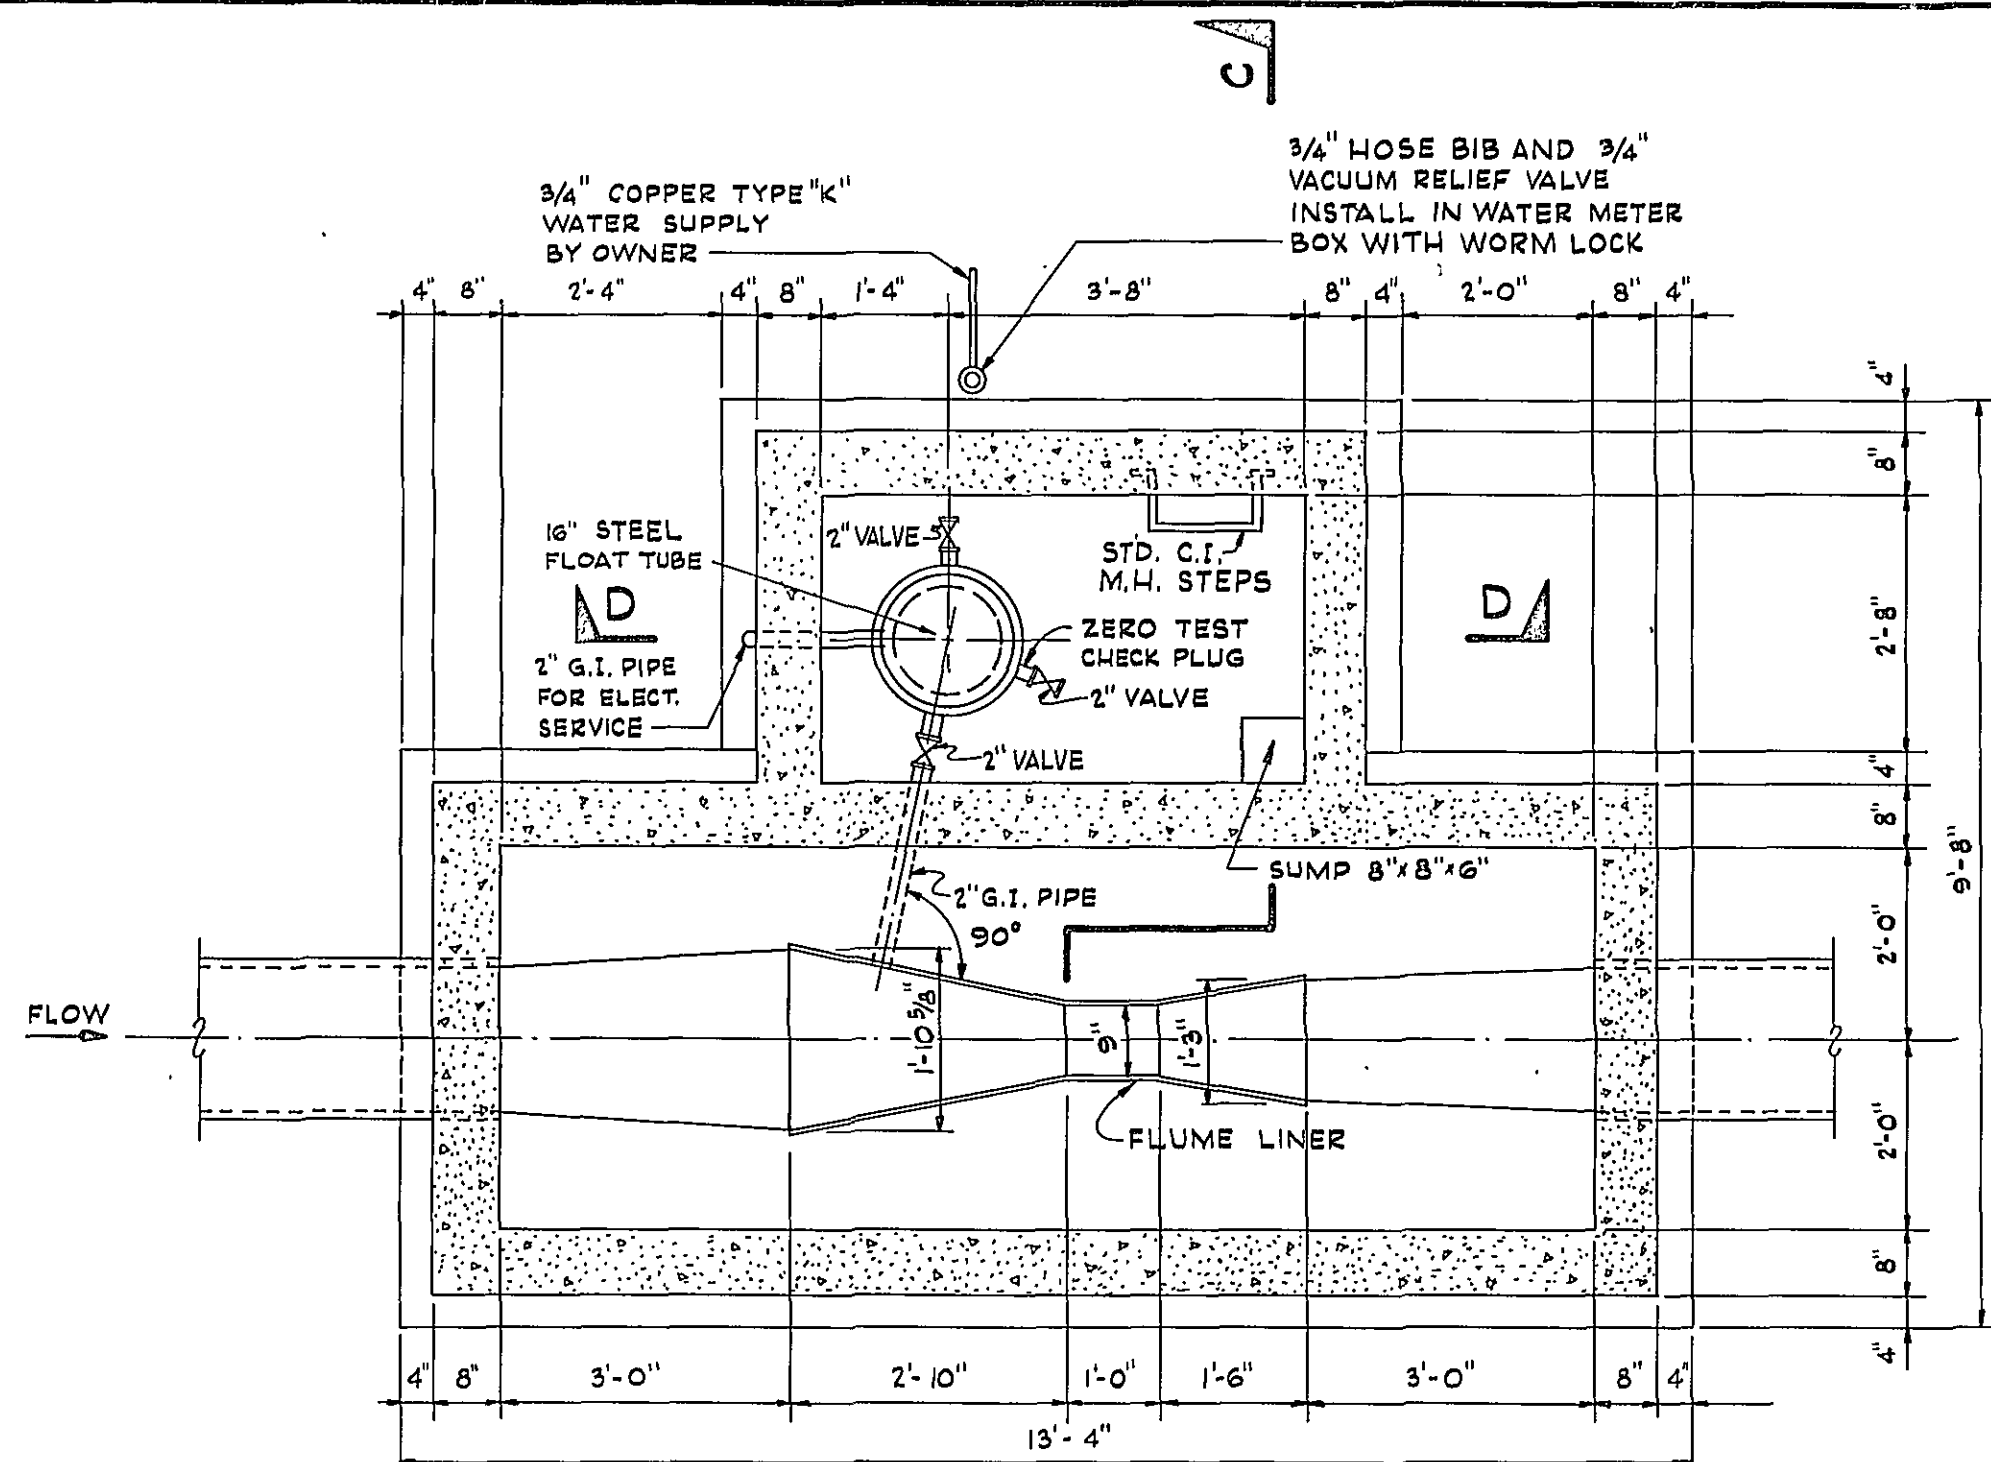


SECTION "A-A"
SCALE: 1/2" = 1'-0"

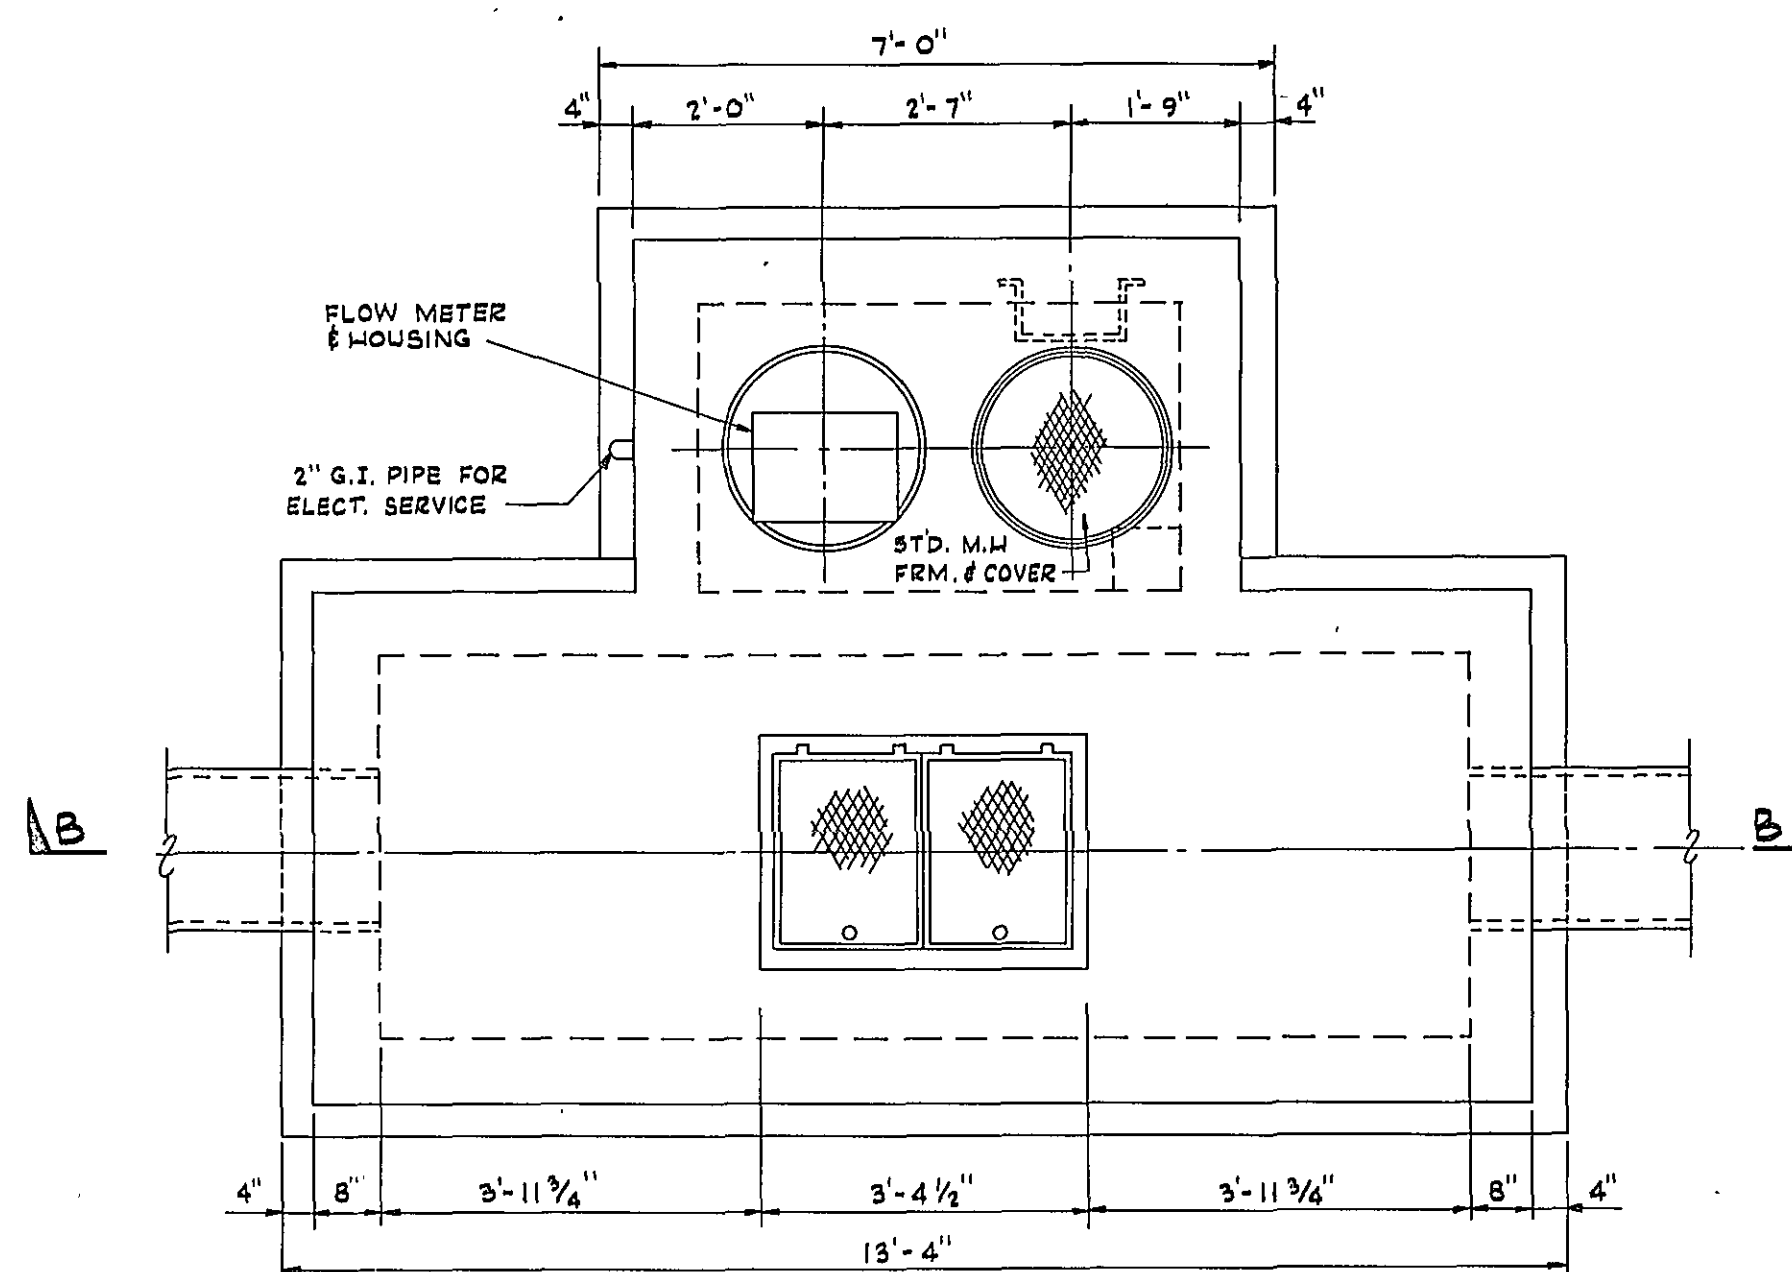


PLAN
SCALE: 1/2" = 1'-0"

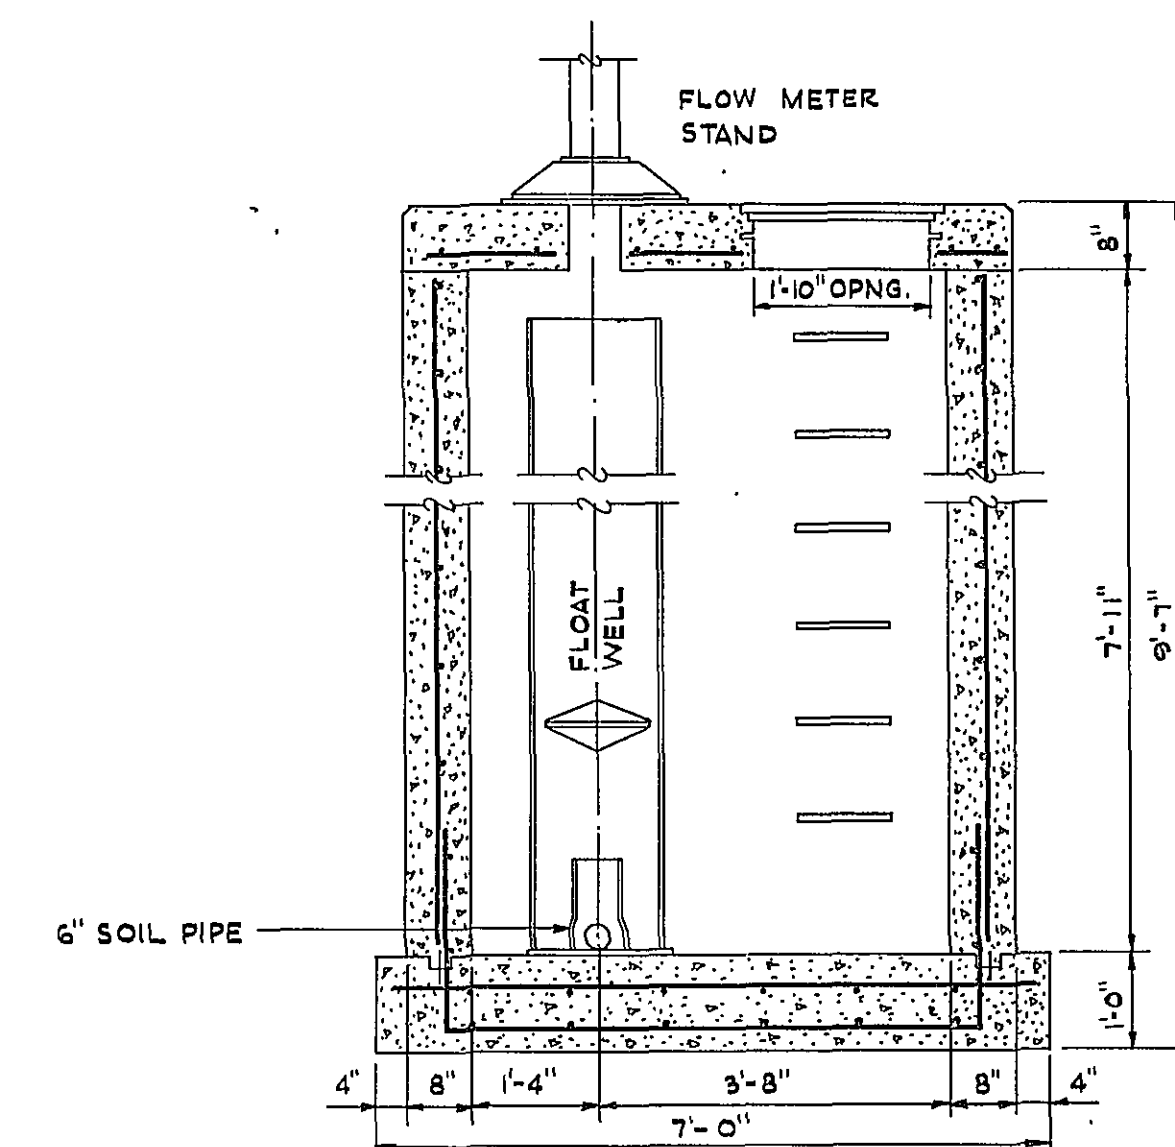


SECTION "D-D"
SCALE: 1/2" = 1'-0"

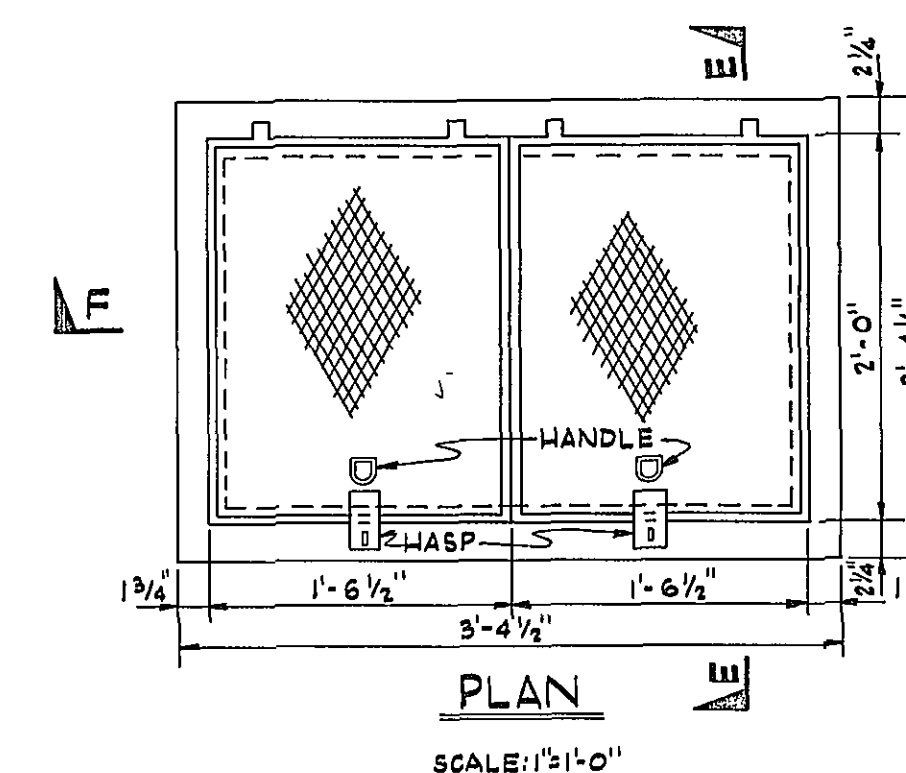


SECTION "F-F"
SCALE: 1/2" = 1'-0"

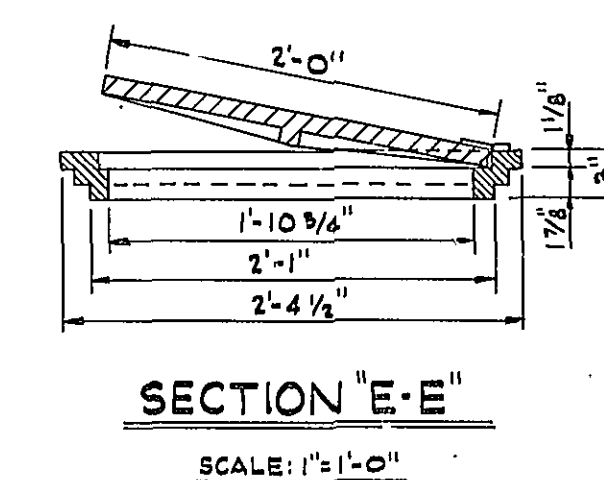

SECTION "E-E"
SCALE: 1/2" = 1'-0"

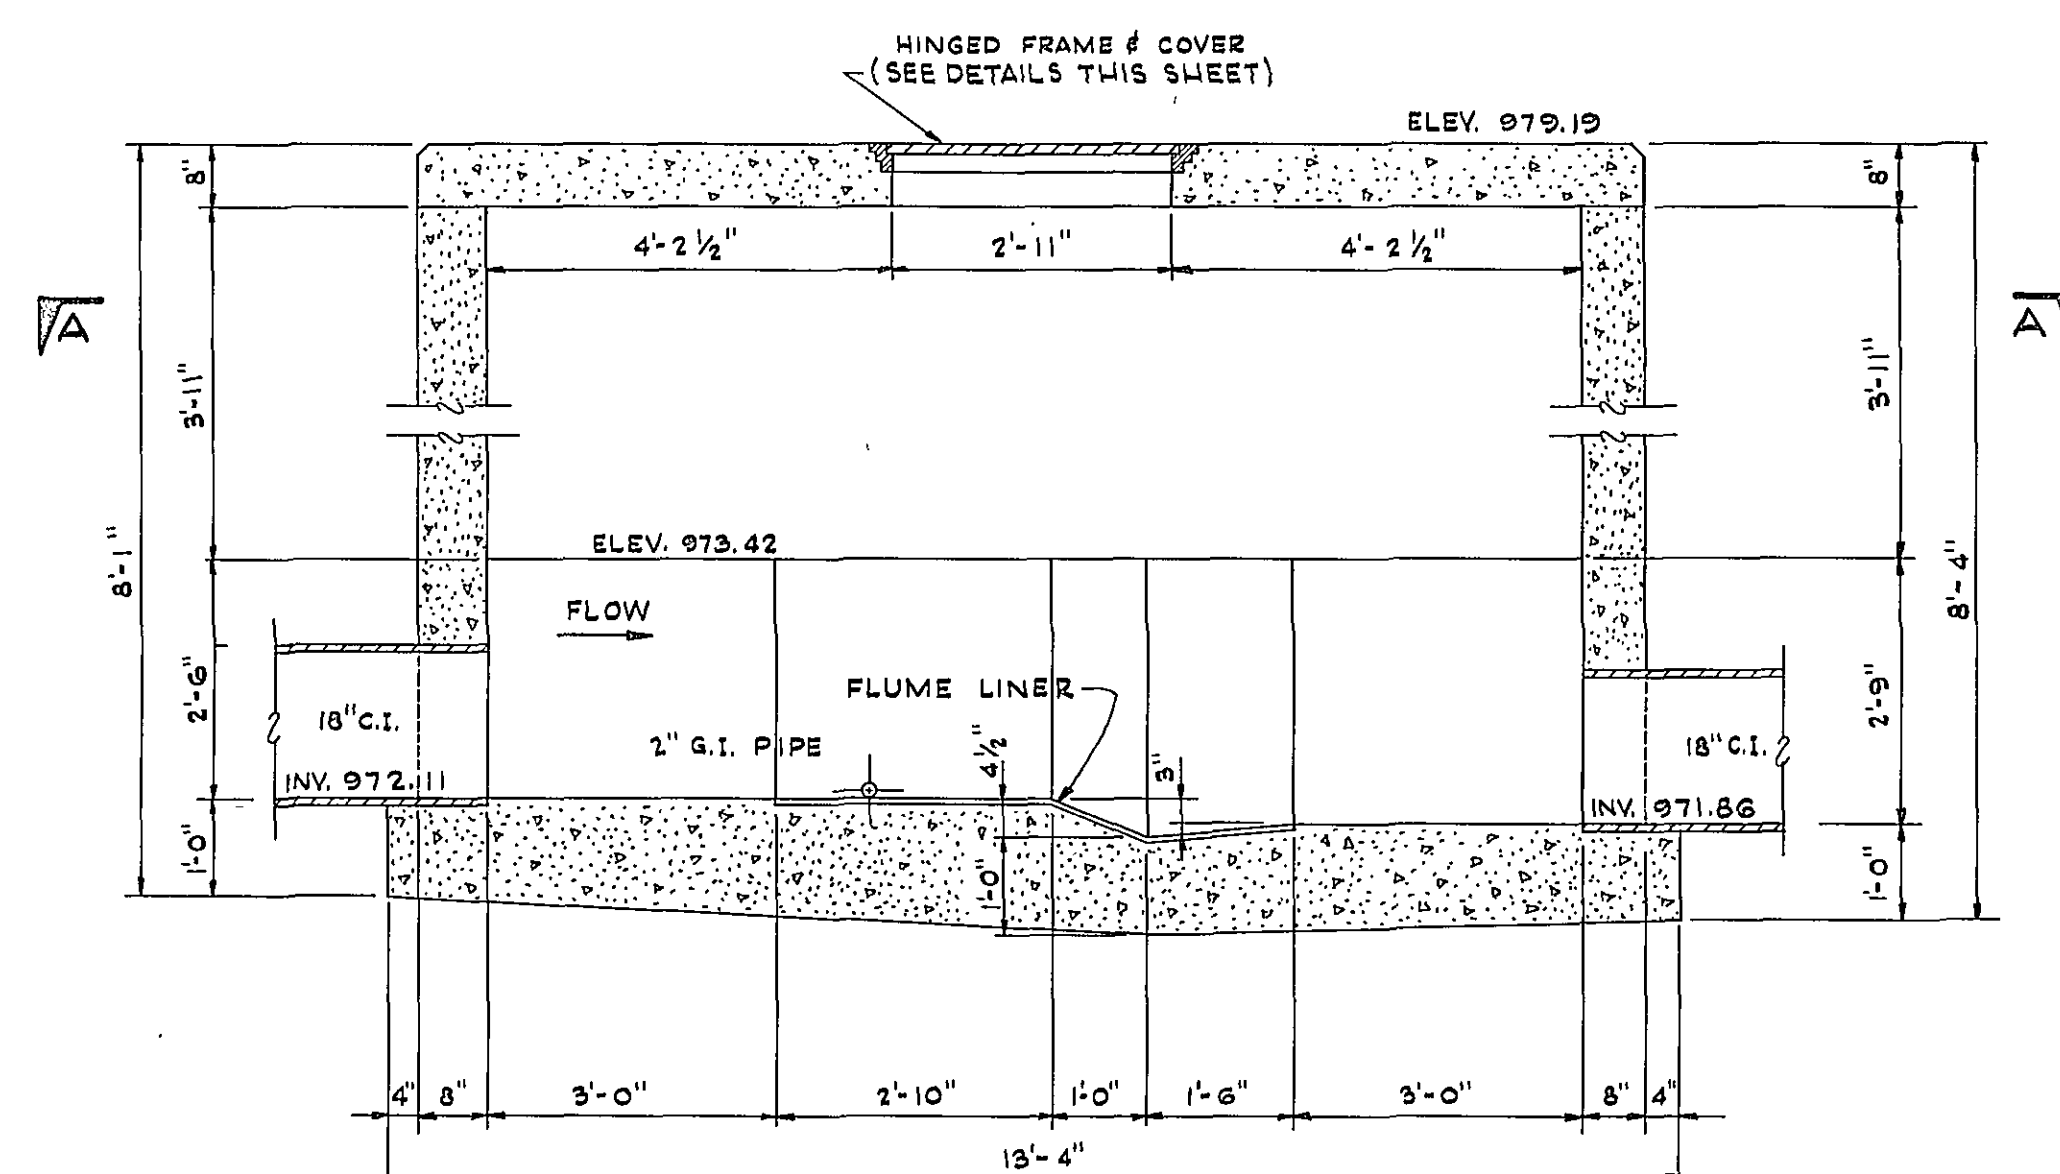


SECTION "B-B"
SCALE: 1/2" = 1'-0"

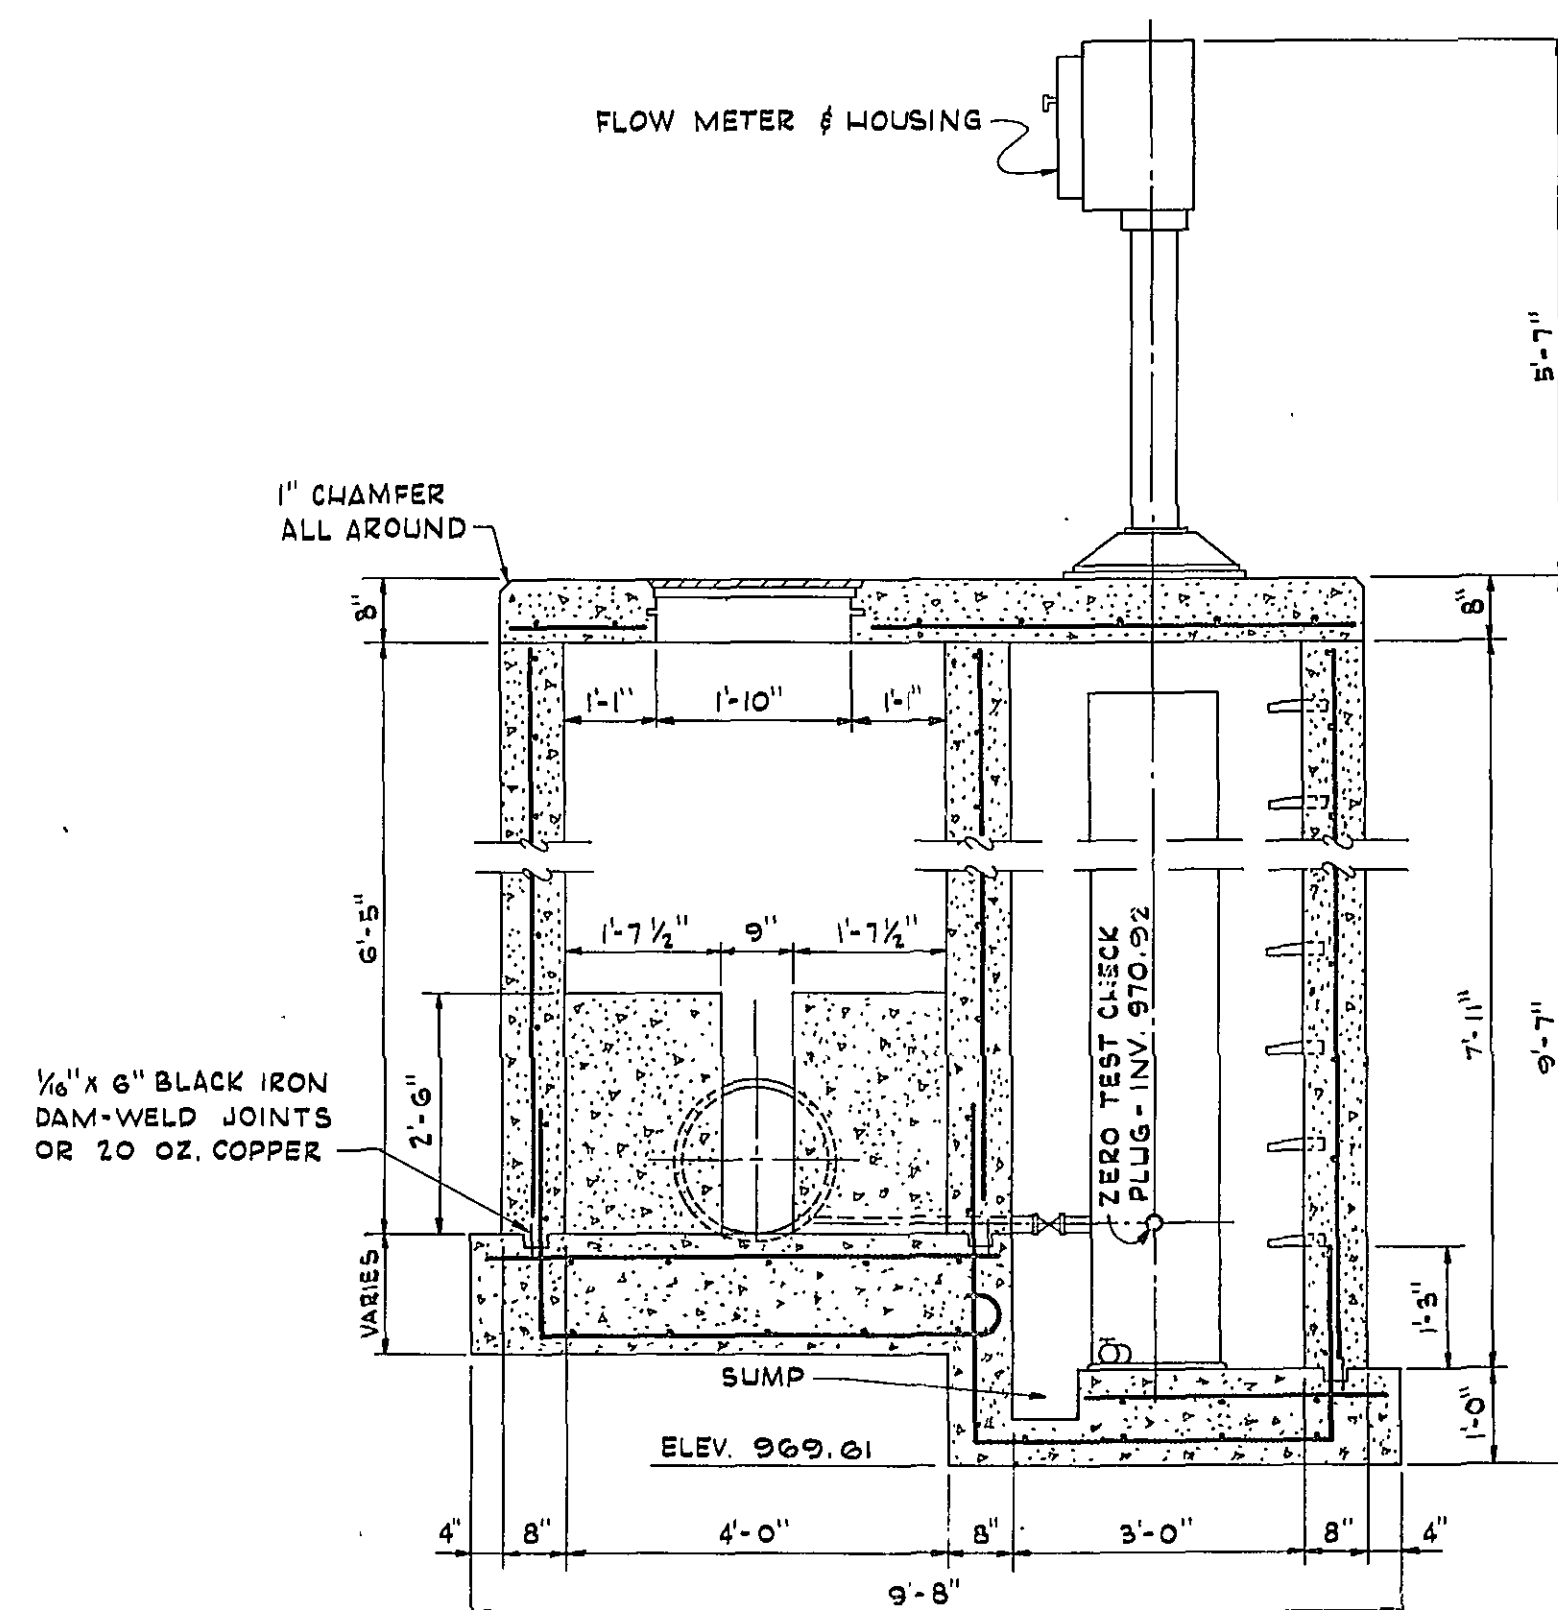


SECTION "C-C"
SCALE: 1/2" = 1'-0"

PAINT O.S. WALLS
WITH 2 COATS
BITUMASTIC NO. 50

ALL REINF.
STEEL # 5 @ 12" @

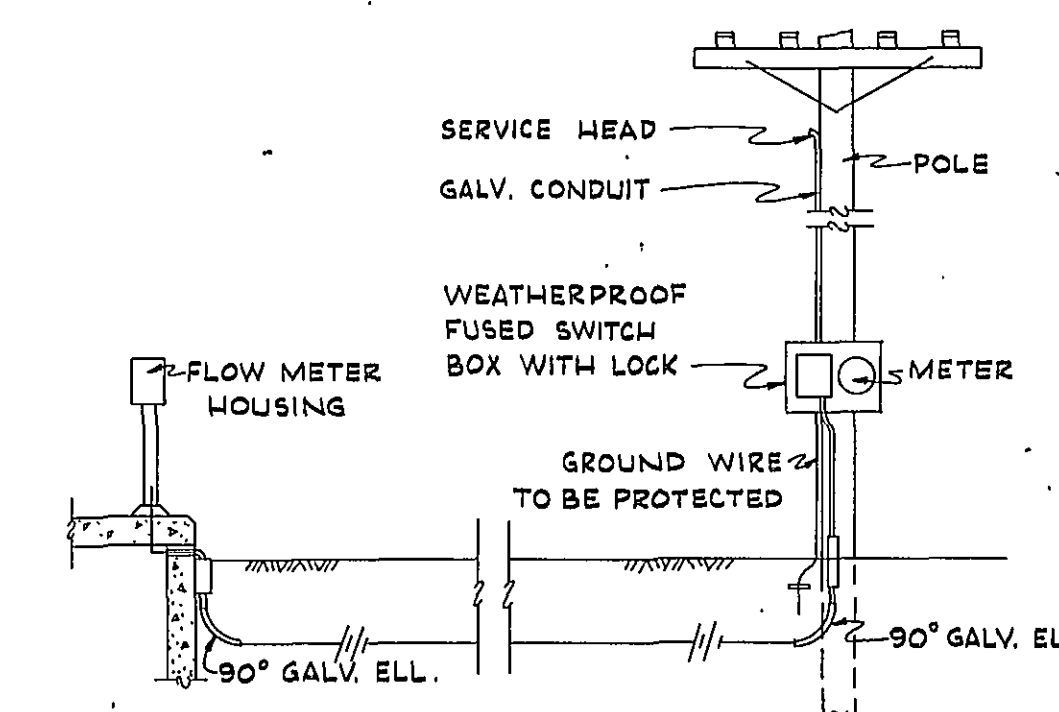

ELECTRICAL SERVICE CONNECTION
NOT TO SCALE

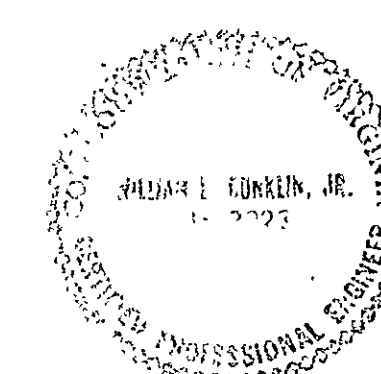

AS BUILT

ROANOKE COUNTY PUBLIC SERVICE AUTHORITY ROANOKE COUNTY, VIRGINIA		
SANITARY SEWERAGE SYSTEM BARNHARDT CREEK INTERCEPTOR		
PROJECT No. 72-2-S METERING CHAMBER		
DES: W.H.C.	LANGLEY, McDONALD and OVERMAN CONSULTING ENGINEERS NORFOLK, VIRGINIA	SCALE: AS SHOWN DATE: 2-15-72 SHEET 12 OF 13
DR: TVL.		
CK: W.E.C.	ELEVATIONS REVISED	JULY 28, 1972
REV. ①		