


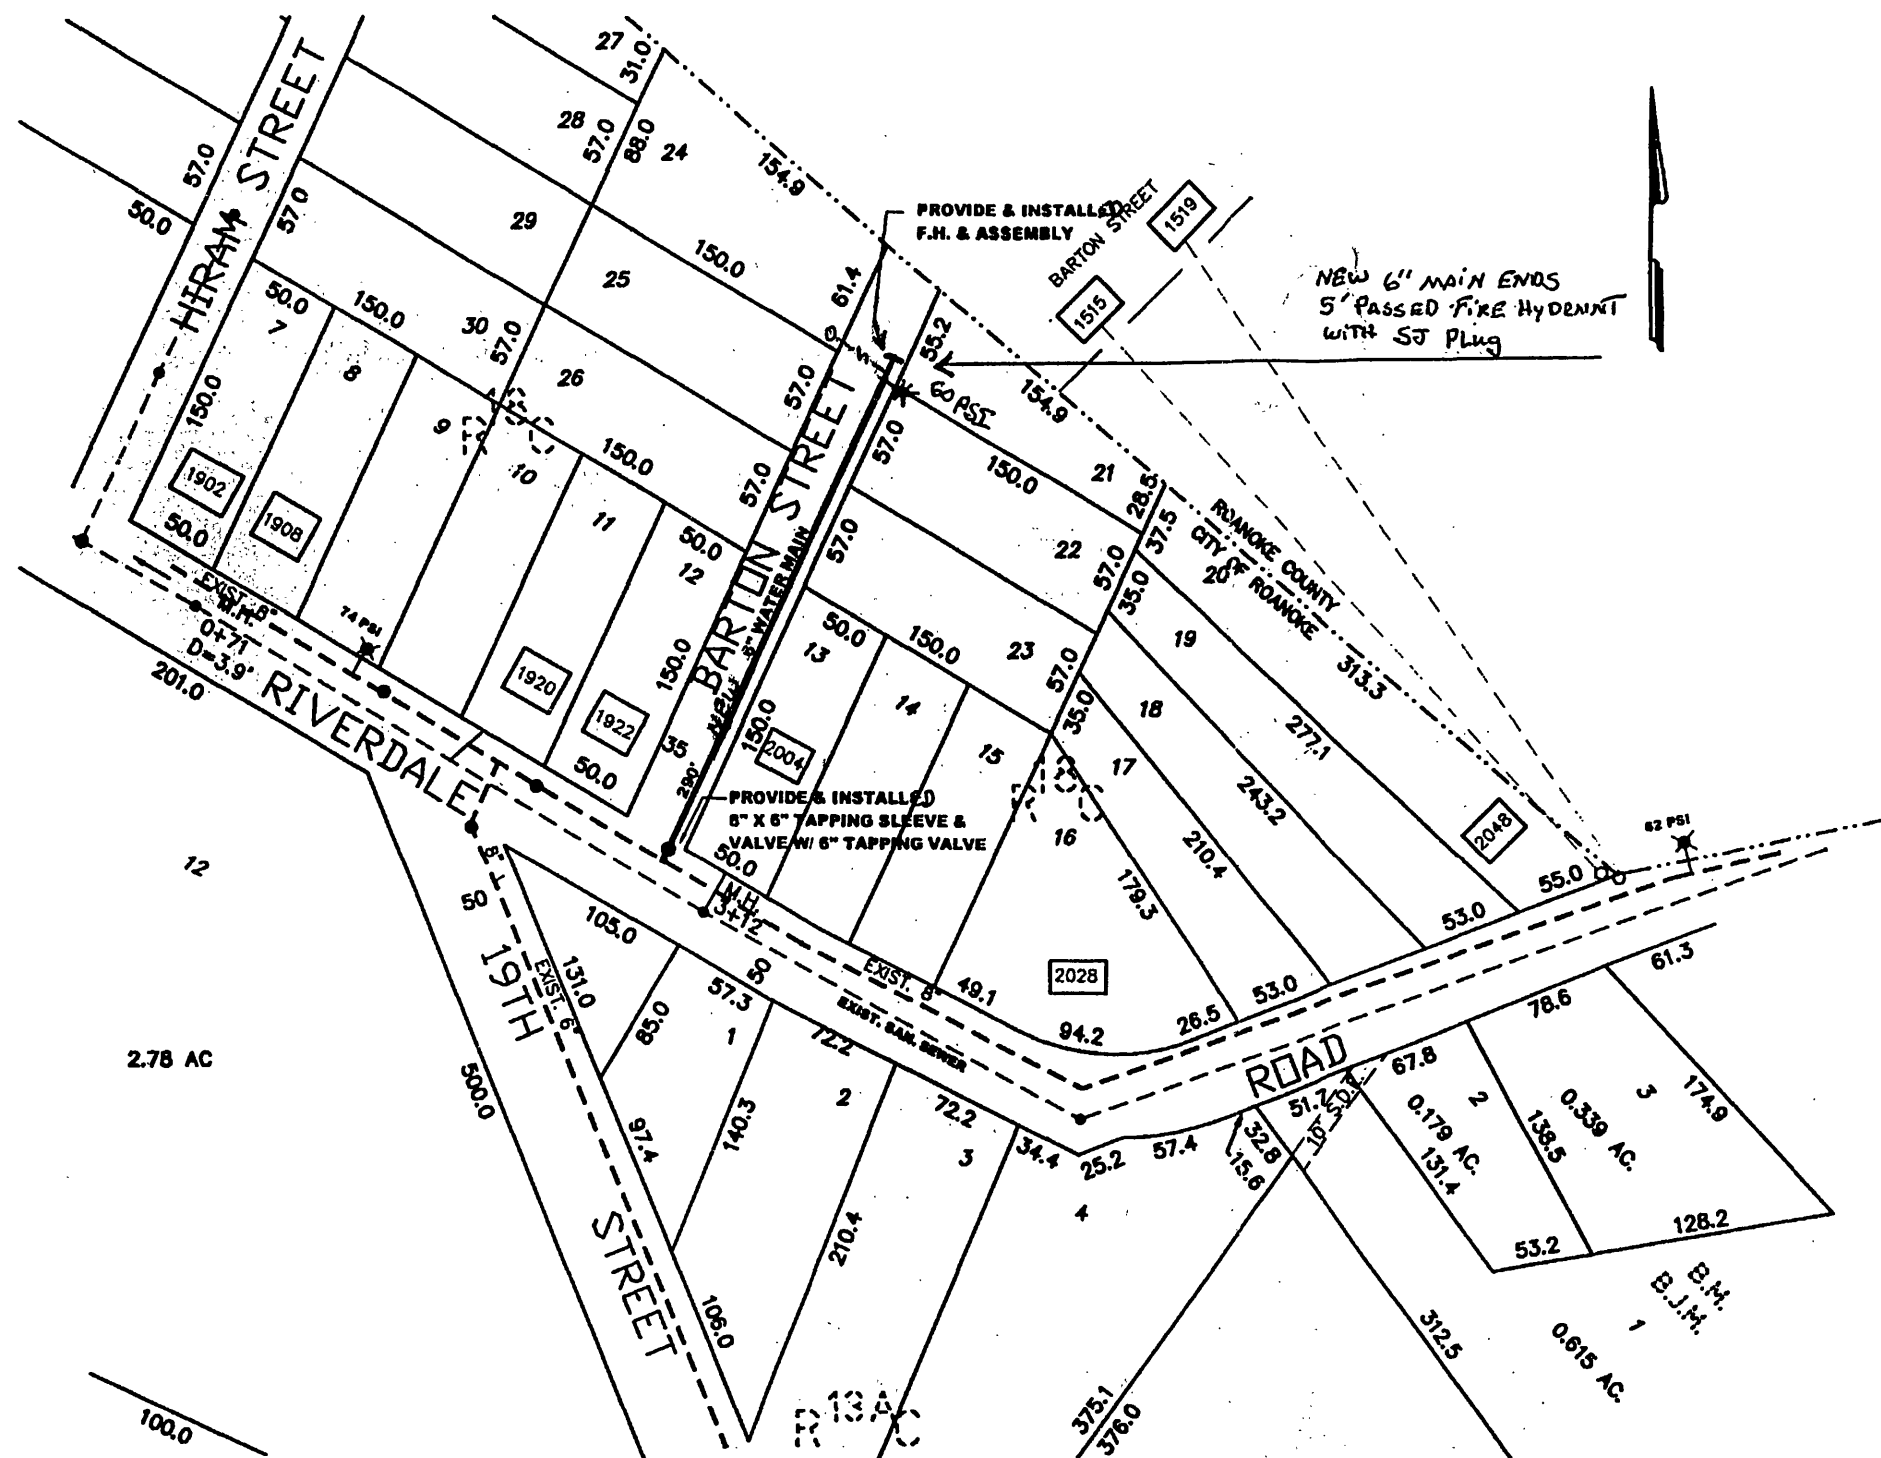

DATE STARTED 11-1-99				
DATE COMP. 11-9-99				
FEET MAIN	SIZE	VALVE	VAULT	BOX
290'	6"	6"	YES	#2
F.H. COMP. 1				
F.H. STUB ONLY				
SERV. INS. BY: COL				
MAIN INS. BY: COL				
NO. 3/4" SERV. INS. 1				
CITY OR CO. CITY				
DEPT. INSP. COL-ULS				

Main is Ductile Iron Pipe

As Built
11-5-99
[Signature]

ROANOKE		WATER DEPARTMENT		VIRGINIA	
BARTON STREET					
RIVERDALE ROAD, S.E.					
SCALE:	1"=100'	<i>Robert K. Benton</i> DIRECTOR OF UTILITIES & OPERATIONS		10/26/99	DATE
DATE:	10/19/99	<i>Robert K. Benton</i> DIRECTOR OF PUBLIC WORKS		10/26/99	DATE
DIST. MAP:	CAD 0672 443	<i>Samuel D. [Signature]</i> MANAGER OF WATER DEPARTMENT		10/26/99	DATE
PLAN NO.:	99-13	<i>Samuel D. [Signature]</i> MANAGER OF UTILITY LINE SERVICES		10/19/99	DATE