gran Hill

CHARITTY I COCK FOTHARTE

QUANTITY	UNIT	UNIT PRICE	COST	BONDABL
	ACRES			
	C.Y.			
	C.Y.			
	EACH			
	EACH			
	LIN. FT.			
-				
300	LIN. FT.	21	6300	6300
	LIN. FT.			
	LUMP SUM			
	LIN. FT.			
	S.F.			
	S.Y.			
	EACH			
	EACH			
	LIN. FT.			
	LIN. FT.			
	EACH .	=		
	S.Y.			
	S.Y.			
	C.Y.			
	C.Y.			
	EACH			
1600		18.00	28,800.00	28,800.00
	LIN. FT.			
1	EACH	1,500.00	1,500.00	1,500.00
1	EACH	750.00	750.00	750.00
2	EACH	750.00	1,500.00	1,500.00
	EACH			
4	EACH	125.00		500.00
8	EACH	150.00	1200.00	1200.00
2320	LIN. FT.	18.00	41,760.00	41,760.00
10	F4.0**		46 800 00	46.55
10		1,250.00	12,500.00	12,500.00
	EACH	200.00	4 555 55	
20	LACH	<u> </u>	4,000.00	4,000.00
1	TIME CITA	3,000 00	3.000.00	3,000.00
<u>'</u>	LOWIT SUM	-,	2,000.00	J,000.00
			<u> </u>	
1	LUMP SUM	6,500.00	6,500.00	6,500.00
			<u> </u>	-,200.00
				105,410
1				100,710
				10541
			1	T I
				115,951.00
	1600 1 1 2 2 4 8 8 2320 10	ACRES C.Y. C.Y. EACH EACH EACH EACH LIN. FT. LIN. FT. LIN. FT. S.F. S.Y. S.Y. EACH EACH LIN. FT. LIN. FT. LIN. FT. S.F. S.Y. S.Y. EACH EACH EACH EACH EACH EACH EACH LIN. FT. EACH S.Y. S.Y. S.Y. S.Y. S.Y. S.Y. S.Y. LIN. FT. LIN. FT. LIN. FT. LIN. FT. EACH EACH EACH EACH LIN. FT. LIN. FT. LIN. FT. LIN. FT. EACH EACH EACH LIN. FT. LIN. FT.	ACRES C.Y. C.Y. C.Y. EACH EACH EACH EACH LIN. FT. LIN. FT. LIN. FT. LIN. FT. LIN. FT. LIN. FT. S.F. S.Y. EACH EACH EACH LIN. FT. LIN. FT. LIN. FT. LIN. FT. LIN. FT. S.F. S.Y. S.Y. EACH EACH LIN. FT. EACH S.Y. S.Y. S.Y. S.Y. S.Y. S.Y. S.Y. S.Y. C.Y. C.Y. C.Y. C.Y. C.Y. CACH LIN. FT. 1 EACH 1600 LIN. FT. 18.00 1 EACH 150.00 2 EACH 250.00 EACH 20 EACH 150.00 LIN. FT. 18.00 LIN. FT. 18.00	ACRES C.Y. C.Y. C.Y. C.Y. EACH EACH EACH EACH IIN. FT. IIN. FT. IIN. FT. IIN. FT. S.F. S.Y. S.Y. S.Y. S.Y. S.Y. S.Y. S.Y

GENERAL NOTES

All construction methods and materials shall conform to the Construction Standards and Specifications of Roanoke County and/or the Virginia Department of Transportation.

The contractor or developer is required to notify the Roanoke County Engineering Division in writing at least three (3) days prior to any construction, including, but not limited to the following:

- A. Installation of approved erosion control devices
- B. Clearing and grubbing C. Subgrade excavation
- D. Installing storm sewers or culverts
- E. Setting curb and gutter forms
- F. Placing curb and gutter G. Placing other concrete
- H. Placing gravel base
- I. Placing any roadway surface
- J. Installing water lines

K. Installing sanitary sewer lines

A pre-construction conference should be scheduled with the Roanoke County Engineering Division, to be held at least one (1) day prior to any construction.

Measures to control erosion and siltation must be provided prior to plan approval. Plan approval in no way relieves the developer or contractor of the responsibilities contained within the erosion and siltation control policies.

A permit must be obtained from the V.D.O.T. Residency Office. Rognoke County, prior to construction in the highway right—of—way.

Plan approval does not guarantee issuance of any permits by V.D.O.T.

An approved set of plans and all permits must be available at the

All unsuitable material shall be removed from the construction limits of the roadway before placing embankment.

Field construction shall honor proposed drainage divides as shown

Pavement sections on approved plans are based on a minimum CBR of 10. CBR tests are to be performed by the engineer and submitted to V.D.O.T. and to the Roanoke County Engineering Division prior to placement. CBR values < 10 will require revised pavement sections.

All roadside ditches or grades of more than 5 percent shall be paved with cement concrete to the limits as indicated on the plans and as required at the field inspection.

Location of augrd rails shall be determined at a joint field inspection by the County and V.D.O.T.

All springs shall be capped and piped to the nearest storm sewer or natural watercourse. The pipe shall be 6 inch minimum diameter and conform to V.D.O.T. Standard SB-1.

Standard street and traffic control signs shall be erected at each intersection by the developer prior to final street acceptance.

Construction debris shall be containerized in accordance with the Virginia Litter Control Act. No less than one litter receptacle shall be provided on site.

The contractor shall provide adequate means of cleaning mud from trucks and/or other equipment prior to entering public streets. It is the contractors responsibility to insure that the streets are in a clean, mud and dust free condition at all times.

The developer and/or contractor shall supply all utility companies with copies of approved plans, advising them that all grading and installation shall conform to approved plans.

Contractors shall notify utilities of proposed construction at least two (2), but not more than ten (10) working days in advance. Area public utilities may be notified thru "Miss Utility": 1—800—552—7001.

The developer or contractor shall supply the county with correct As-Built plans before final acceptance.

All work shall be subject to inspection by Roanoke County and/or V.D.O.T. inspectors.

Field corrections shall be approved by the Roanoke County Engineering Division prior to such construction.

100 year floodway and floodplain information shall be shown where

Grade stakes shall be set for all curb and gutter, culvert, sanitary sewer and storm sewer.

INDEX

- COVER SHEET
- SEWER PLAN AND PROFILE
- SEWER PLAN AND PROFILE
- WATER PLAN AND PROFILE
- EROSION CONTROL DETAILS
- NOTES AND DETAILS

11-06-03 REVISED PER COUNTY COMMENTS 12-23-03 REVISED PER COUNTY COMMENTS 2-24-04 REVISED PER COUNTY COMMENTS 4-16-04 REVISED PER COUNTY COMMENTS 12-13-04 REVISED PER VDOT COMMENTS 12-29-04 REVISED PER VDOT COMMENTS 3-06-06 REVISED PER AS-BUILT CONDITIONS

SEWER NOTES

A minimum cover of three (3) feet is required over proposed lines.

Contractor shall be responsible for locating and uncovering all manholes after paving. Manhole tops shall be adjusted to grade if necessary.

exact location. The contractor shall comply with State Water Works Regulations, Section 12.05.03, where lines cross.

All existing utilities may not be shown or may not be shown in the

House connections are to be made with 4" pipe installed at a minimum grade of 1/4 inch to 1 foot in R/W.

Laterals from manholes shall be PVC or Ductile Iron of sufficient length to provide two (2) feet of bearing on natural ground. The transition from ductile iron to asbestos cement or concrete pipe shall be made with an adapter coupling in R/W.

All trenches in existing or future rights—of—way shall be compacted according to V.D.O.T. standards.

Lines shall be staked prior to construction.

All water and sanitary sewer facilities are to be installed according to the Roanoke County Water and Sanitary Sewer Design and Construction

WATER NOTES

A minimum cover of three (3) feet is required over proposed lines.

Contractor shall be responsible for locating and uncovering valve vaults after paving and adjustment to final grade if necessary.

All existing utilities may not be shown or may not be shown in the exact location. The contractor shall comply with the State Water Works Regulations, Section 12.05.03, where lines cross.

All trenches in existing or future highway right—of—ways shall be compacted according to V.D.O.T. standards.

Lines shall be staked prior to construction.

Water main shall be minimum Class 52 Ductile Iron in accordance to AWWA C151 or DR-14 PVC in accordance with AWWA C-900. Availability number ______03-168


All water and sanitary sewer facilities are to be installed according to the Roanoke County Water and Sanitary Sewer Design and Construction

Connections to the water and sewer lines shall be coordinated at the preconstruction meeting.

Single Residential Service for High Pressure (WDD-02) will be required for all lots of this development.

LEGEND

Property Line	
Right-of-way	
Centerline	
Minimum Building Line	
Existing Storm Sewer	
Existing Sanitary Sewer	
Existing Water Main	
Existing Contour	— — — — — — — — — — — — — — — — — — —
Proposed Contour	1155
Proposed Drainage Divide	
Proposed Limits of Clearing	
Proposed Storm Sewer	
Proposed Sanitary Sewer	
Proposed Water Main	

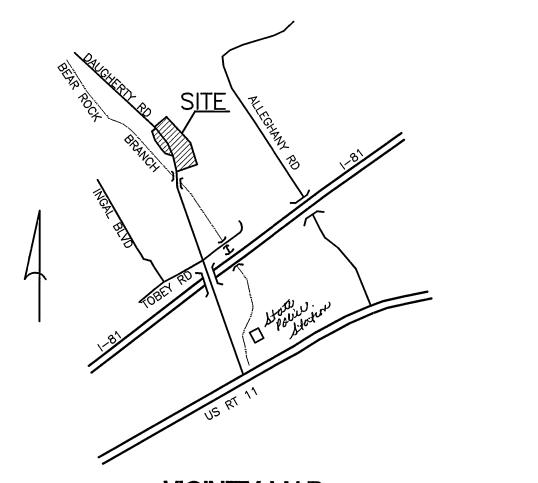

VICINITY MAP

SURVEY INFORMATION

Horizontal and vertical control surveys were performed in (year) All elevations must be referenced to the National Geodetic Vertical Datum of 1929.


Source of topographic mapping is BALZER AND ASSOCIATES, INC.

dated AUGUST 2003

BALZER AND ASSOCIATES, INC. Boundary was performed by_ dated_AUGUST 2003

The professional seal and signature below certifies the boundary survey and topographic mapping to be accurate and correct.

BENCHMARK: RAILROAD SPIKE IN UTILITY POLE ELEVATION 1228.15

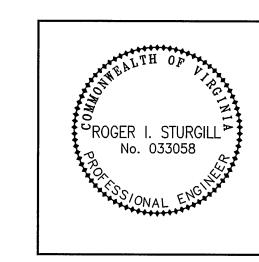

PROFESSIONAL ENGINEER SEAL AND SIGNATURE

OWNER/DEVELOPER, AM AWARE

WVWA ID# 6PUQAN SHEET_ 1

COUNTY OF ROANOKE

NAME OF DEVELOPMENT BEAR ROCK SUBDIVISION	OF THE SITE DESIGN REQUIREMENTS IMPOSED BY THIS SITE DEVELOPMENT PLAN AND OTHER APP—
MAGISTERIAL DISTRICT(S) CATAWBA	LICABLE COUNTY CODES. I HEREBY CERTIFY THAT I AGREE TO COMPLY WITH THESE REQUIREMENTS, UNLESS MODIFIED IN ACCORDANCE WITH LOCAL LAW
A.M. COOPER CONSTRUCTION OWNER (name, address, telephone) 4430 OLD CAVE SPRING ROAD ROANOKE, VA 24018 540-989-0920	FAX 540-989-7523
A.M. COOPER CONSTRUCTION DEVELOPER (name, address, telephone) 4430 OLD CAVE SPRING ROAD ROANOKE, VA 24018 540-989-0920	FAX 540-989-7523
ENGINEER, ARCHITECT OR SURVEYOR (name, address, telephone) BALZER AND ASSOCIATES INC 1208 CORPORATE CIRCLE ROANOKE, VA 24018	540-772-9580 FAX 540-772-8050
TAX MAP NO(S) 54.02 (55.01) BLOCK NO(S) 1 (1)	PARCEL NO(S) 9,9.1 (60)