


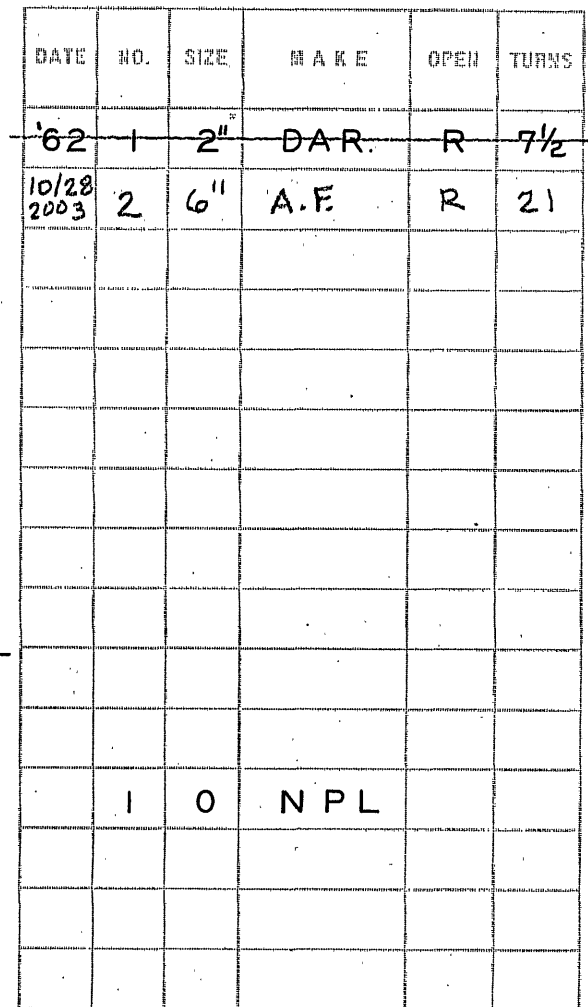

CITY OF ROANOKE—WATER DEPT.	
VALVE DIAGRAM	
BEECH STREET &	
LILAC AVENUE N.W.	
WEST INTERSECTION	
SEC. MAP	263
DATE	PAGE NO.