

DATE:	12-17-02
REVISIONS	
△	
△	
△	
△	


PIERSON
ENGINEERING
&
SURVEYING

P.O. BOX 311
1324 ROANOKE ROAD
DALEVILLE, VA 24083

(540) 966-3027 TEL
(540) 966-5906 FAX
e-mail: rplerson@rbnet.com



SEWERLINE PROFILE
FOR
PARSELL ZEIGLER
CITY OF ROANOKE, VIRGINIA

PROFILE SHEET

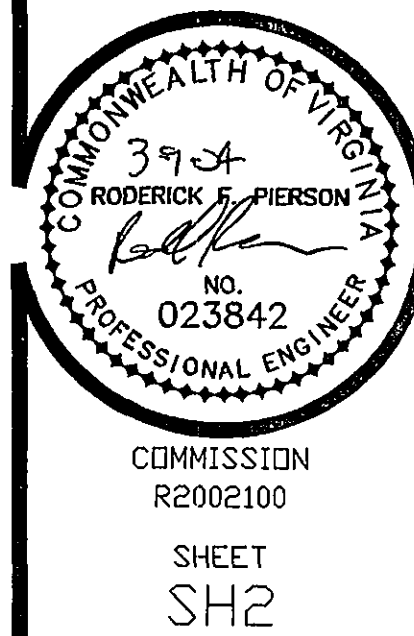

COMMISSION
R2002100

SHEET
SH2

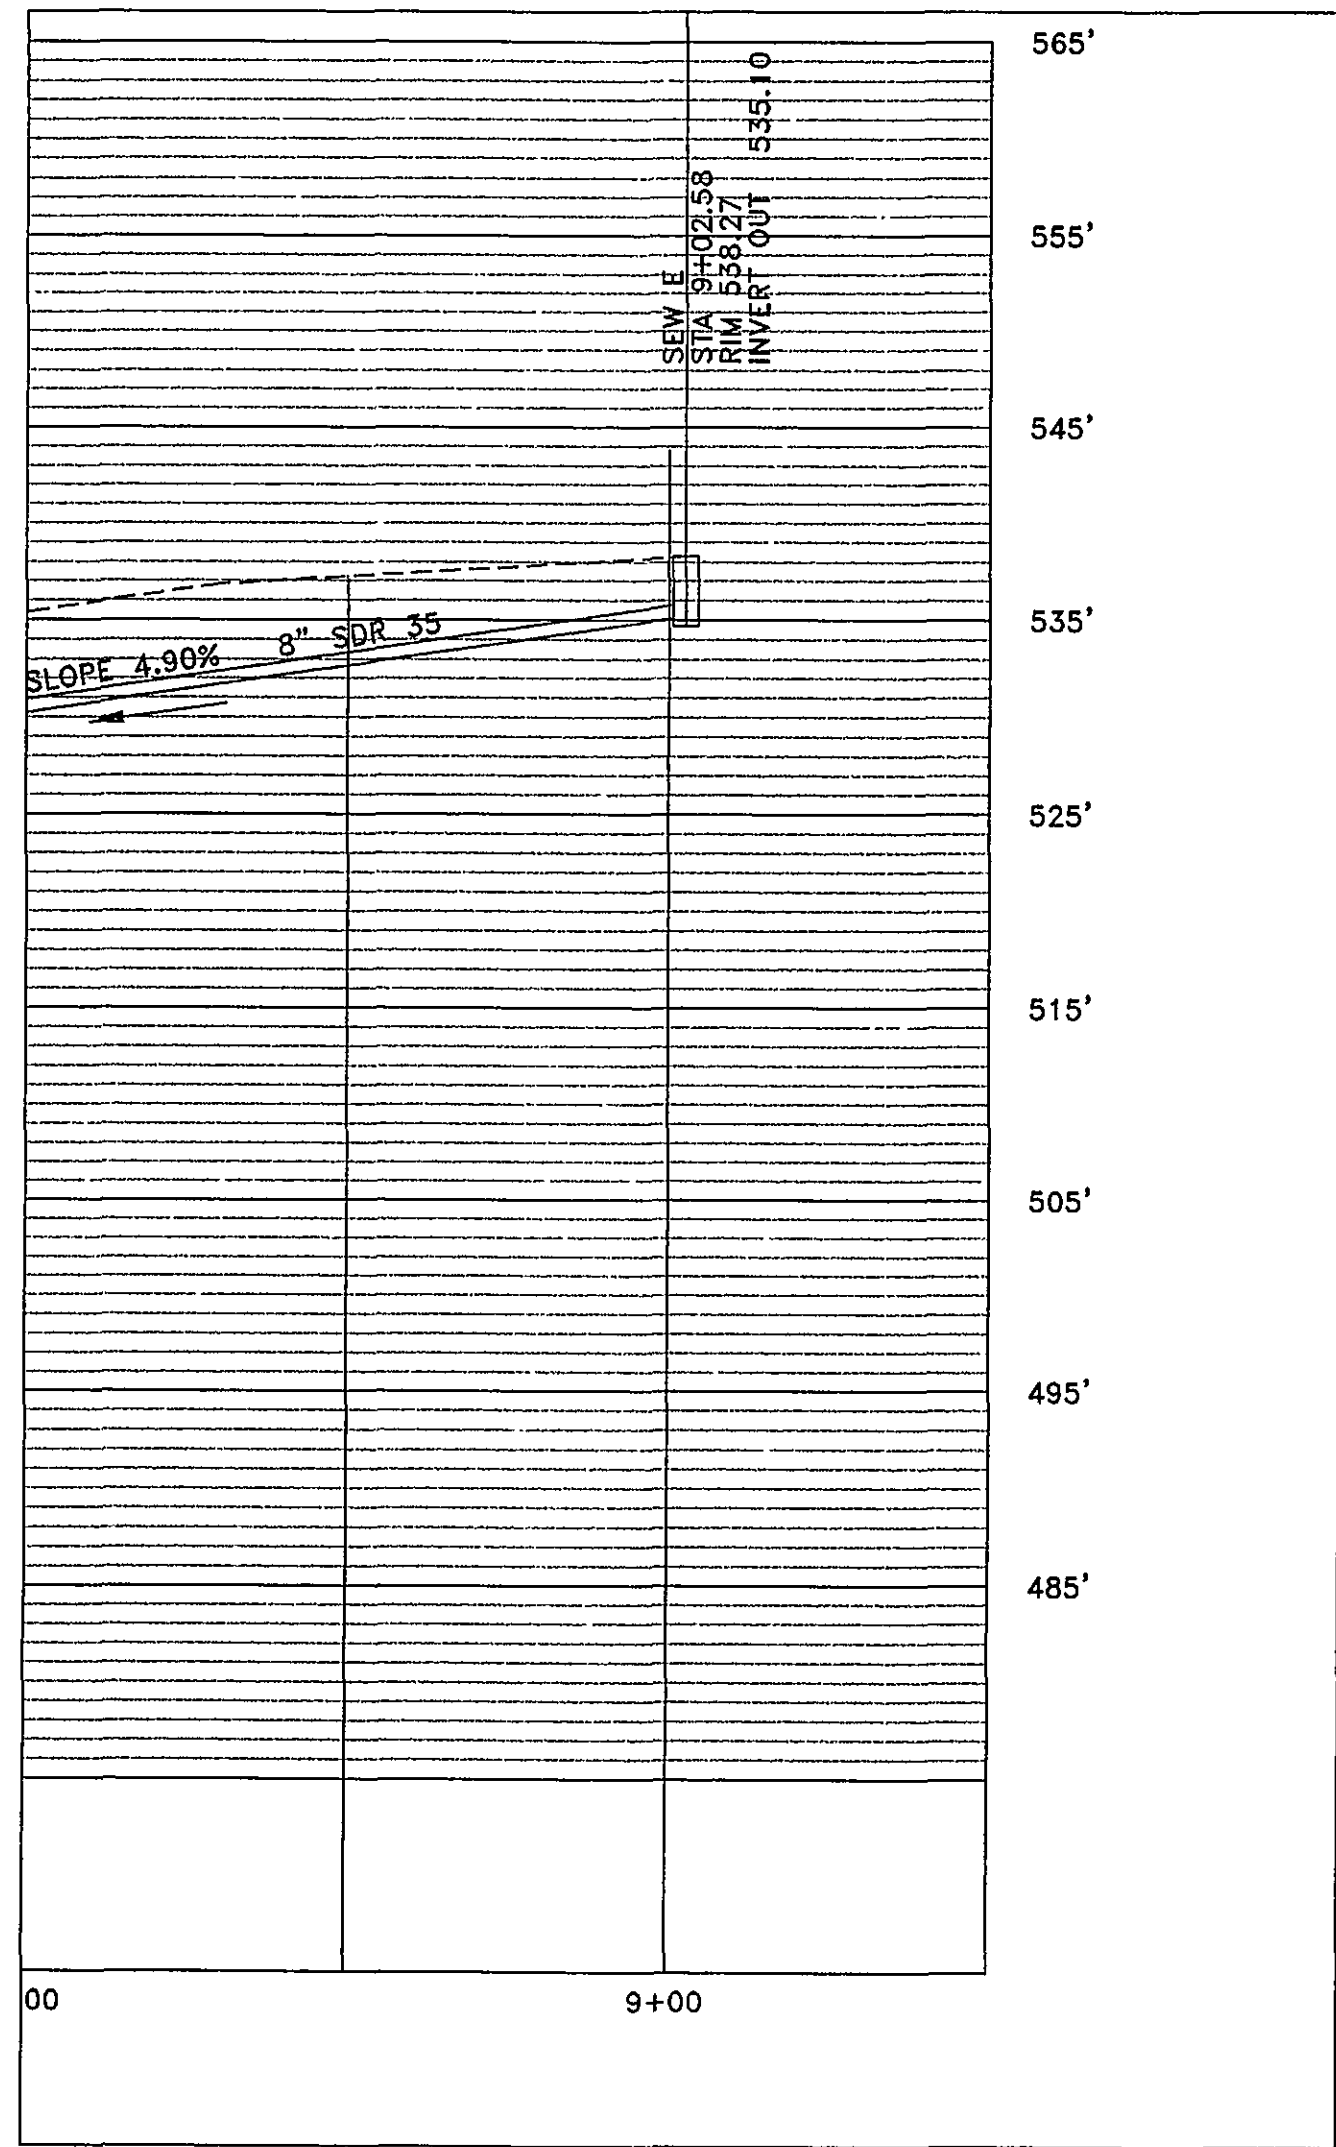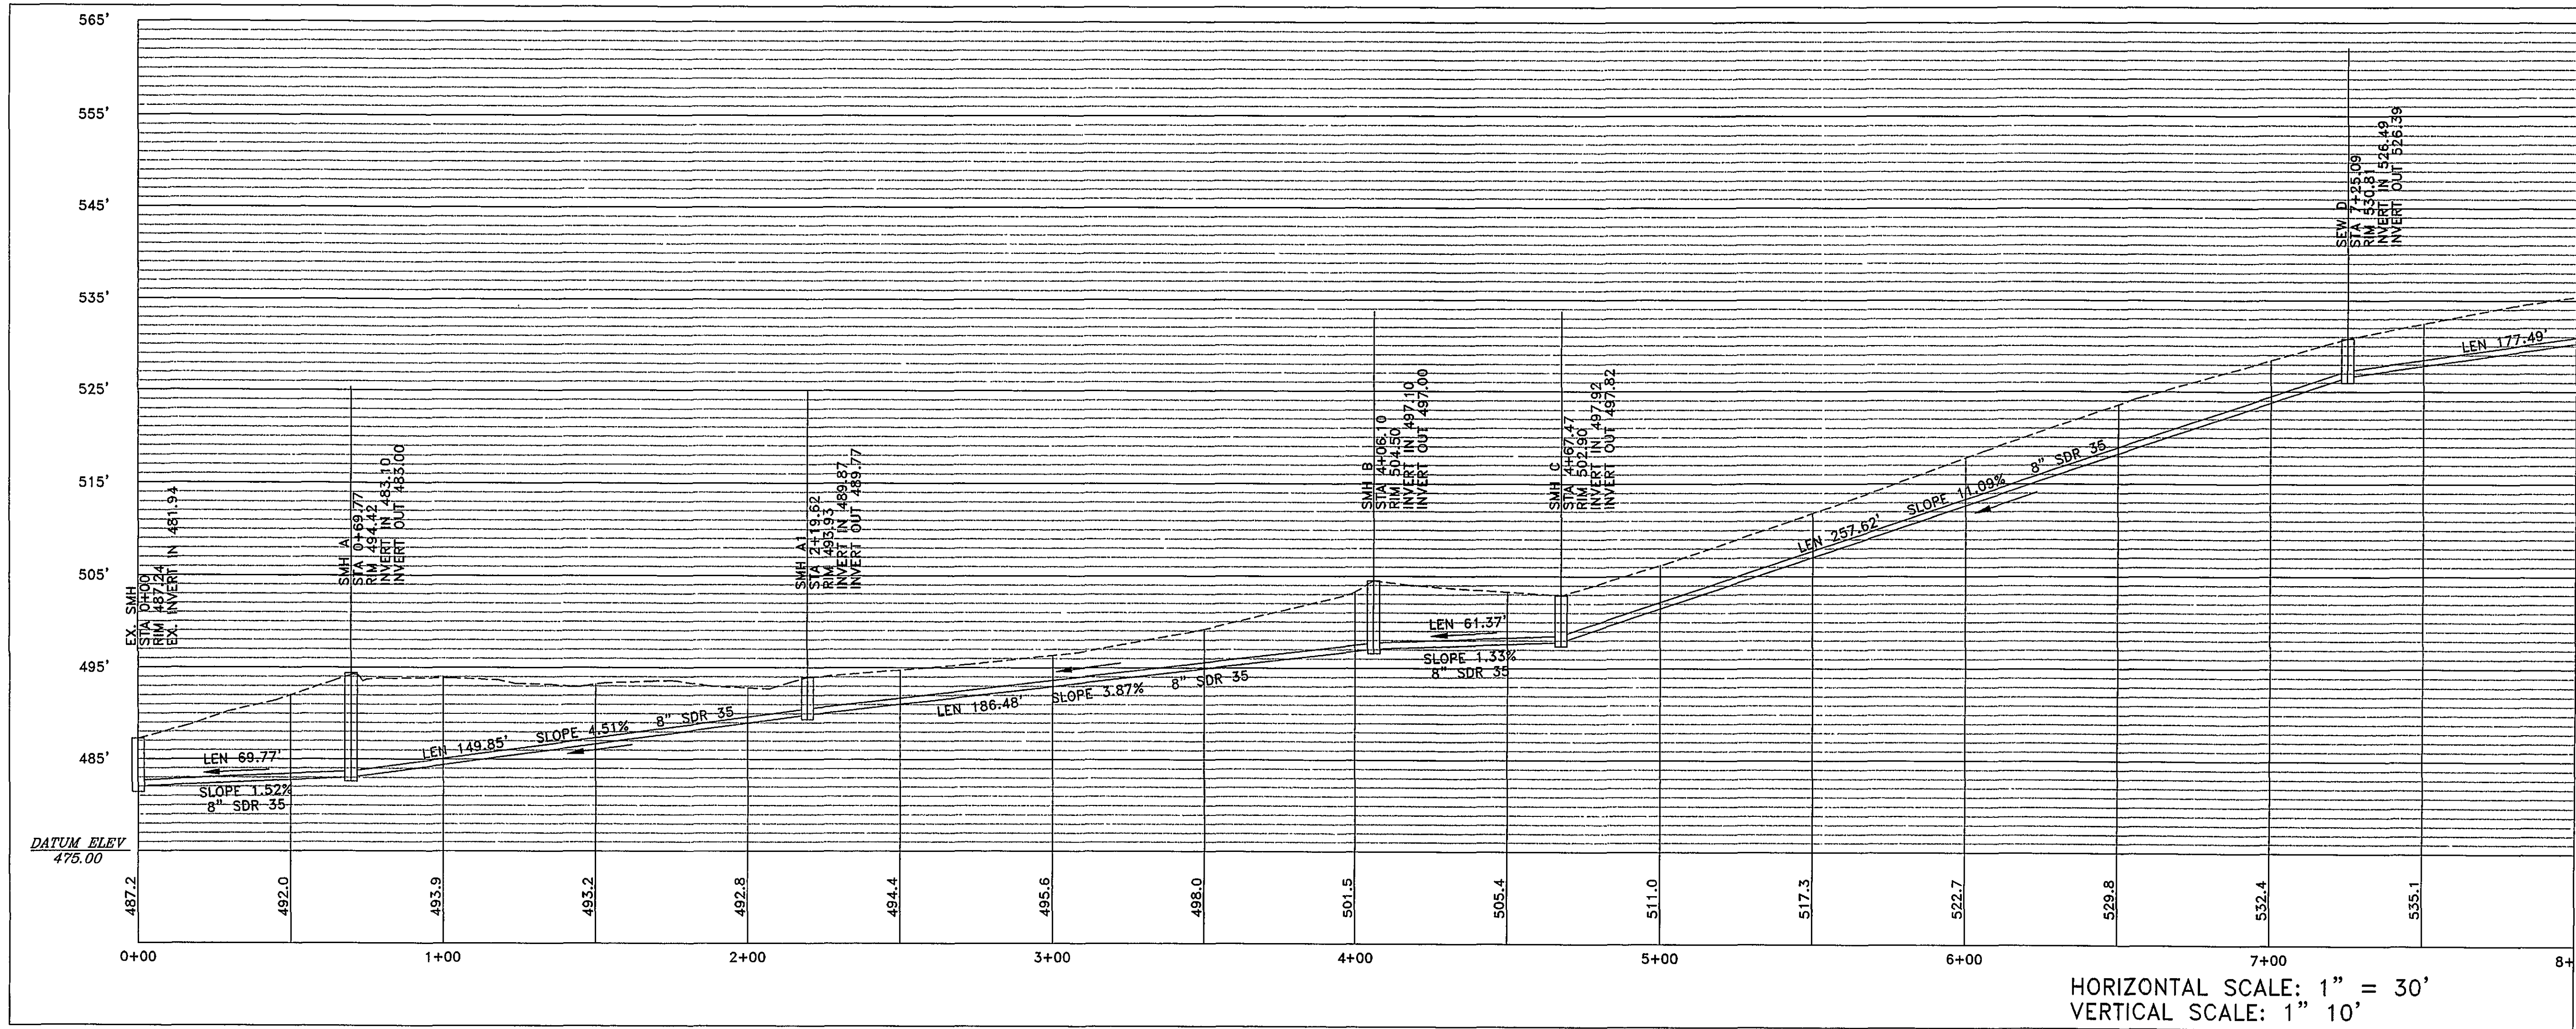

AS-BUILTS

C/VINTONSEWERPARSELL