



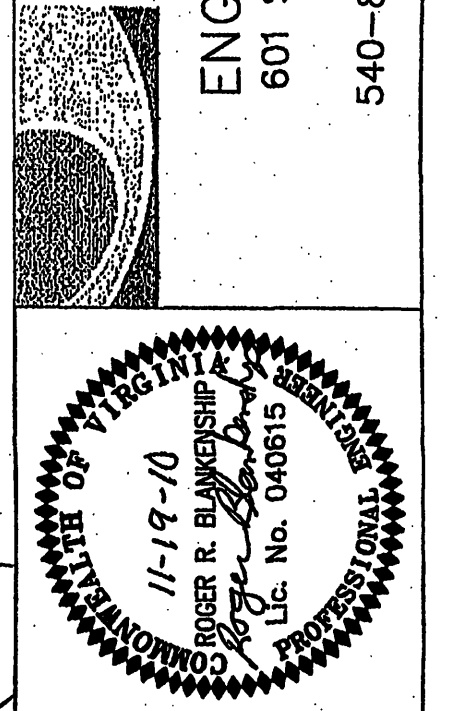



BELLE HAVEN WATERLINE
PLAN & PROFILE

Rev	Description	Date	By

Designed: AAS
 Drawn: AAS
 Checked: RRB
 Approved:
 Date: 11/19/10
 Project:

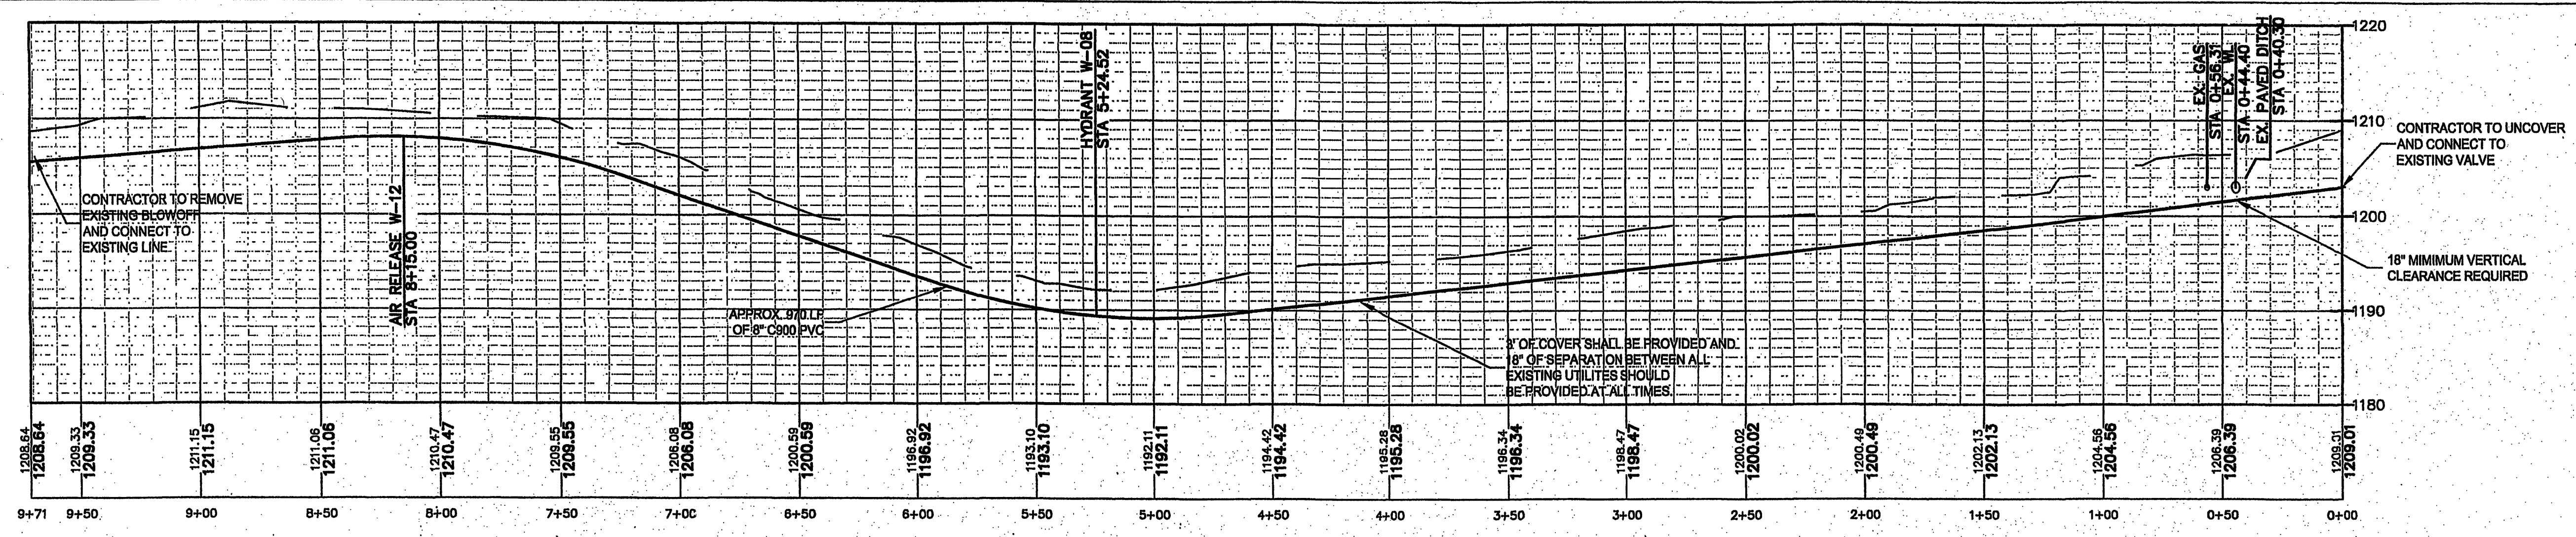

MARTINDALE/TOWNSEND WATER PROFILE
 SCALE
 VERTICAL: 1" = 10'
 HORIZONTAL: 1" = 40'

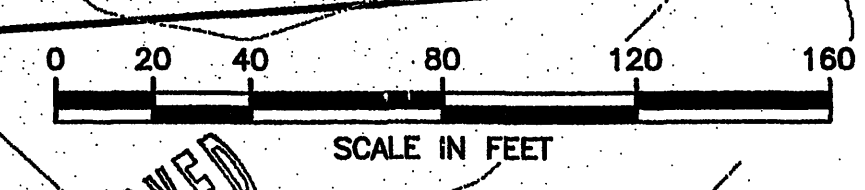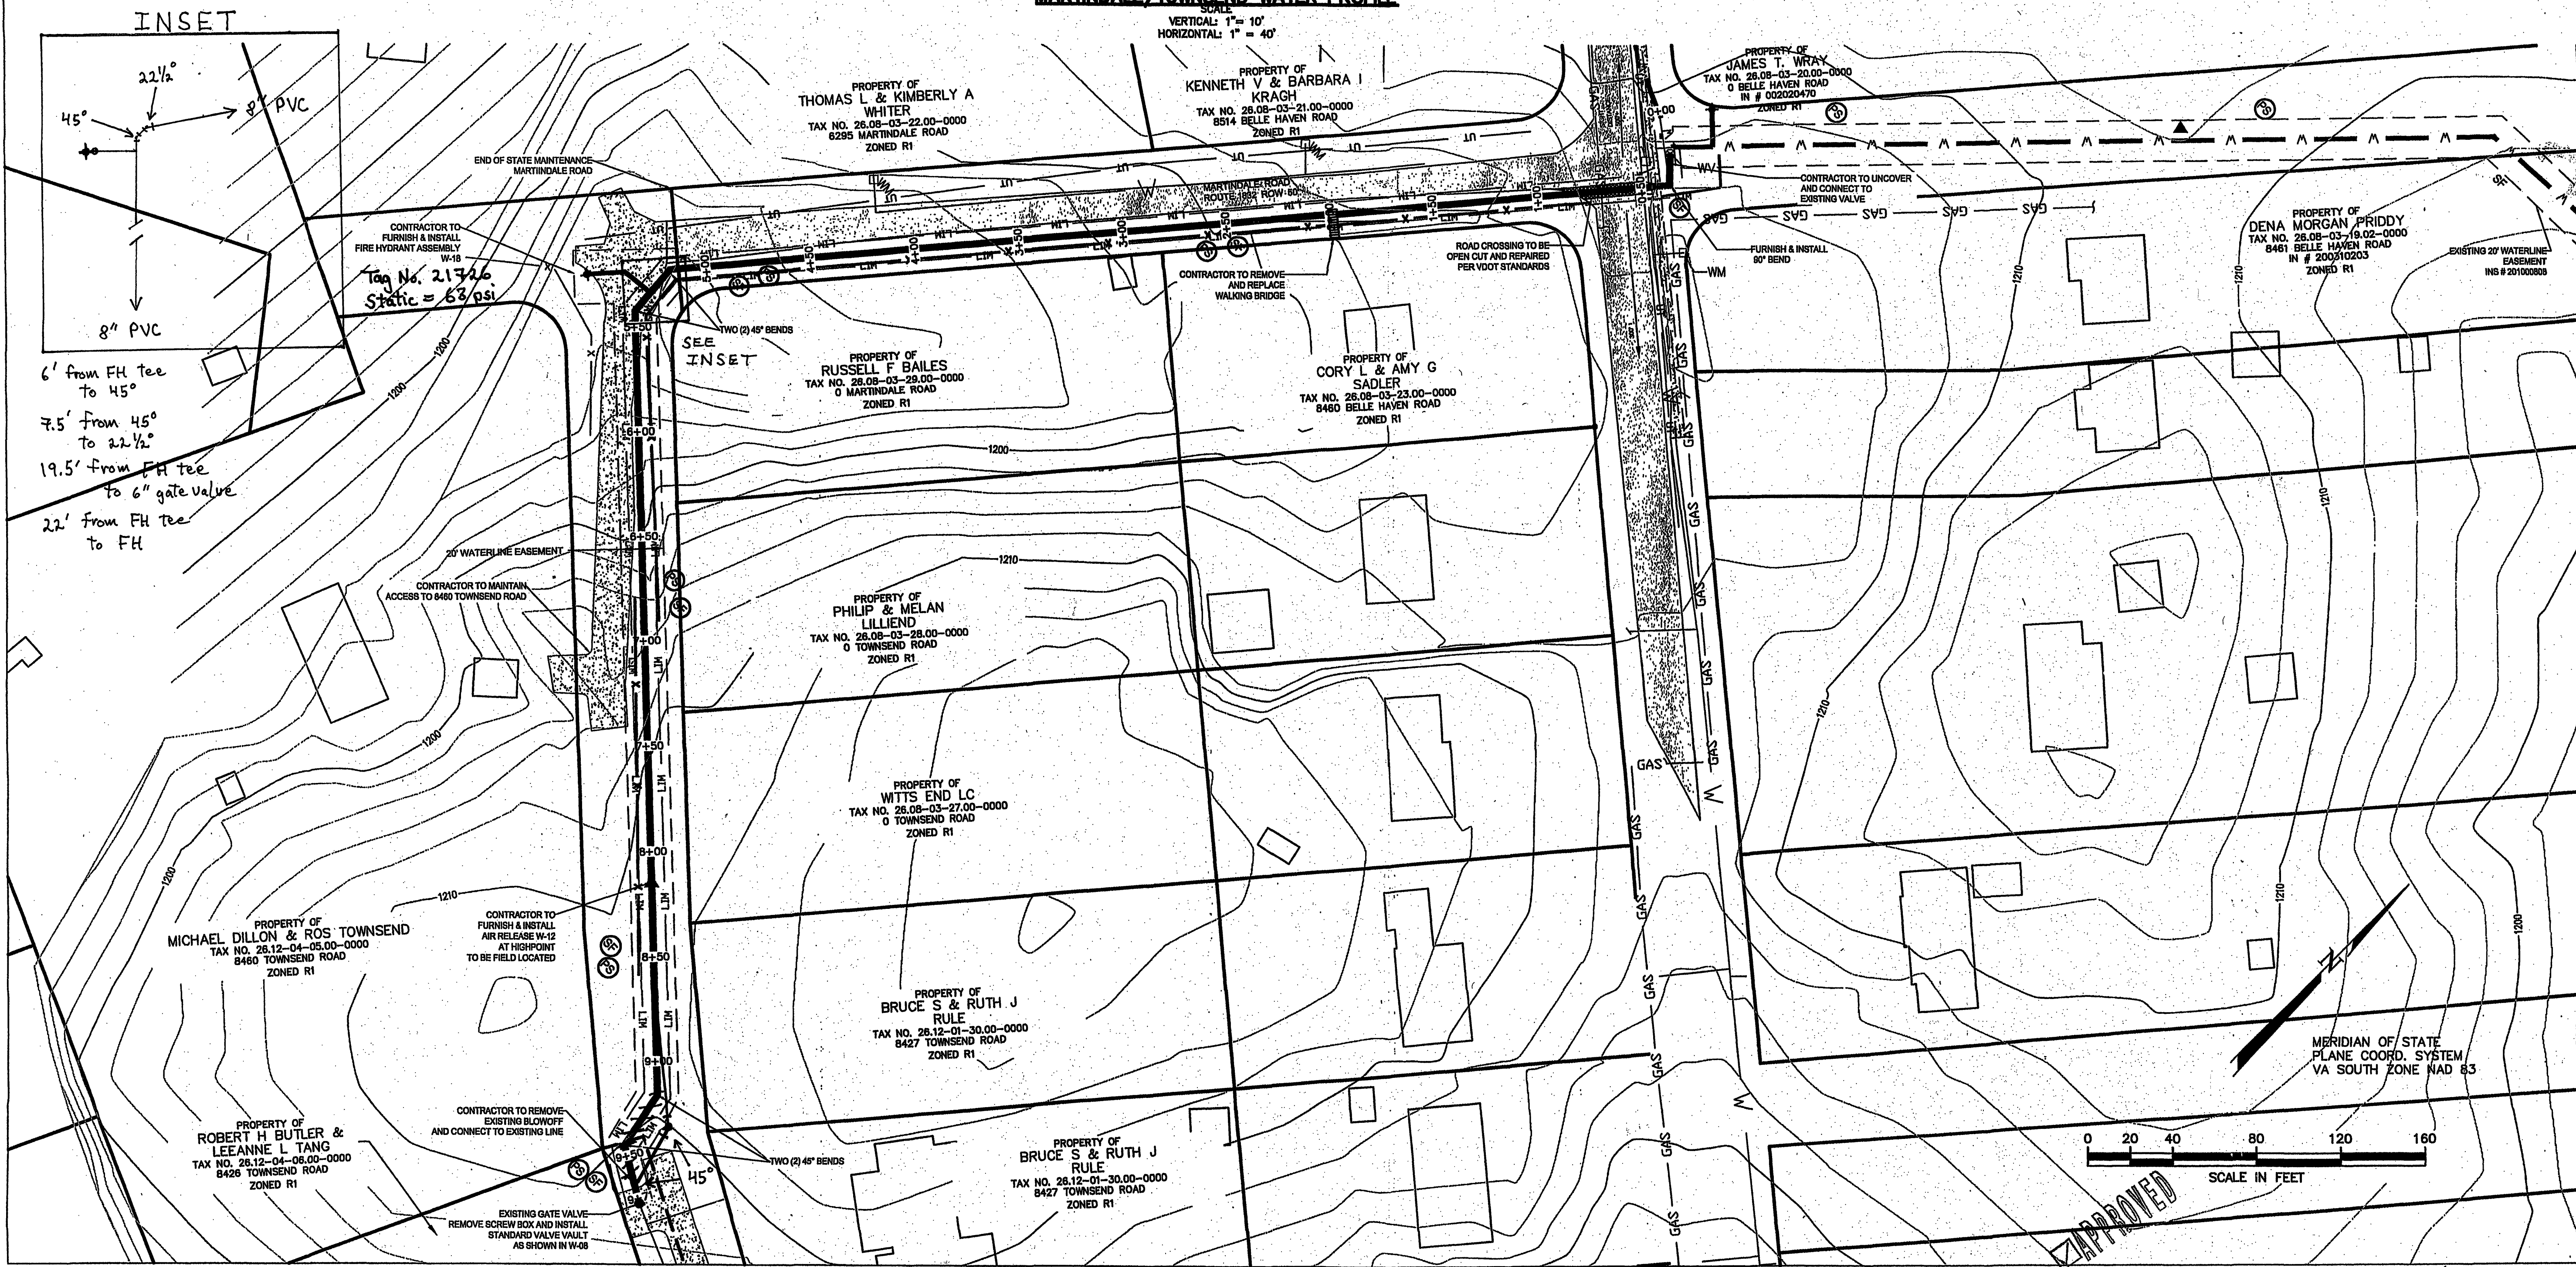

APPROVED

As-Built 2.16.12 K. Winslow