



**WATERLINE PLAN VIEW**  
SCALE: 1"=50'

THIS PLAN IS FOR THE CONSTRUCTION OF A NEW WATERLINE PARALLEL TO BLUE HILLS VILLAGE DRIVE. REFERENCE THE APPROVED PLANS DATED 07/12/07 FOR ALL OTHER SITE CONSTRUCTION INFORMATION. EASEMENT RECORDED SEE P.B. 1 PG. 3209-3110.

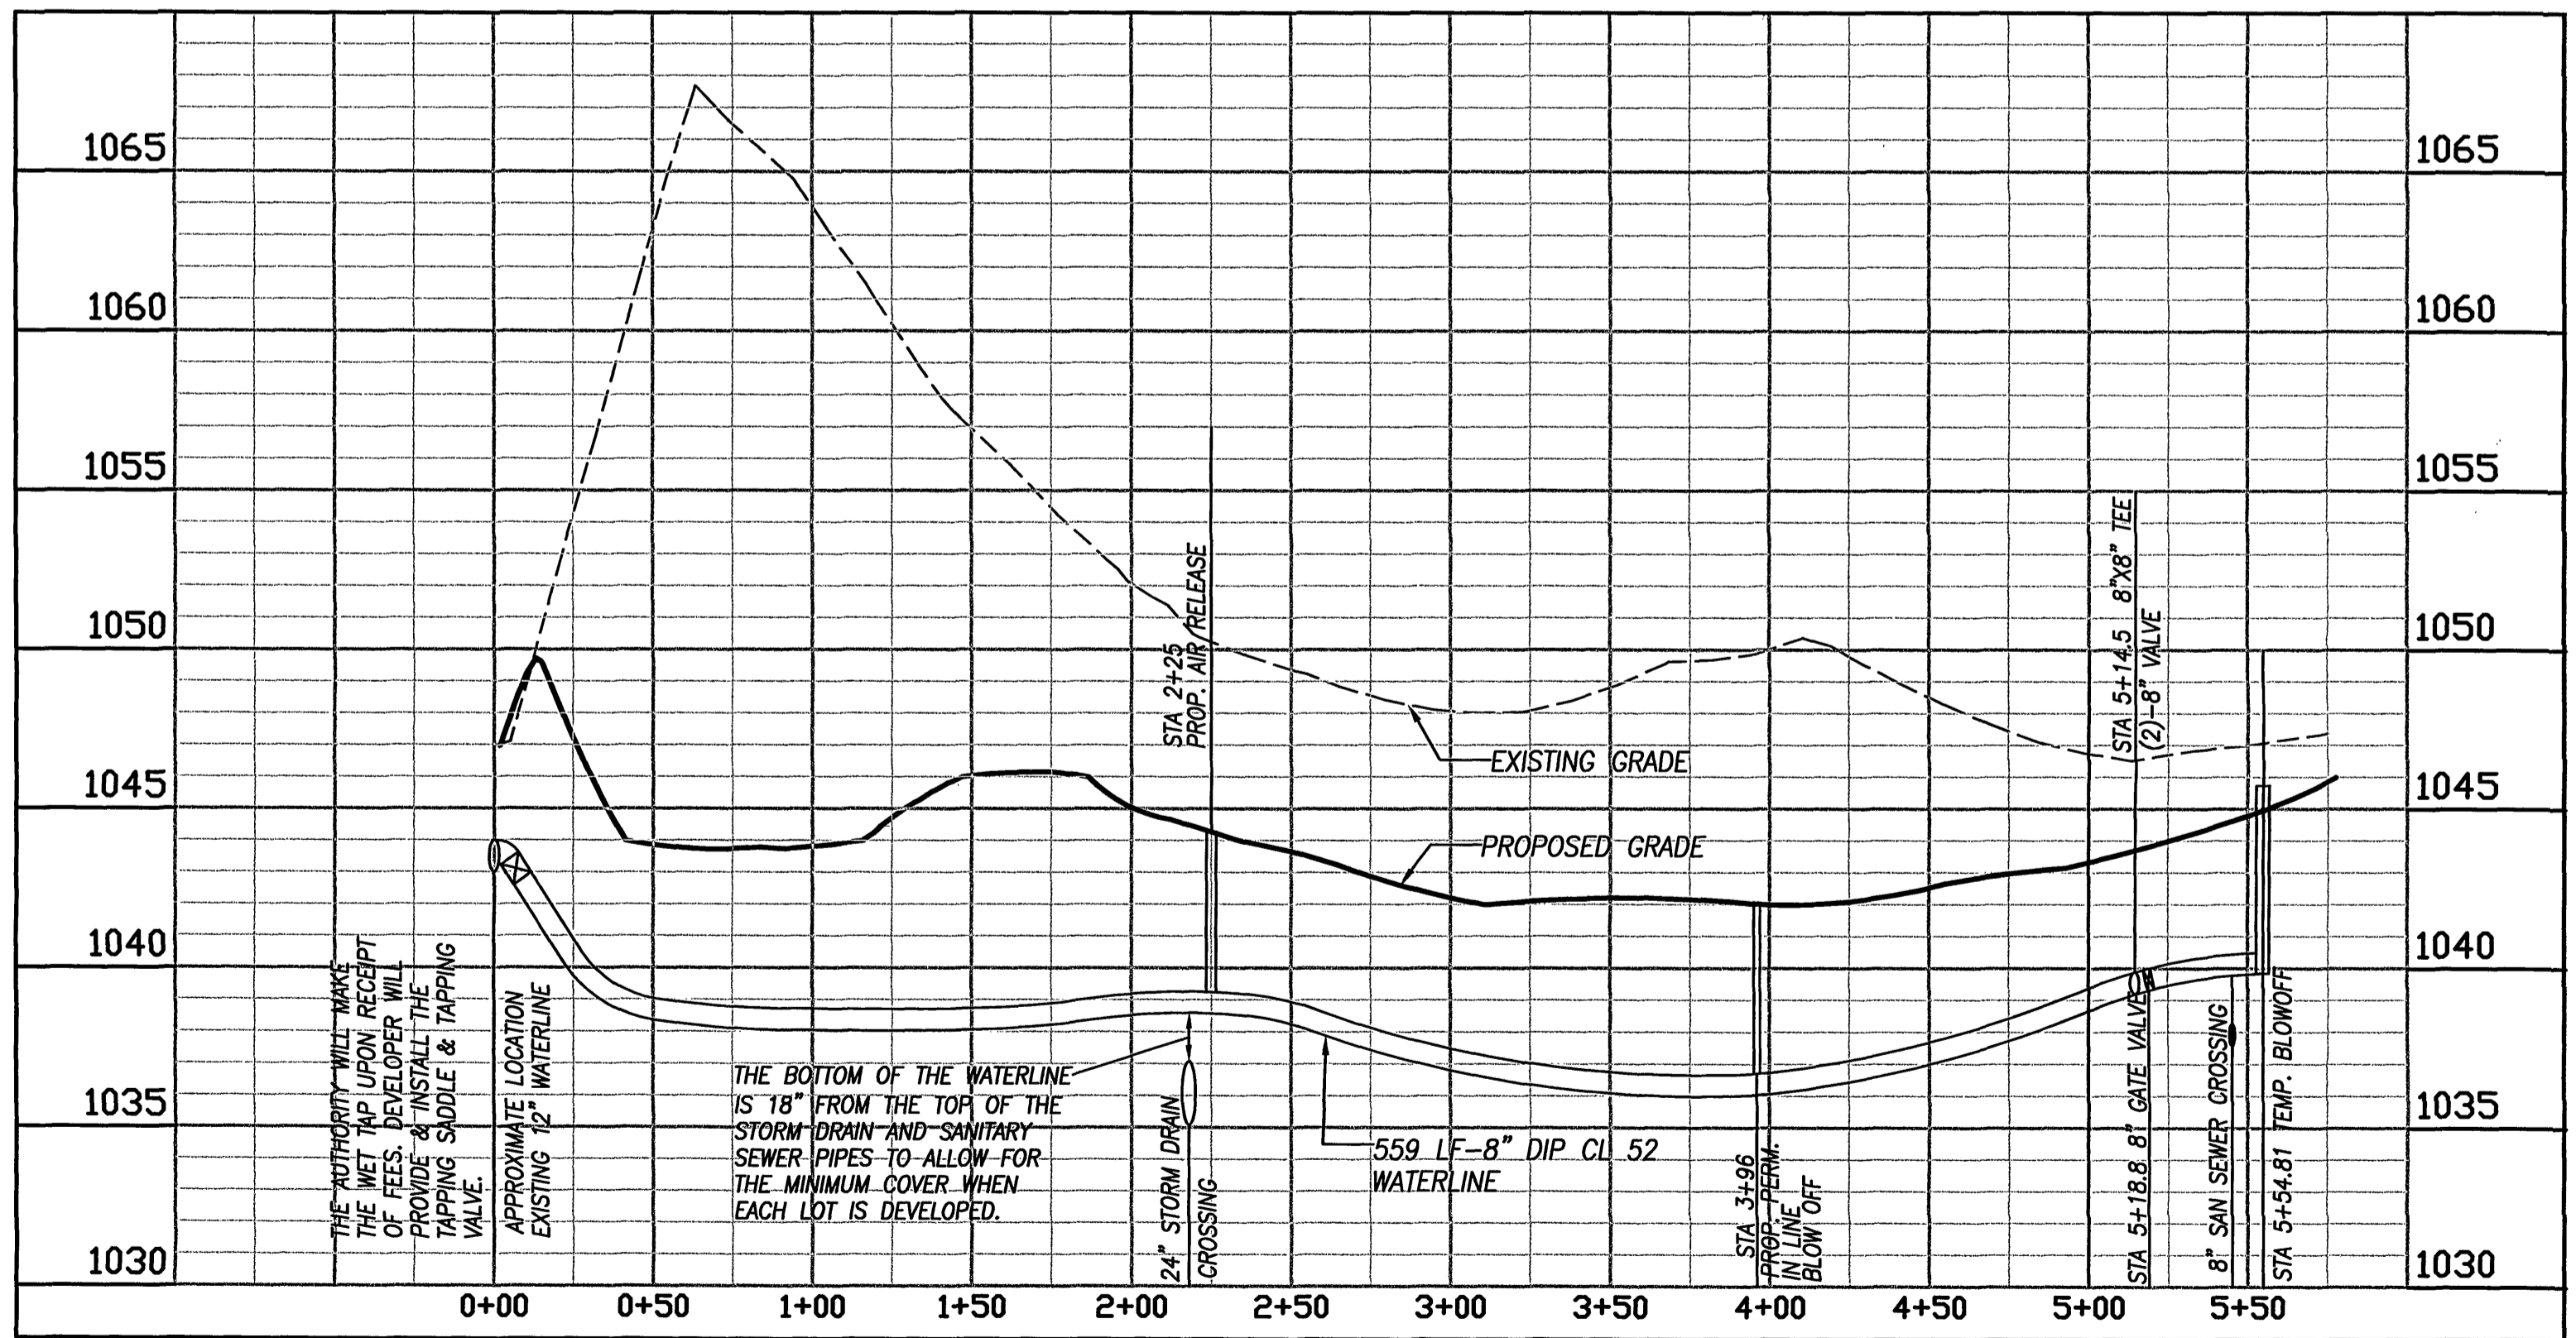


**WATERLINE PROFILE**  
SCALE: 1"=50' HORZ  
1"=5' VERT

THIS PLAN IS FOR THE CONSTRUCTION OF A NEW WATERLINE PARALLEL TO BLUE HILLS VILLAGE DRIVE. REFERENCE THE APPROVED PLANS DATED 07/12/07 FOR ALL OTHER SITE CONSTRUCTION INFORMATION. EASEMENT RECORDED SEE P.B. 1 PG. 3209-3110.

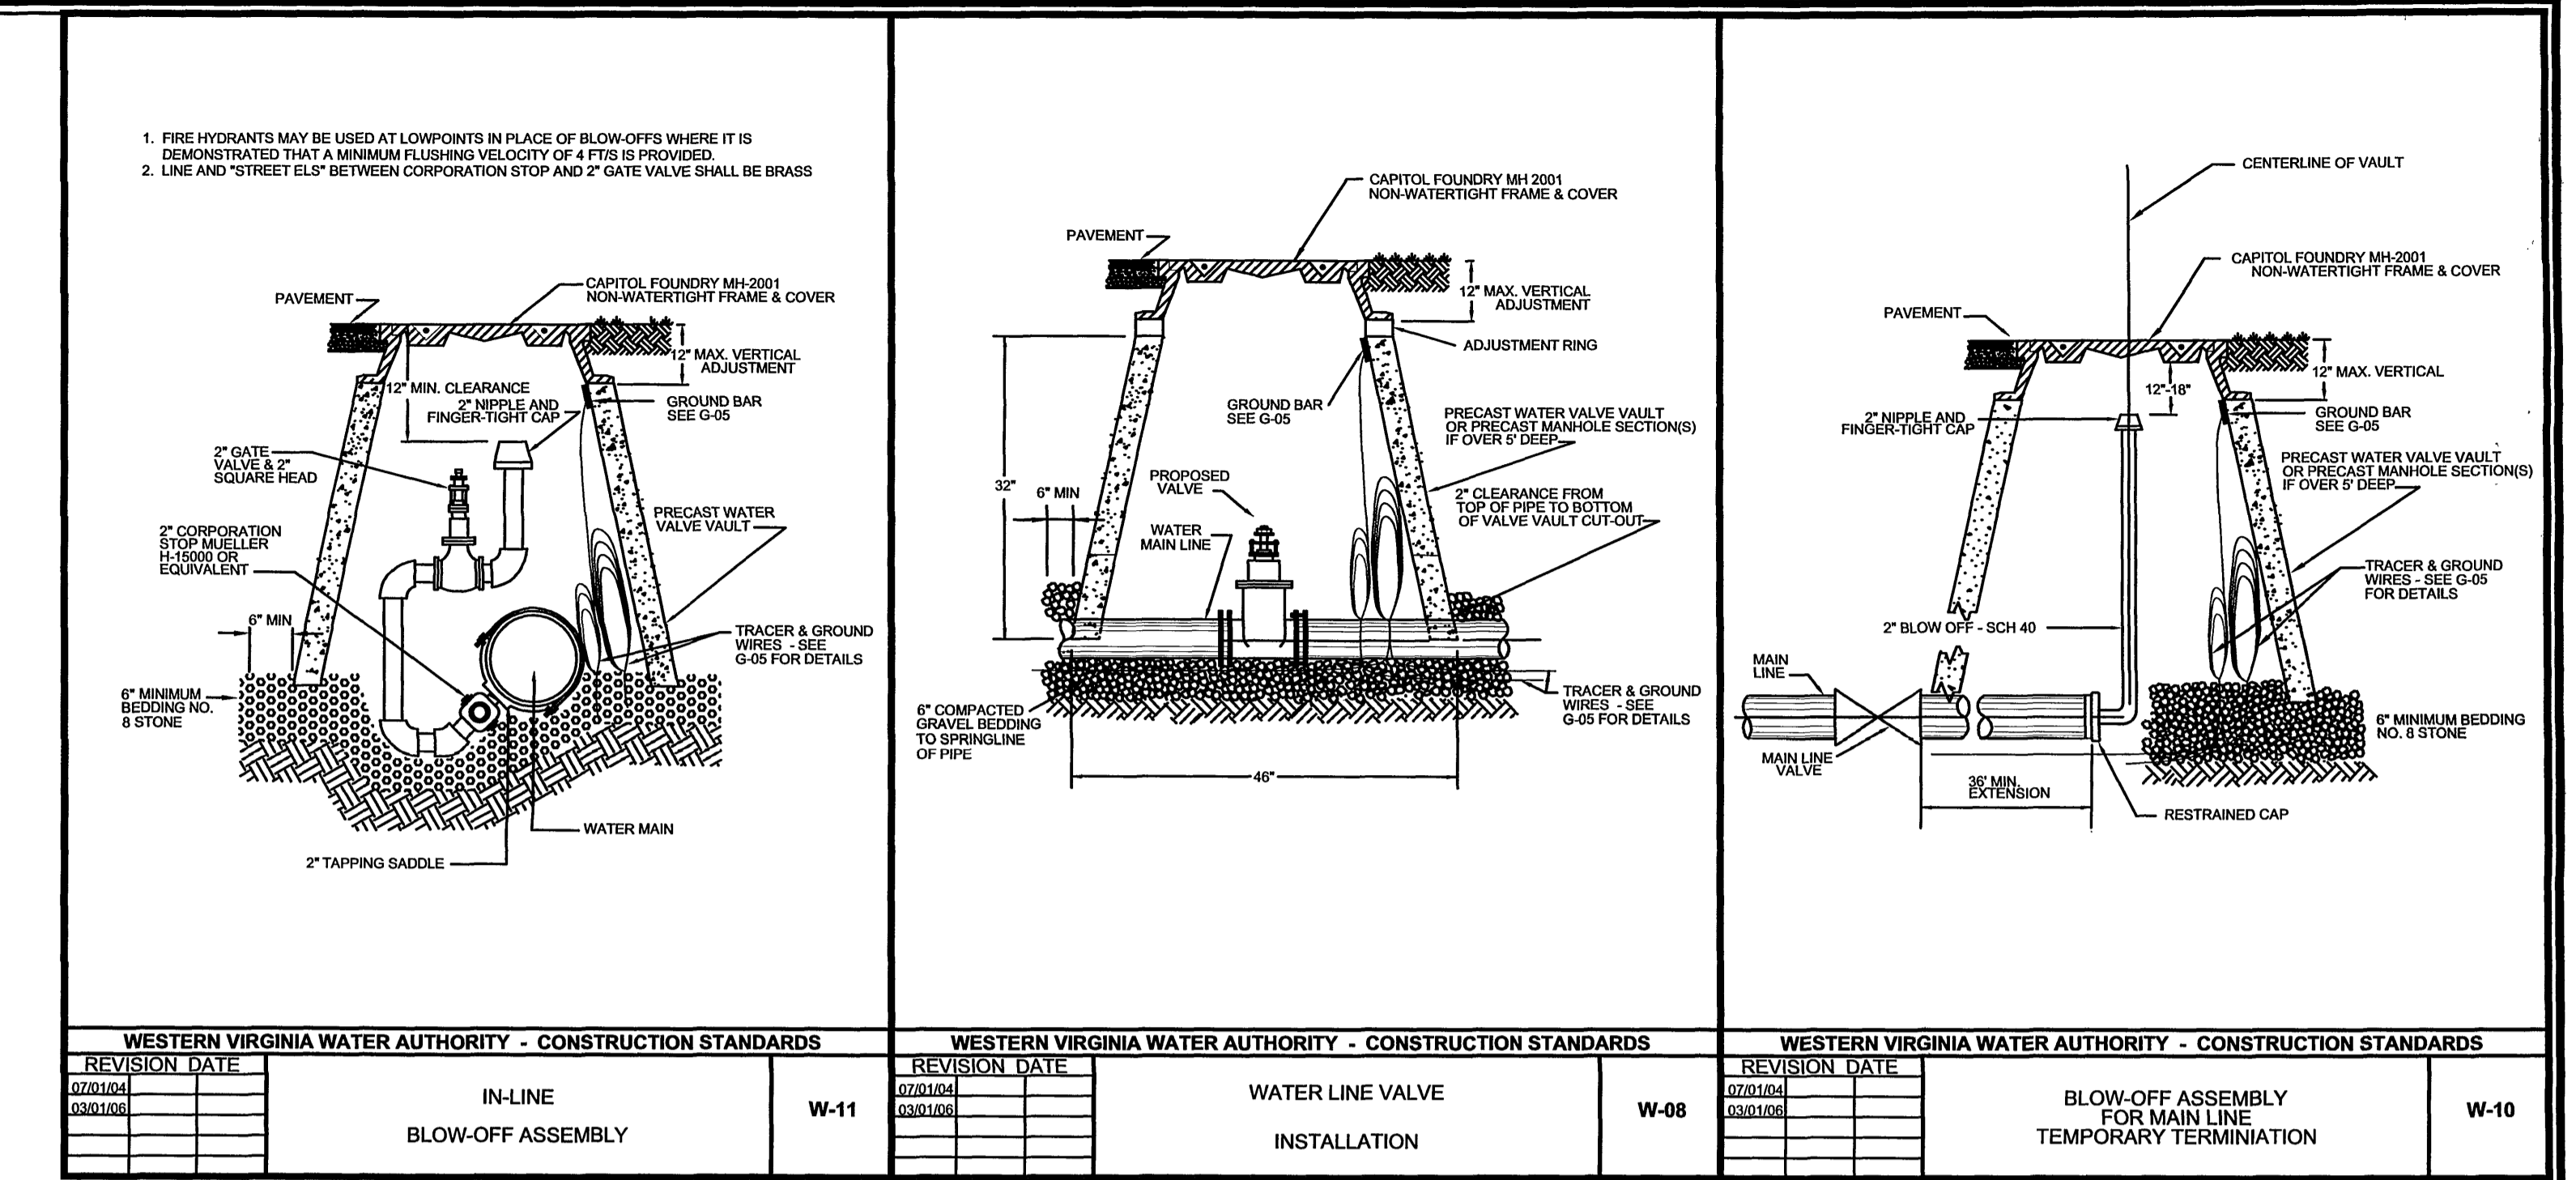

WESTERN VIRGINIA WATER AUTHORITY - CONSTRUCTION STANDARDS

REVISION DATE	DESCRIPTION	W-11	REVISION DATE	DESCRIPTION	W-08	REVISION DATE	DESCRIPTION	W-10
07/20/04			07/20/04			07/20/04		
03/01/06			03/01/06			03/01/06		

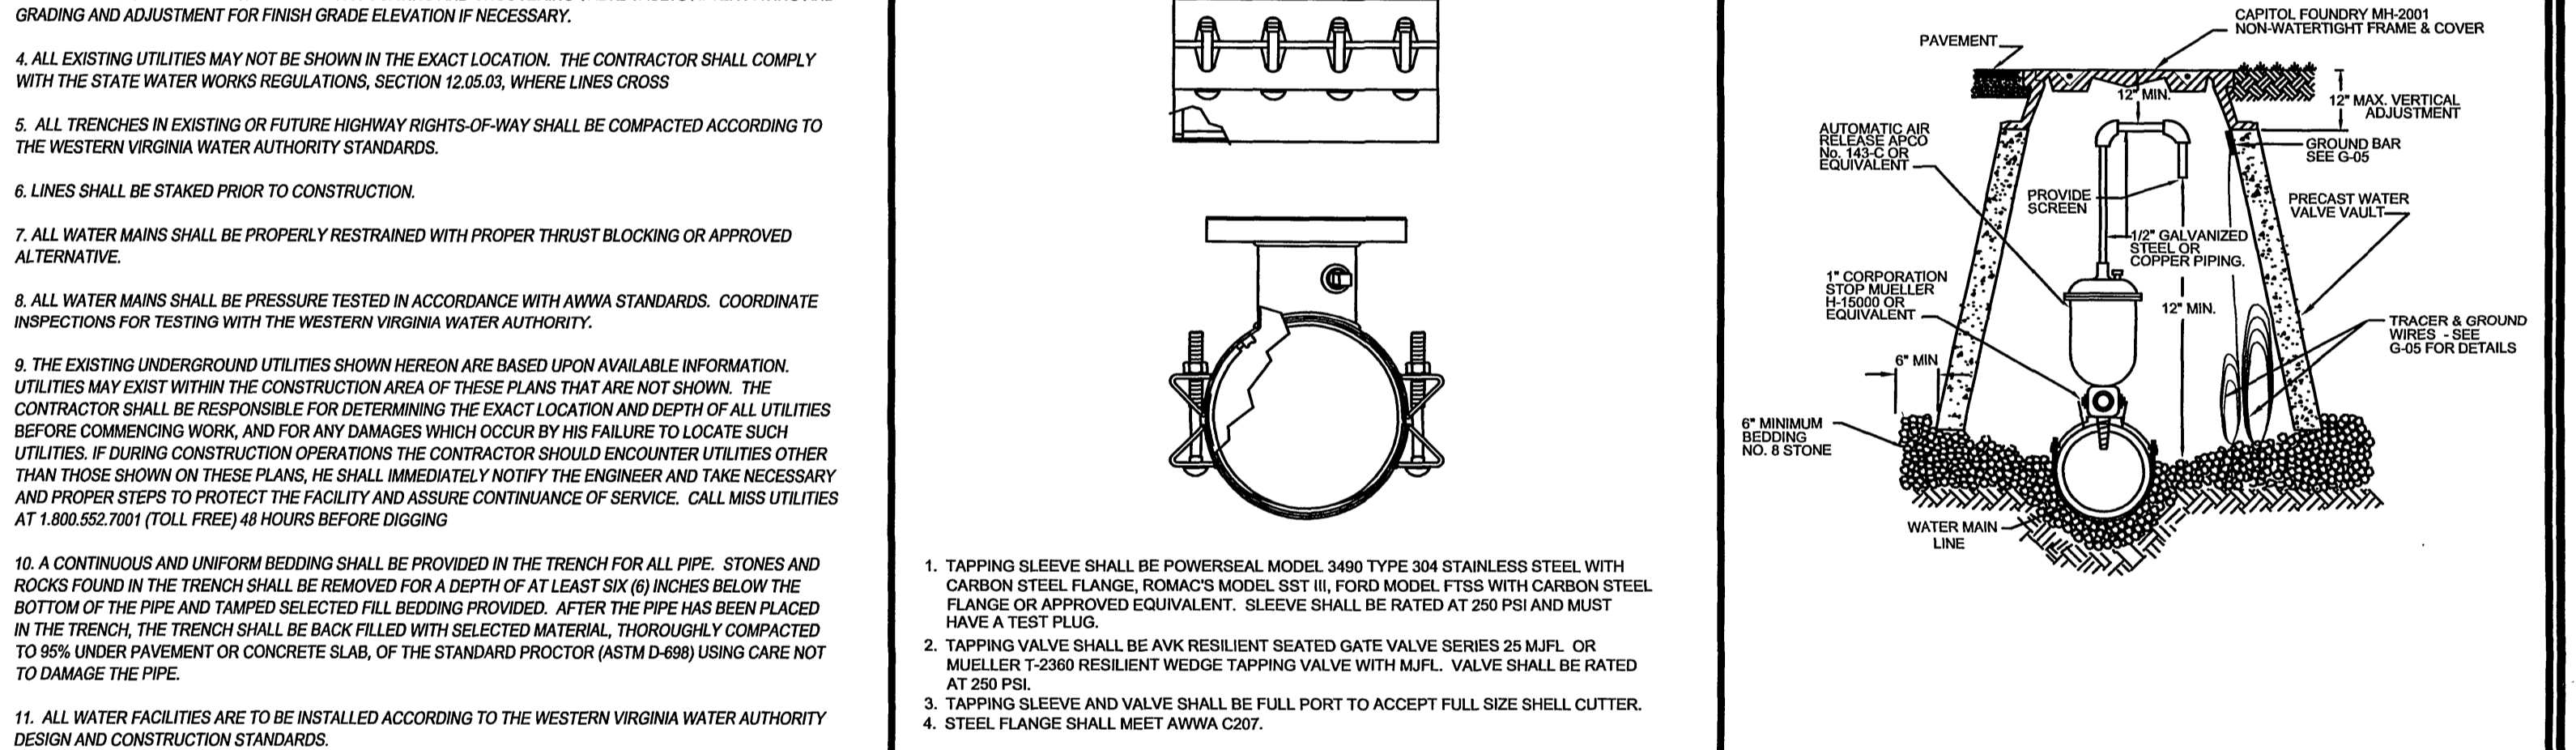

WESTERN VIRGINIA WATER AUTHORITY - CONSTRUCTION STANDARDS

REVISION DATE	DESCRIPTION	W-23	REVISION DATE	DESCRIPTION	W-12
07/20/04			07/20/04		
03/01/06			03/01/06		

15. THIS PLAN IS FOR THE CONSTRUCTION OF A NEW WATERLINE PARALLEL TO BLUE HILLS VILLAGE DRIVE. THE WATERLINE WAS SHOWN ON THE APPROVED PLANS BUT NOT REVIEWED FOR CONSTRUCTION. REFERENCE APPROVED BLUE HILLS VILLAGE PLANS DATED 07/12/07 FOR SITE CONSTRUCTION.  
16. DUE TO WORKING PRESSURES ABOVE 100 PSI DUCTILE IRON PIPE IS REQUIRED.

AS-BUILTS ON WATER  
4-22-2008  
MARK SINR  
CONTRACTOR'S SET

Water main  
Ductile Iron class 52  
American pipe  
valves are 8" muller  
Right to close 27 turns  
Install date is 10-22-07

See page's 5+10 For Sewer

**ENGINEERING CONCEPTS, INC.**  
3433 BRAMBLETON AVENUE, SUITE 200B  
ROANOKE, VIRGINIA 24018  
540.776.5715 FAX: 540.776.8543

Drawn DRB	<b>FIELD REVISION WATERLINE EXTENSION</b> <b>BLUE HILLS VILLAGE ROANOKE, VIRGINIA</b>	SCALE: AS SHOWN
Designed JDE		SEPT. 20, 2007
Checked JDE		PROJECT: 06067
Approved JDE		1

