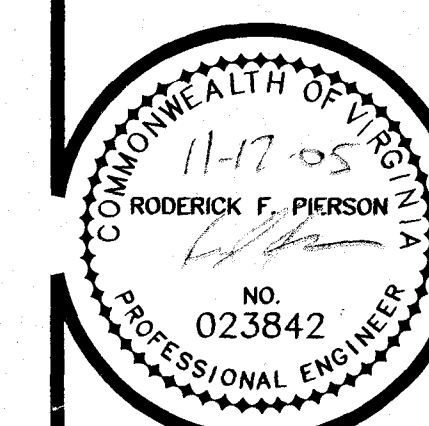


PIERSON
ENGINEERING
&
SURVEYING

P.O. BOX 311
1324 ROANOKE ROAD
DALEVILLE, VA 24083



(540) 966-3027 TEL
(540) 966-5906 FAX
e-mail: rplerson@rbnet.com

DEVELOPMENT PLANS FOR
LOT 13, SECTION II, ASHLEY PLANTATION
SHOWING A SANITARY SEWER RELOCATION
BOTETOURT COUNTY, VIRGINIA

PLAN AND
PRIOFILE

COMMISSION
R200548

SHEET
1

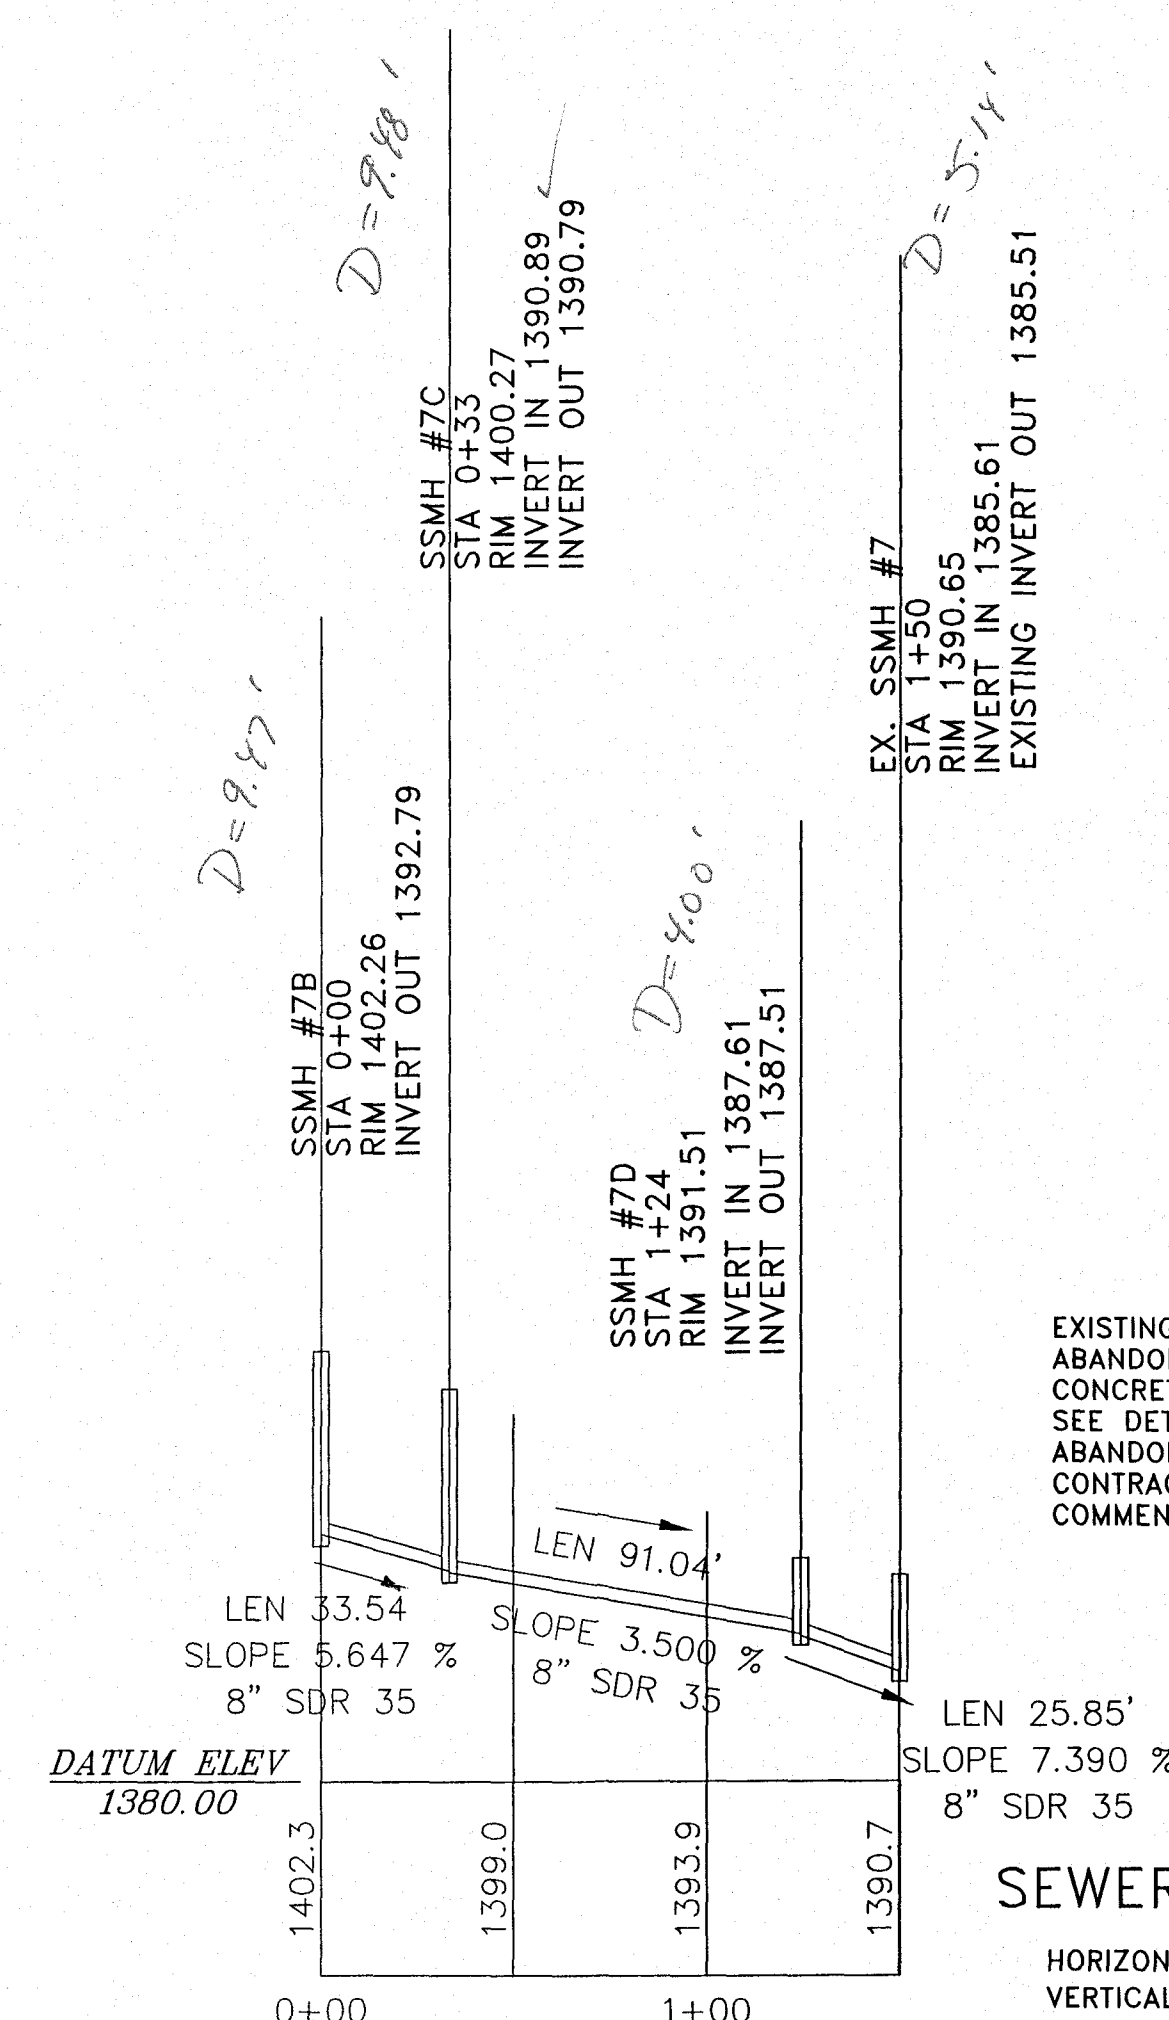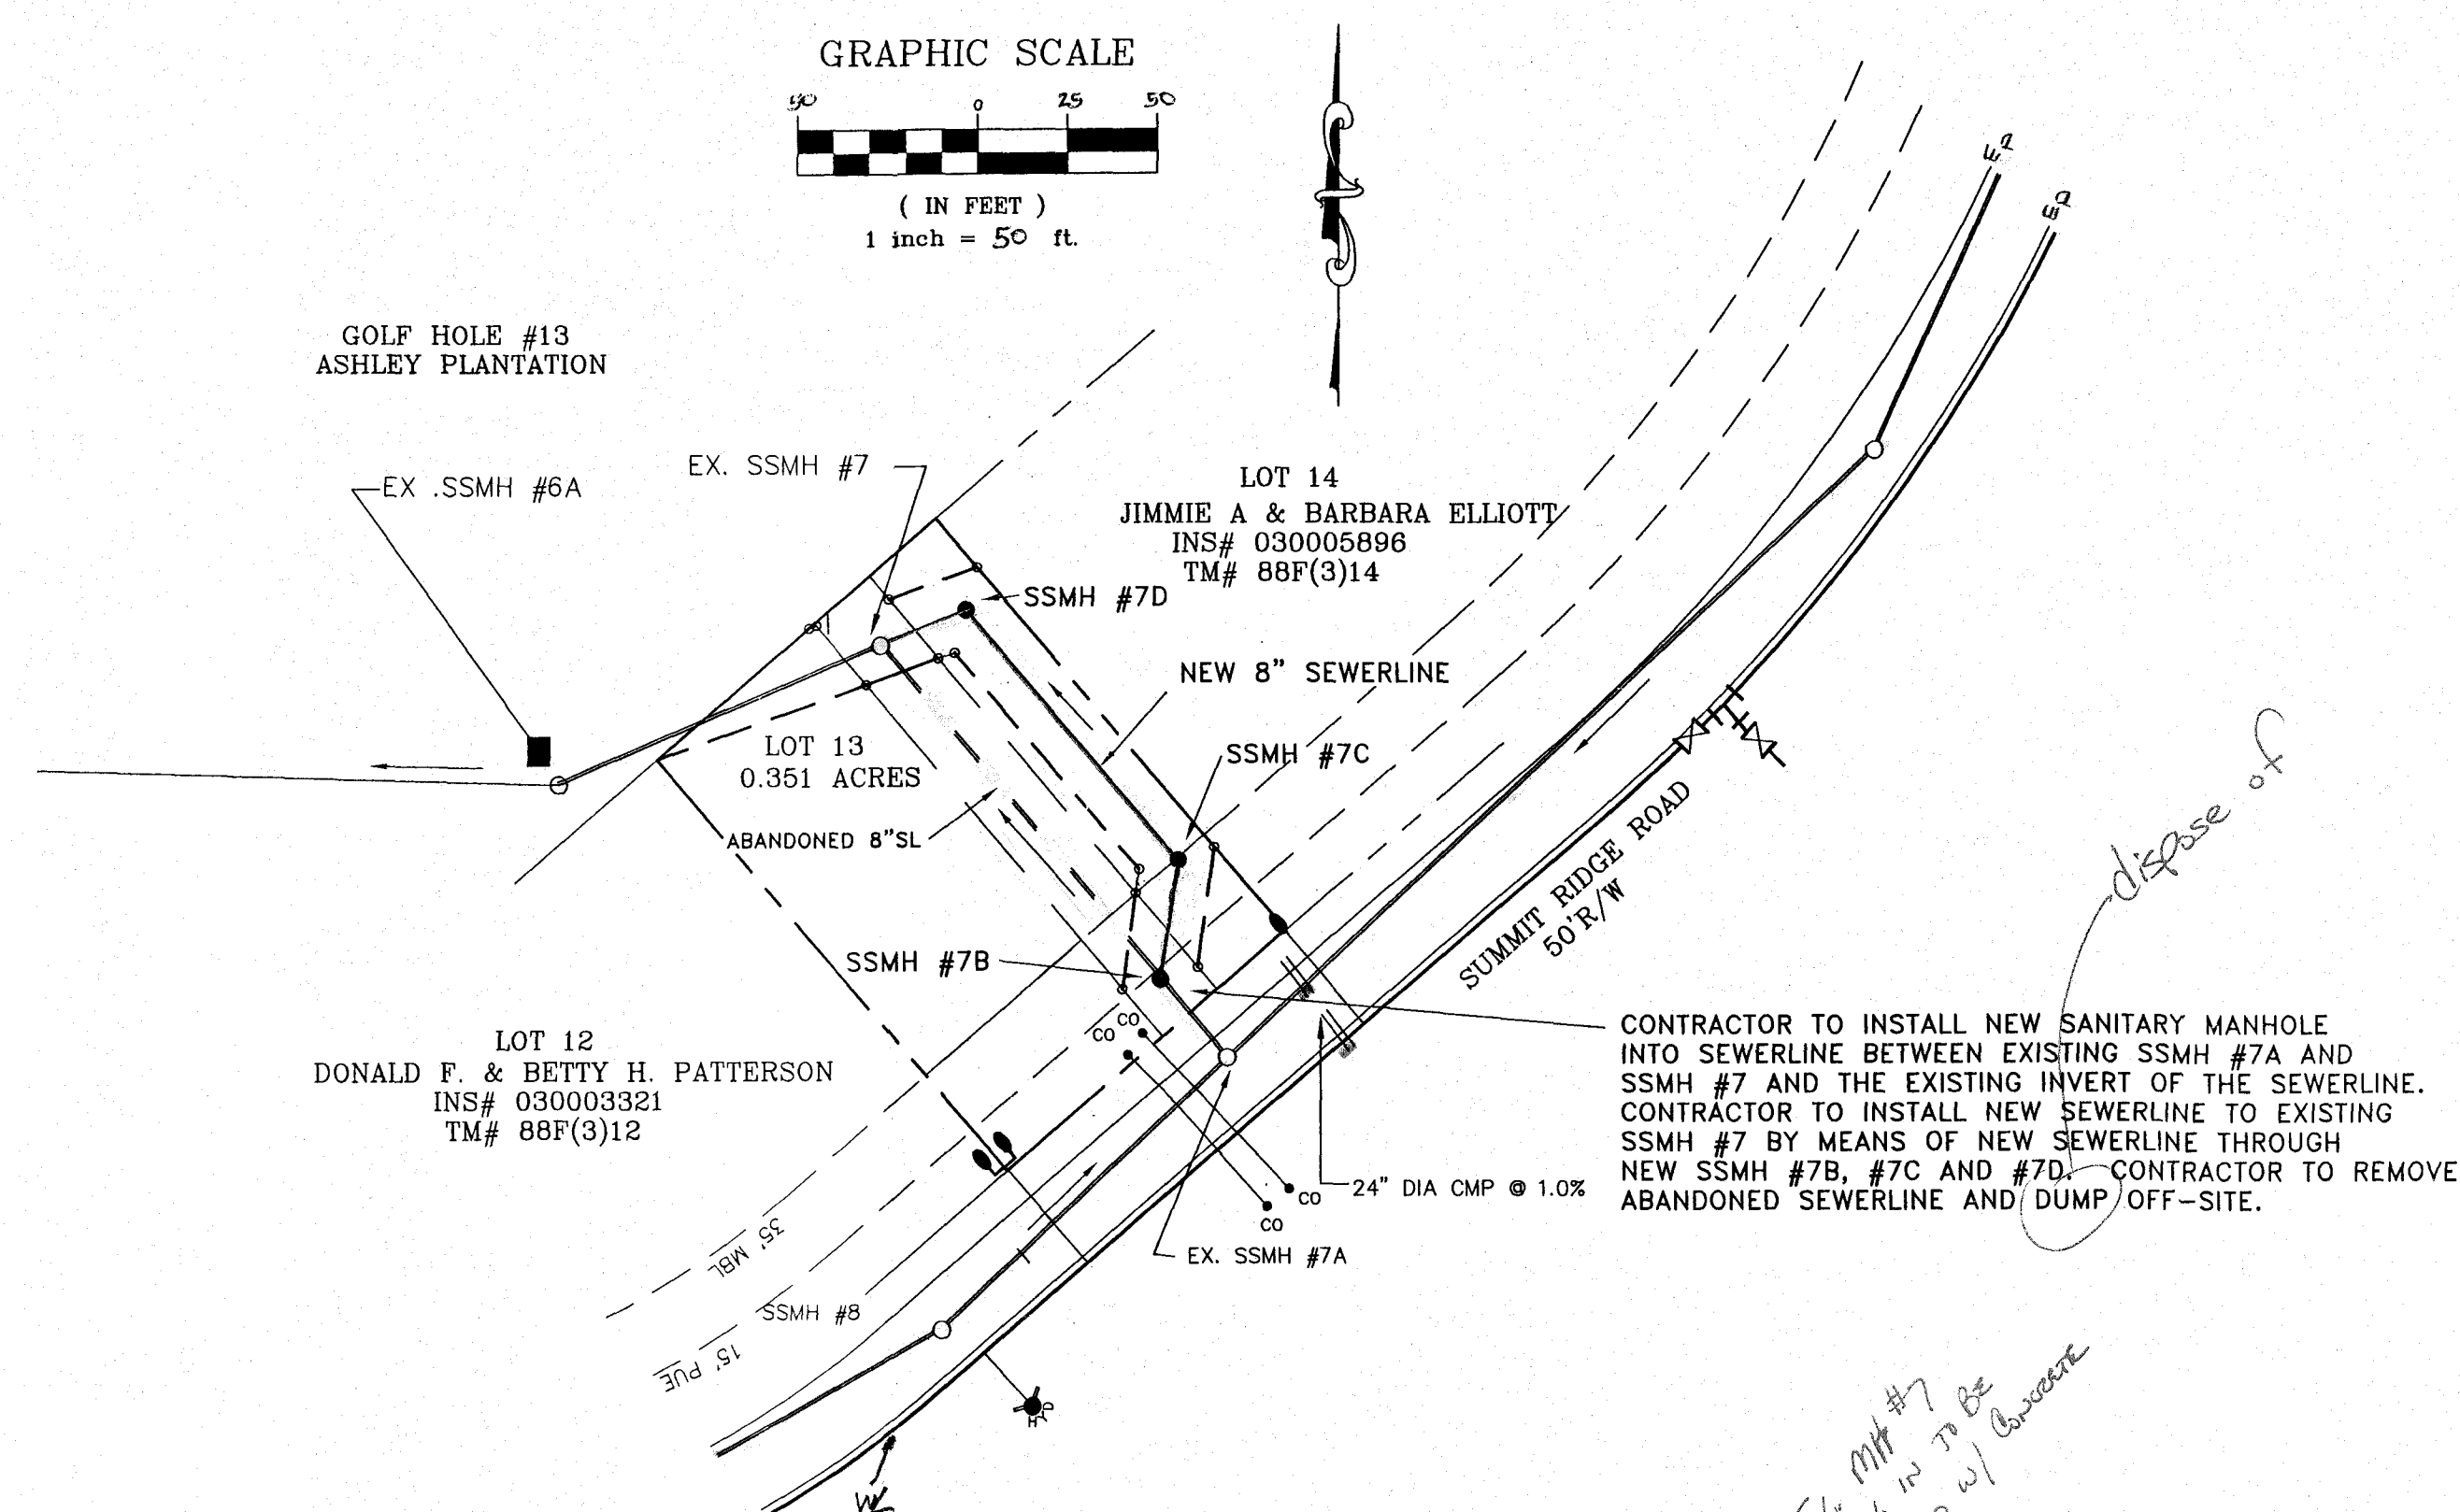

EXISTING SSMH #7 PREVIOUSLY HAD AN INVERT THAT IS BEING ABANDONED. CONTRACTOR SHALL PLUG ABANDONED INVERT WITH CONCRETE ON BOTH THE INSIDE AND OUTSIDE OF THE MANHOLE. SEE DETAIL ON SEWER DETAIL SHEET "SANITARY SEWER PIPE ABANDONMENT AT A MANHOLE. CONTRACTOR TO VERIFY INVERT ELEVATIONS PRIOR TO COMMENCING WORK.

Comments

1. All MH of Lives TO BE TESTED
2. Boys?
3. Stop Drugs
4. Prisoner
- 5.

