
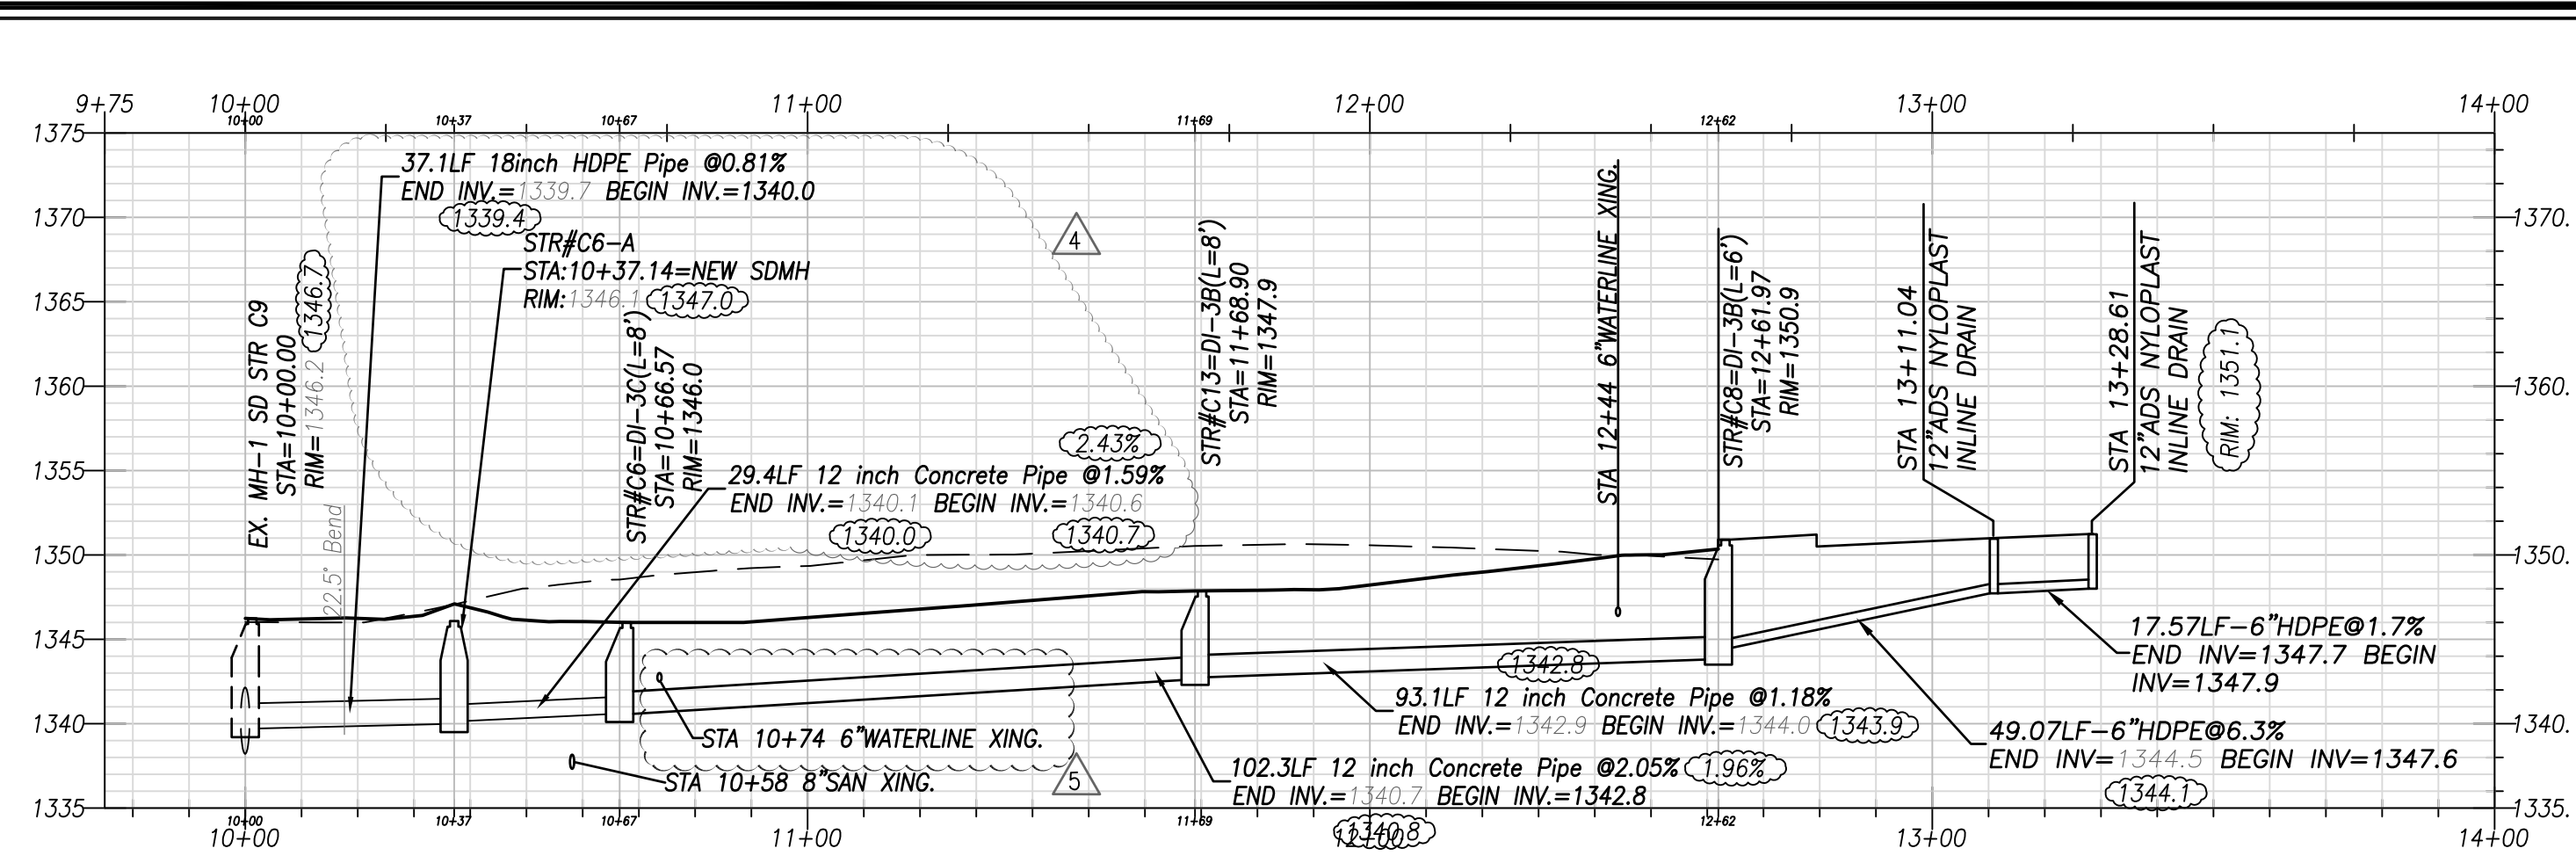
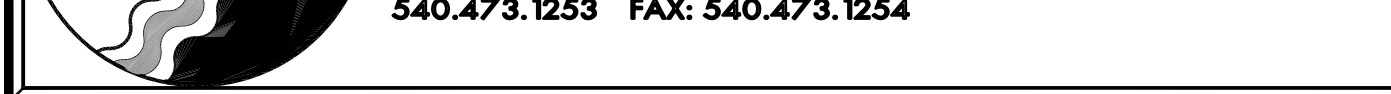
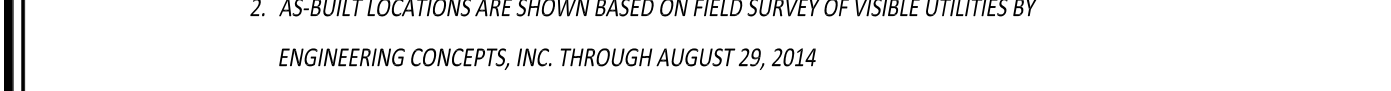
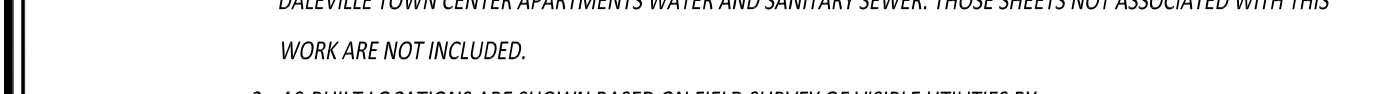
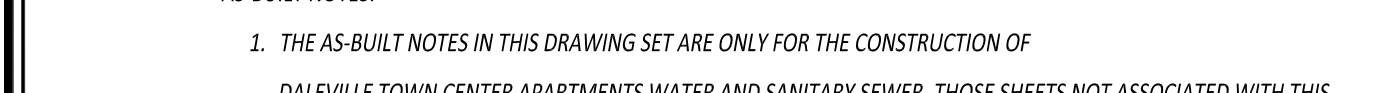
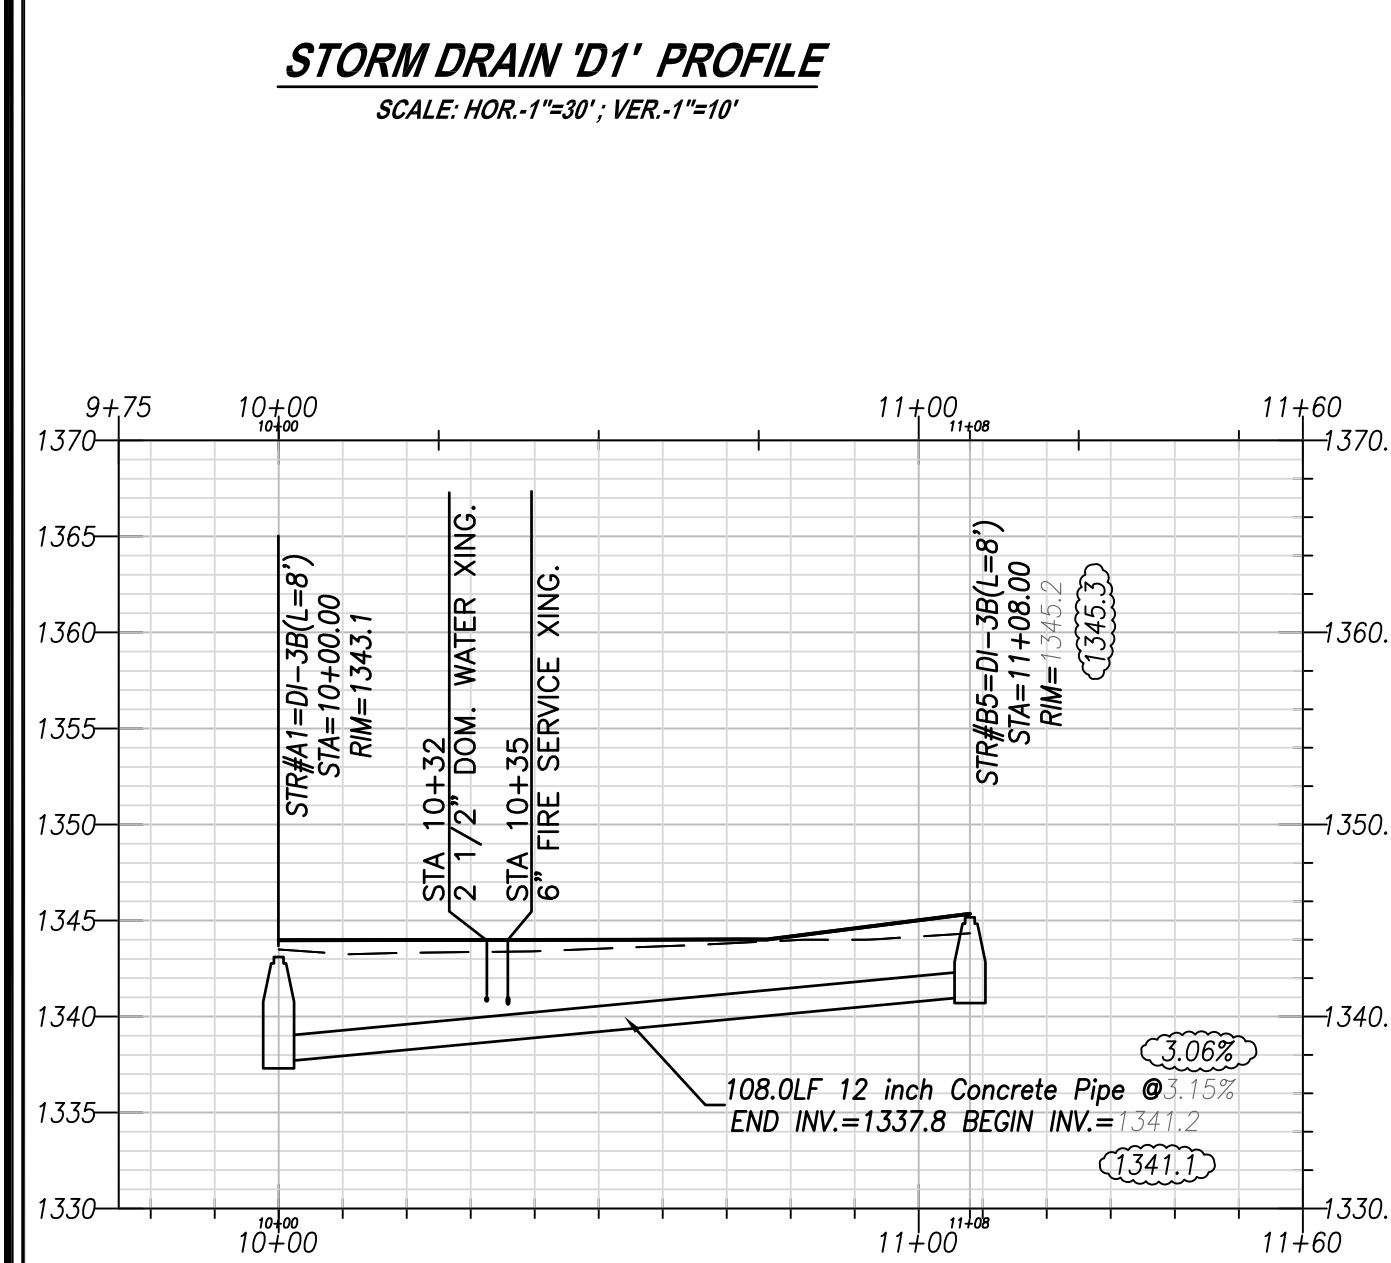
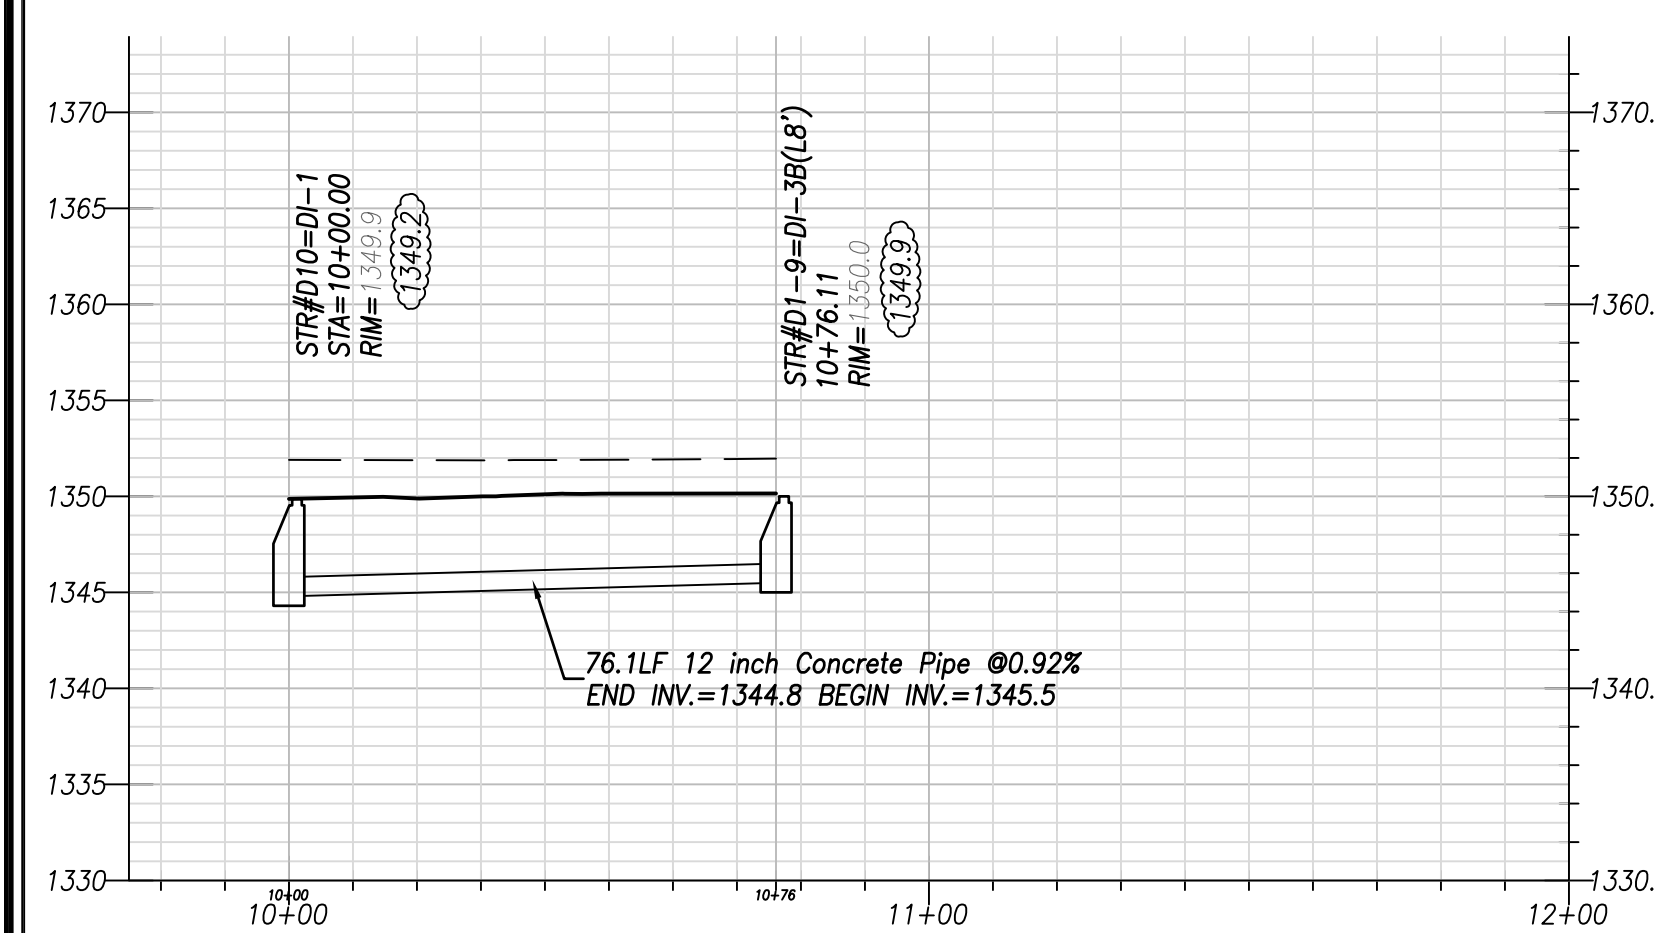
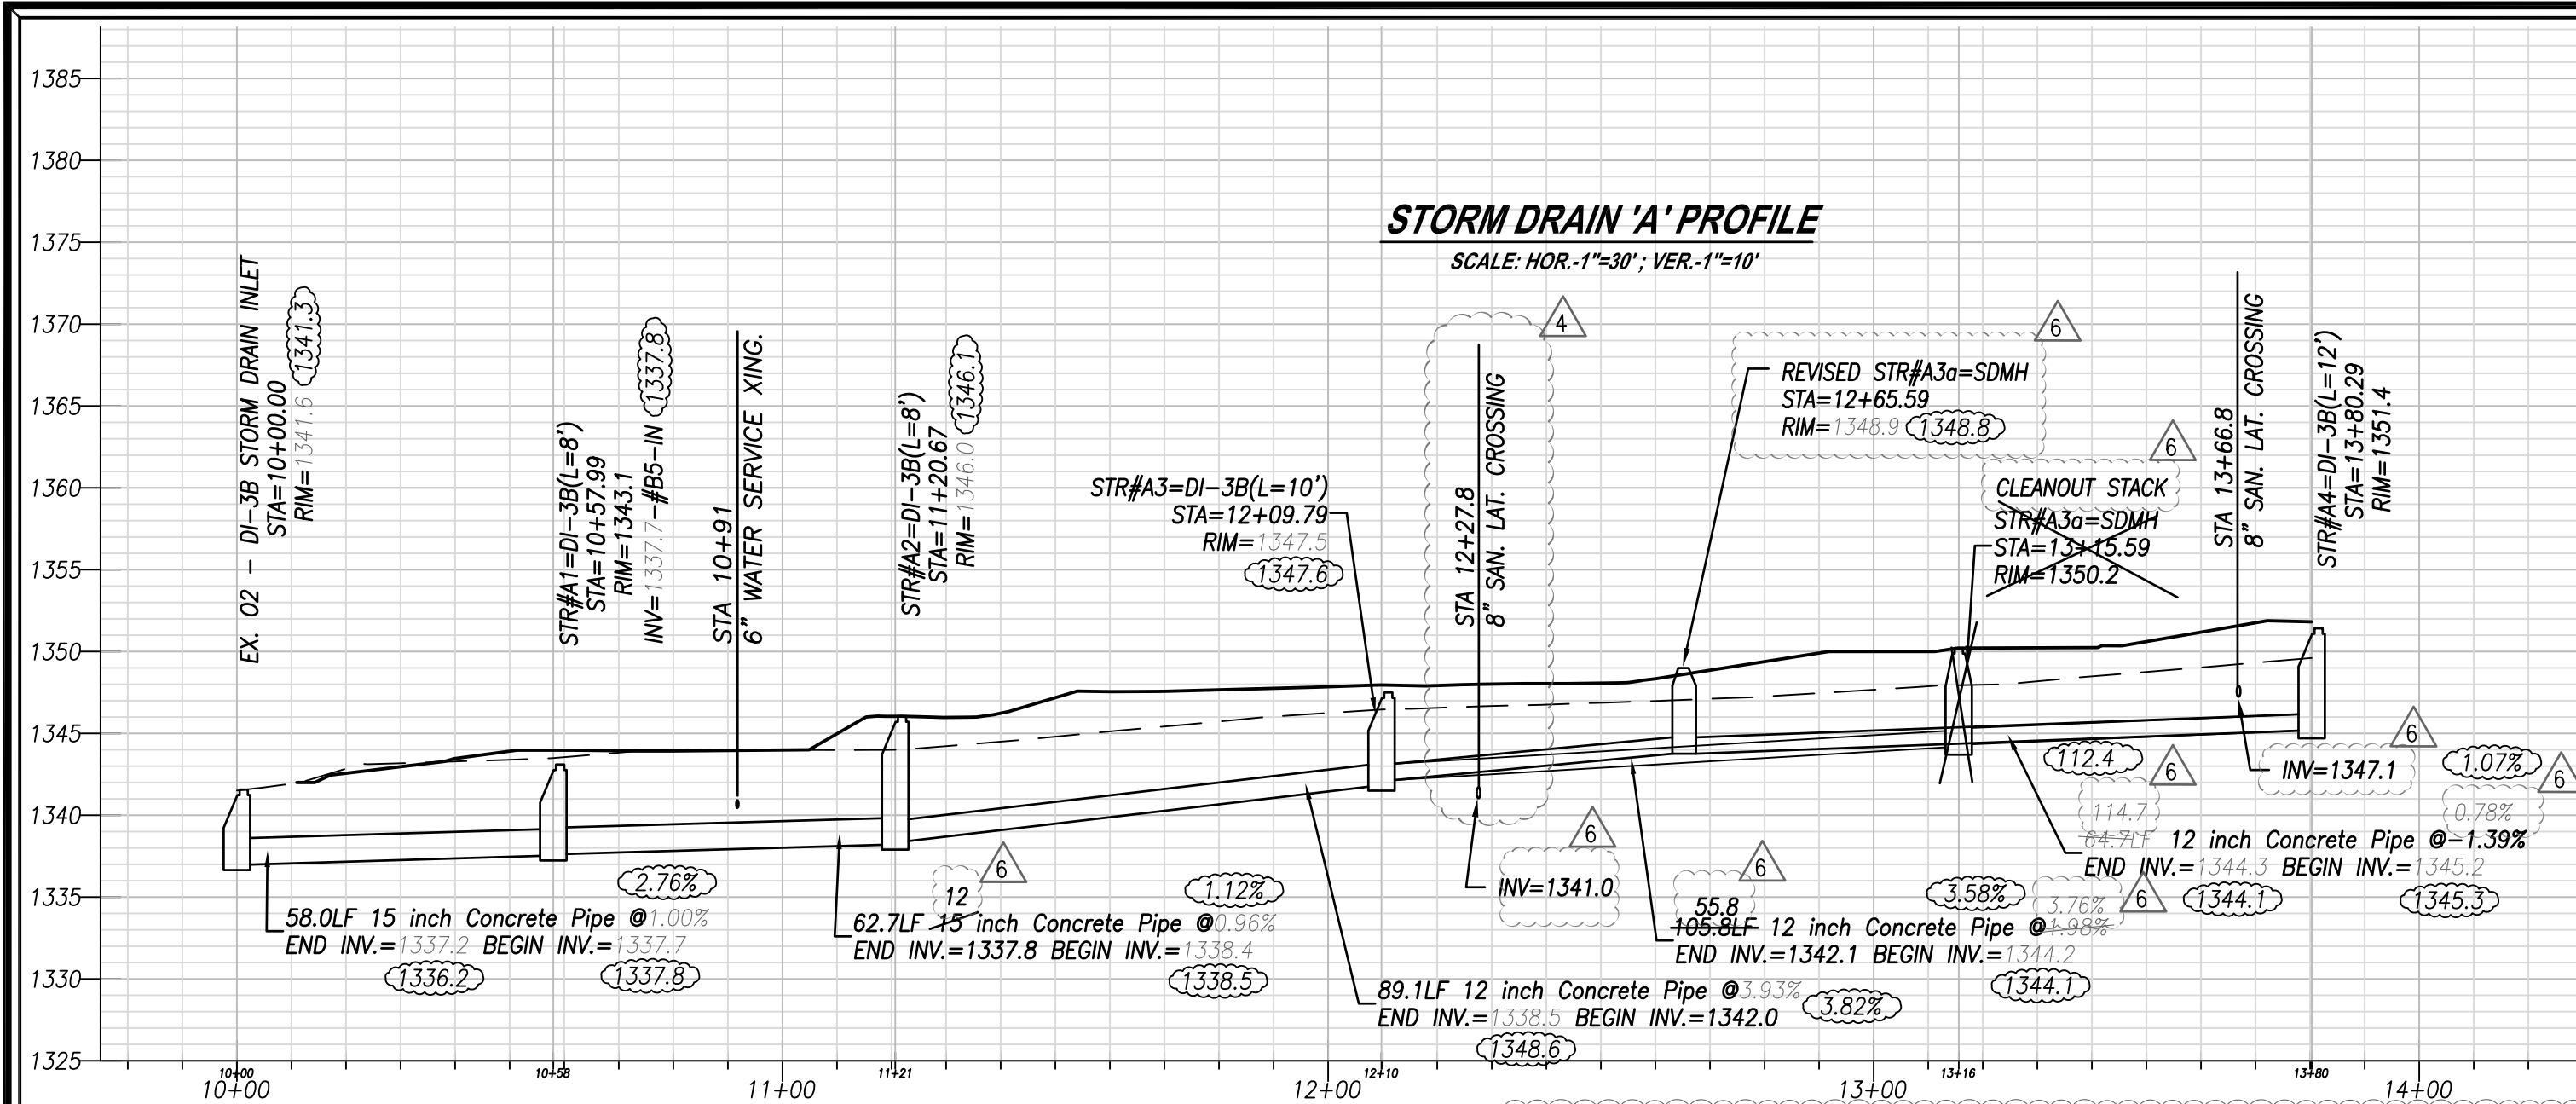


- AS-BUILT NOTES:
1. THE AS-BUILT NOTES IN THIS DRAWING SET ARE ONLY FOR THE CONSTRUCTION OF DALEVILLE TOWN CENTER APARTMENTS WATER AND SANITARY SEWER. THOSE SHEETS NOT ASSOCIATED WITH THIS WORK ARE NOT INCLUDED.
 2. AS-BUILT LOCATIONS ARE SHOWN BASED ON FIELD SURVEY OF VISIBLE UTILITIES BY ENGINEERING CONCEPTS, INC. THROUGH AUGUST 29, 2014

- NOTES:
1. ALL STORM DRAINS SHALL BE PLACED WITH A MINIMUM OF TWO (2) FEET COVER TO FINISHED GRADE.
 2. ALL SANITARY AND WATERLINES SHALL BE PLACED WITH A MINIMUM OF THREE (3) FEET COVER TO FINISHED GRADE.

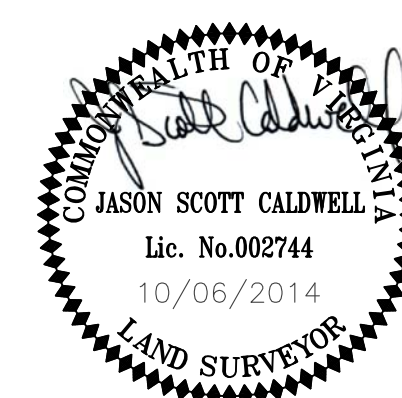

No.	Revision	By	Appd.	Date	Drawn
2	STORM REVISIONS (LINE 'D')	MSMj	RHW	12/31/12	MSMj
3	SAN. REVISION AT SS-1	MSMj	RHW	05/29/13	MSMj
4	STORM DRAIN C	RHW	RHW	7/24/13	RHW
5	BUILDING D4 WATER SERVICE	ECI	RHW	8/23/13	Approved
6	FIELD CONSTRUCTION CHANGES	ECI	RHW	10/25/13	RHW

UTILITY PROFILES		SCALE: AS SHOWN
DALEVILLE TOWN CENTER APARTMENTS		DATE: 10/25/13
DALEVILLE TOWN CENTER		PROJECT: 11029
BOTETOURT COUNTY - VIRGINIA		C10

ENGINEERING CONCEPTS, INC.
 20 S. ROANOKE ST., PO BOX 619
 FINCASTLE, VIRGINIA 24090
 540.473.1253 FAX: 540.473.1254

"Storm and Sewer As-Built"