




NOTE:
INVERTS OR RIMS OF CLEANOUTS NOT AS-BUILT

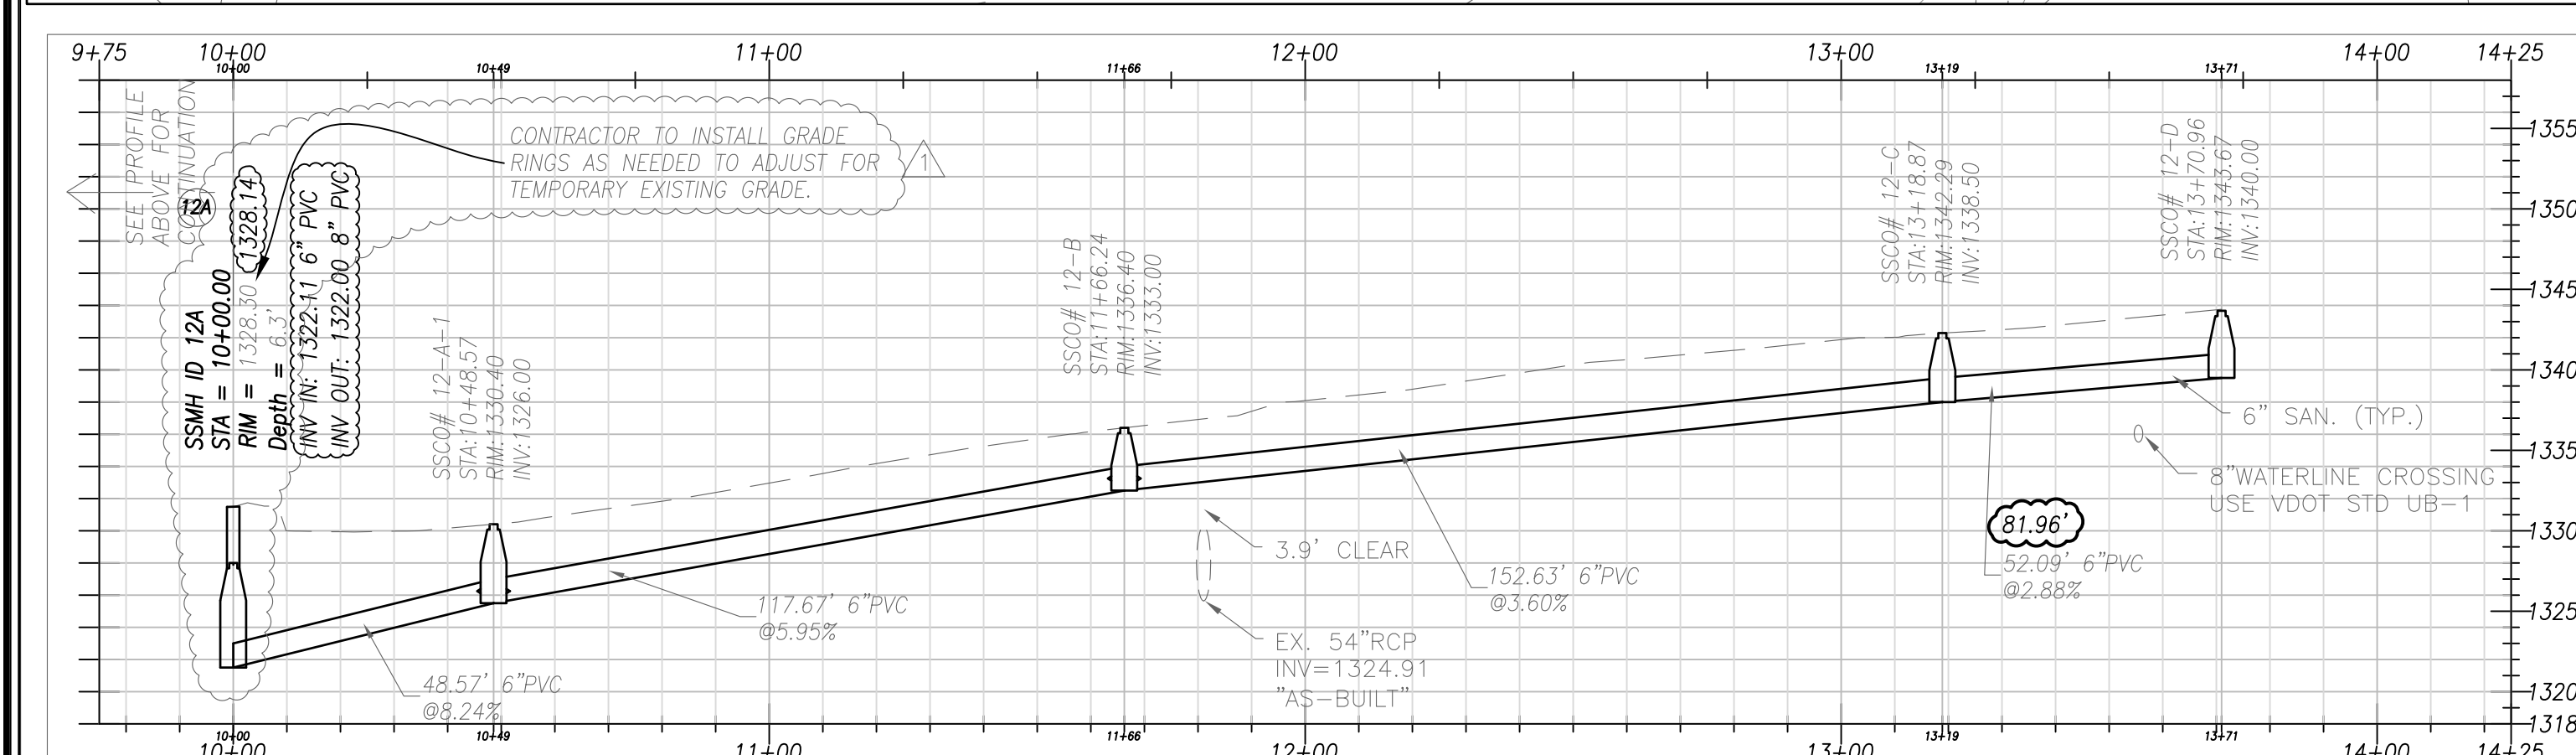

No.	Revision	By	Appd.	Date	Drawn	MSMj	OFFSITE SANITARY SEWER PROFILES DALEVILLE TOWN CENTER APARTMENTS	SCALE: 1"=30'
	SSMH REVISION	ECI	RHW	2/29/13	Designed	MSMj		DATE: SEP. 6, 201
					Checked	RHW	DALEVILLE TOWN CENTER BOTETOURT COUNTY – VIRGINIA	PROJECT: 11029
					Approved	RHW		C5