


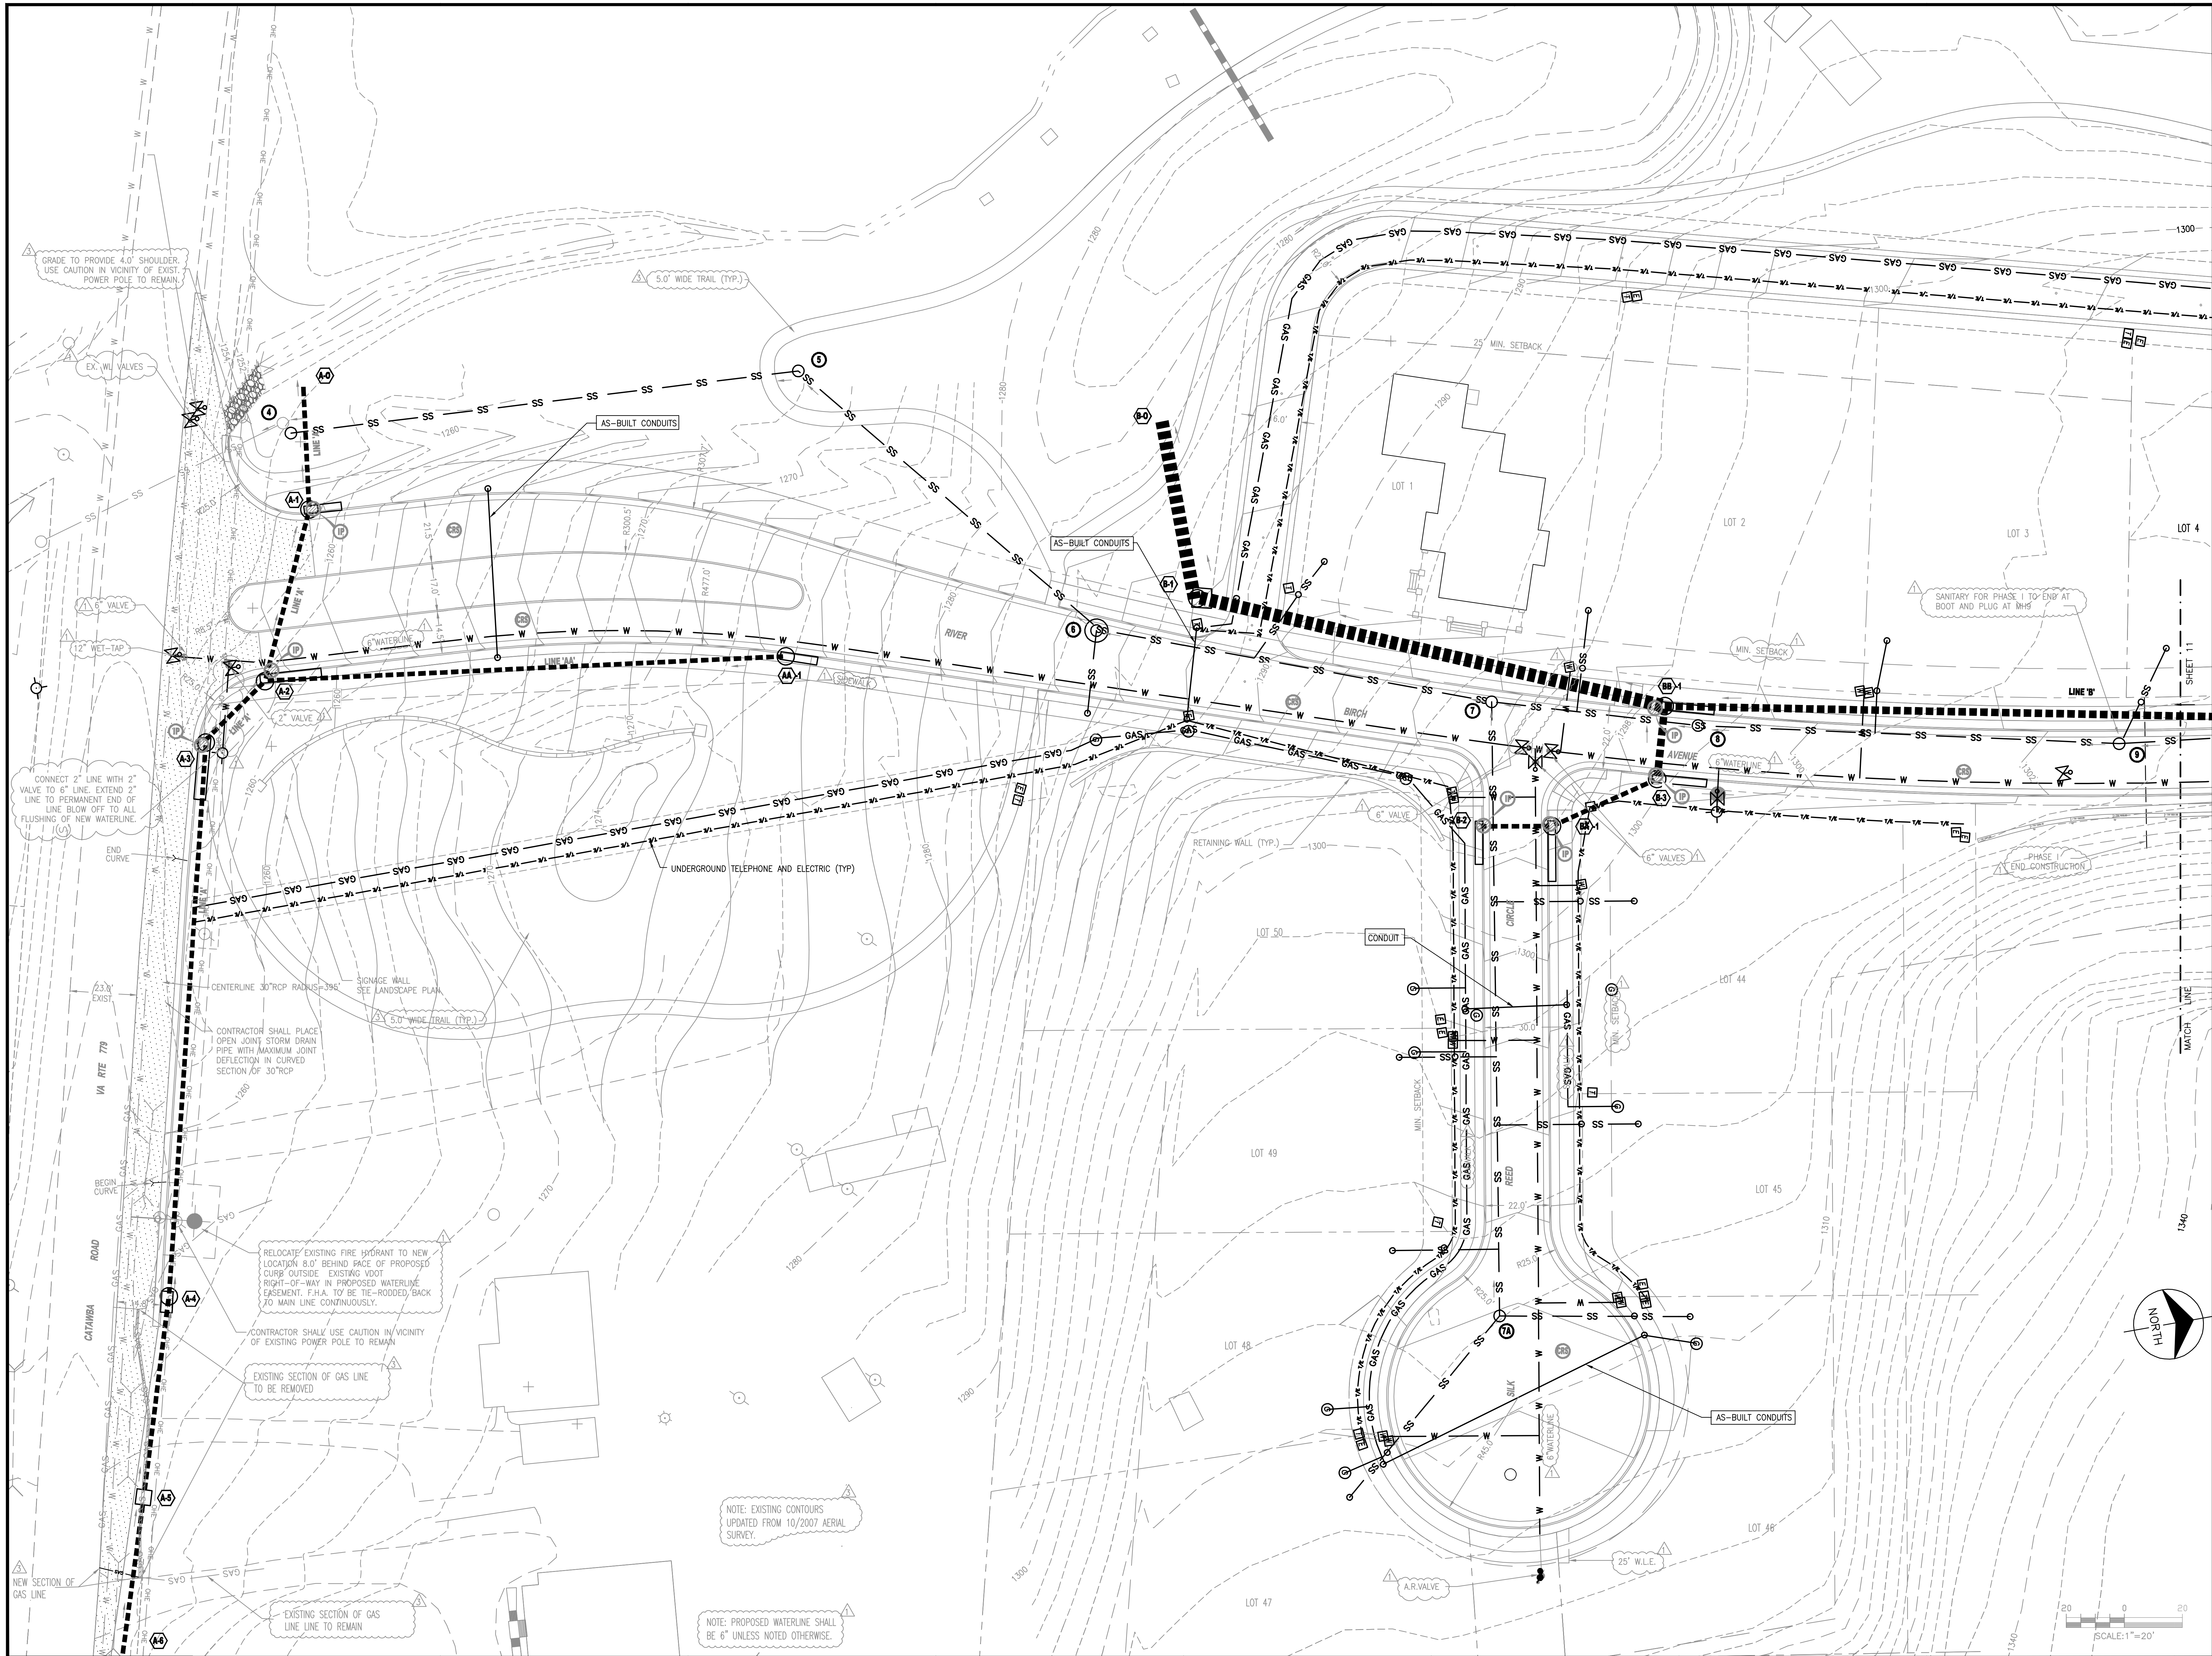

VARIOUS DEVELOPMENT REVISIONS
VARIOUS COUNTY REVIEW COMMENTS

MSMJ
BY

07/08/08
DATE

MARK
REVISIONS

DATE 5/8/08
PROJECT 03083
DESIGNED RHW
DRAWN MSMJ
CHECKED RHW

ENGINEERING
CONCEPTS, INC.
"Creating Success"
20 S. Riverside Street, PO Box 616
Fayetteville, Virginia 22801
540.473.1233 fax 540.473.1234

PROJECT FRALIN AND WALDRON
DALEVILLE TOWN CENTER

DRAWING COMPREHENSIVE DEVELOPMENT PLAN

SHEET
C-10