
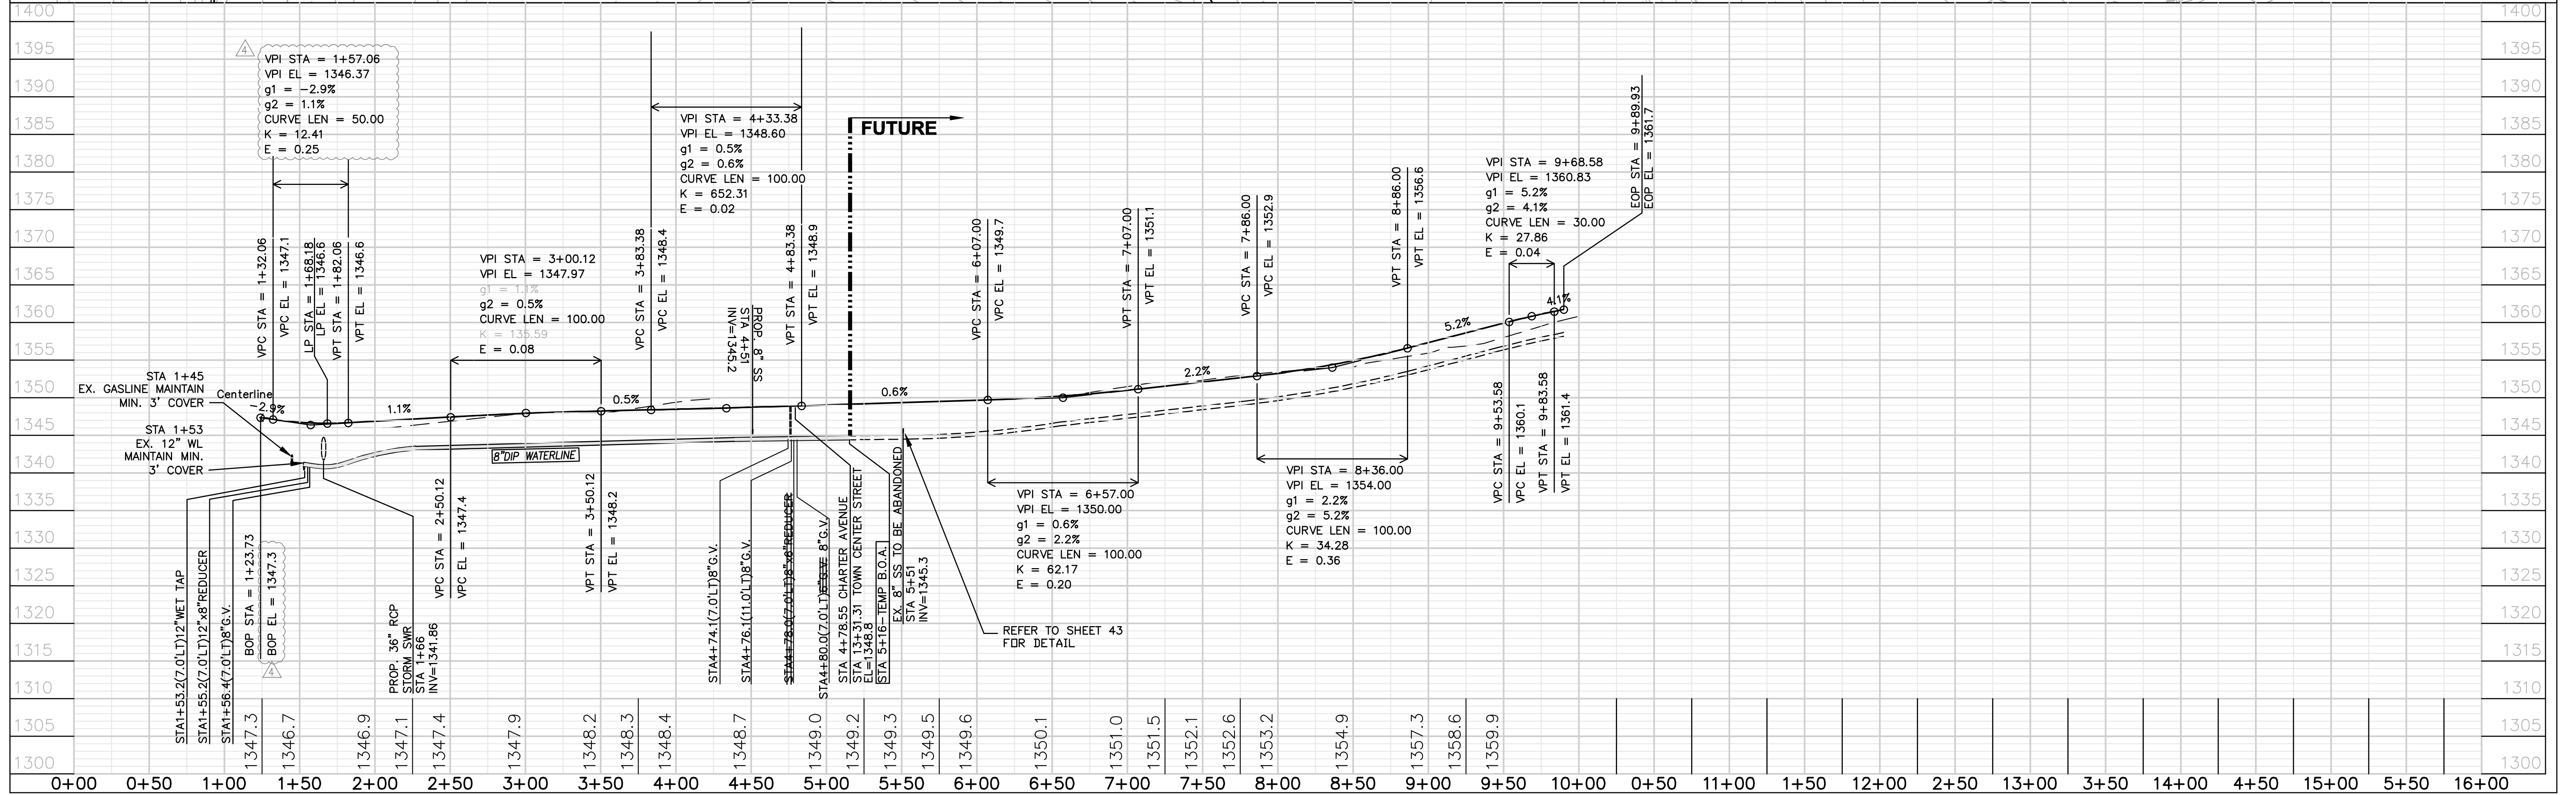


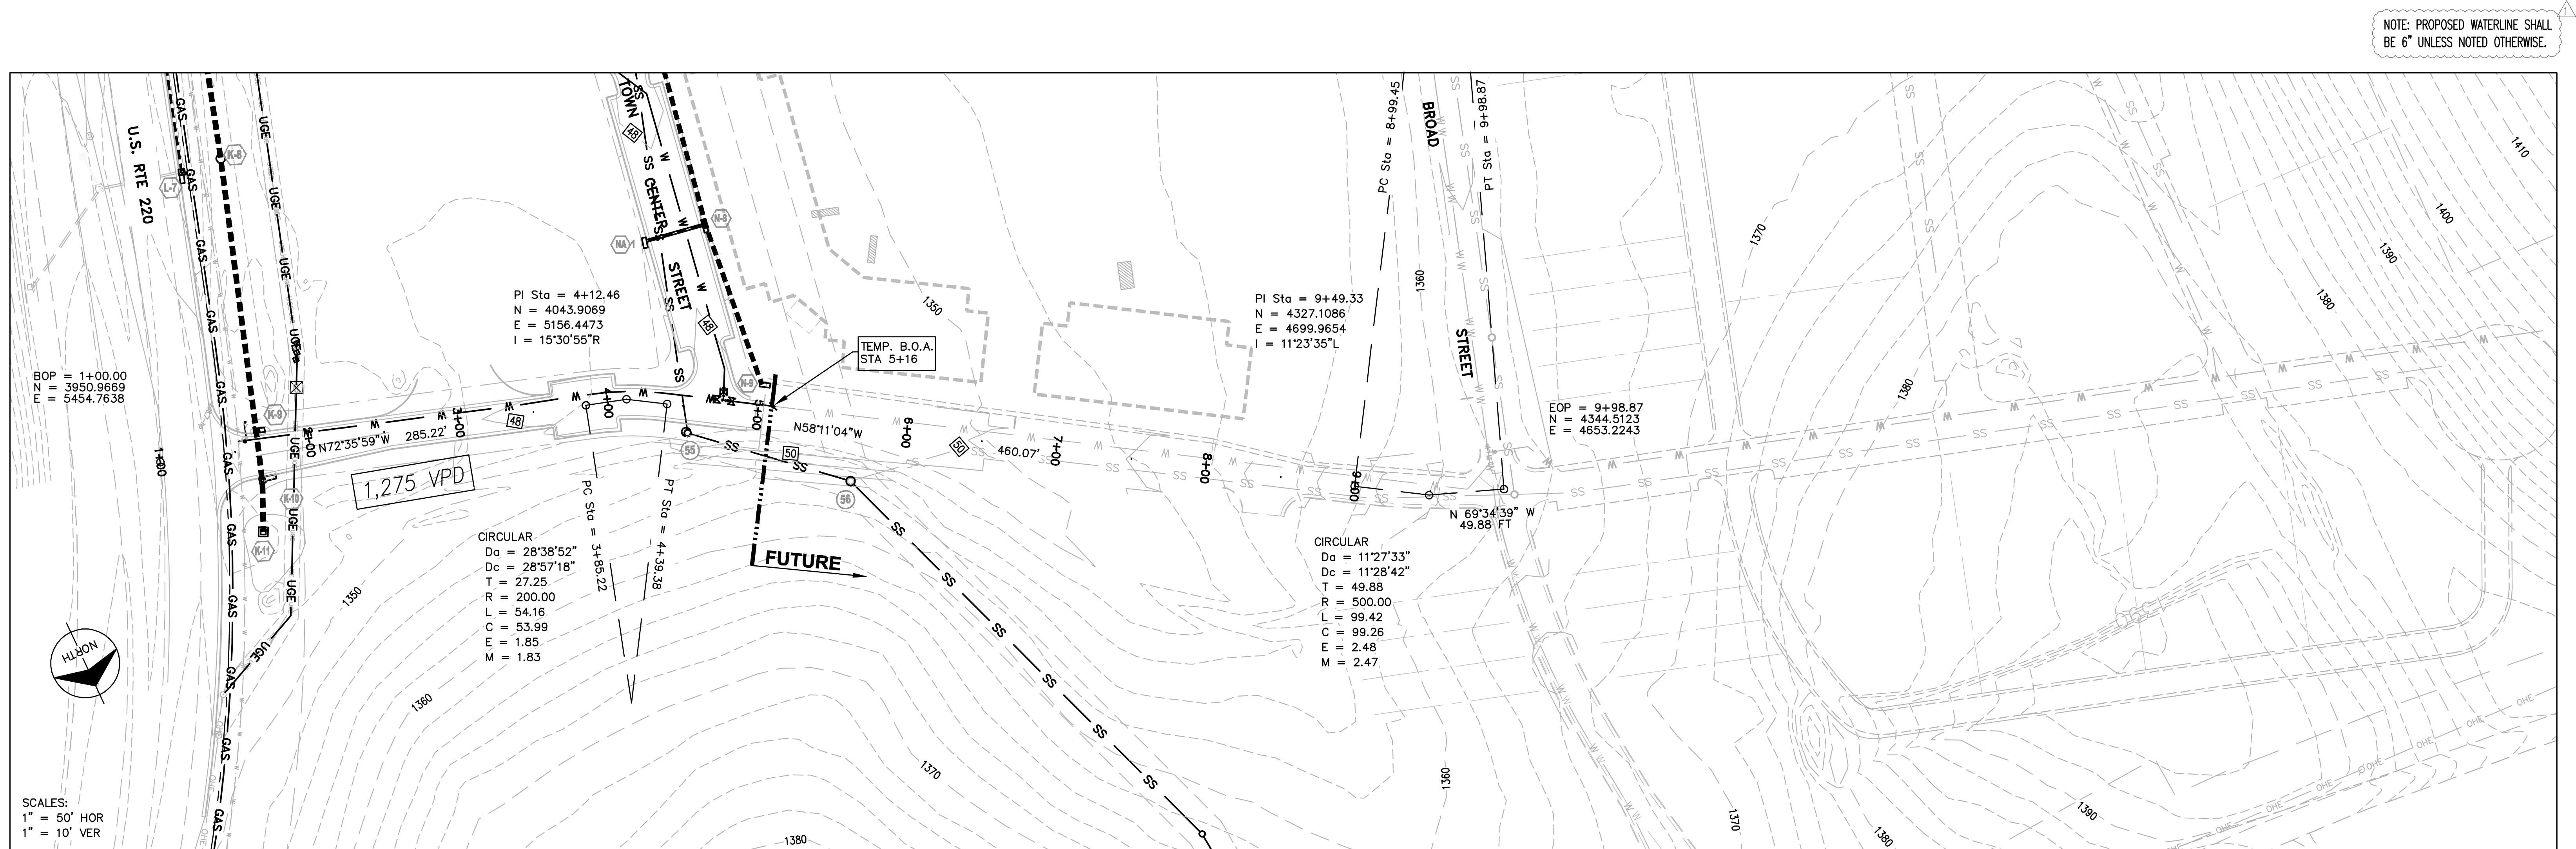

ENGINEERING
CONCEPTS, INC.
"Creating Success"
28 S Roanoke Street, PO Box 619
540-473-1253 fax 540-473-1254

PROJECT
FRANK AND WALDRON
DALEVILLE TOWN CENTER

DRAWING
CHARTER AVENUE PLAN / PROFILE

DATE
5/8/08

PROJECT
03083

DESIGNED
RHW

DRAWN
MSMJ

CHECKED
RHW

DATE
8/29/08

MARK
DATE

BY
MSMJ

REVISIONS

DESCRIPTION

VARIOUS DESIGN DEVELOPMENT REVISIONS

VARIOUS COUNTY REVIEW COMMENTS

AS-BUILT

C-27

SHEET