
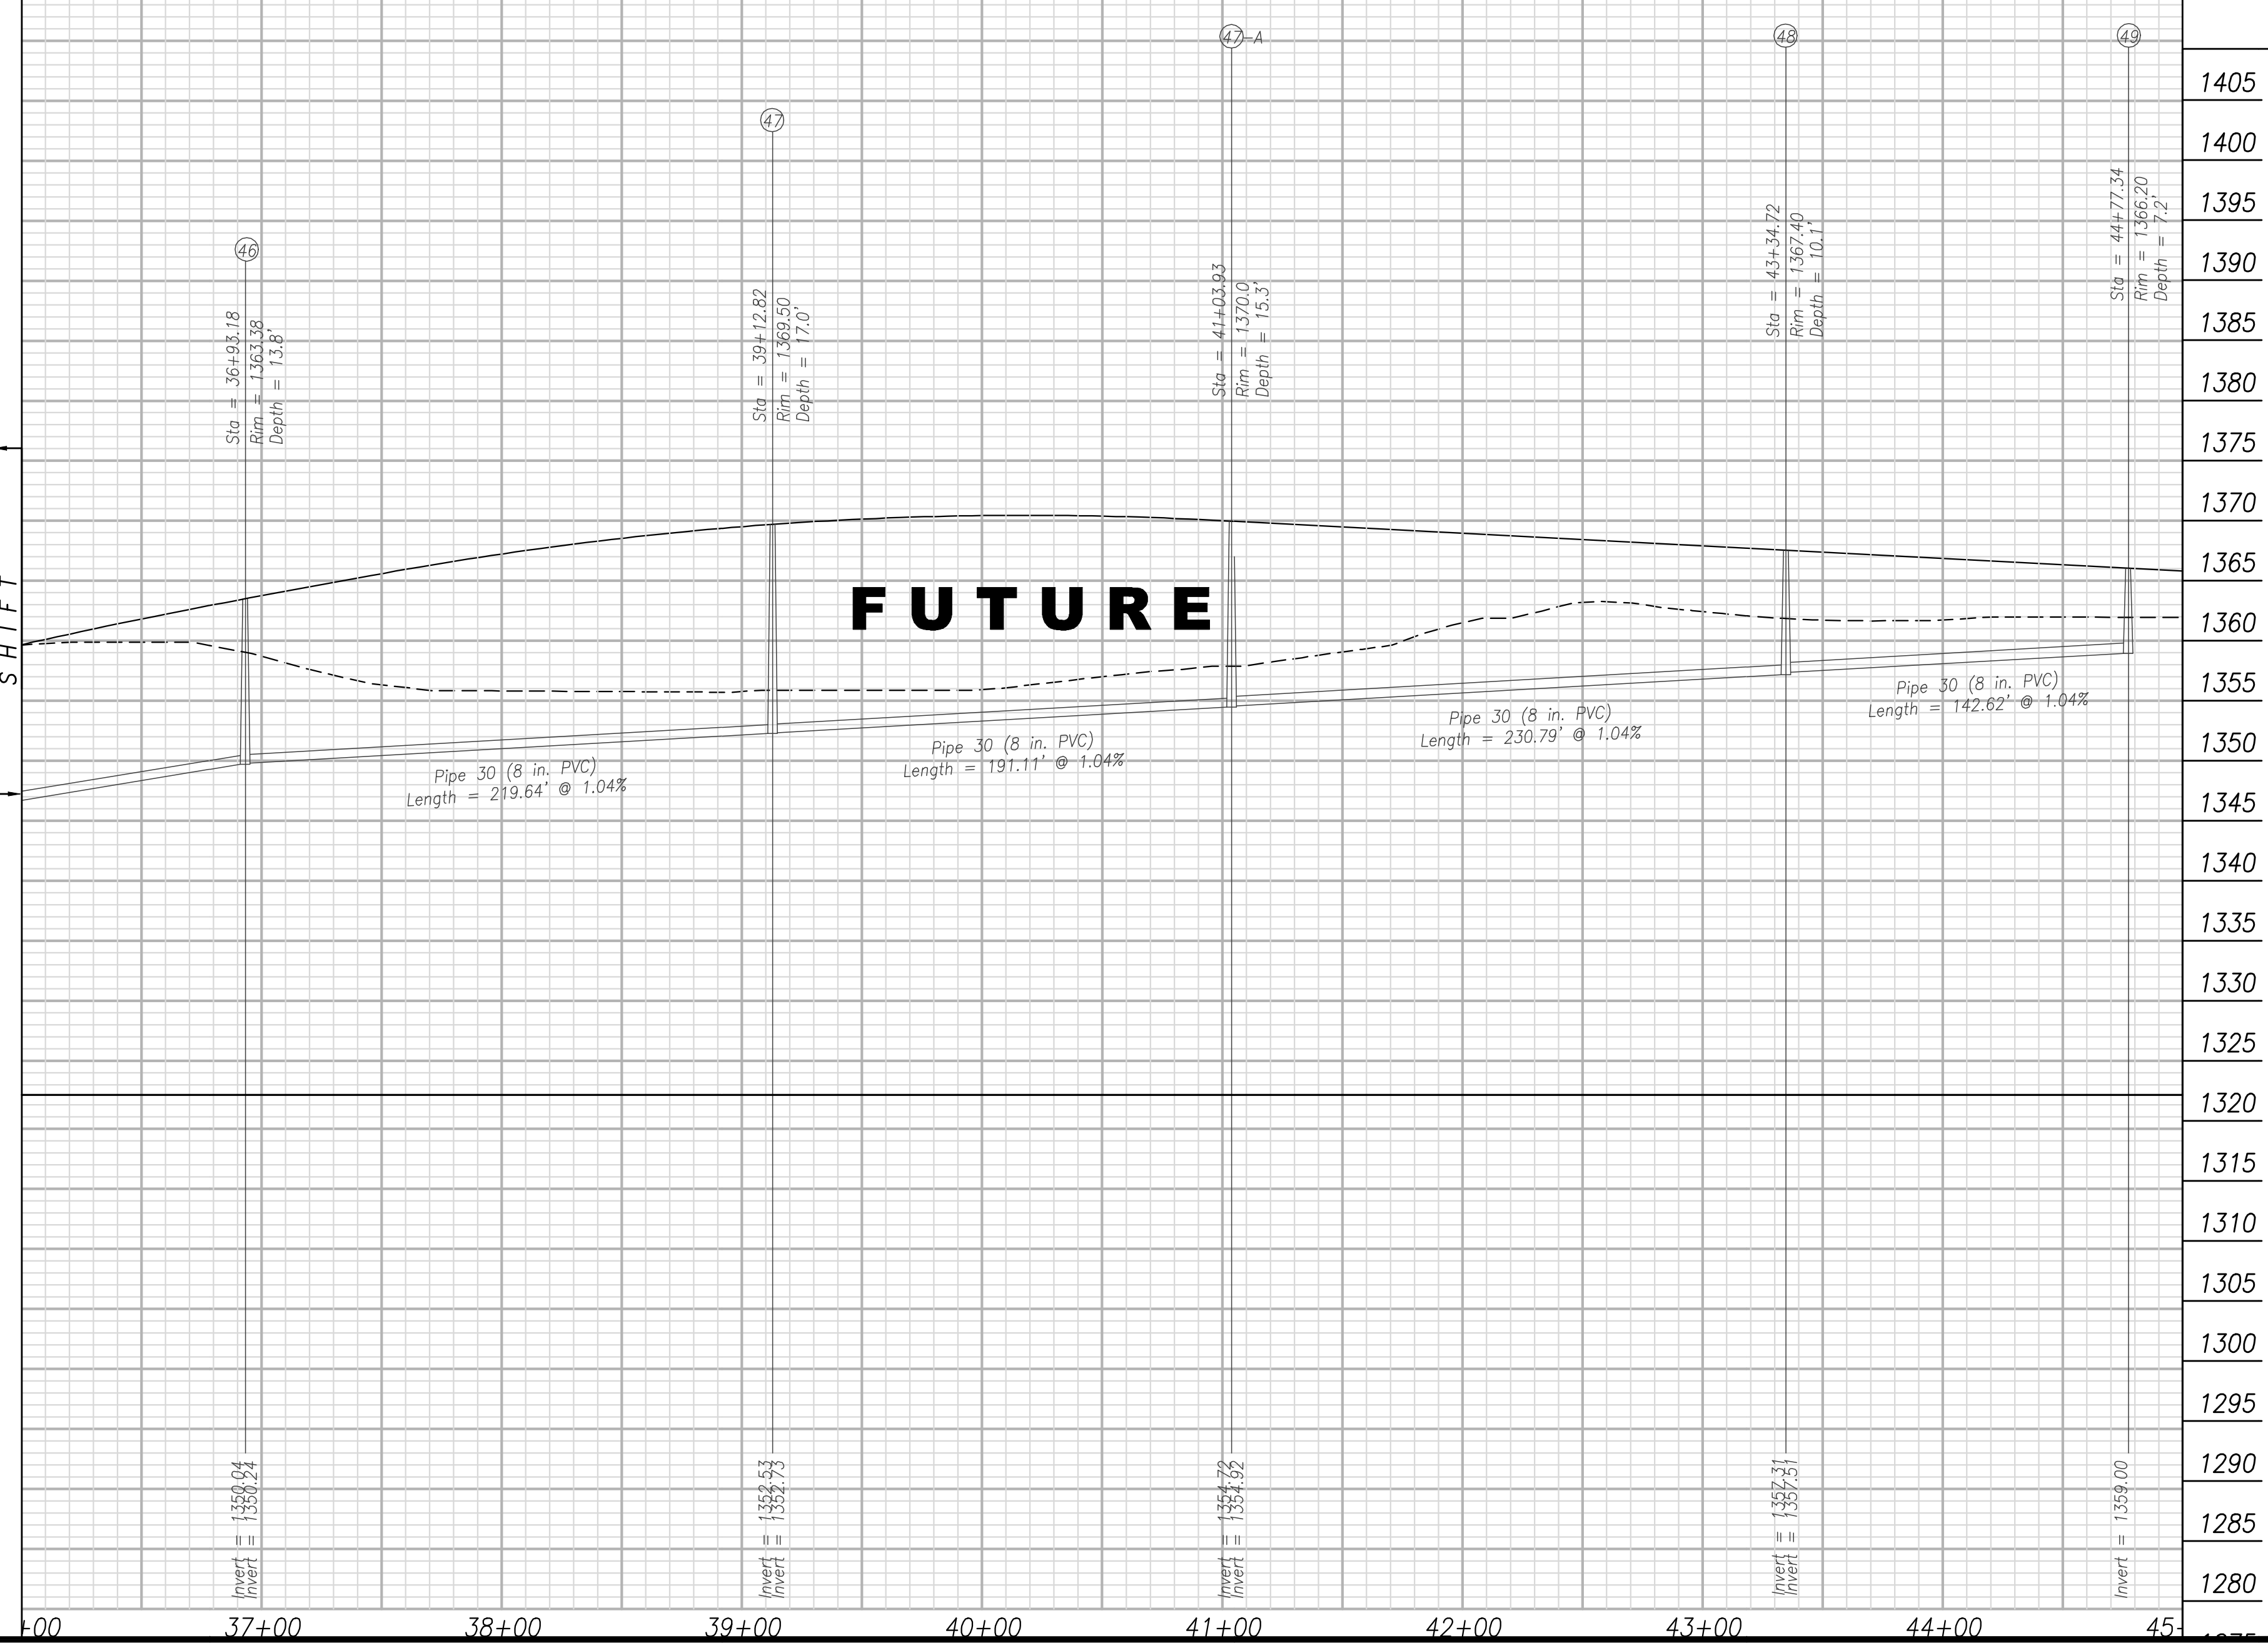
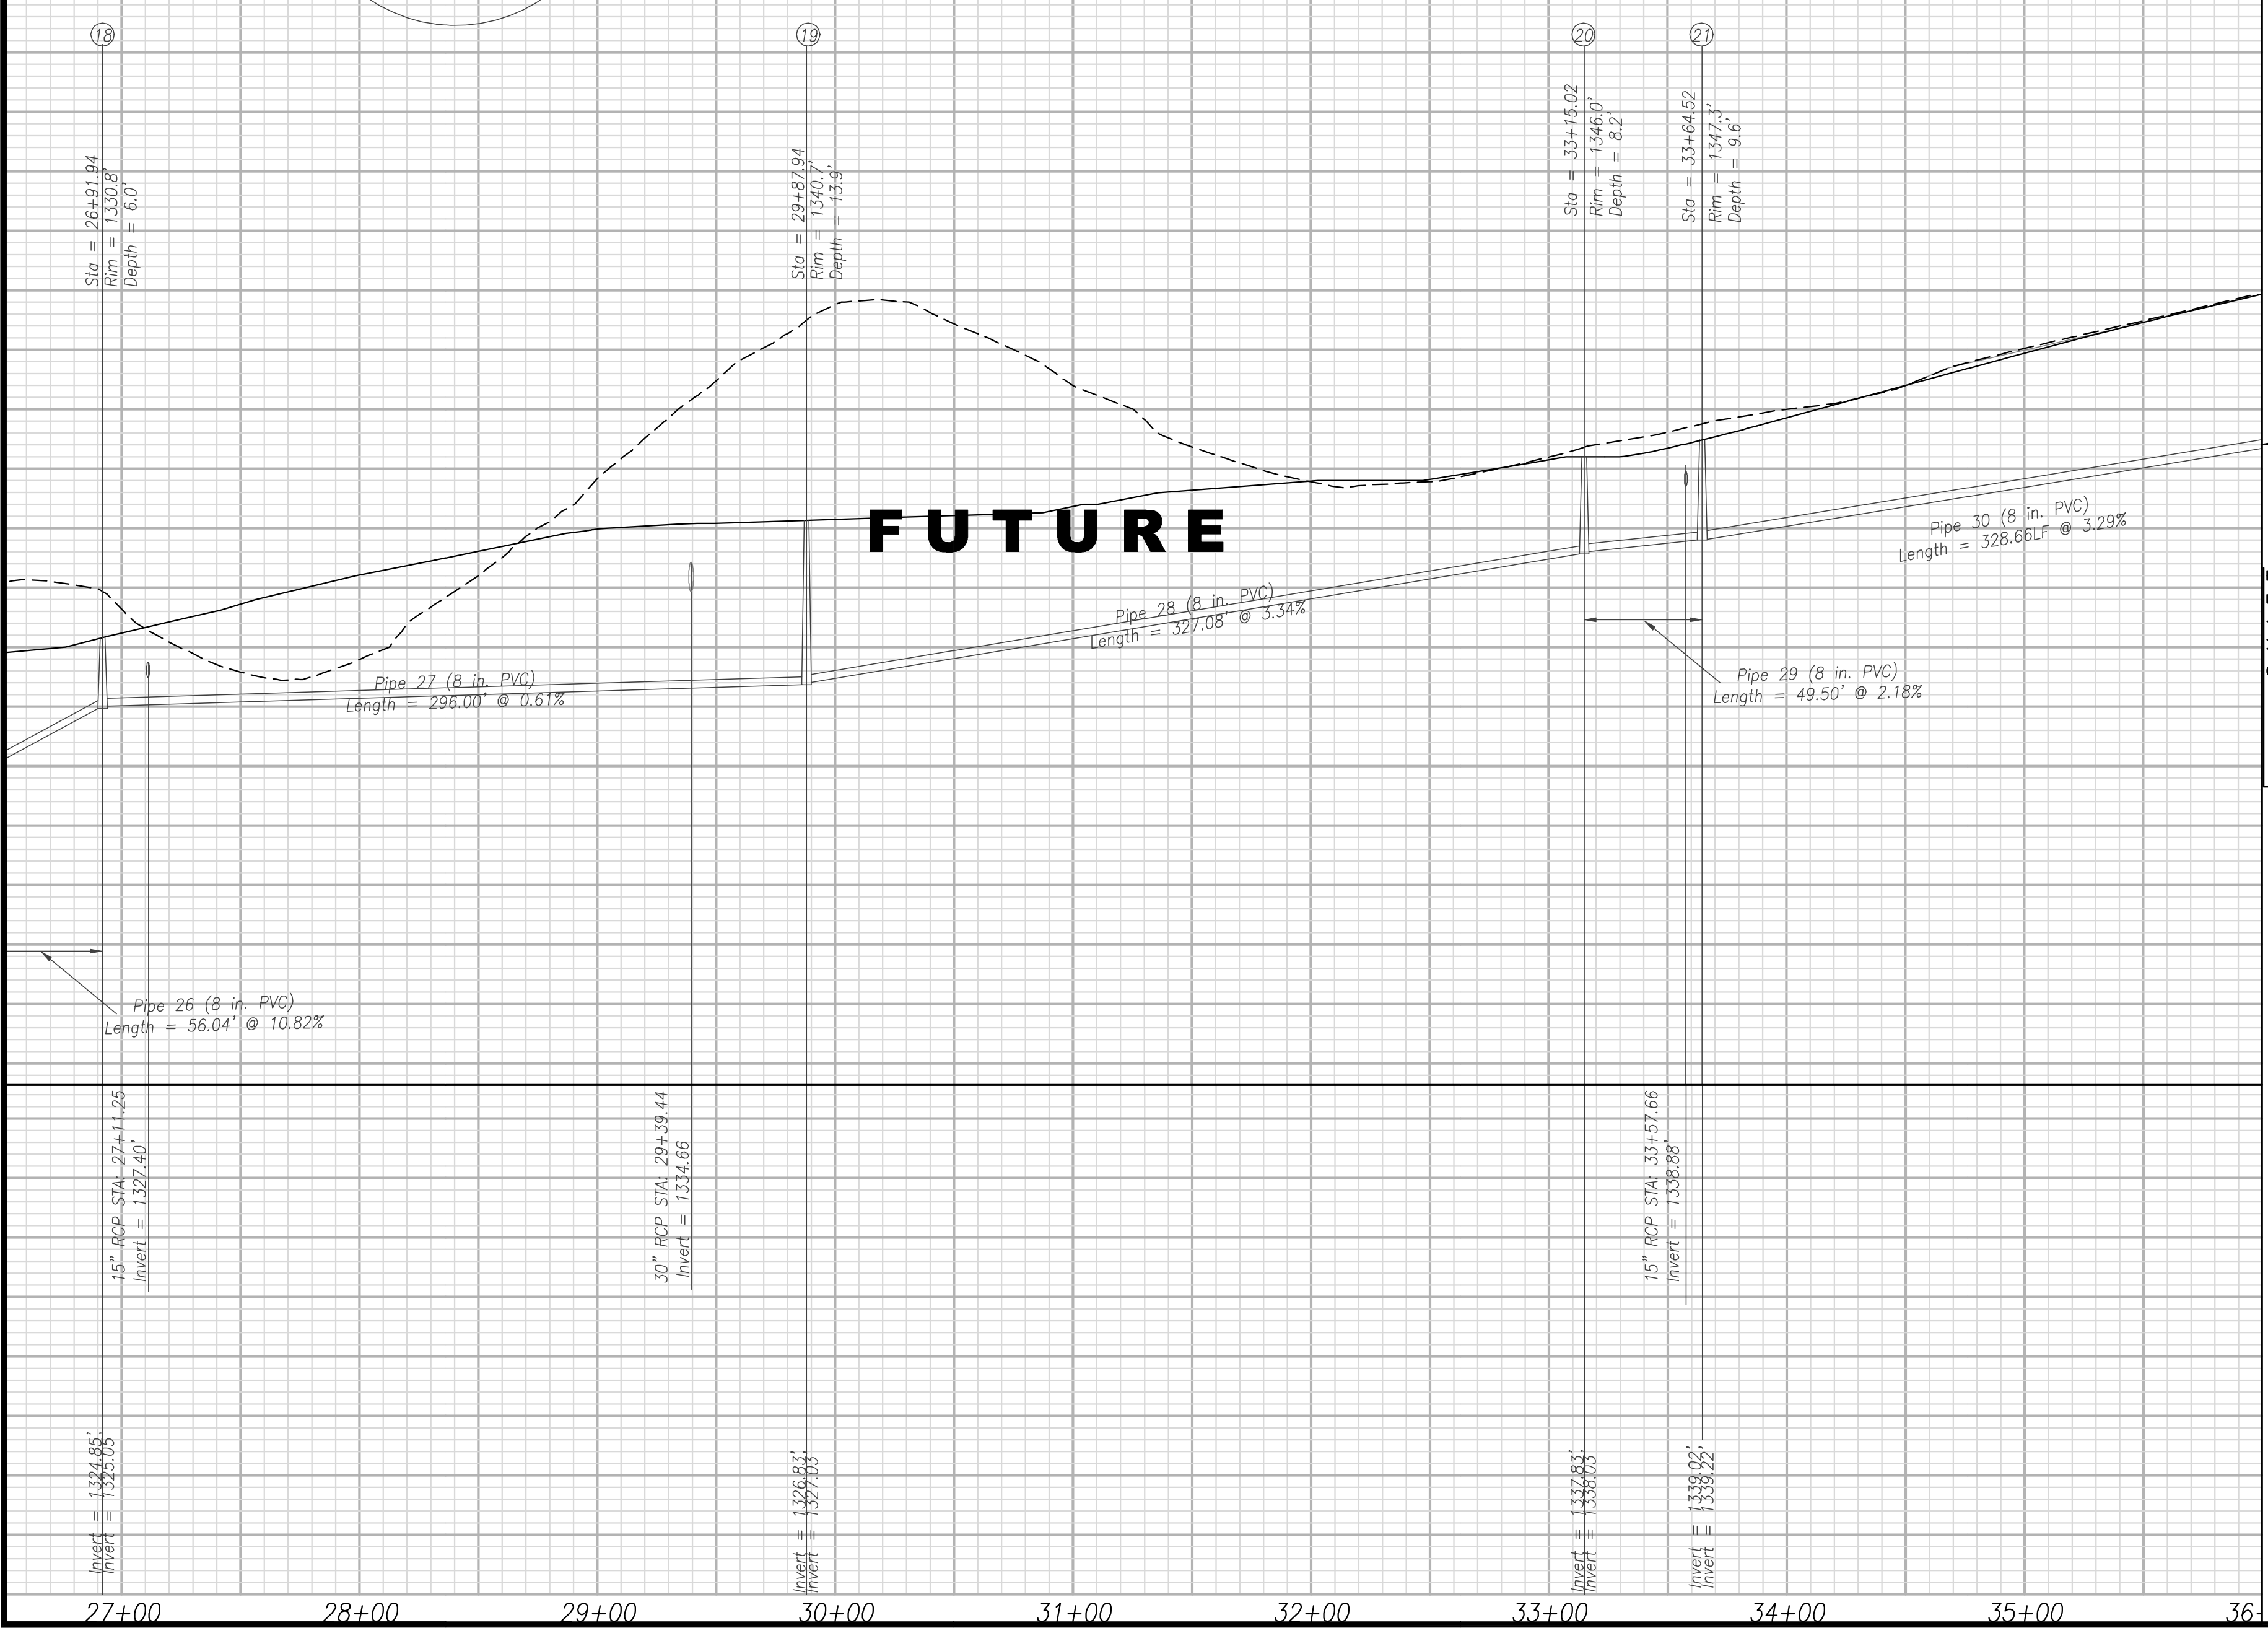


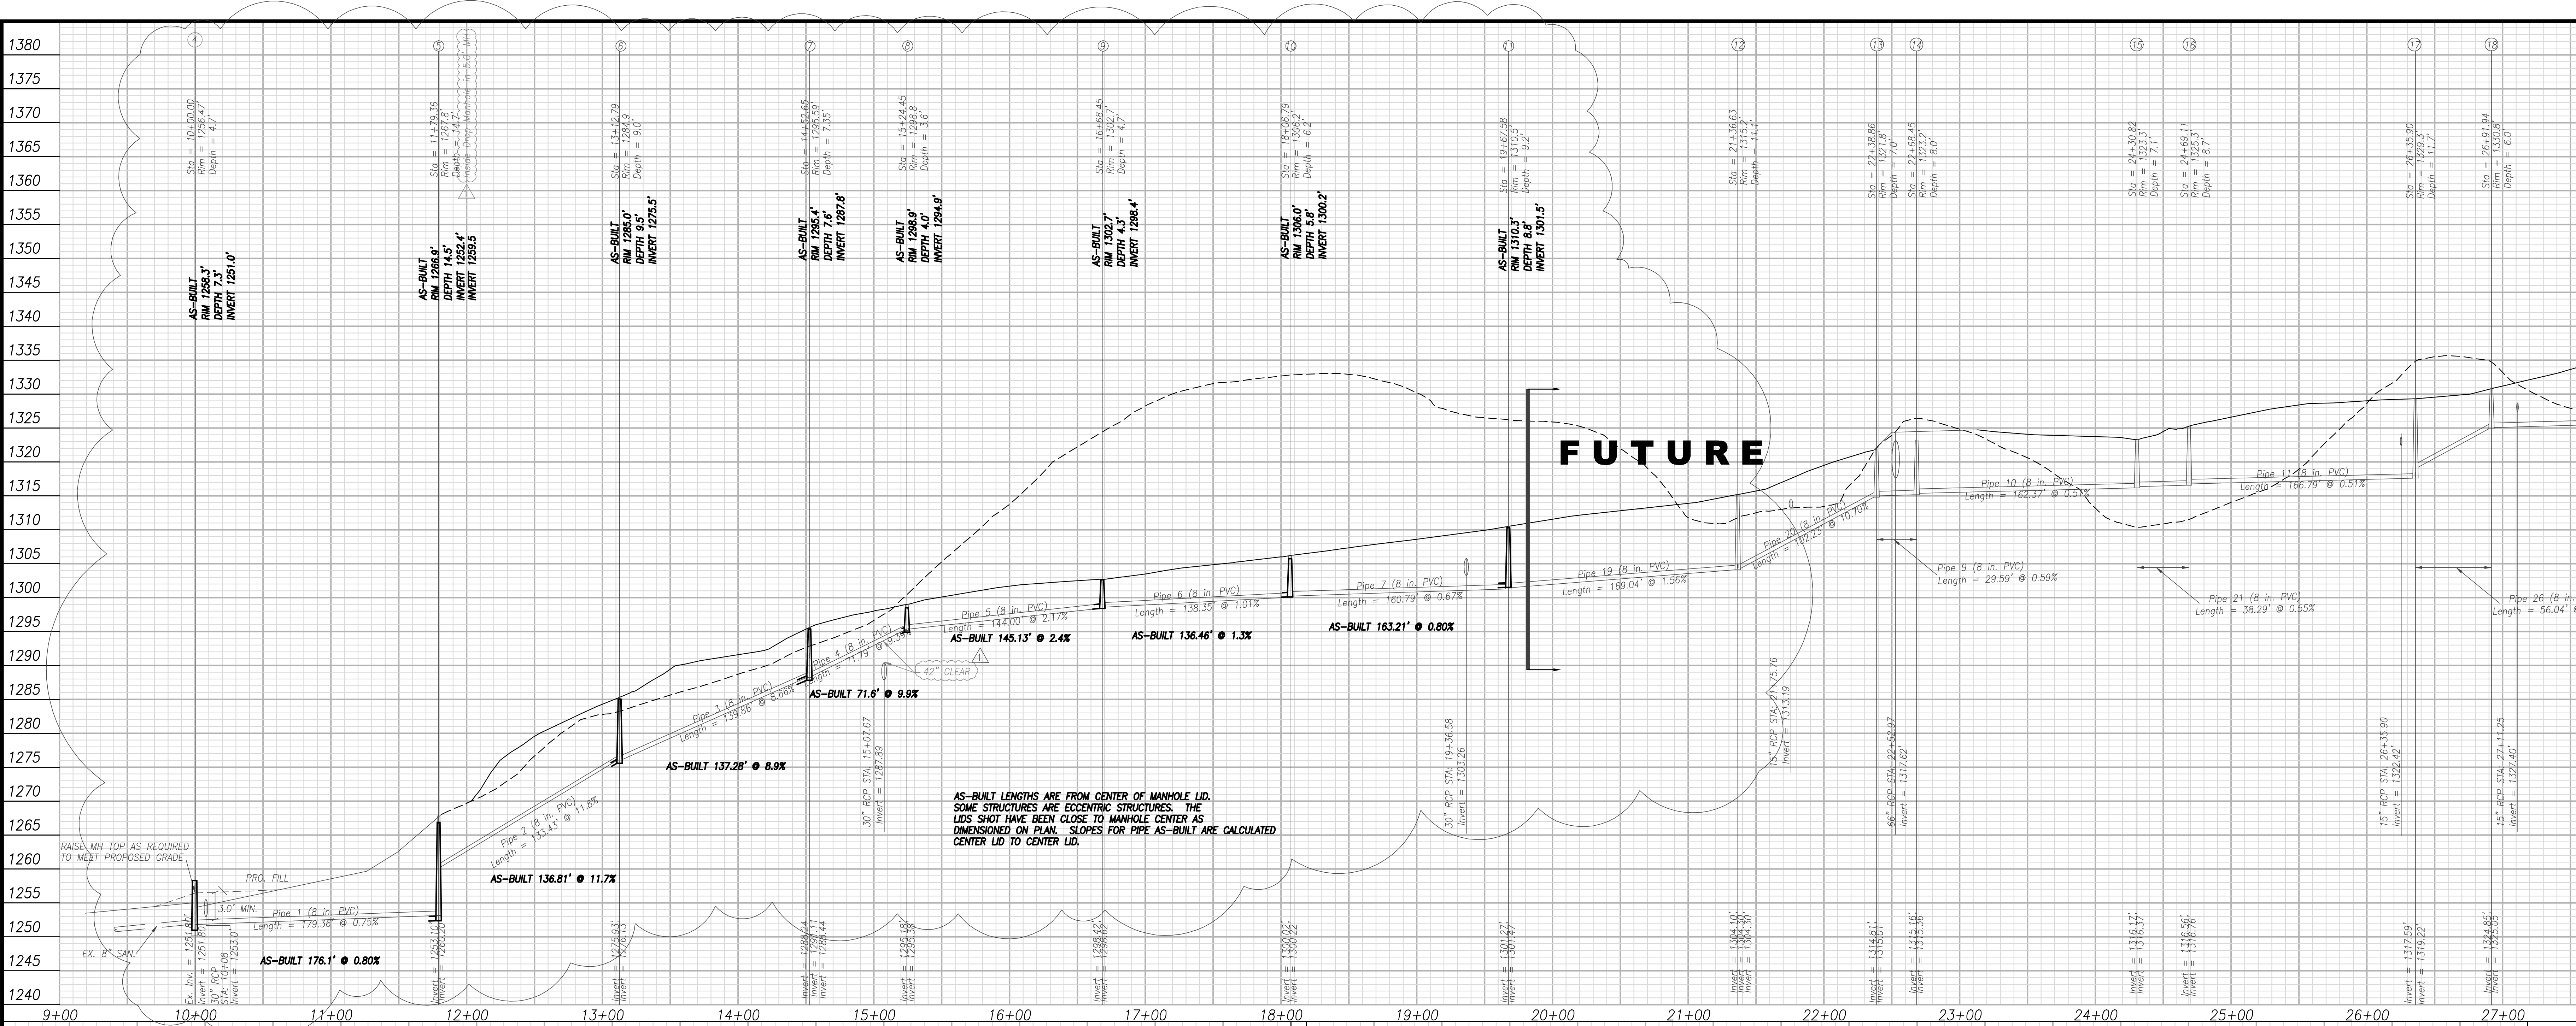

DATE 5/8/08
PROJECT 03083
DESIGNED RHW
DRAWN MSJ
CHECKED RHW

ENGINEERING
CONCEPTS, INC.
"Creating Success"
20 S Beaulieu Street, PO Box 619
540-473-1253 Fax 540-473-1254

PROJECT FRALIN AND WALDRON
DALEVILLE TOWN CENTER
DRAWING SANITARY SEWER PROFILES
SHEET C-38

VARIOUS COUNTY REVIEW COMMENTS
DESCRIPTION
MARK DATE
3/10/08
BY MSJ
REVISIONS