


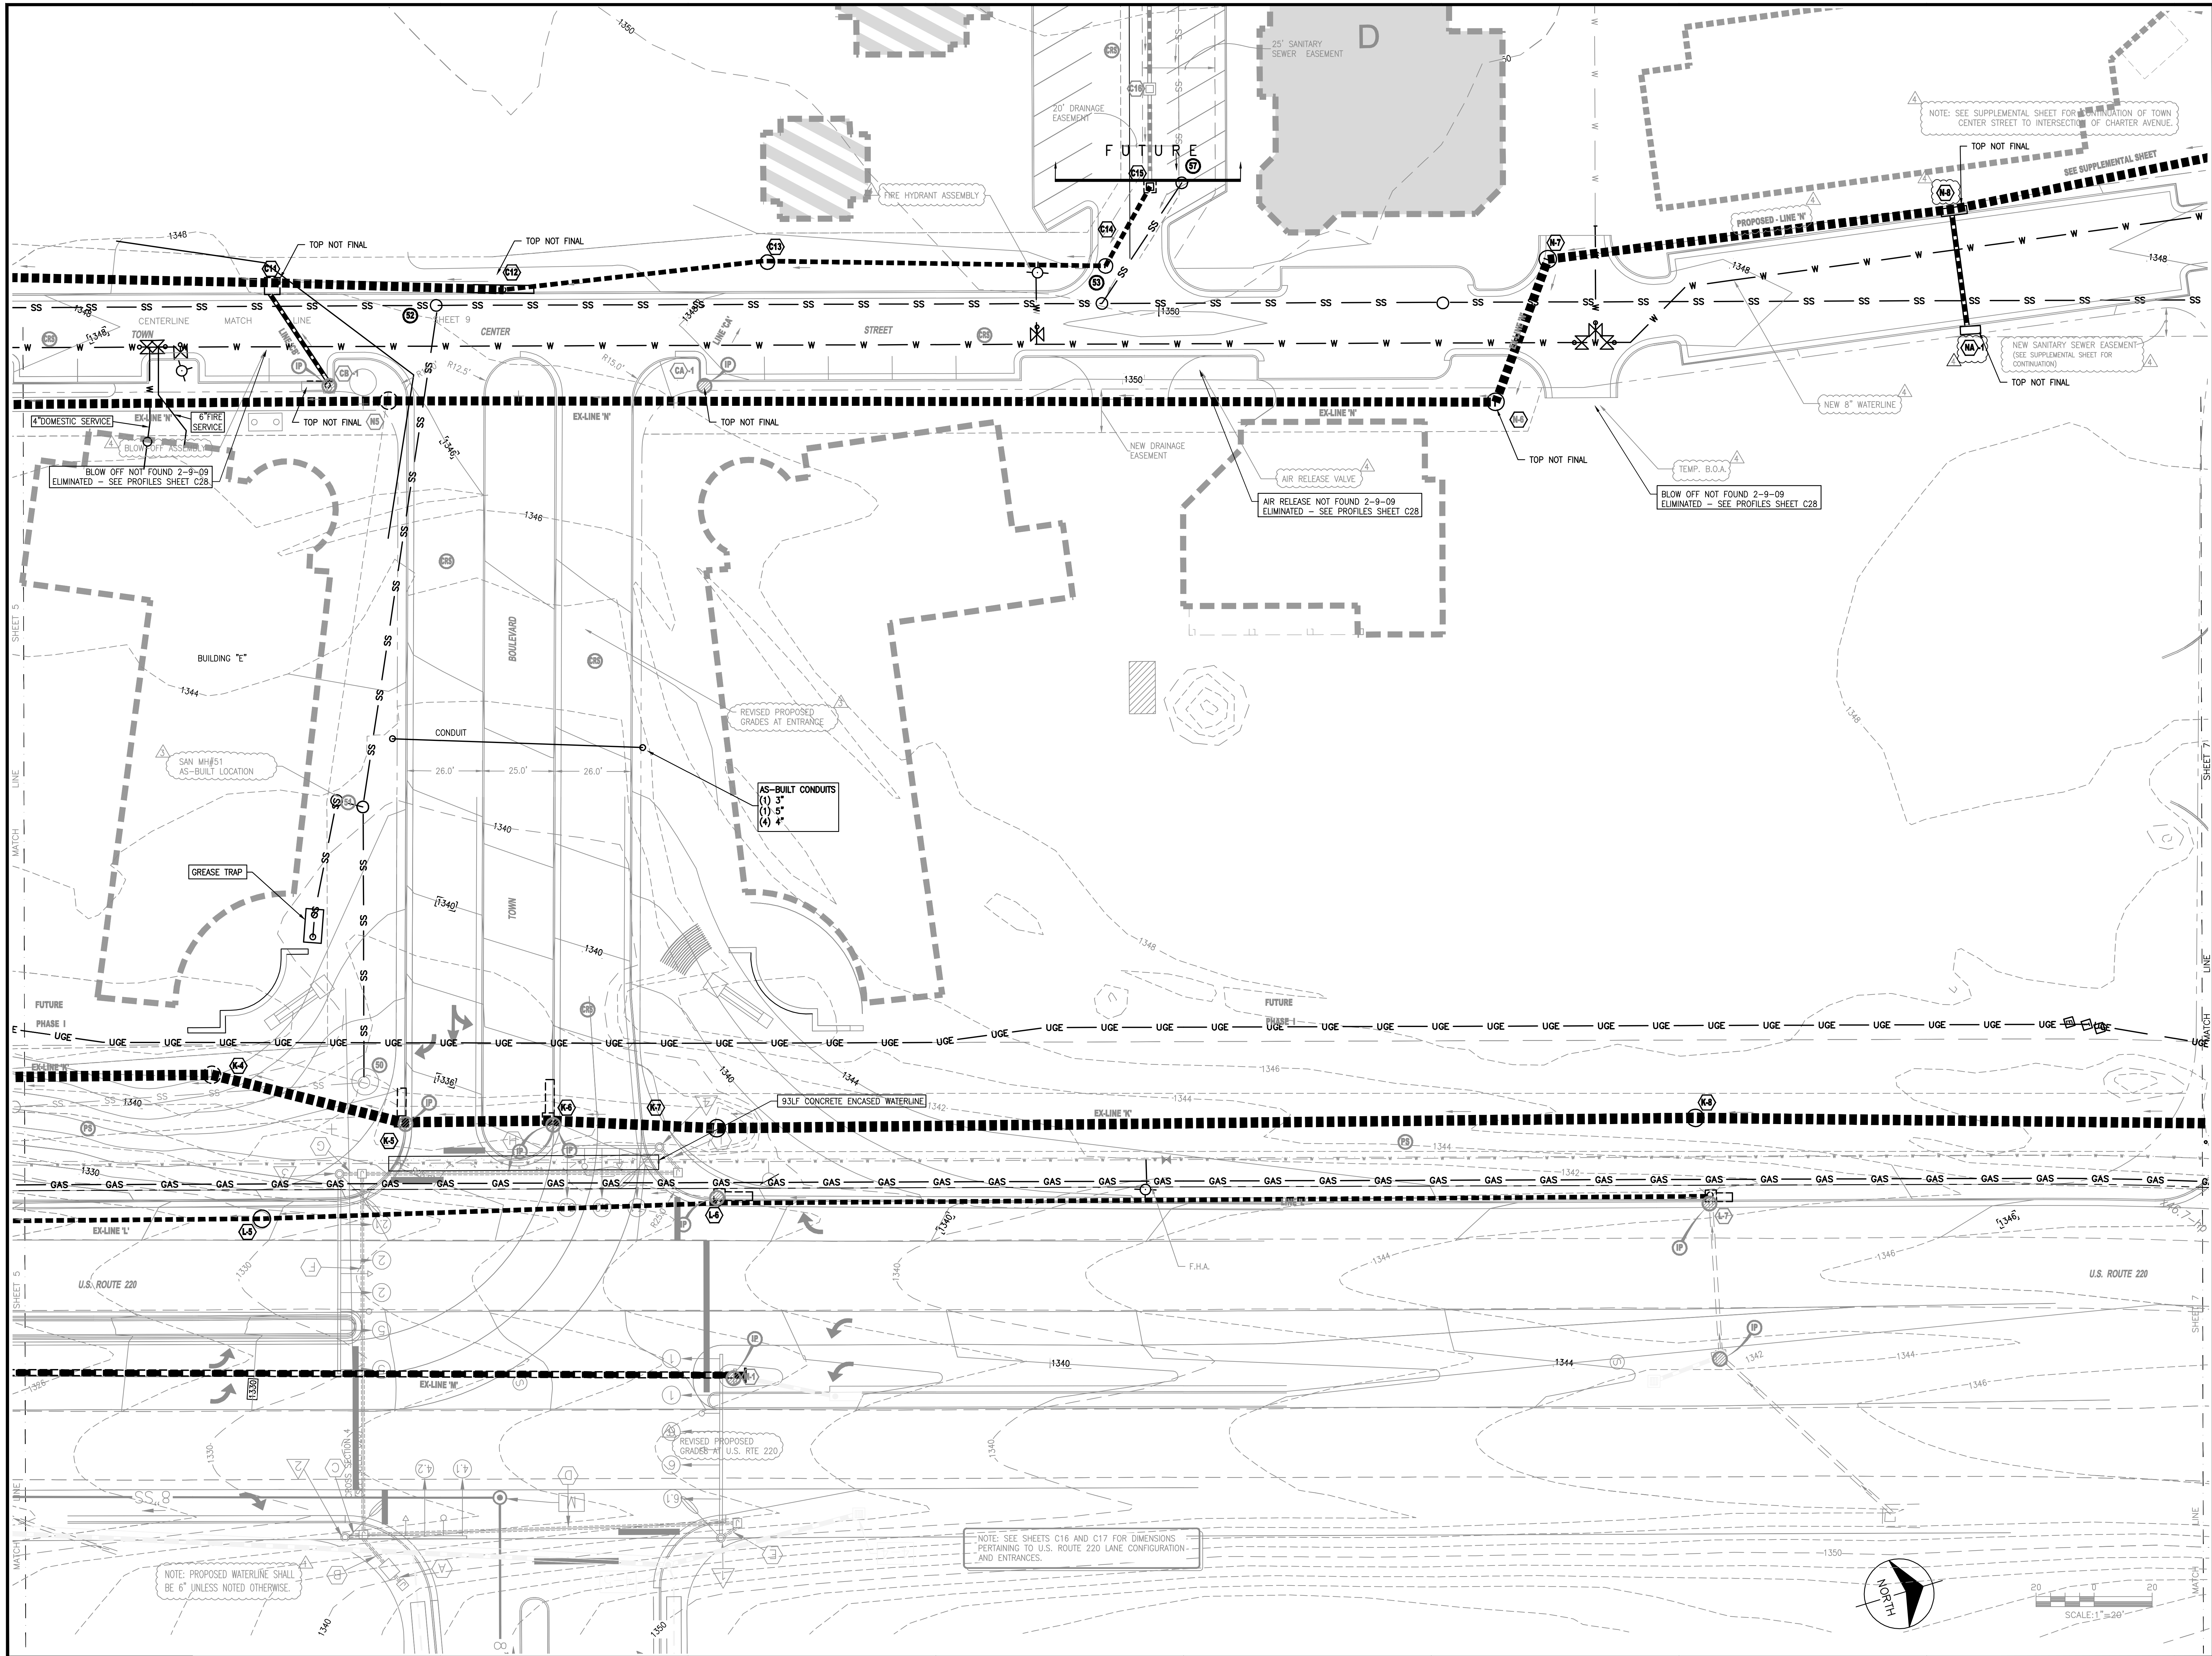

VARIOUS DESIGN DEVELOPMENT REVISIONS
VARIOUS DEVELOPMENT REVISIONS
VARIOUS COUNTY REVIEW COMMENTS

MSMJ
09/29/08
07/08/08
03/08/08

MARK DATE
BY

REVISIONS

DATE 5/8/08
PROJECT 03083
DESIGNED RHW
DRAWN MSMJ
CHECKED RHW

ENGINEERING
CONCEPTS, INC.
"Creating Success"

ROBERT H. WAMPLER, JR.
No. 34713
PROFESSIONAL ENGINEER

PROJECT FRALIN AND WALDRON
DALEVILLE TOWN CENTER

DRAWING COMPREHENSIVE DEVELOPMENT PLAN

SHEET
C-06