


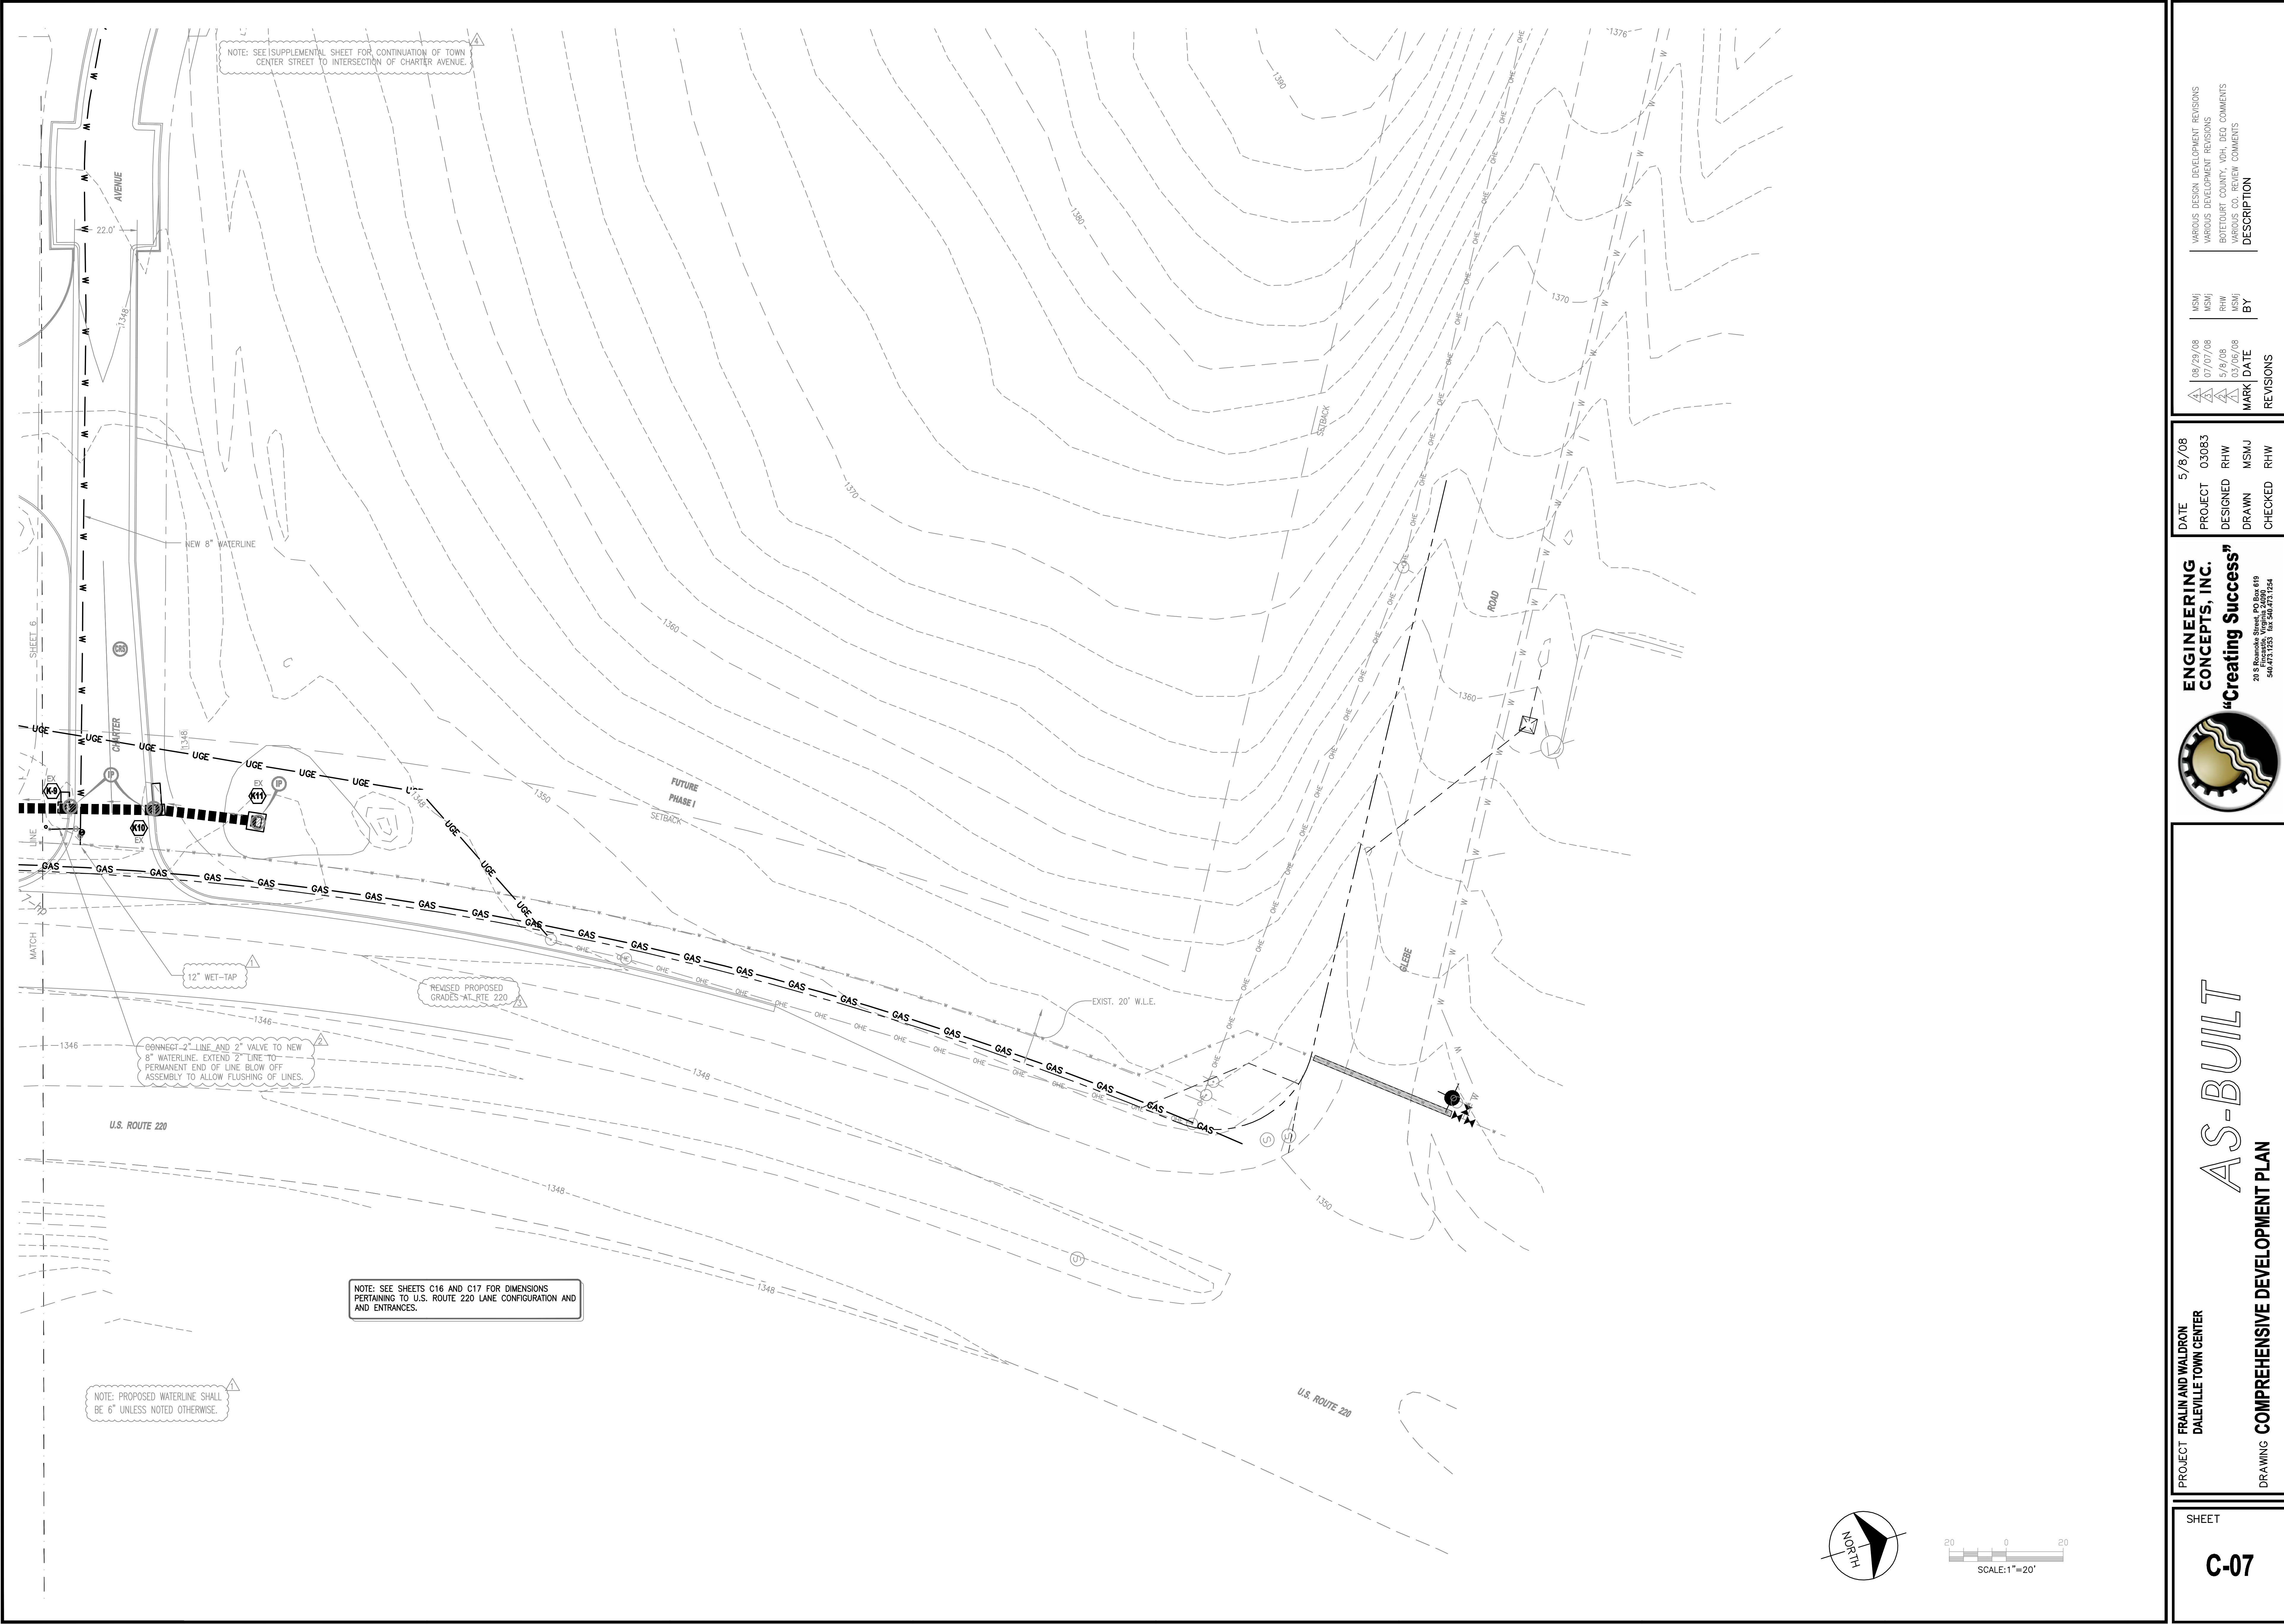

PROJECT
FRALIN AND WALDRON
DALEVILLE TOWN CENTER

AS-BUILT

DRAWING
COMPREHENSIVE DEVELOPMENT PLAN

DATE
5/8/08

PROJECT
03083

DESIGNED
RHW

DRAWN
MSMJ

CHECKED
RHW

08/29/08
MSMJ

07/07/08
RHW

5/8/08
MSMJ

03/06/08
MSMJ

MARK

DATE

REVISIONS

VARIOUS DESIGN DEVELOPMENT REVISIONS

VARIOUS DEVELOPMENT REVISIONS

BOTETOURT COUNTY, VDH, EDC COMMENTS

VARIOUS CO. REVIEW COMMENTS

DESCRIPTION

ENGINEERING
CONCEPTS, INC.

“Creating Success”

20 S. Riverside Street, PO Box 616
Friesdale, Virginia 22626
540.473.1253 fax 540.473.1254