

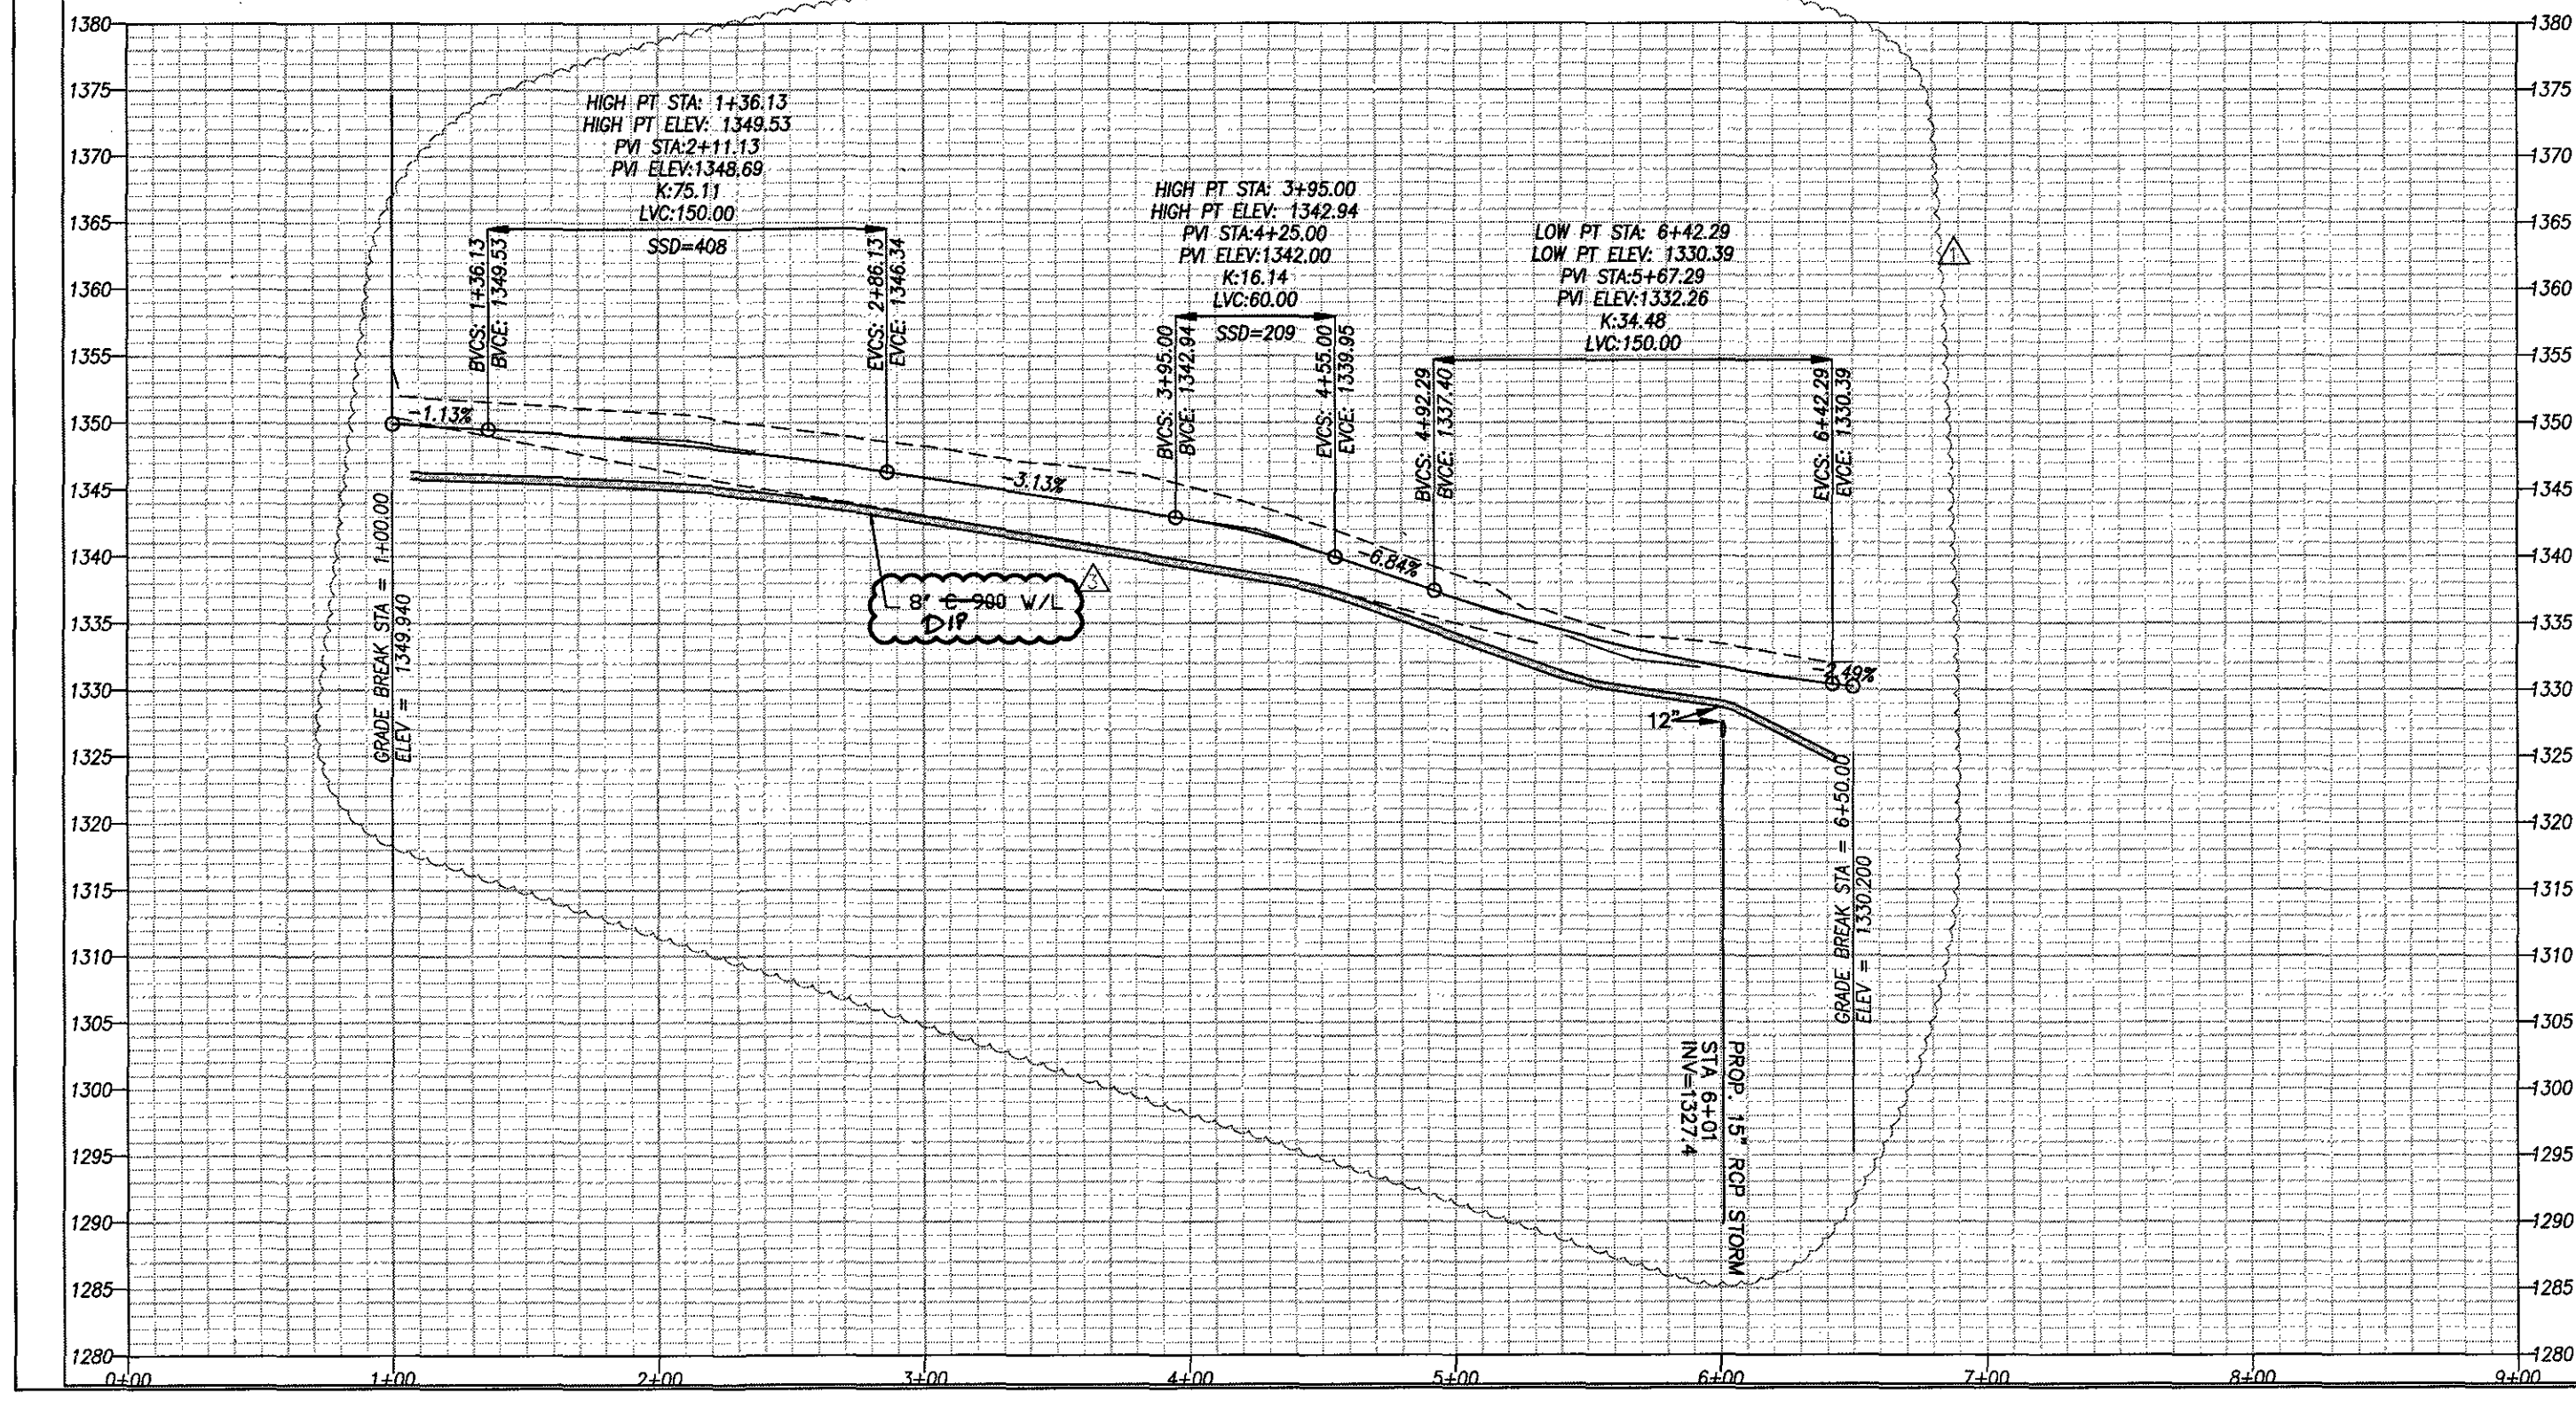
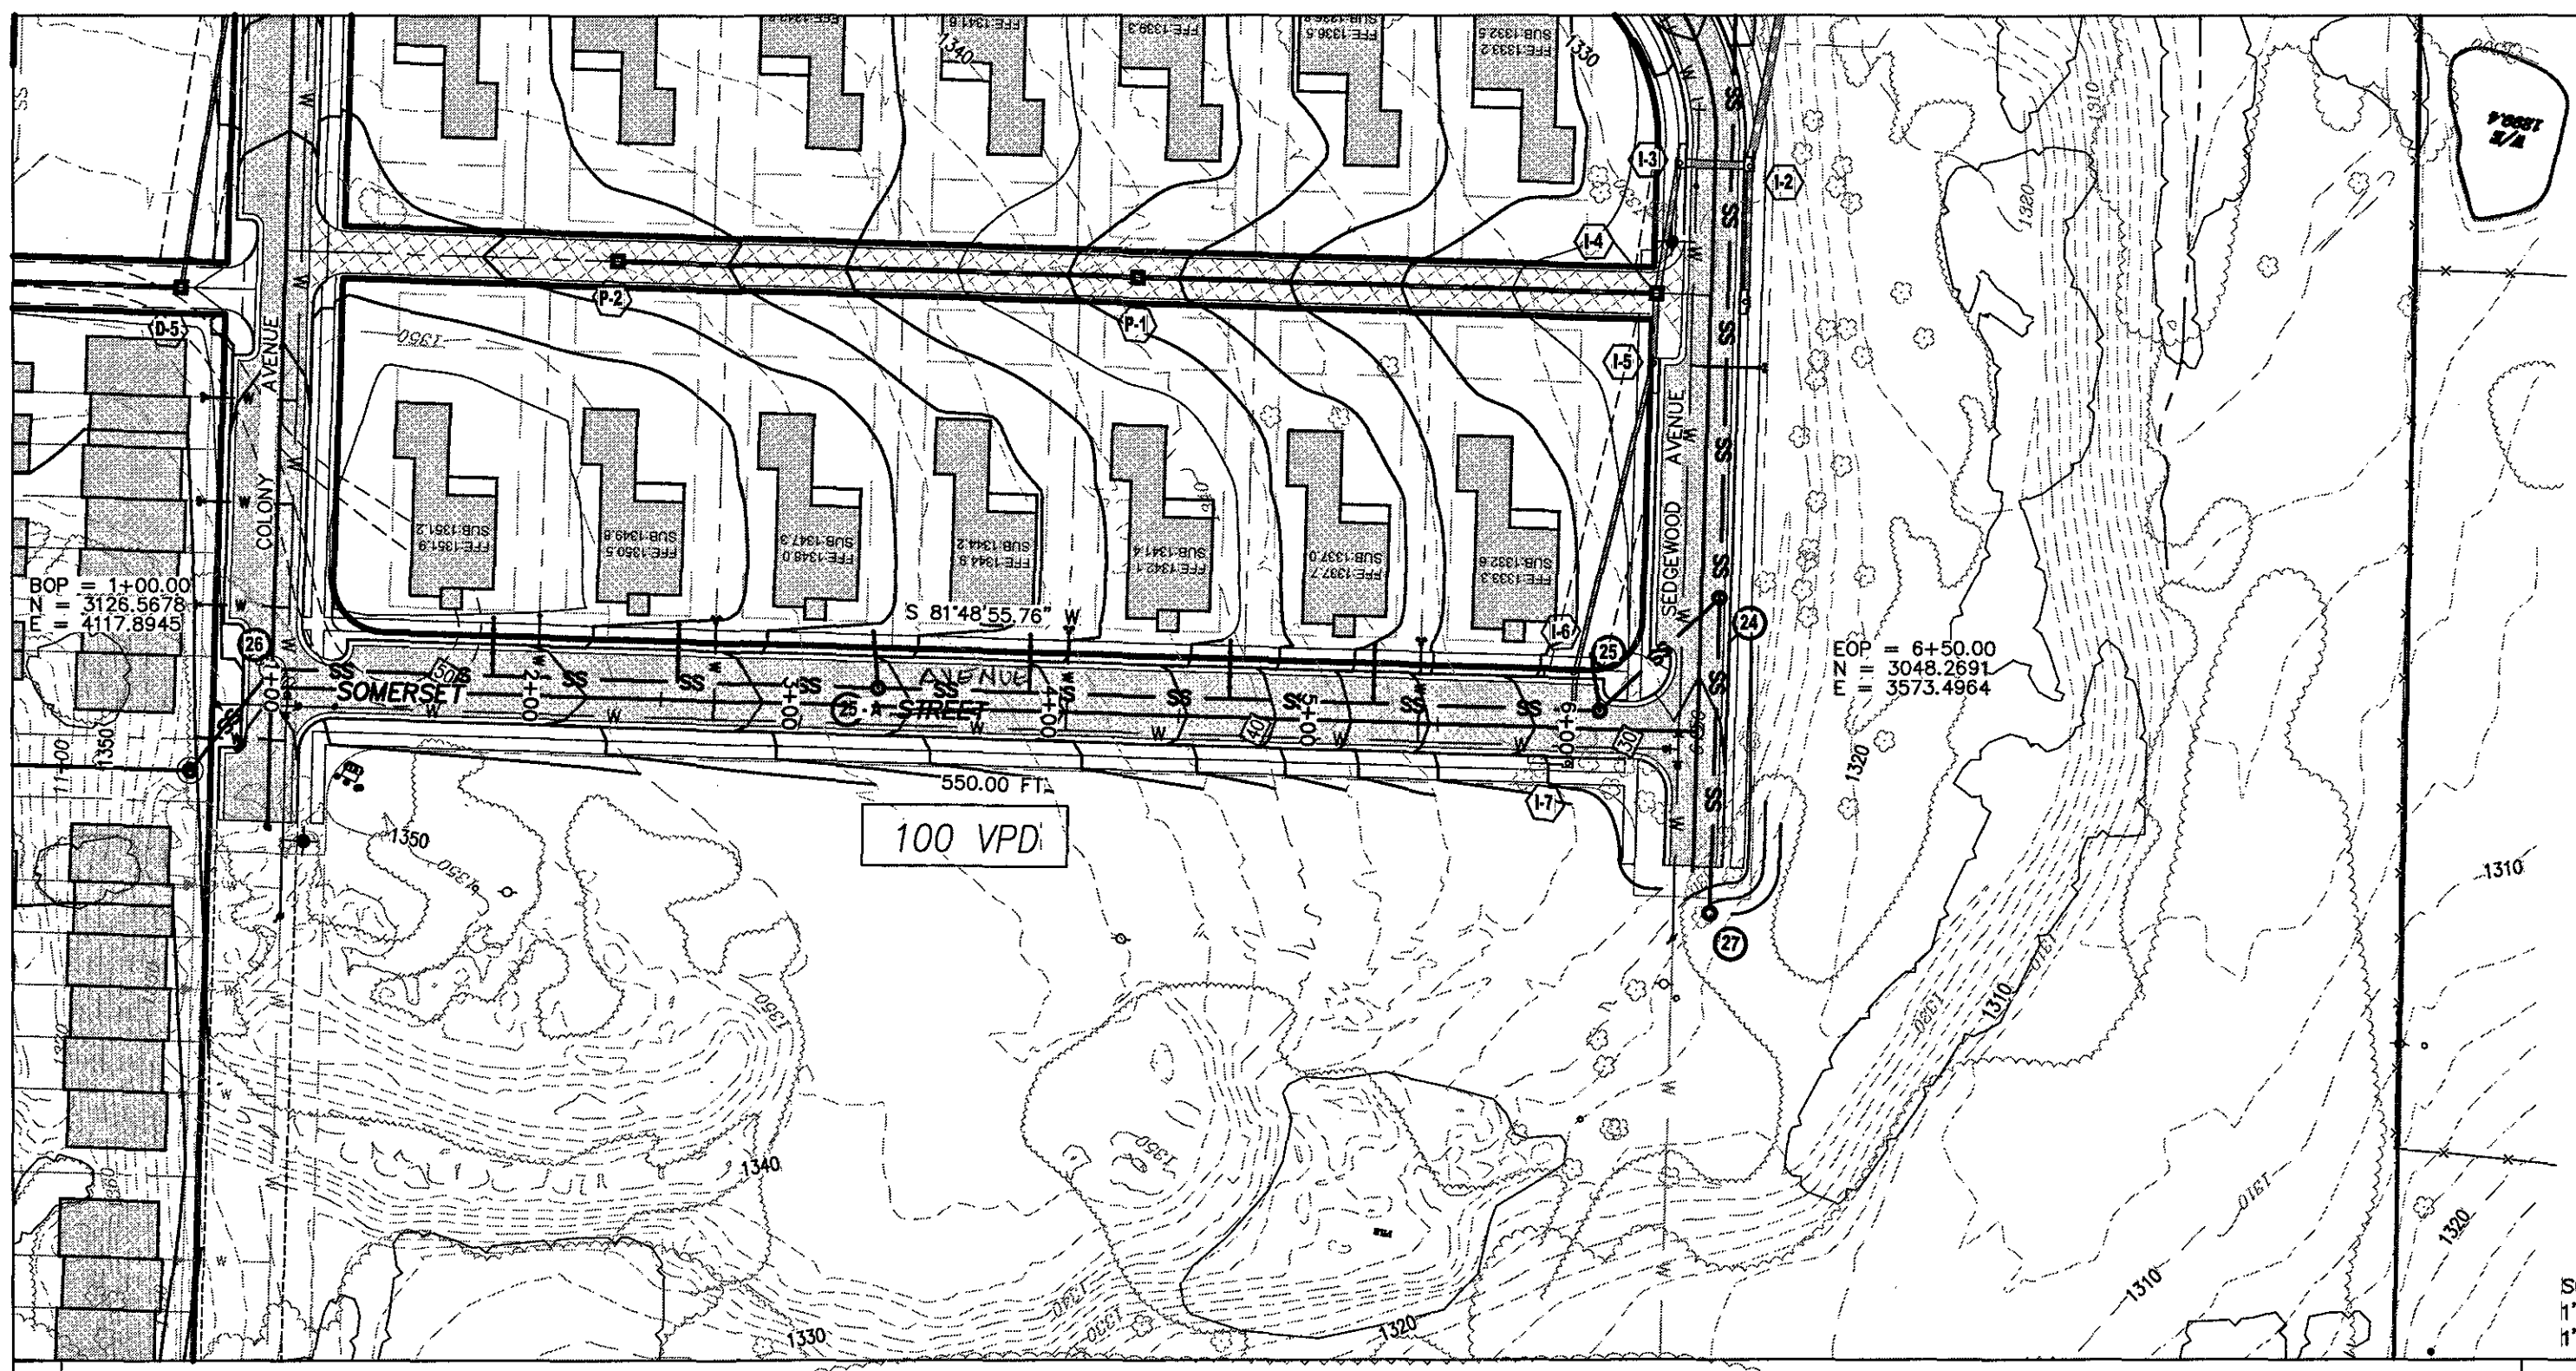


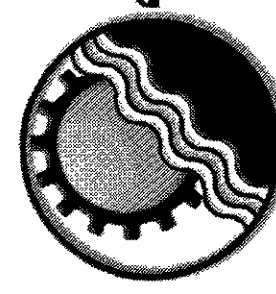

+ Phase 1 Water Line Tested 4-13-18
 + Phase 2 Water Line Tested 7-18-18

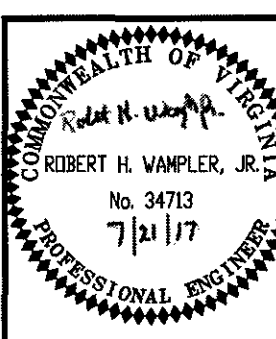

**ENGINEERING
 CONCEPTS, INC.**
 "Creating Success"
 24 GRANVILLE STREET
 DALEVILLE, VIRGINIA 24083
 540.475.1253

DATE	5/8/08
PROJECT	03083
DESIGNED	RHW
DRAWN	MSMJ
CHECKED	RHW

REVISIONS	DATE	BY	DESCRIPTION
1	7/21/17	MSMJ	WMA COMMENTS
2	7/19/17	MSMJ	WMA COMMENTS
3	5/24/17	MSMJ	VARIOUS DEVELOPMENT REVISIONS