

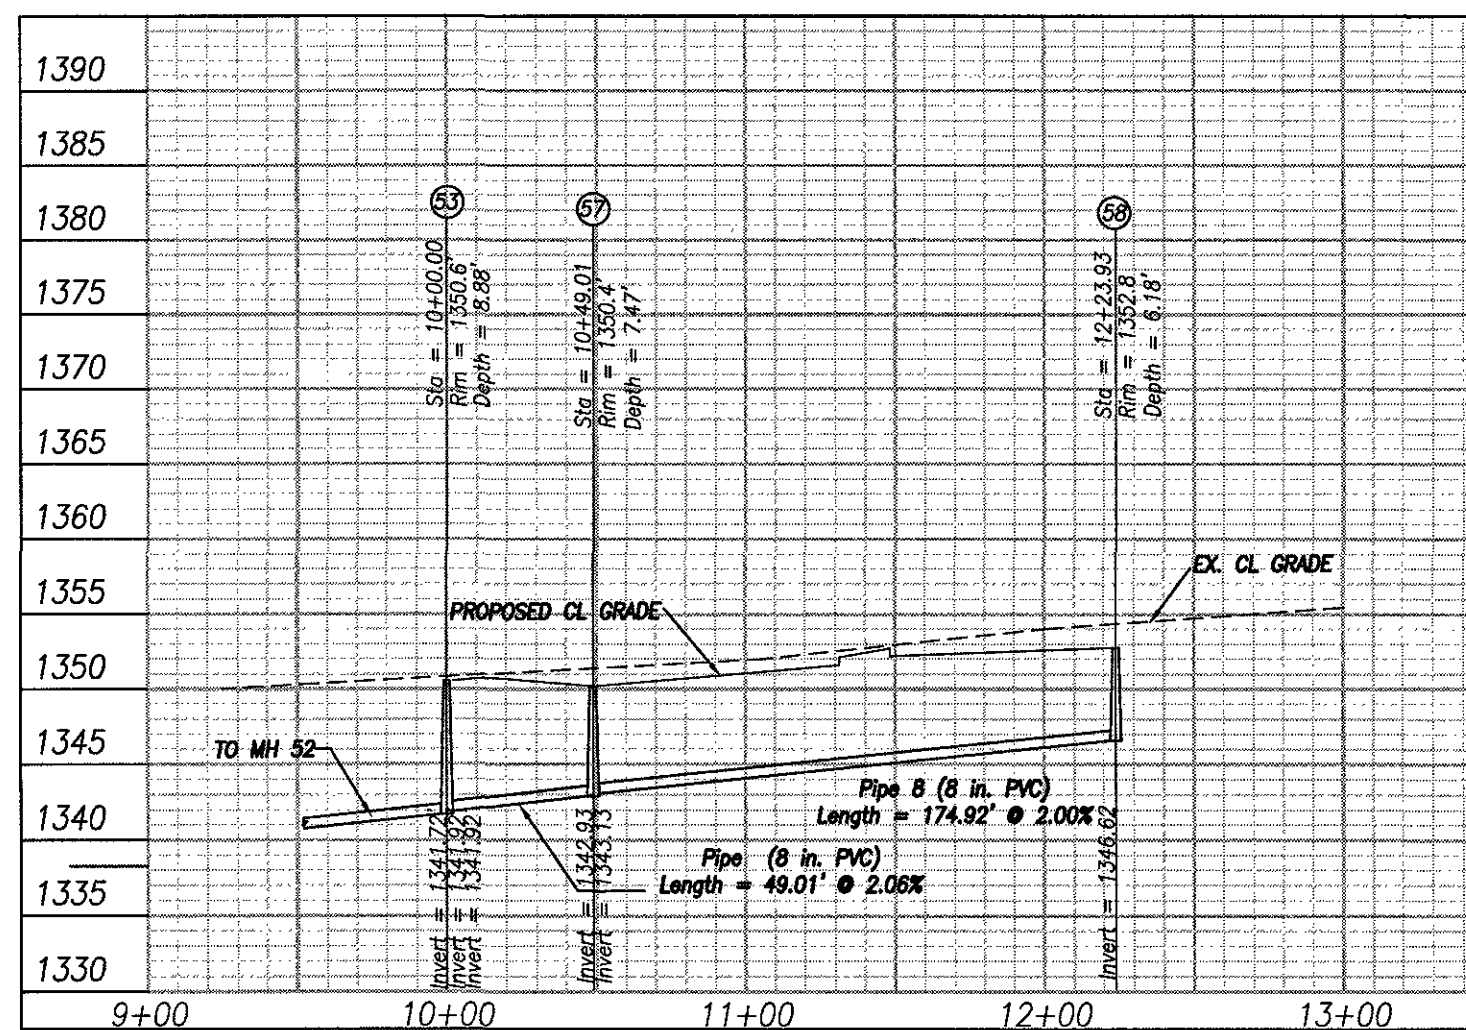
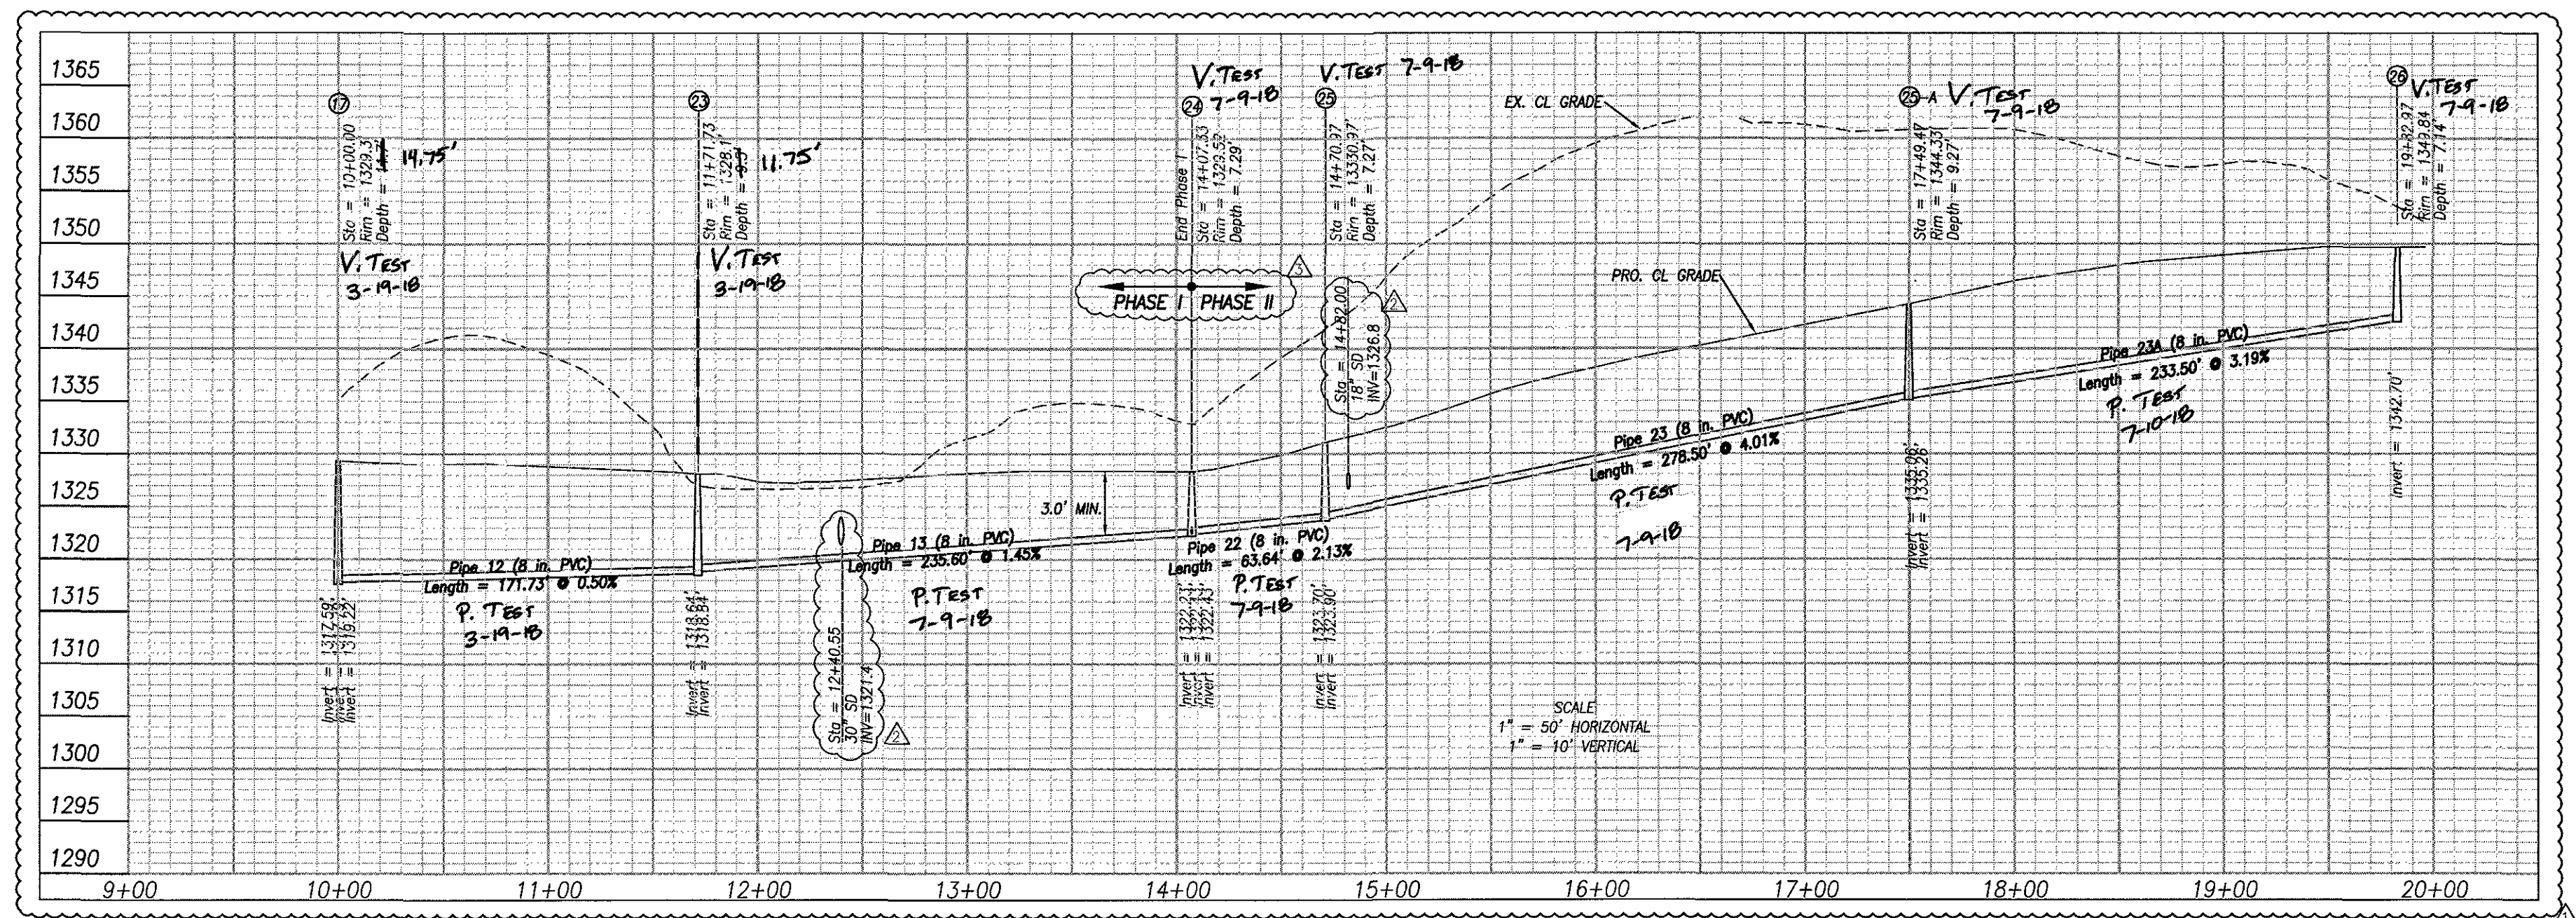


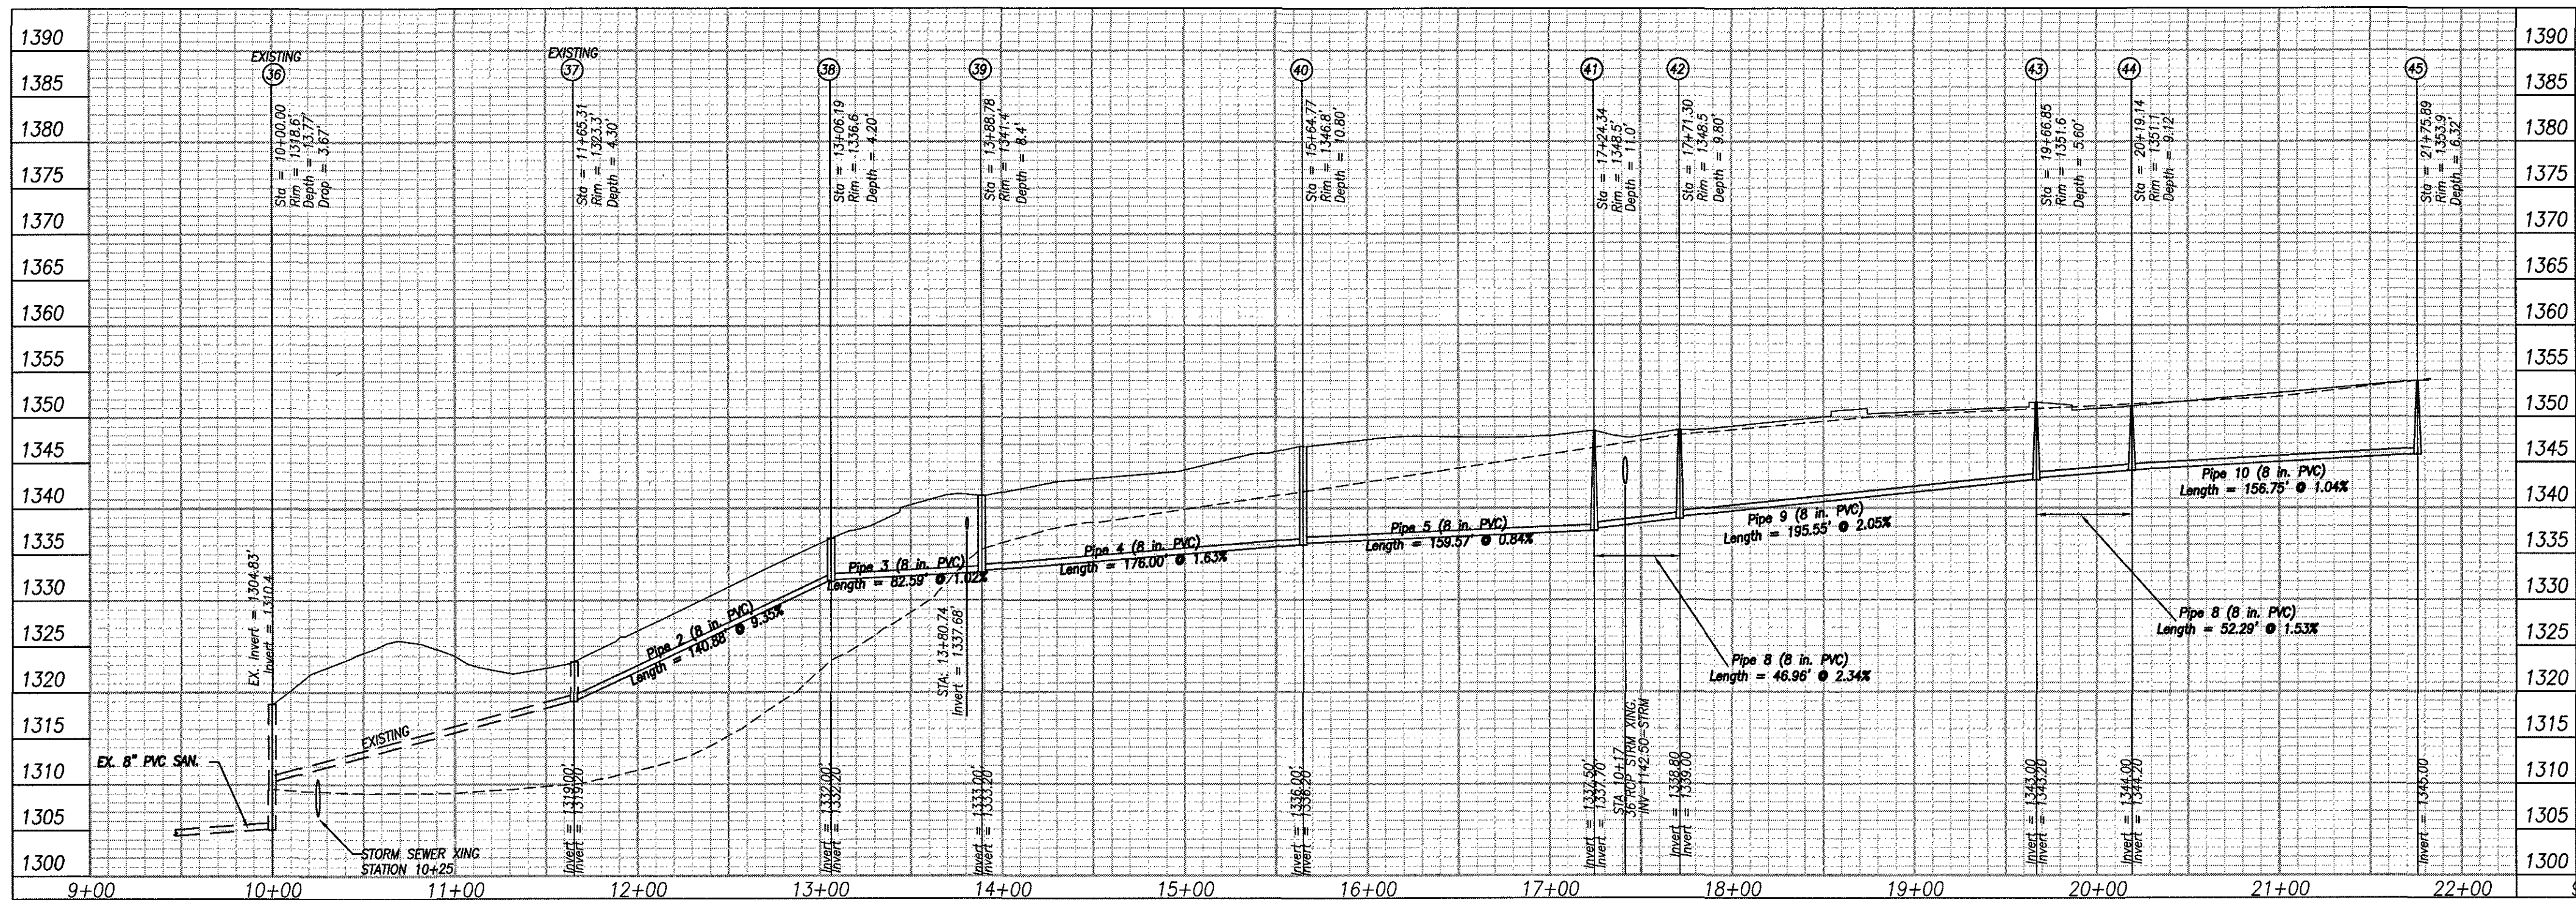

ENGINEERING
CONCEPTS, INC.
"Creating Success"

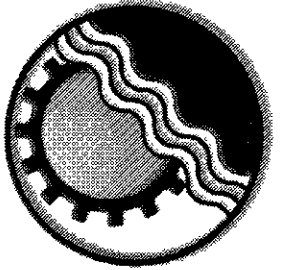

ROBERT H. WAMPLER, JR.
Lic. No. 34713
7/11/17
PROFESSIONAL ENGINEER

PROJECT: FRALIN AND WALDRON
DALEVILLE TOWN CENTER
DRAWING: SANITARY SEWER PROFILES

SHEET
C-39

DATE: 5/8/08
PROJECT: 03083
DESIGNED: RHW
DRAWN: MSMJ
CHECKED: RHW

DATE: 12/11/17
PROJECT: 03083
DESIGNED: RHW
DRAWN: MSMJ
CHECKED: RHW

WMA COMMENTS - PHASING
WMA COMMENTS
VARIOUS DEVELOPMENT REVISIONS

DESCRIPTION
BY
DATE
REVISIONS