

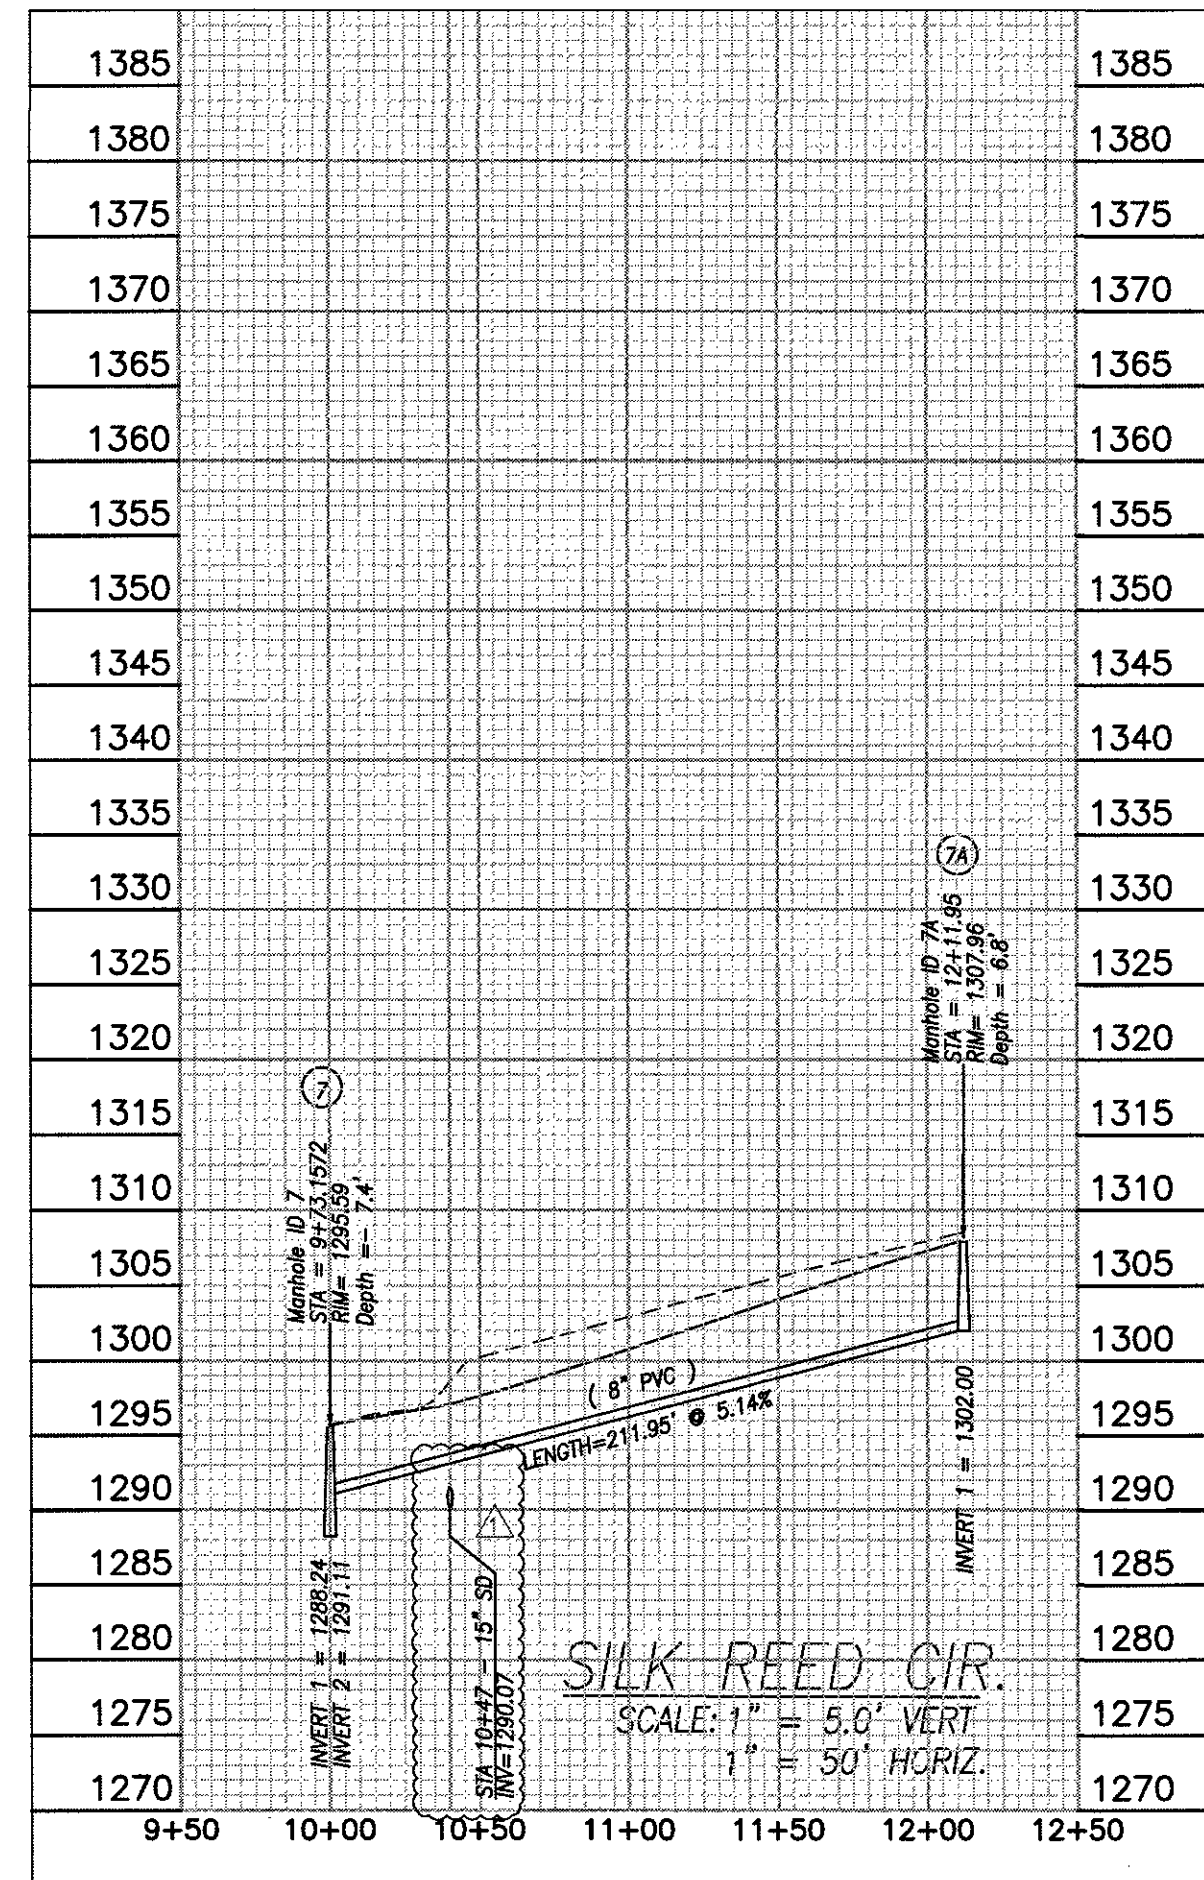
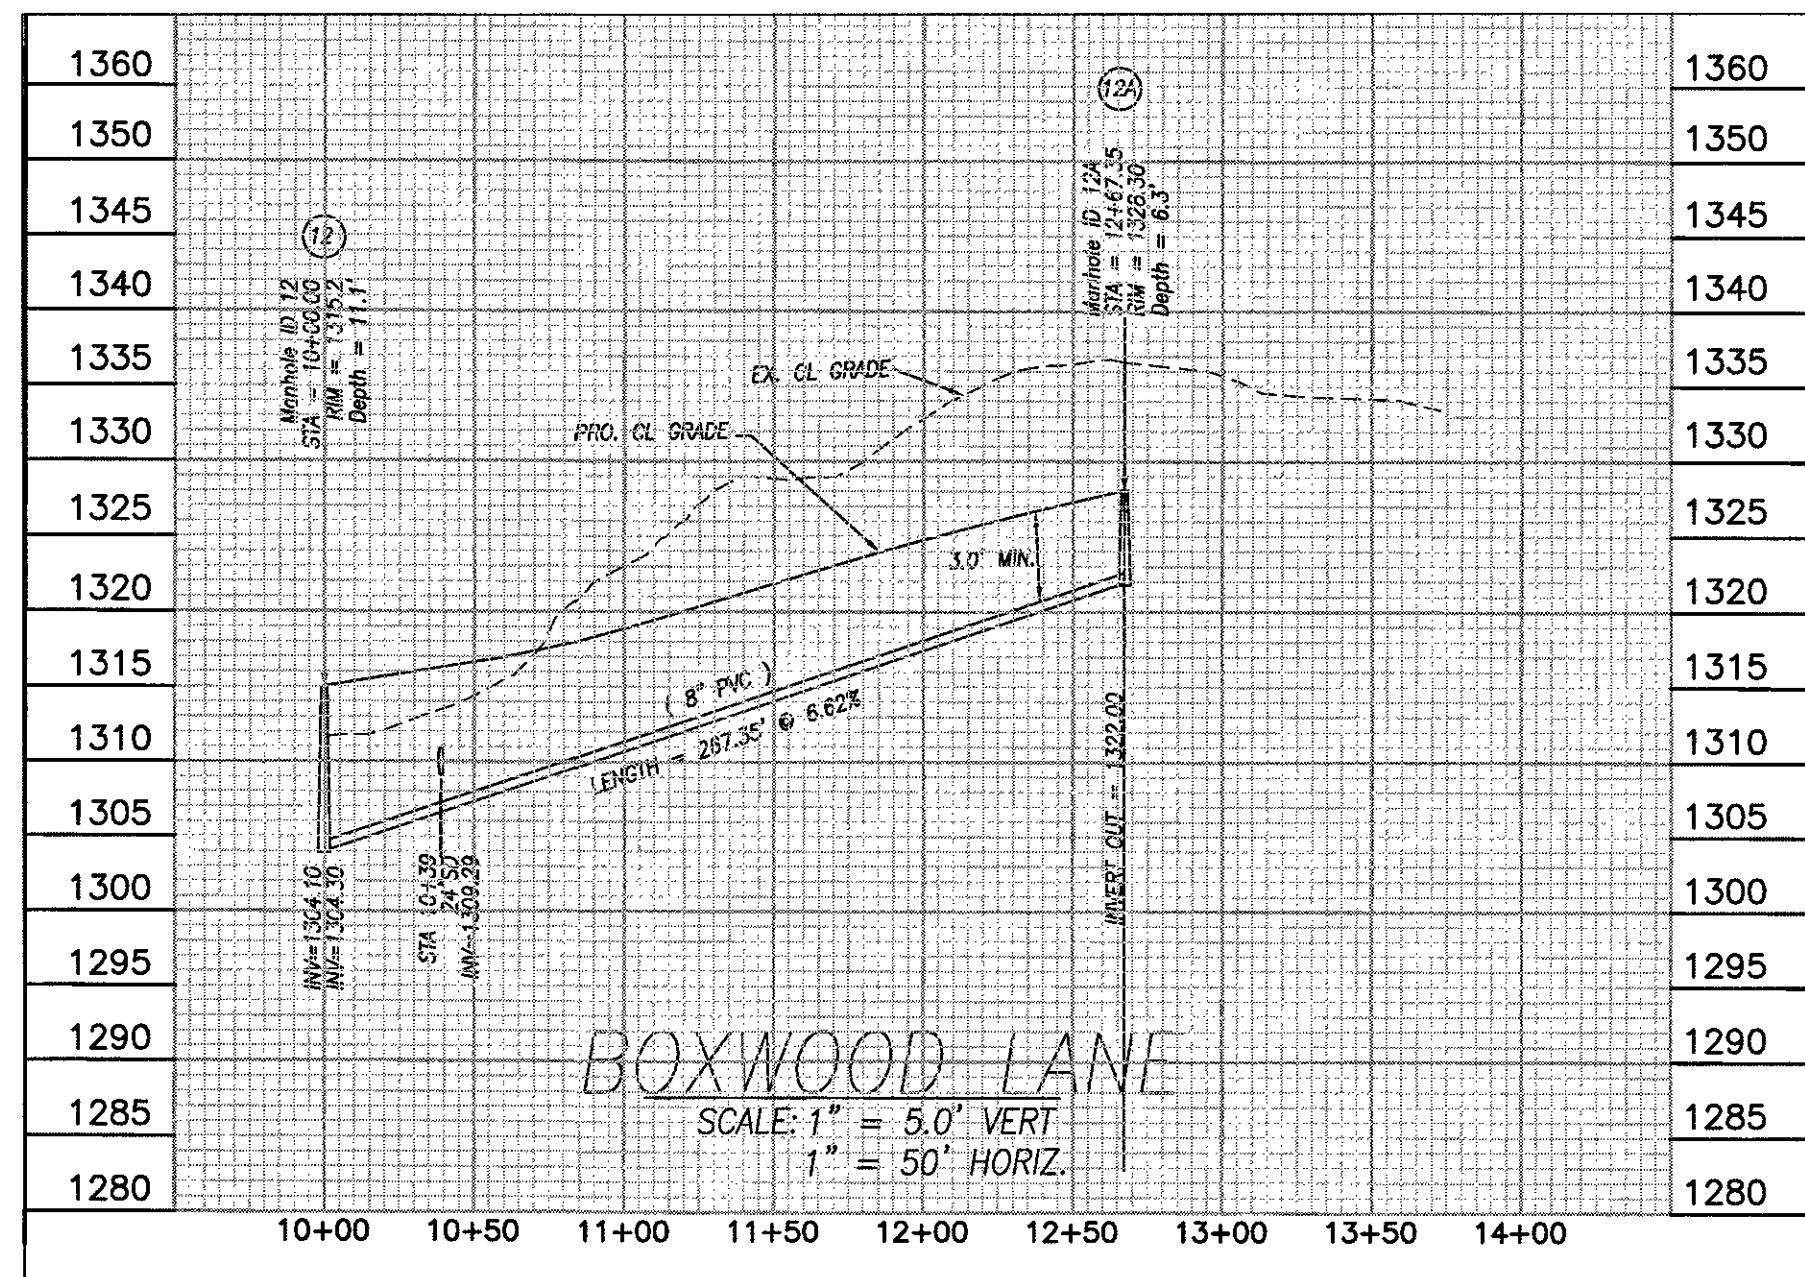
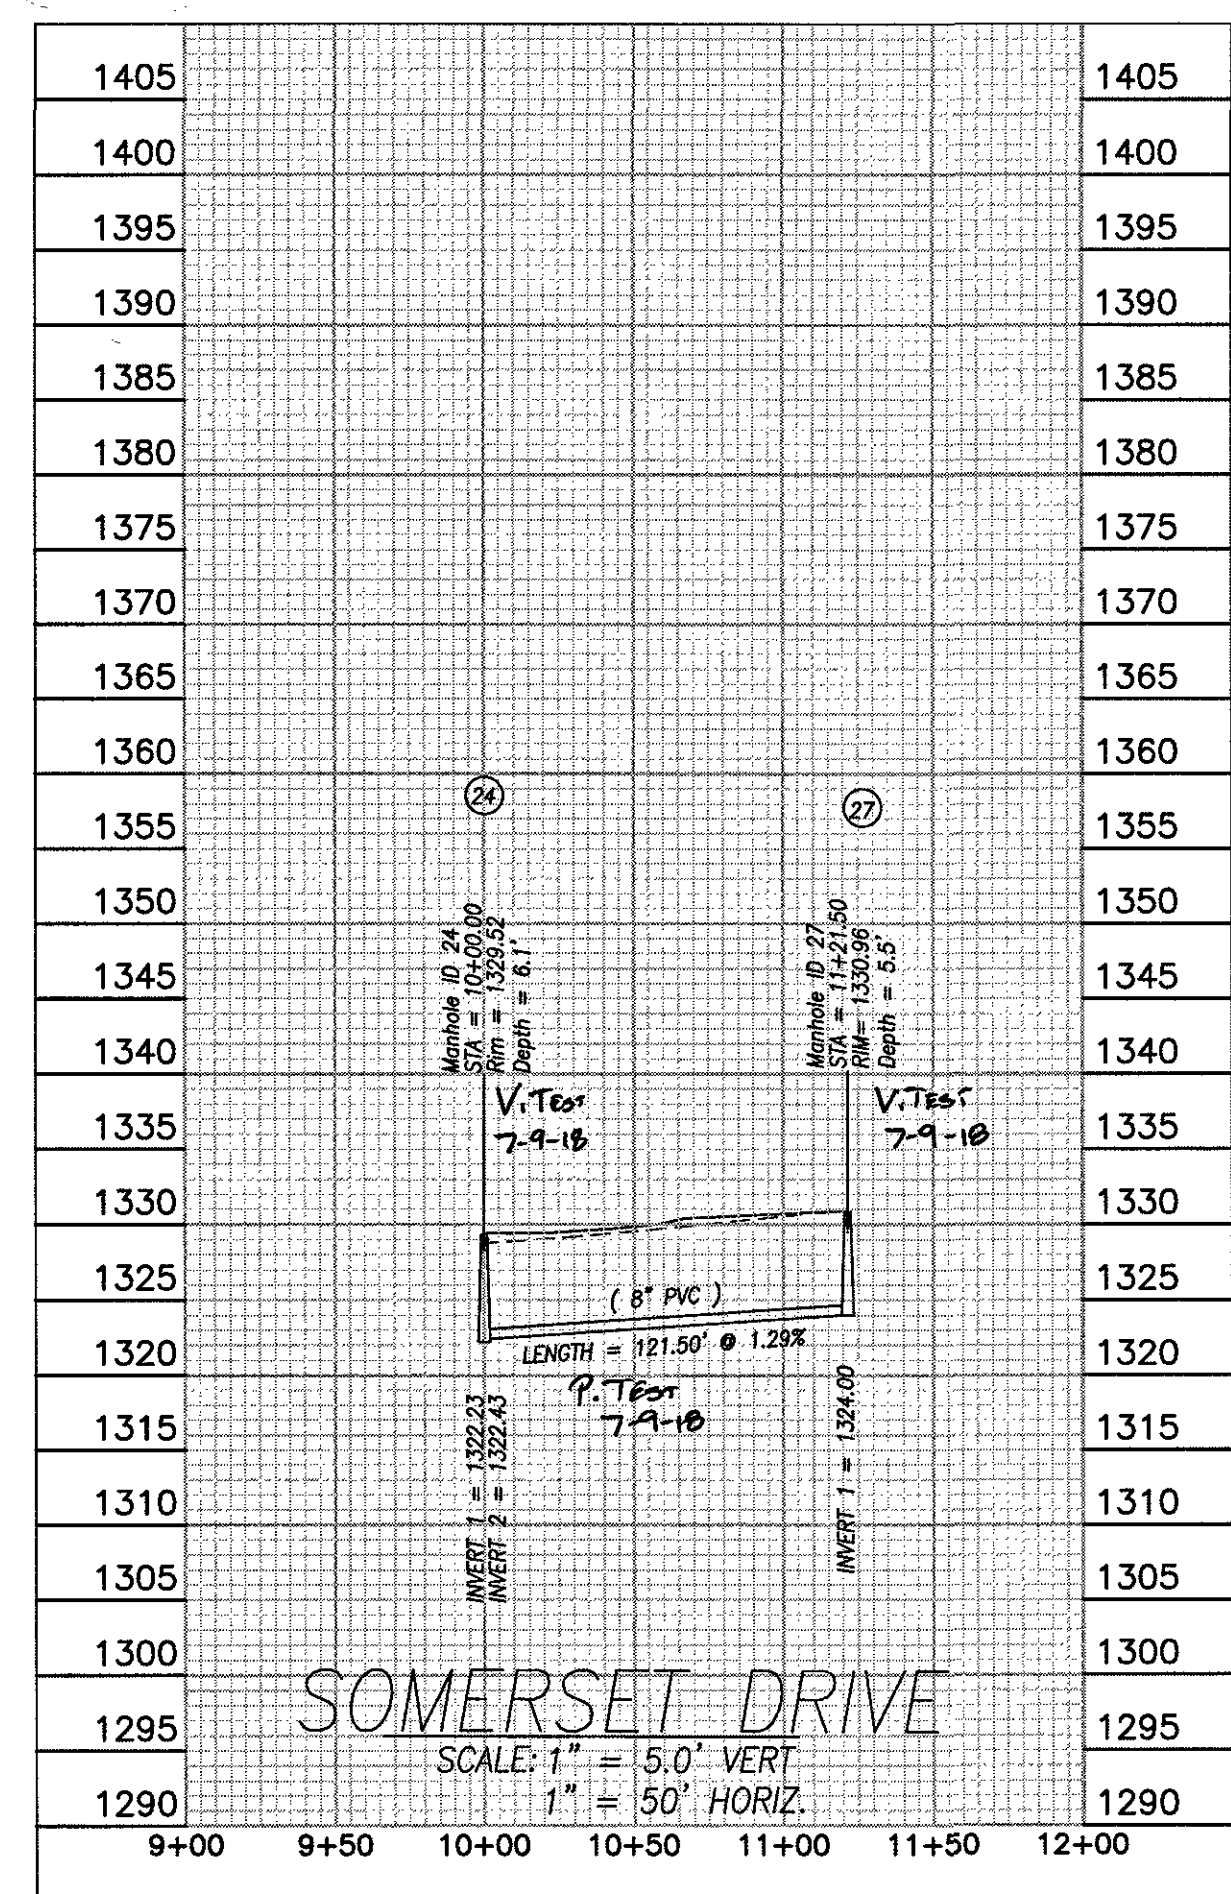
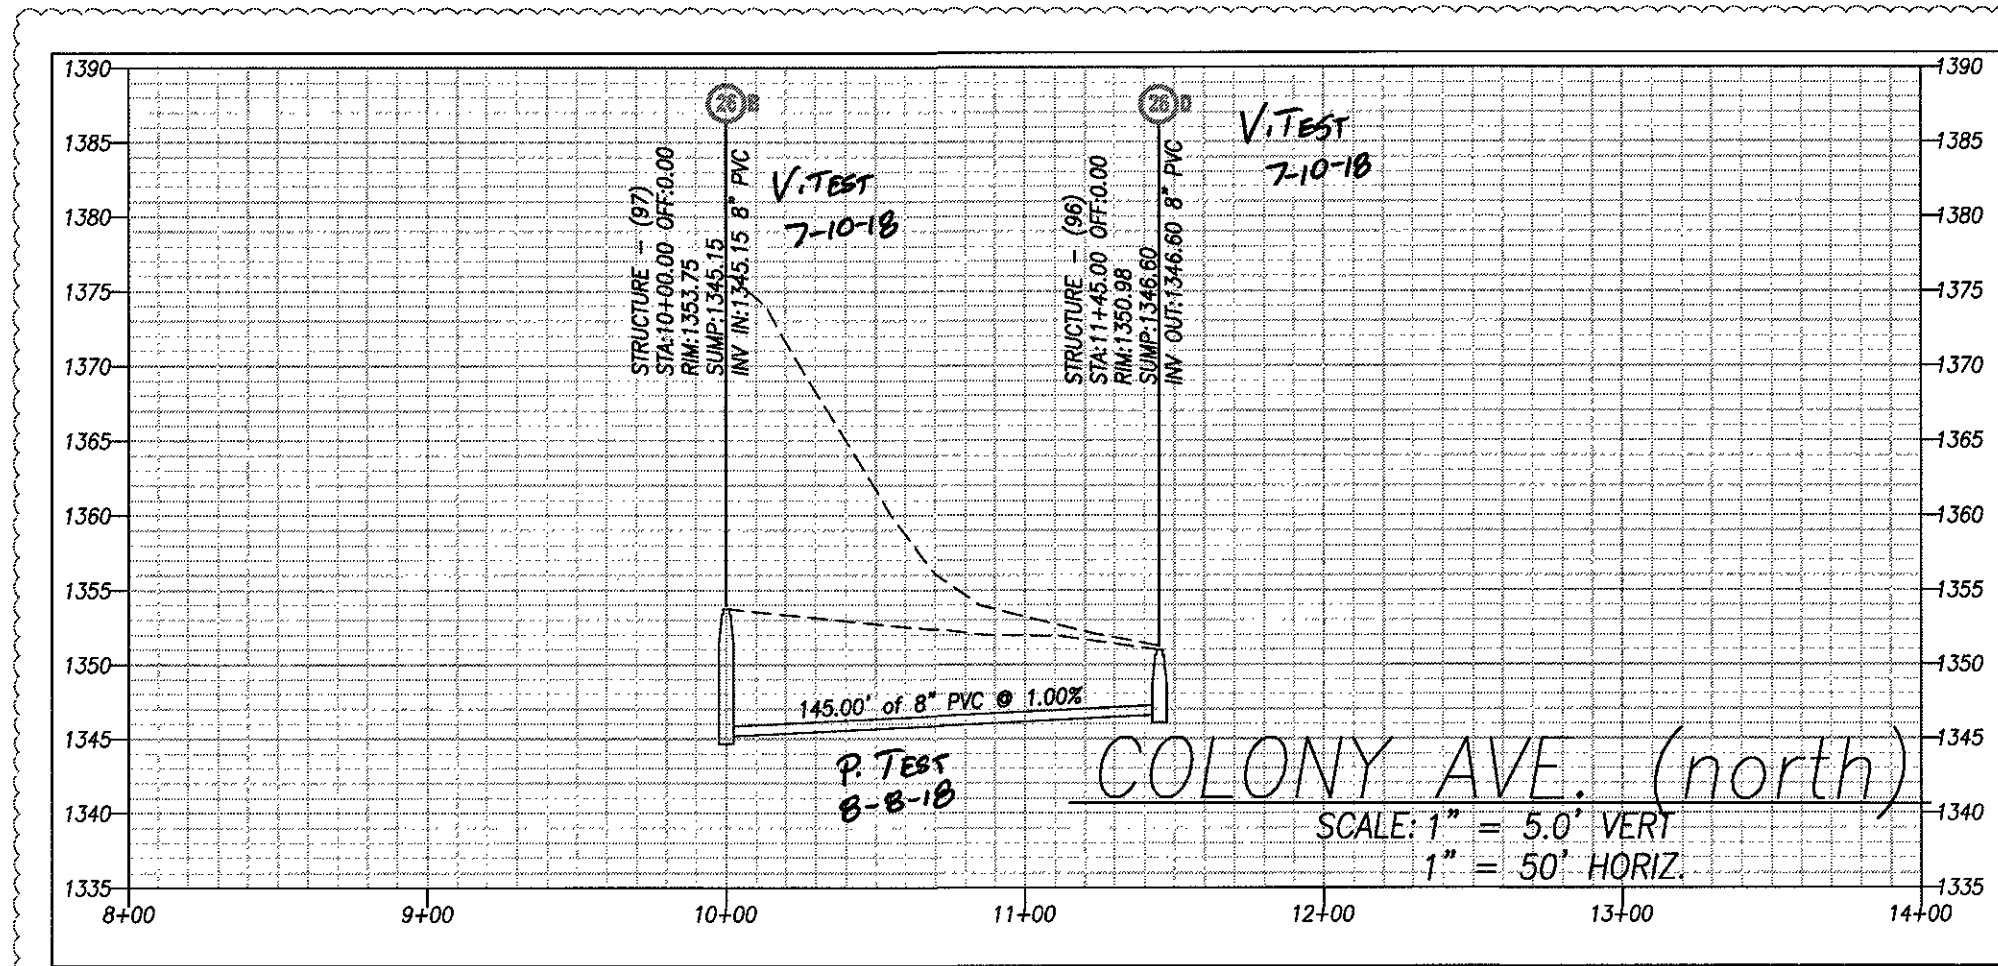
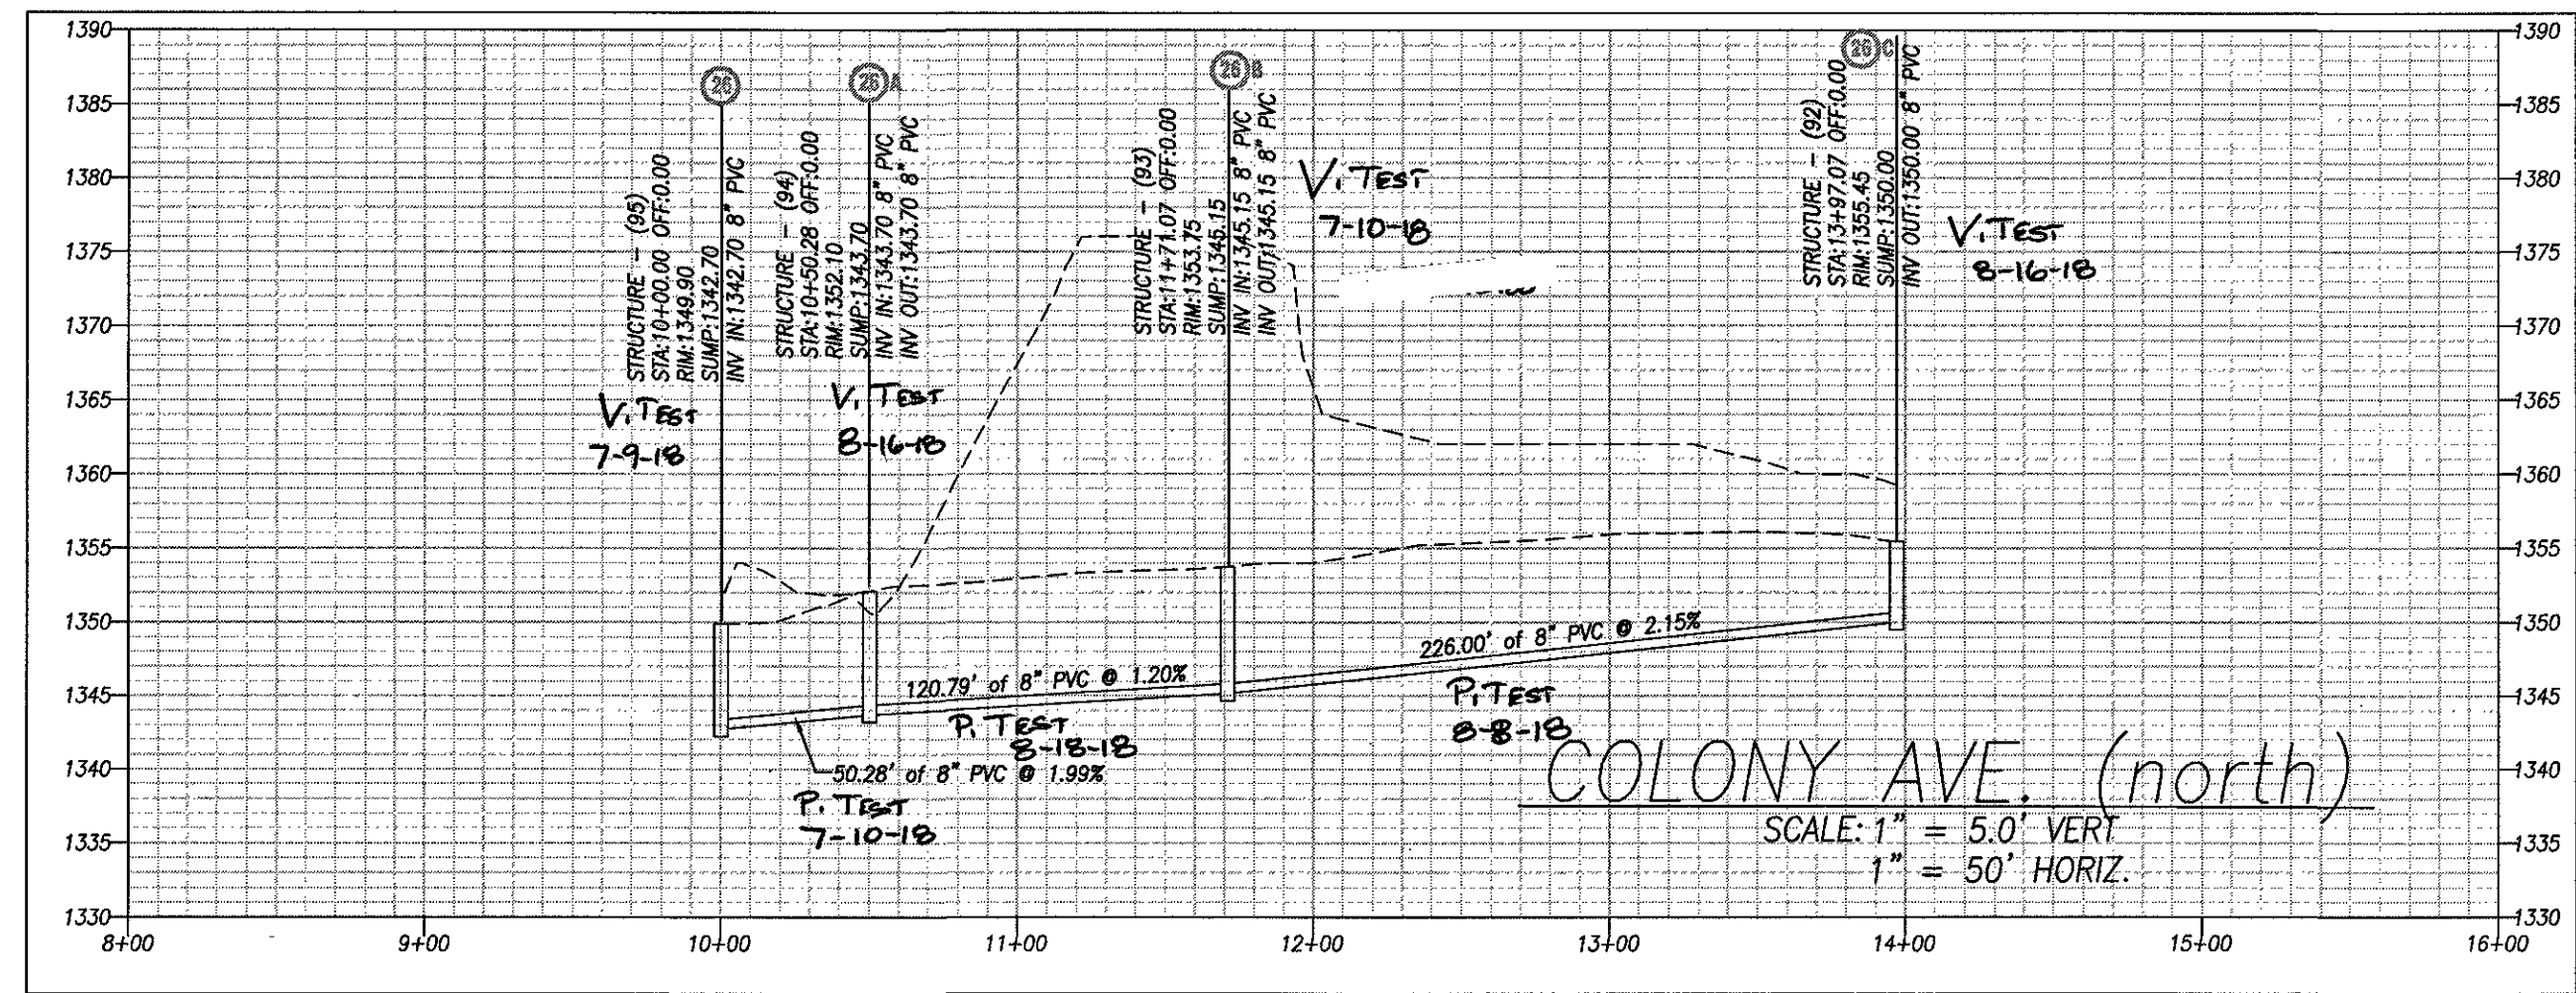


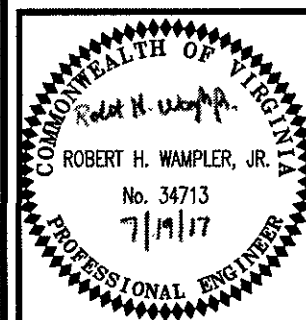

DATE 5/8/08
PROJECT 03083
DESIGNED RHW
DRAWN MSWJ
CHECKED RHW

ENGINEERING
CONCEPTS, INC.
"Creating Success"
4401 WILSON STREET
DALEVILLE, GA 30156
PHONE 404.272.1285

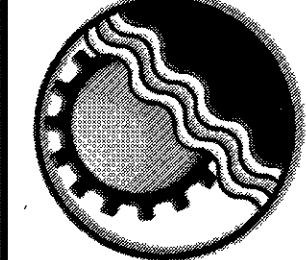

PROJECT FRANK AND WALDRON
DALEVILLE TOWN CENTER

DRAWING SANITARY SEWER PROFILES

SHEET
C-40