



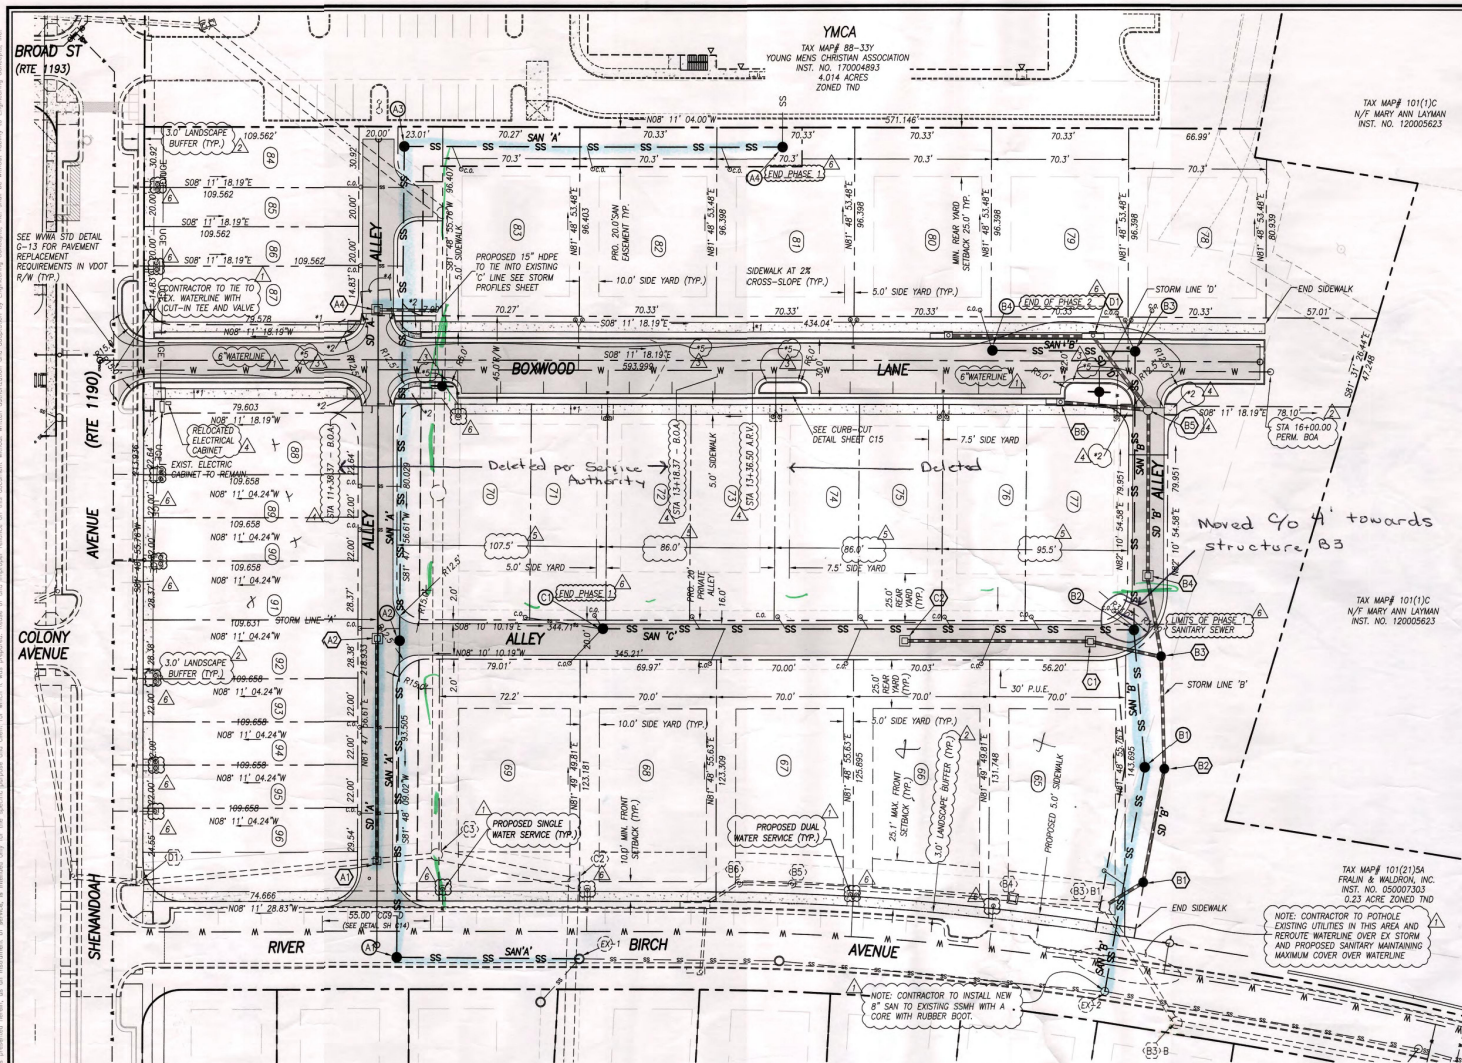

EX-3 RM 1340.27  
 INV IN 1327.11 8" PVC  
 INV OUT 1327.07 8" PVC  
 SHEL 1327.77  
  
 EX-4 RM 1341.39  
 INV IN 1329.66 8" PVC  
 INV OUT 1329.62 8" PVC  
 SHEL 1330.65  
  
 EX-5 RM 1341.44  
 INV IN 1330.02 8" PVC  
 INV OUT 1329.94 8" PVC  
 SHEL 1330.74  
  
 EX-6 RM 1342.30  
 INV IN 1331.7 8" PVC  
 SHEL 1332.55


| LOT | c.o. TOP | MIN. INVERT | PLANNED MIN FFE |
|-----|----------|-------------|-----------------|
| 65  | 1315.00  | 1303.53     | 1315.00         |
| 66  | 1314.50  | 1309.46     | 1318.37         |
| 67  | 1318.50  | 1313.13     | 1321.51         |
| 68  | 1322.90  | 1316.79     | 1325.31         |
| 69  | 1324.90  | 1321.19     | 1328.70         |
| 70  | 1327.50  | 1320.69     | 1338.48         |
| 71  | 1325.20  | 1319.85     | 1336.48         |
| 72  | 1322.70  | 1317.28     | 1333.19         |
| 73  | 1320.30  | 1314.99     | 1332.52         |
| 74  | 1318.10  | 1312.72     | 1330.01         |
| 75  | 1315.80  | 1313.38     | 1329.34         |
| 76  | 1313.90  | 1308.03     | 1326.80         |
| 77  | 1313.90  | 1305.37     | 1326.80         |
| 78  | 1327.50  | 1319.38     | 1329.72         |
| 79  | 1327.80  | 1319.37     | 1329.34         |
| 80  | 1328.0   | 1319.64     | 1330.80         |
| 81  | 1333.00  | 1327.83     | 1333.30         |
| 82  | 1336.50  | 1327.14     | 1336.27         |
| 83  | 1337.80  | 1326.46     | 1338.97         |
| 84  | 1345.40  | 1326.10     | 1349.00         |
| 85  | 1345.03  | 1326.10     | 1349.00         |
| 86  | 1344.71  | 1325.69     | 1348.33         |
| 87  | 1344.50  | 1325.69     | 1348.33         |
| 88  | 1342.40  | 1324.54     | 1346.67         |
| 89  | 1342.10  | 1324.31     | 1346.00         |
| 90  | 1341.80  | 1324.31     | 1345.33         |
| 91  | 1341.50  | 1323.80     | 1344.67         |
| 92  | 1341.10  | 1323.80     | 1343.33         |
| 93  | 1340.80  | 1323.21     | 1343.15         |
| 94  | 1340.50  | 1323.21     | 1342.67         |
| 95  | 1340.20  | 1322.77     | 1342.67         |
| 96  | 1339.80  | 1322.77     | 1342.00         |

- NOTES:
1. SIDEWALKS AND BUFFER STRIP CROSS-SLOPES TO BE 2% TYPICAL.
  2. TYPICAL SIDEWALK INTERSECTION RAMP TO BE VDOT STD CG-12.
  3. MAINTENANCE OF SIDEWALKS PARTIALLY WITHIN VDOT RIGHT-OF-WAY TO BE THE RESPONSIBILITY OF THE DEVELOPER.
  4. PROPOSED 15'x15' PUBLIC DRAINAGE EASEMENT.
  5. CURB TO BE PAINTED YELLOW AND MARKED WITH SIGNAGE STATING "NO PARKING - FIRE LANE".
  6. FIELD VERIFY EXISTING UNDERGROUND UTILITIES FOR CONFLICT WITH PROPOSED WATER METER LOCATIONS. ADJUST METER LOCATION WITH VDOT INSPECTOR.

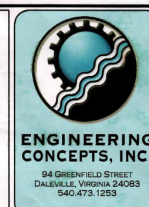

| No. | Description             | Date     |
|-----|-------------------------|----------|
| 1   | WWW 7/2/19 COMMENTS     | 07/23/19 |
| 2   | VDOT COMMENTS 08/28/19  | 09/03/19 |
| 3   | FIRE/EMS ACCESS COMMENT | 10/11/19 |
| 4   | VDOT COMMENTS 12/13/19  | 12/16/19 |
| 5   | SHIFT DUPLEX LOT LINES  | 02/27/20 |
| 6   | WWW COMMENTS            | 3/30/20  |

**DALEVILLE TOWN CENTER PH 3**  
**BOTETOURT CO. - VIRGINIA**  
**BOXWOOD LANE**  
**SITE DIMENSIONAL PLAN**

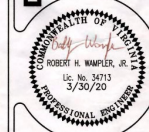

0 30 60  
 GRAPHIC SCALE  
 PROJECT: 18038

**C04**