

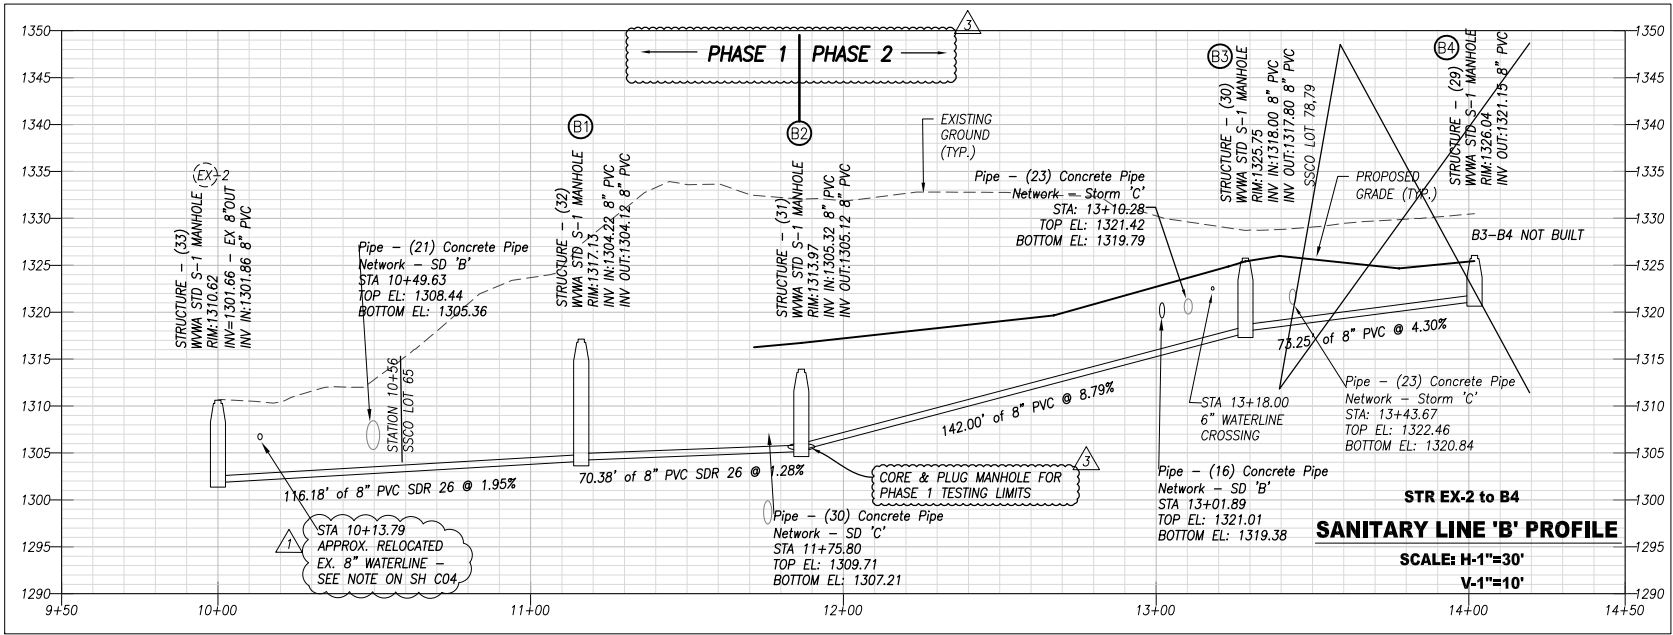


This document, together with the concepts and designs presented herein, as an instrument of service, is intended only for the specific purpose and client for which it was prepared. Reuse of and improper reliance on this document without written authorization and adaptation by Engineering Concepts, Inc. shall be without liability to Engineering Concepts, Inc.

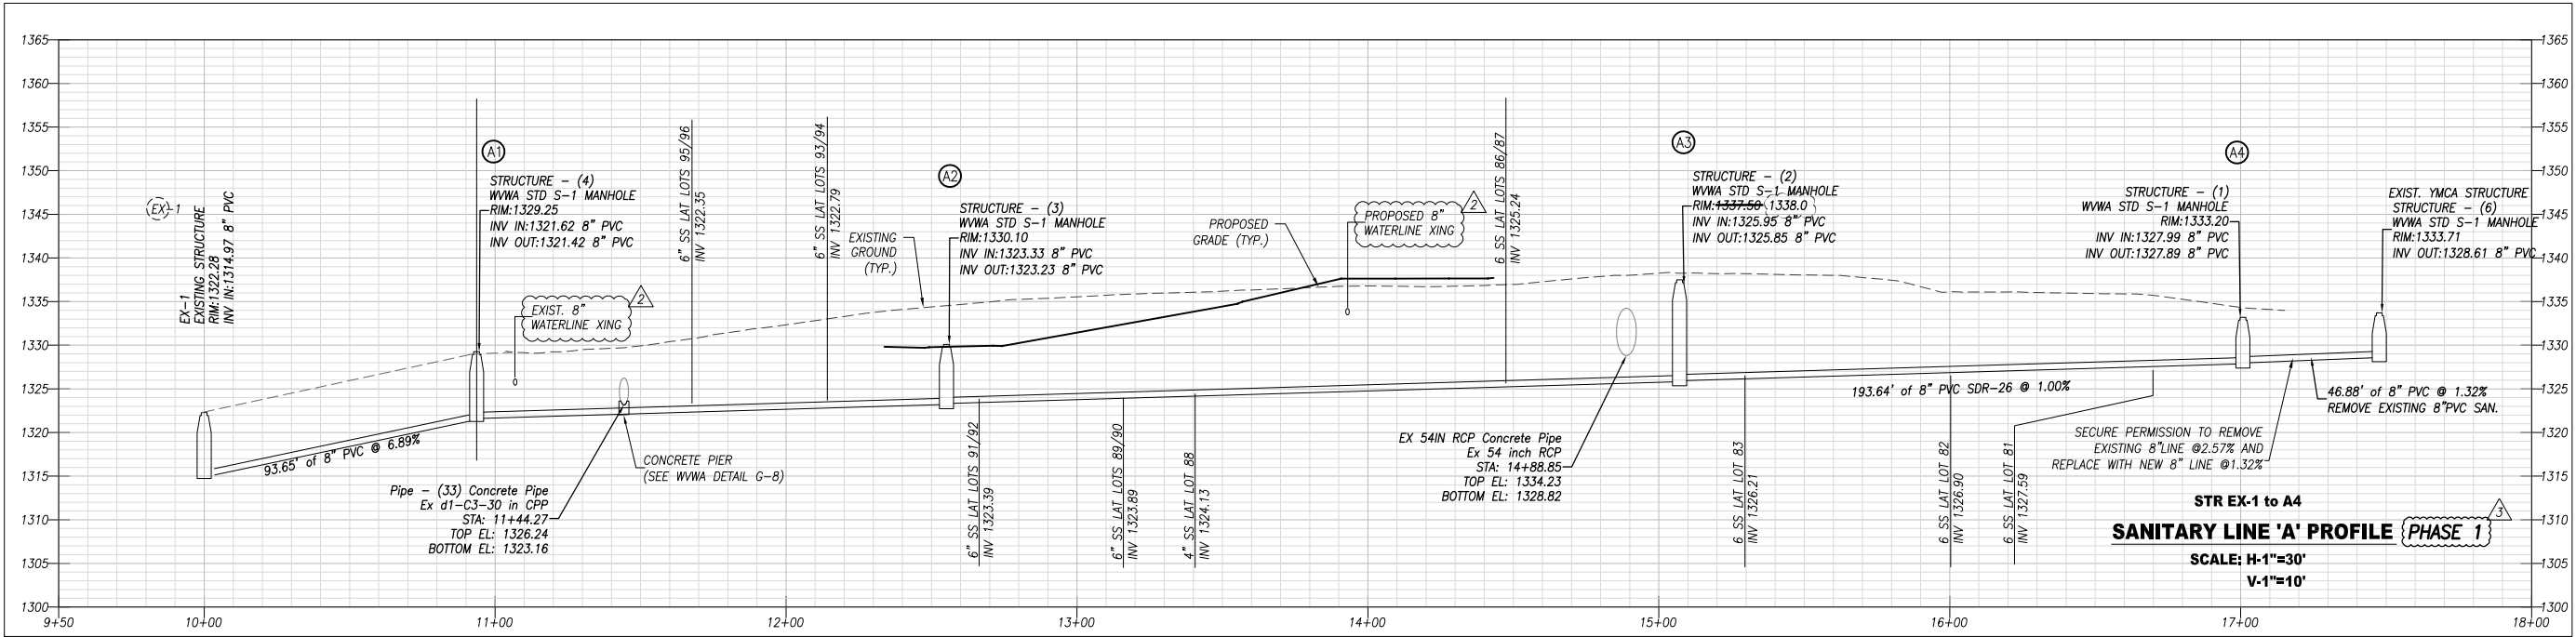

NOTE: ALL SANITARY PIPES TO BE PVC
SDR-35 UNLESS OTHERWISE NOTED
ON PROFILES

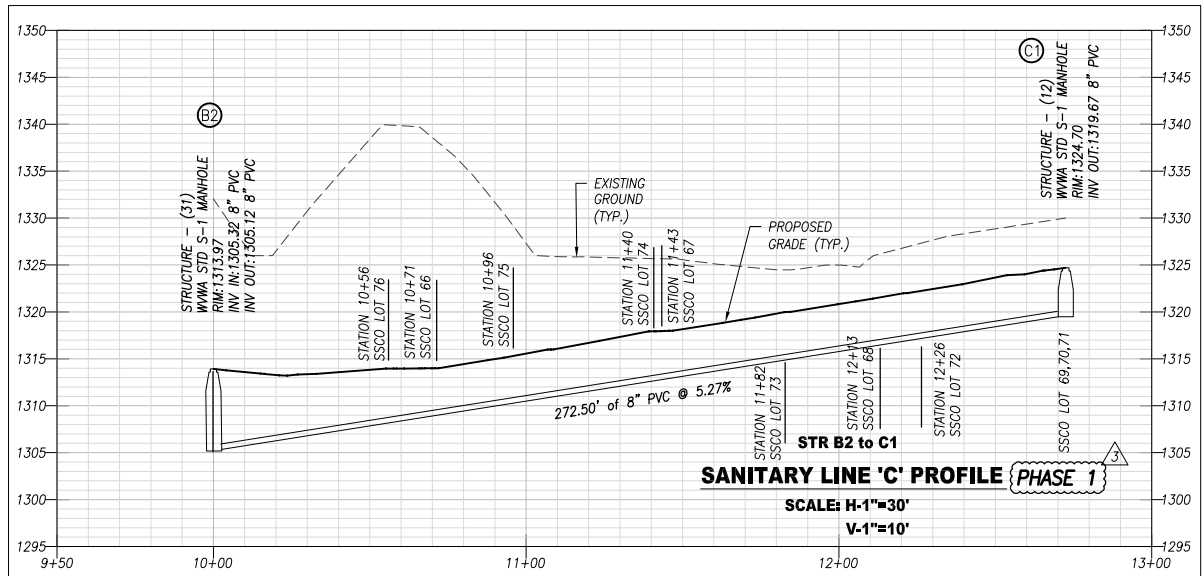

Structure As-Built Information Per Plan Coordinates				Invert In Measure Down	Invert In Elevation	Invert Out Measure Down	Invert Out Elevation	Cleanout A Dep	Cleanout A Elevation	Cleanout B Depth	Cleanout B Elevation	Pipe Length	Slope
Structure	Rim Plan Coords												
A1	1329.19			8.25	1320.94	8.3	1320.89					160.71	1.0%
A2	1329.93			7.3	1322.63	7.4	1322.53					252.63	1.0%
A3	1337.13			11.86	1325.27	12	1325.13					194.95	1.2%
A4	1332.95			5.29	1327.66	5.411	1327.539						
B0	1310.152			8.75	1301.402								
B1	1316.37			12.5	1303.87	12.58	1303.79					117.37	2.0%
B2	1313.31			8.57	1304.74	8.92	1304.39	8.67	1304.64			70.25	0.7%
B3	1324.9			8.05	1316.85	8.11	1316.79	7.9	1317	7.8	1317.1	141.15	8.5%
B4	Not Installed 9/21/2020												
C1	1324.78			5.8	1318.98	5.9	1318.88	5.8	1318.98	5.68	1319.1	274.95	5.31%
Structure As-Built Information State Plane Coordinates				Invert In Measure Down	Invert In Elevation	Invert Out Measure Down	Invert Out Elevation	Cleanout A Dep	Cleanout A Elevation	Cleanout B Depth	Cleanout B Elevation		
Structure	Rim State Plane Coords	Northing	Eastng										
A1	1328.8	3677566.767	11071659.53	8.25	1320.55	8.3	1320.5					160.71	1.0%
A2	1329.58	3677598.052	11071817.13	7.3	1322.28	7.4	1322.18					252.63	1.0%
A3	1336.72	3677648.181	11072064.69	11.86	1324.86	12	1324.72					194.95	1.2%
A4	1332.54	3677457.56	11072105.38	5.29	1327.25	5.411	1327.129						
B0	1309.75			8.75	1301								
B1	1315.96	3677208.189	11071835.22	12.5	1303.46	12.58	1303.38					117.37	2.0%
B2	1312.9	3677229.719	11071902.08	8.57	1304.33	8.92	1303.98	8.67	1304.23			70.25	0.7%
B3	1324.9	3677259.025	11072040.14	8.05	1316.85	8.11	1316.79	7.9	1317	7.8	1317.1	141.15	8.8%
B4	Not Installed 9/21/2020												
C1	1324.38	3677498.476	11071844.25	5.8	1318.58	5.9	1318.48	5.8	1318.58	5.68	1318.7	274.95	5.31%



**ENGINEERING
CONCEPTS, INC.**

94 GREENFIELD STREET
DALEVILLE, VIRGINIA 24063
540.473.1253


No.	Description	Date
1	WWA 7/2/19 COMMENTS	7/23/19
2	VDOT COMMENTS 12/13/19	12/16/19
3	WWA PHASING	3/30/20

DALEVILLE TOWN CENTER PH 3

BOTETOURT CO. - VIRGINIA

BOXWOOD LANE

SANITARY SEWER PROFILES

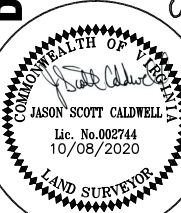

0 1 2
GRAPHIC SCALE

PROJECT: 18038

C08