



DTC
RIVER
BIRCH
ADJUSTMENTS

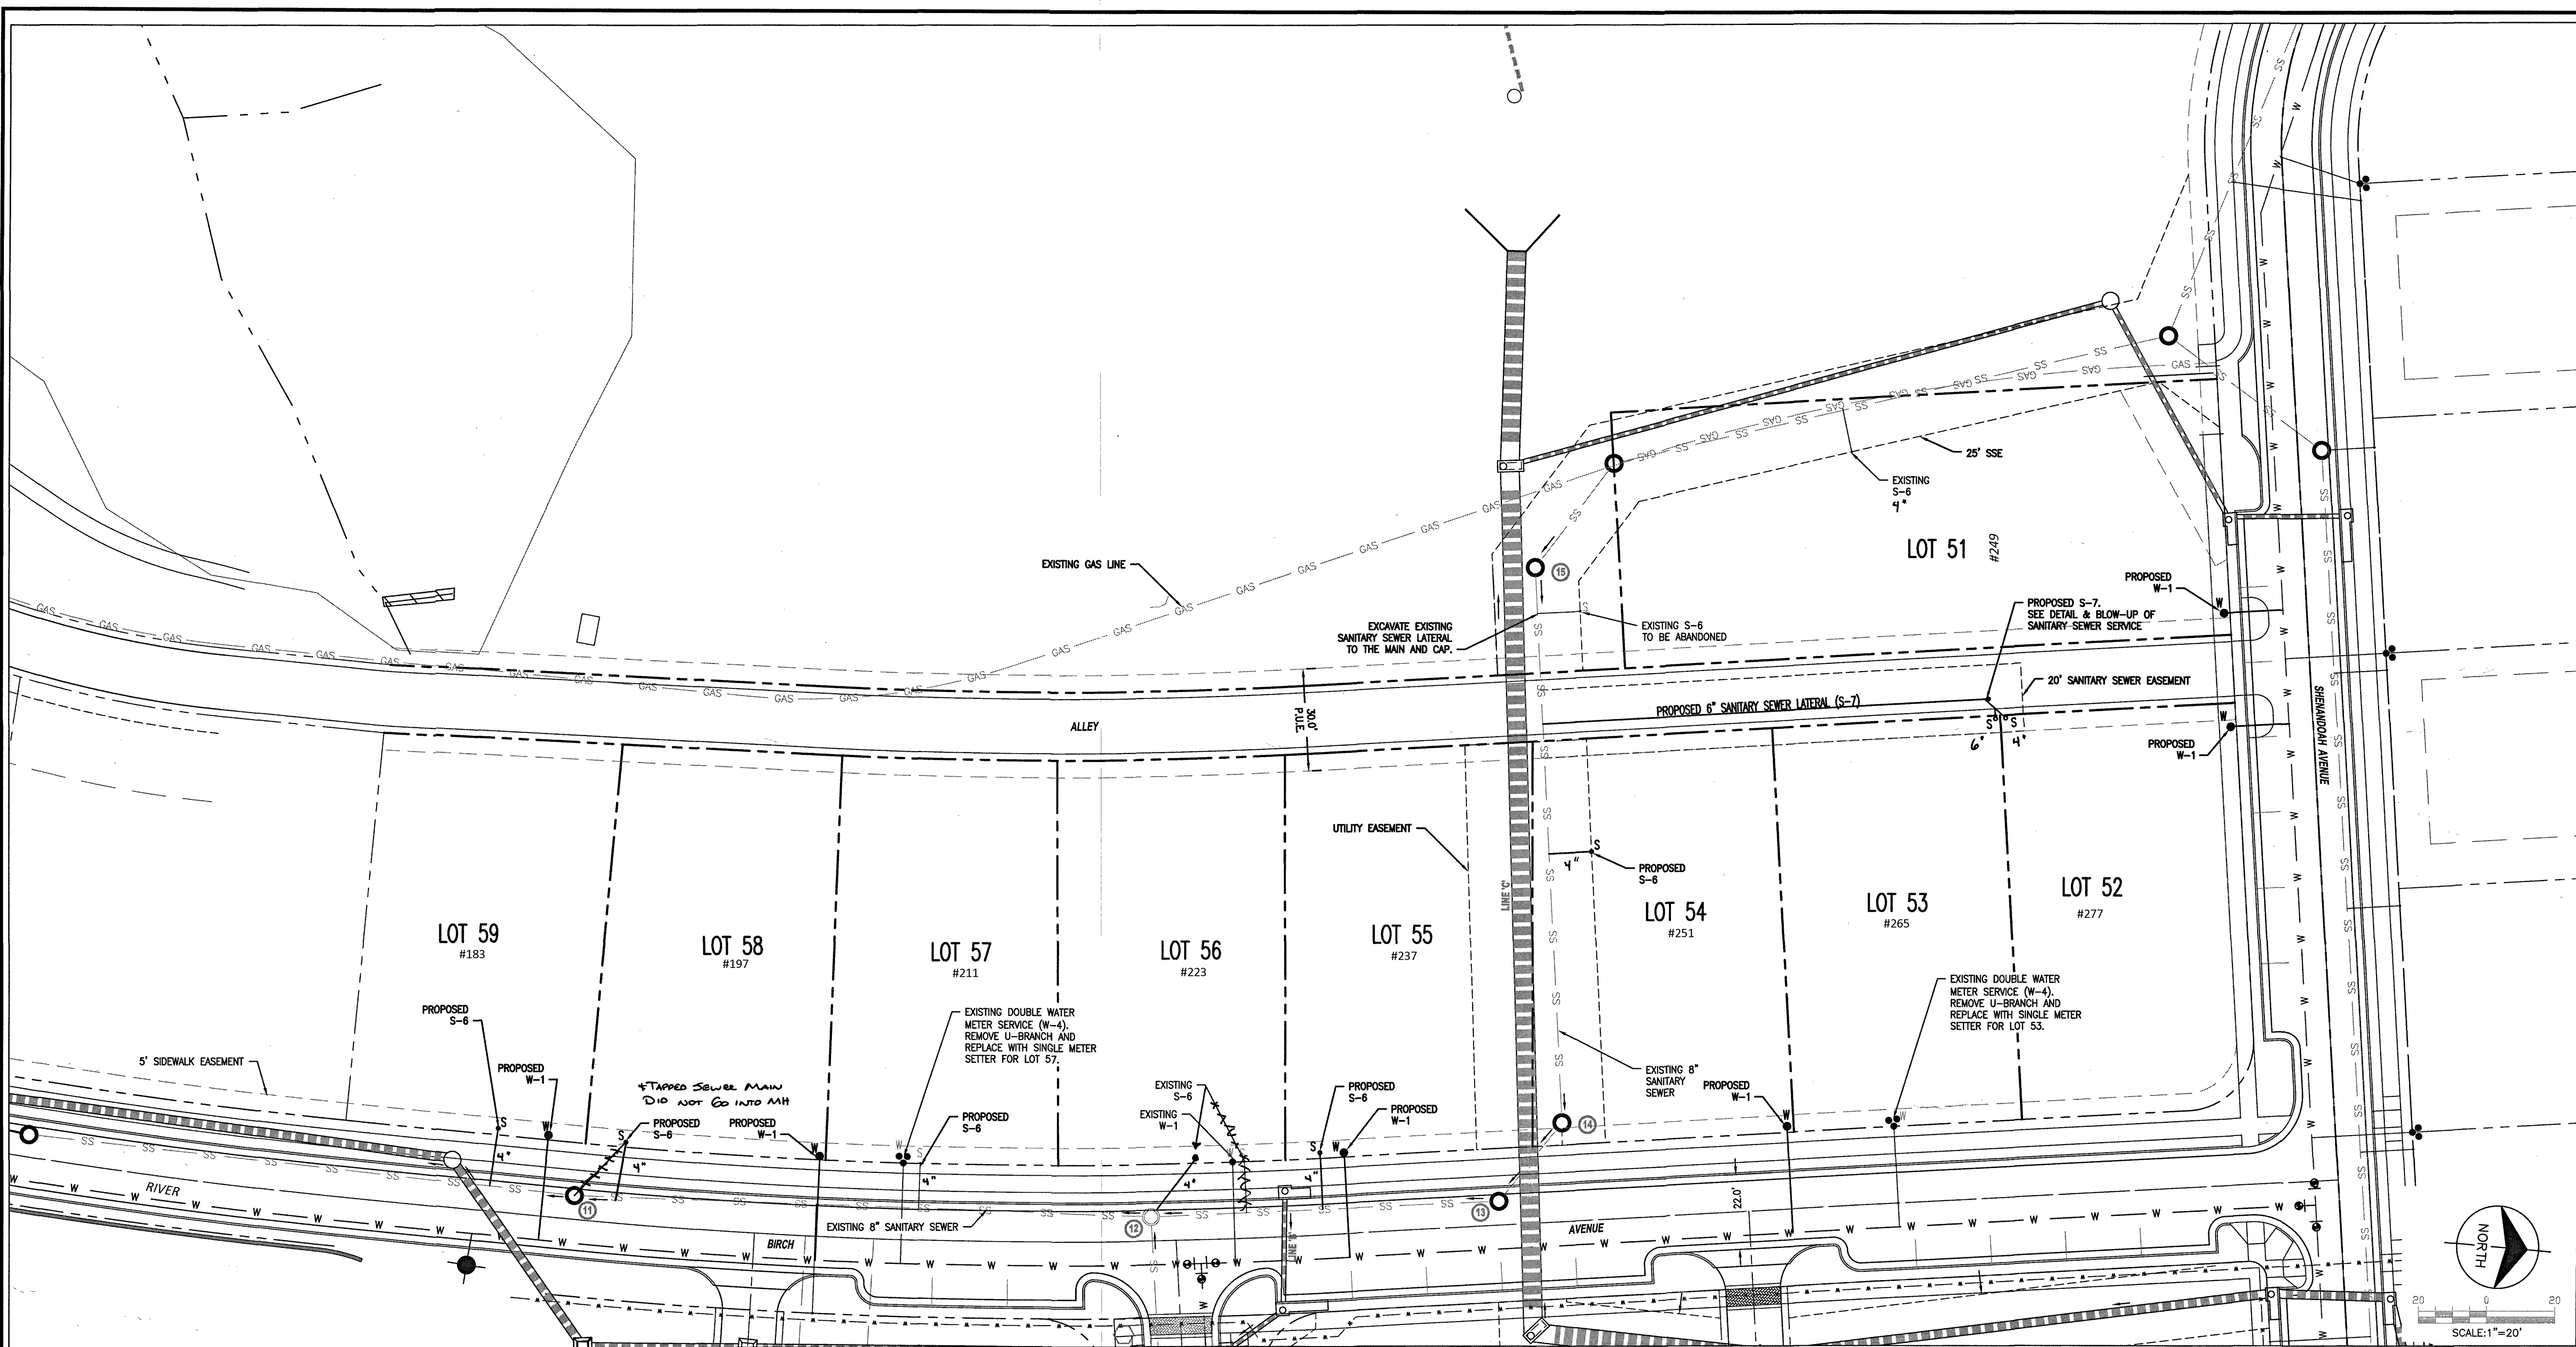

DATE	12/19/18	DESCRIPTION
PROJECT	16089	
DESIGNED	ECI	
DRAWN	ECI	
CHECKED	RHW	

ENGINEERING, INC.
"Creating Success"
54 GREENFIELD STREET
DALEVILLE, OH 43003
TEL: 614.770.1000

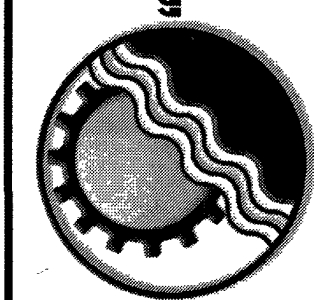

PROJECT FRALIN AND WALDRON
DALEVILLE TOWN CENTER
DRAWING RIVER BIRCH UTILITY ADJUSTMENTS

SHEET

WVWA

CHARLES CRUSH
AS-BUILT
06-05-19

