
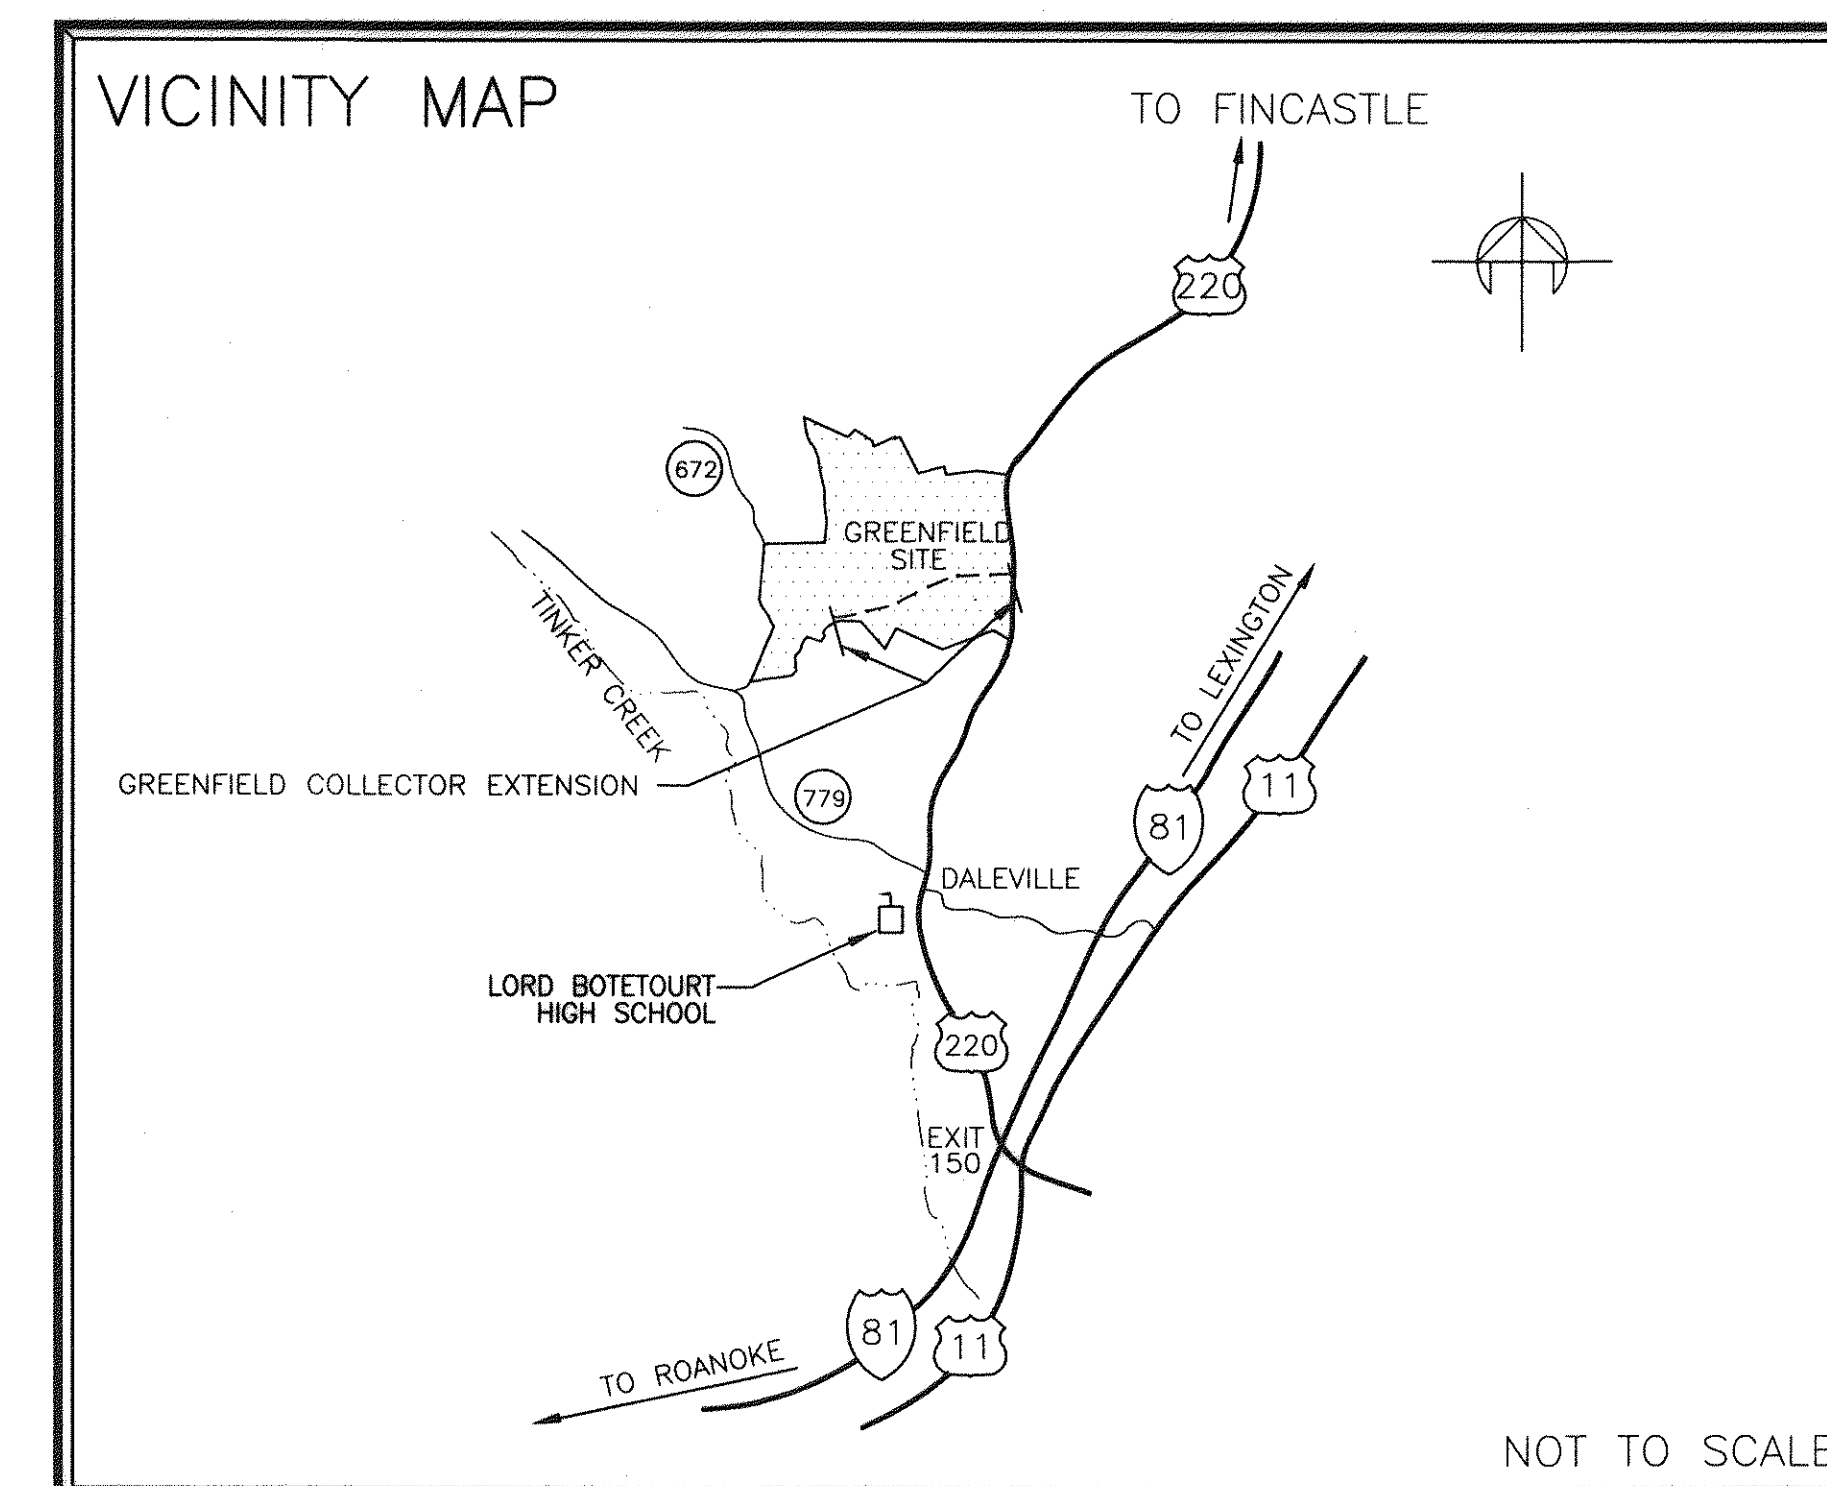


GREENFIELD COLLECTOR EXTENSION SANITARY SEWER PROJECT


BOTETOURT COUNTY
DEPARTMENT OF PUBLIC WORKS

BOTETOURT COUNTY, VIRGINIA
MAY, 1997

(45) GREENFIELD COLLECTOR EXTENSION
PROJECT NAME: Sanitary Sewer Project
DATE: May 1997
TYPE: Sanitary Sewer
LOCATION: Greenfield/LE220
TOTAL # SHEETS: 17
A/E FIRM: ECI
OF SETS: 1

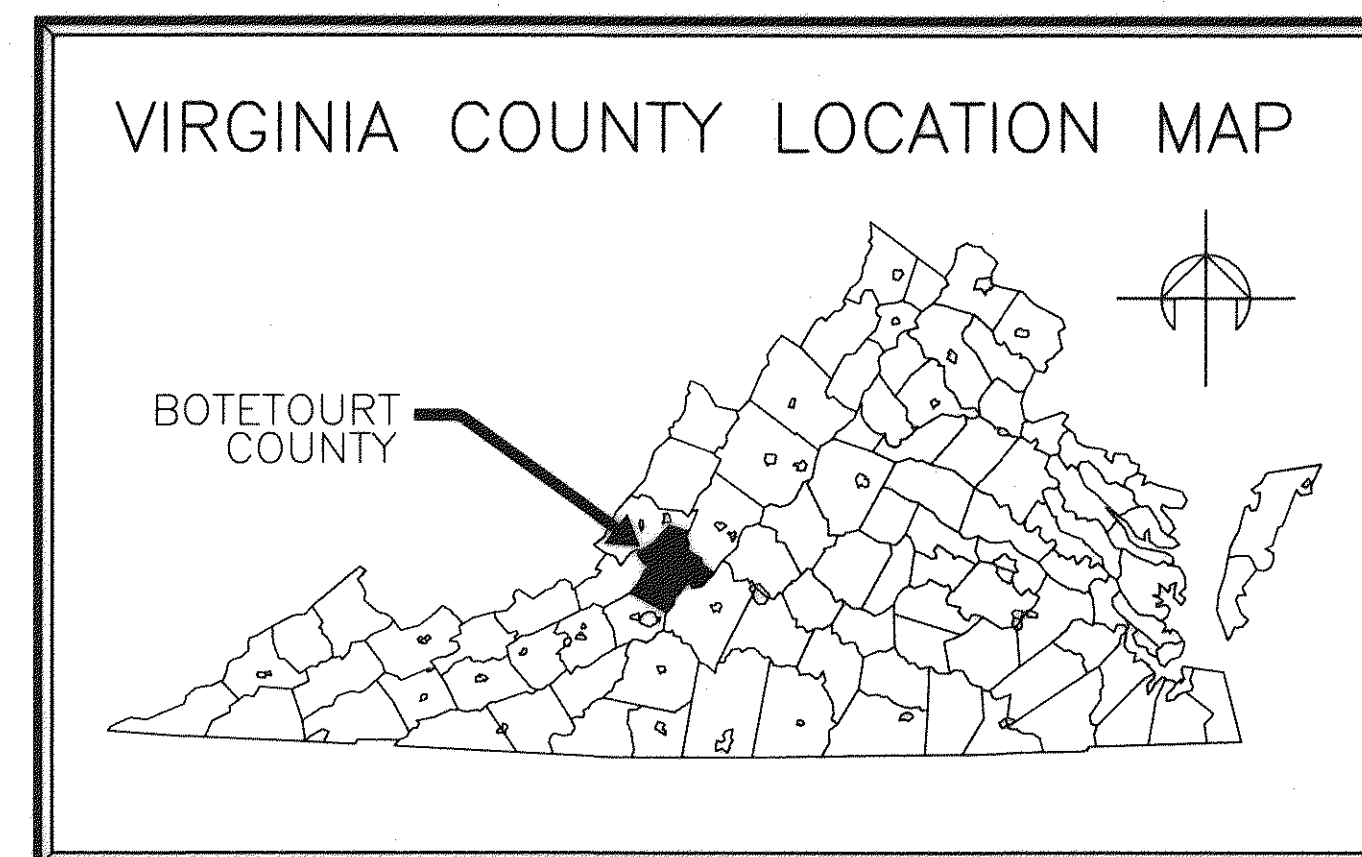

AS-BUILT

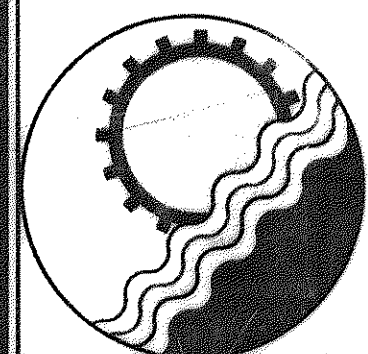

ENGINEERING CONCEPTS, INC.

20 S. ROANOKE ST., PO BOX 619
FINCASTLE, VIRGINIA 24090
540.473.1253 FAX: 540.473.1254

OWNER: BOTETOURT COUNTY

DEPARTMENT OF PUBLIC WORKS
1 WEST MAIN
FINCASTLE, VA

