




FONT DESIGNATES AS BUILT CHANGES TO DESIGN PLANS

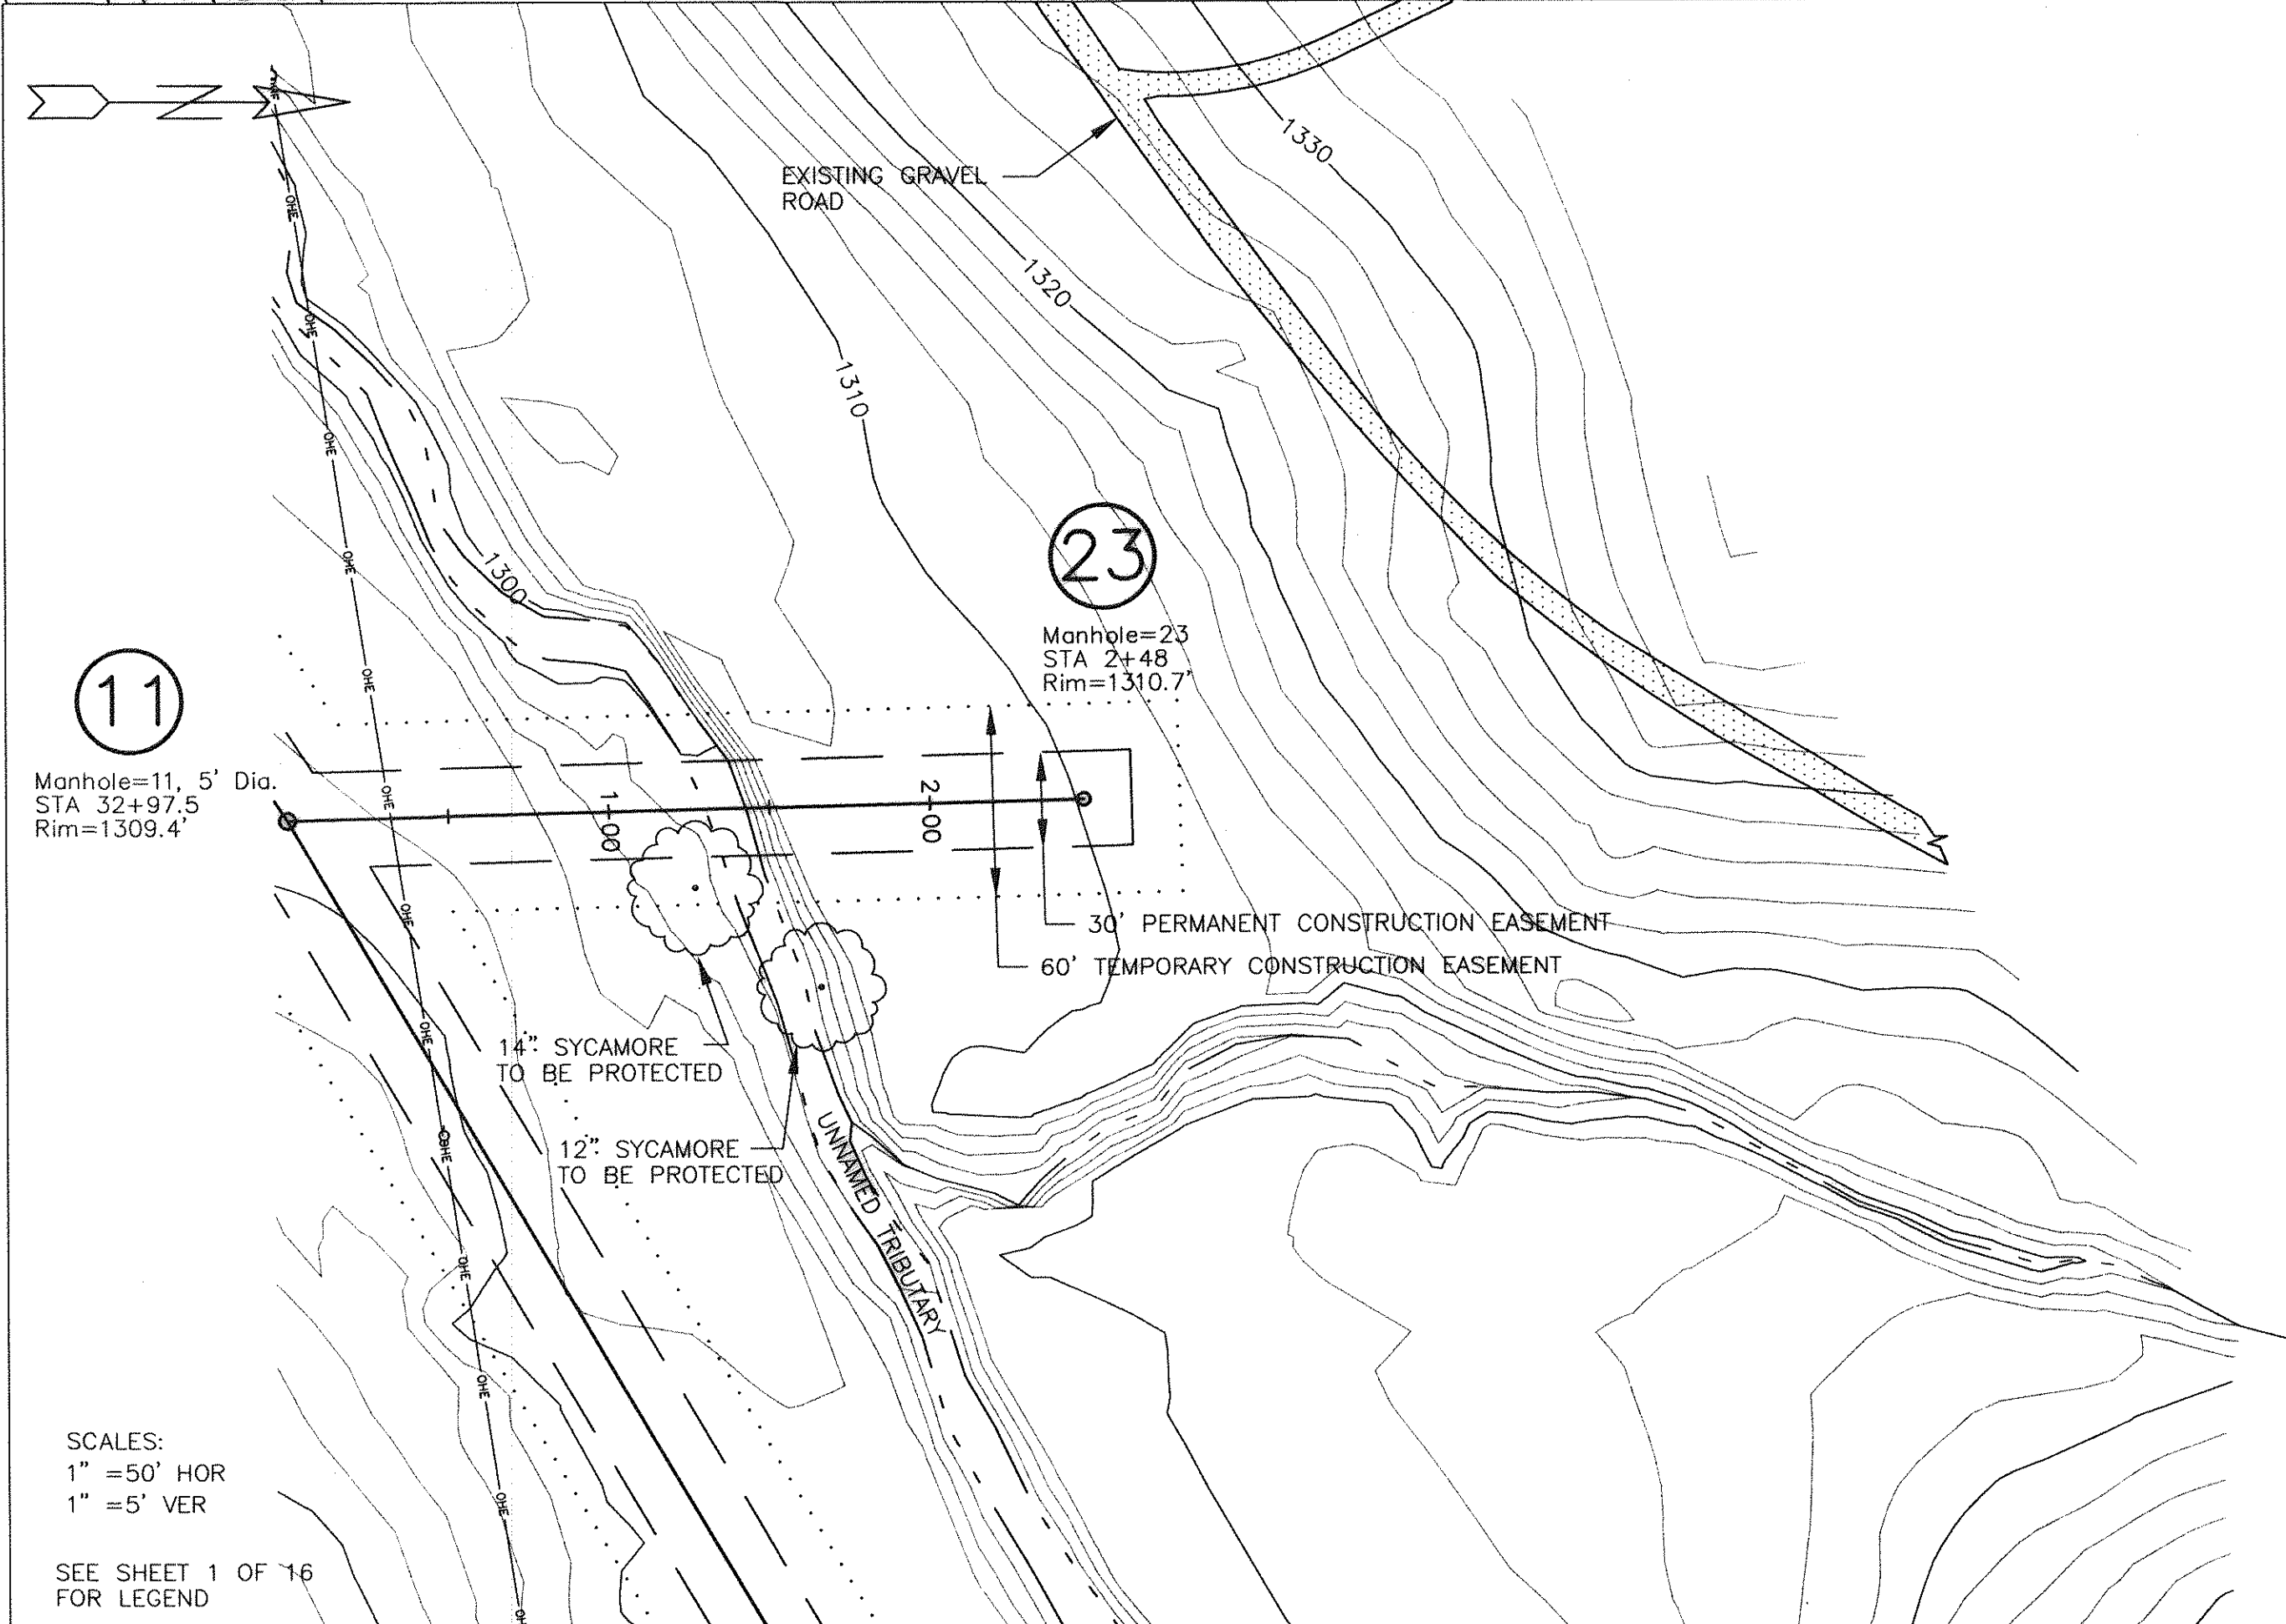