
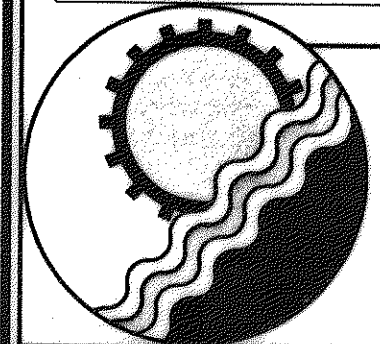
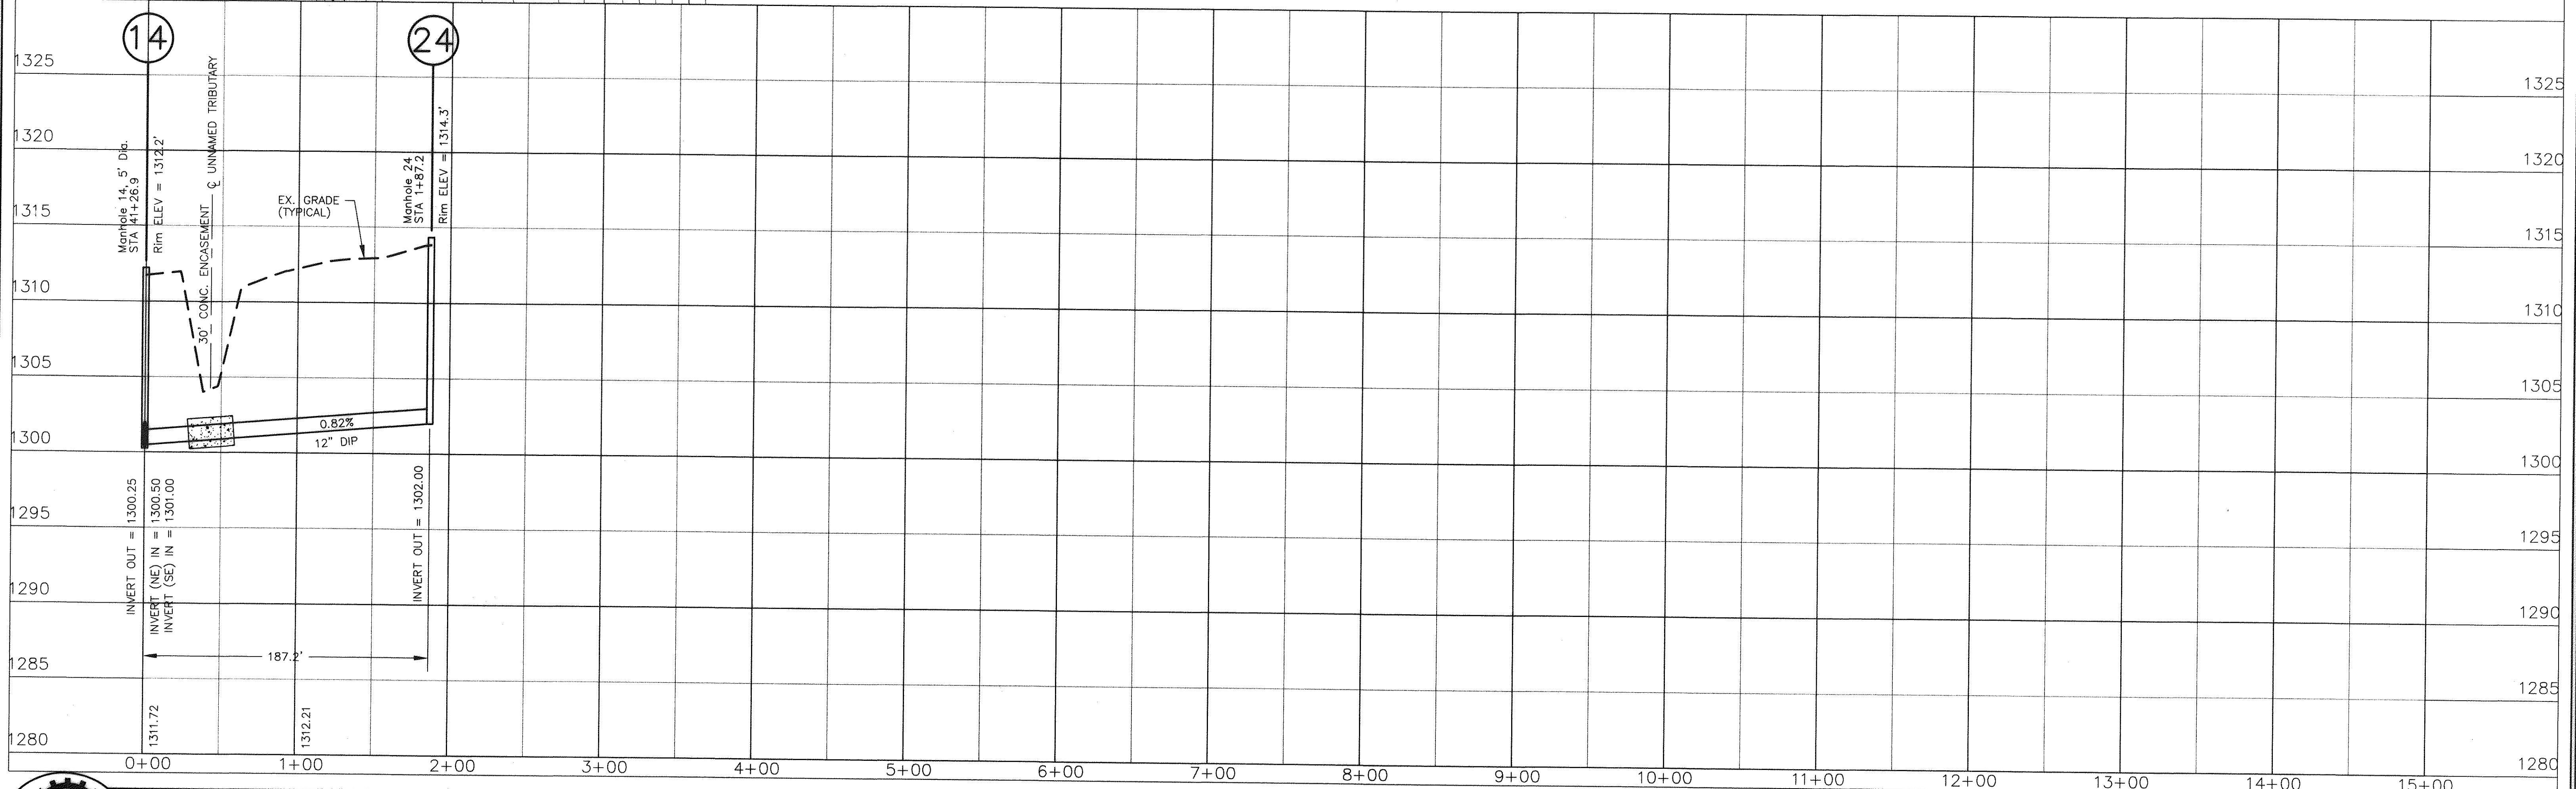


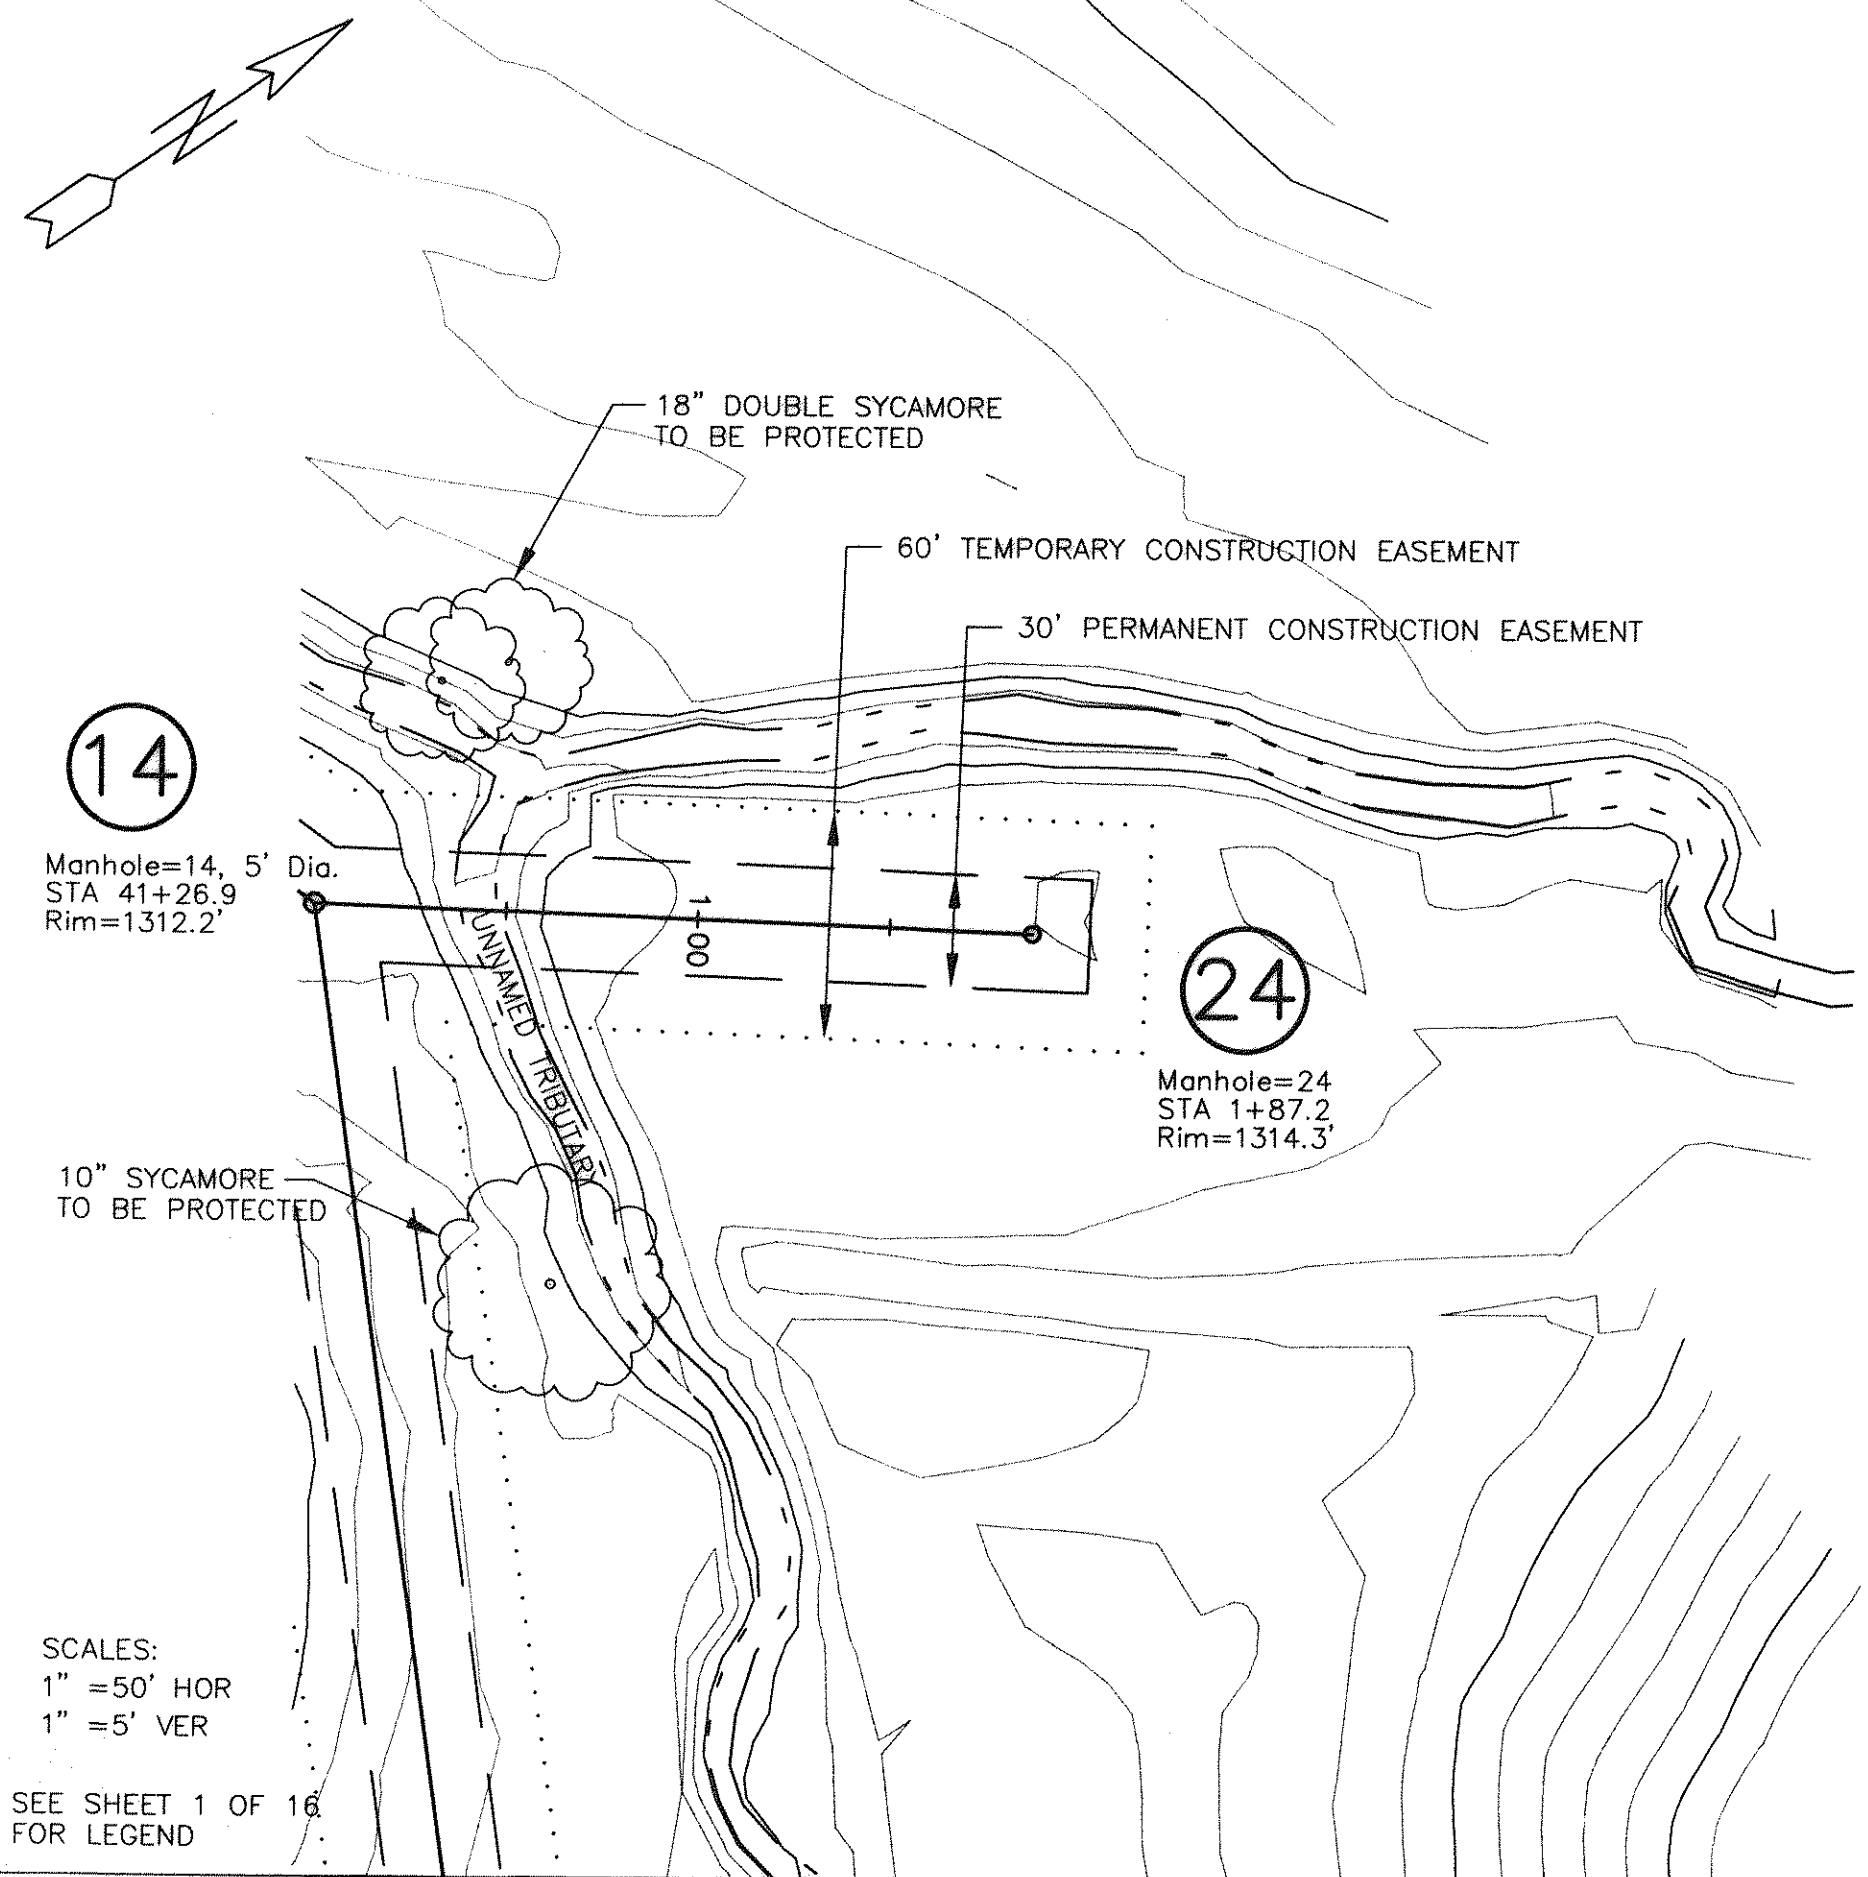

ENGINEERING CONCEPTS, INC.
20 S. ROANOKE ST., PO BOX 619
FINCASTLE, VIRGINIA 24090
540.473.1253 FAX: 540.473.1254

AS-BUILT

Drawn	JHG	GREENFIELD COLLECTOR EXTENSION SANITARY SEWER PROJECT	HOR: 1"=50' VER:1"=5'
Designed	SCG		MAY 1997
Checked	WPJ/JST	PLAN & PROFILES SUBMAIN "J" STA 0+00 - 1+87.2	PROJECT: 97024
Approved	WPJ		9 of 16