
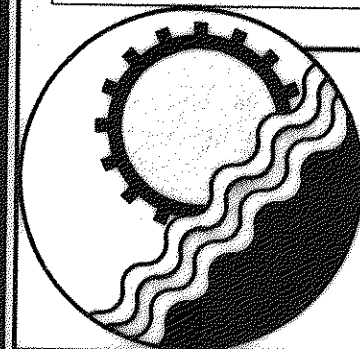
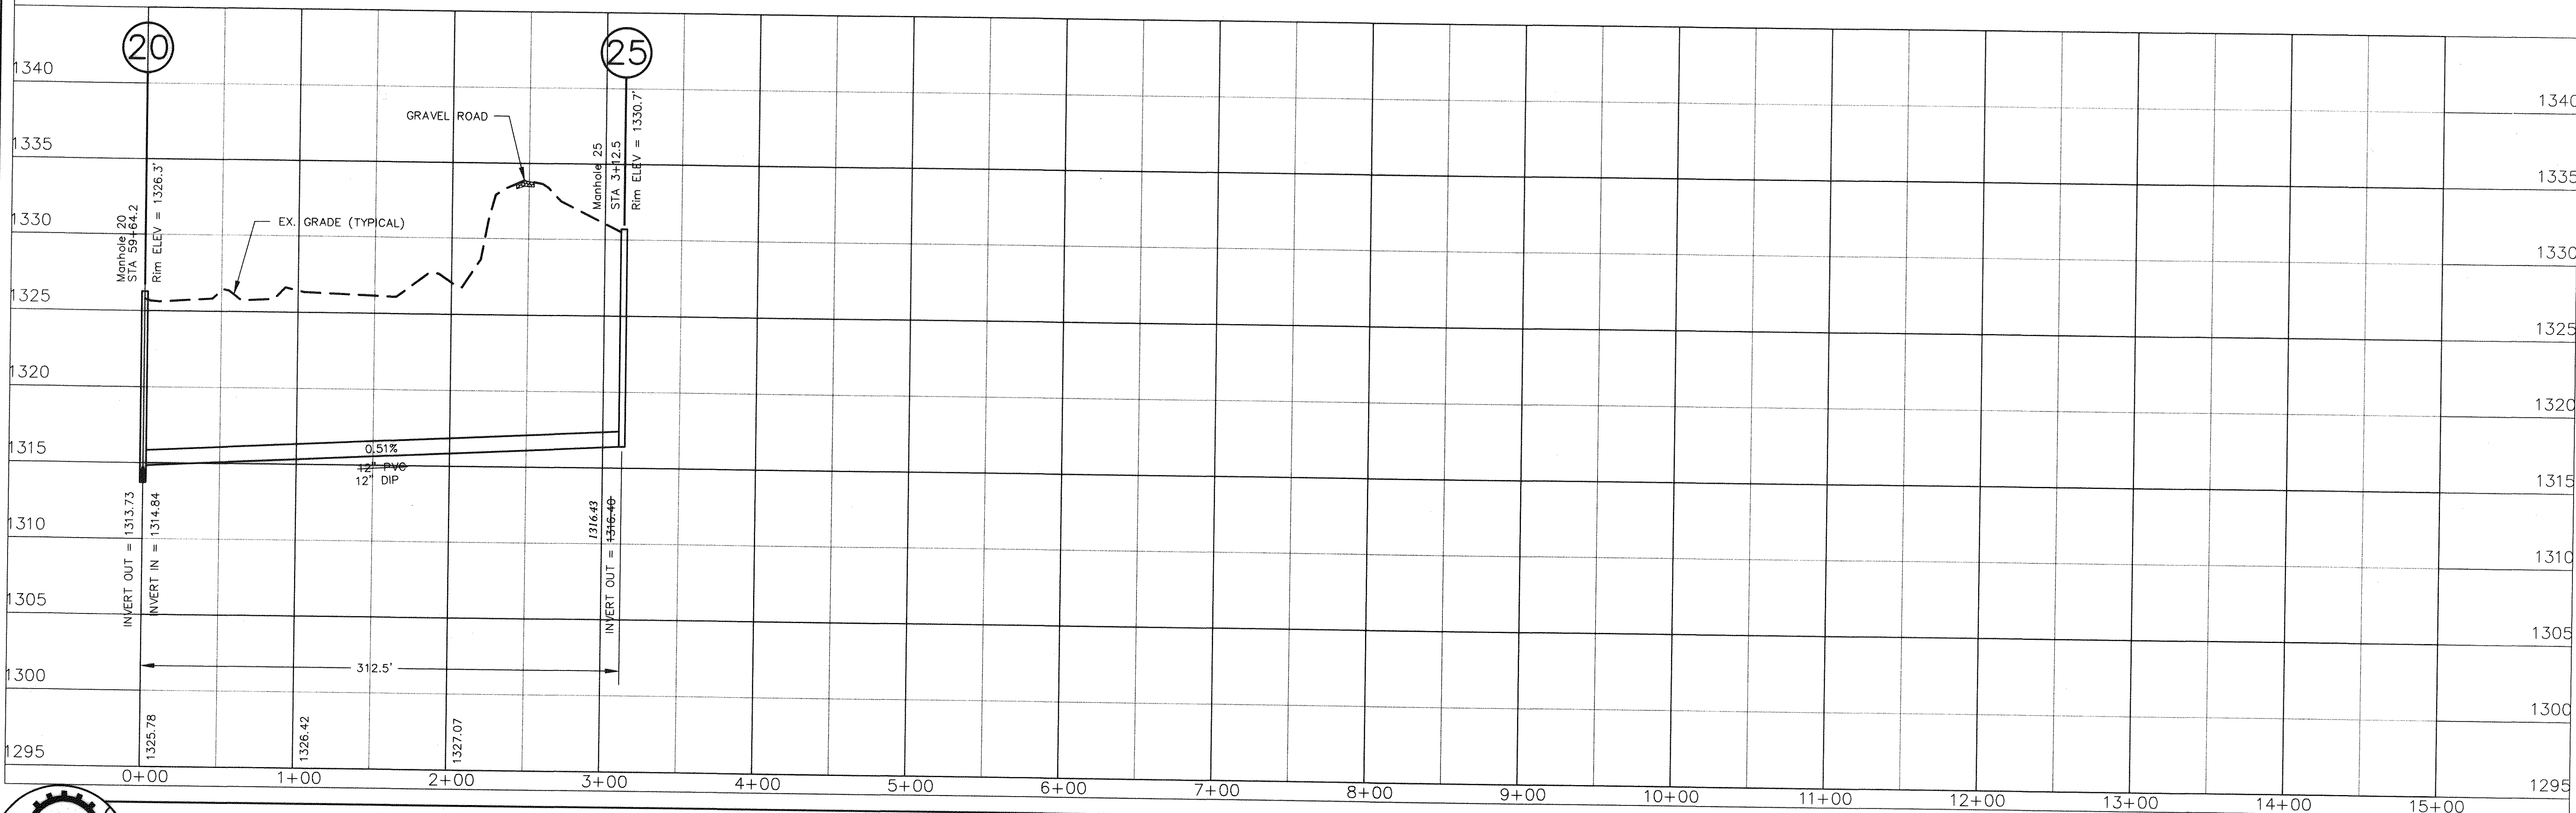
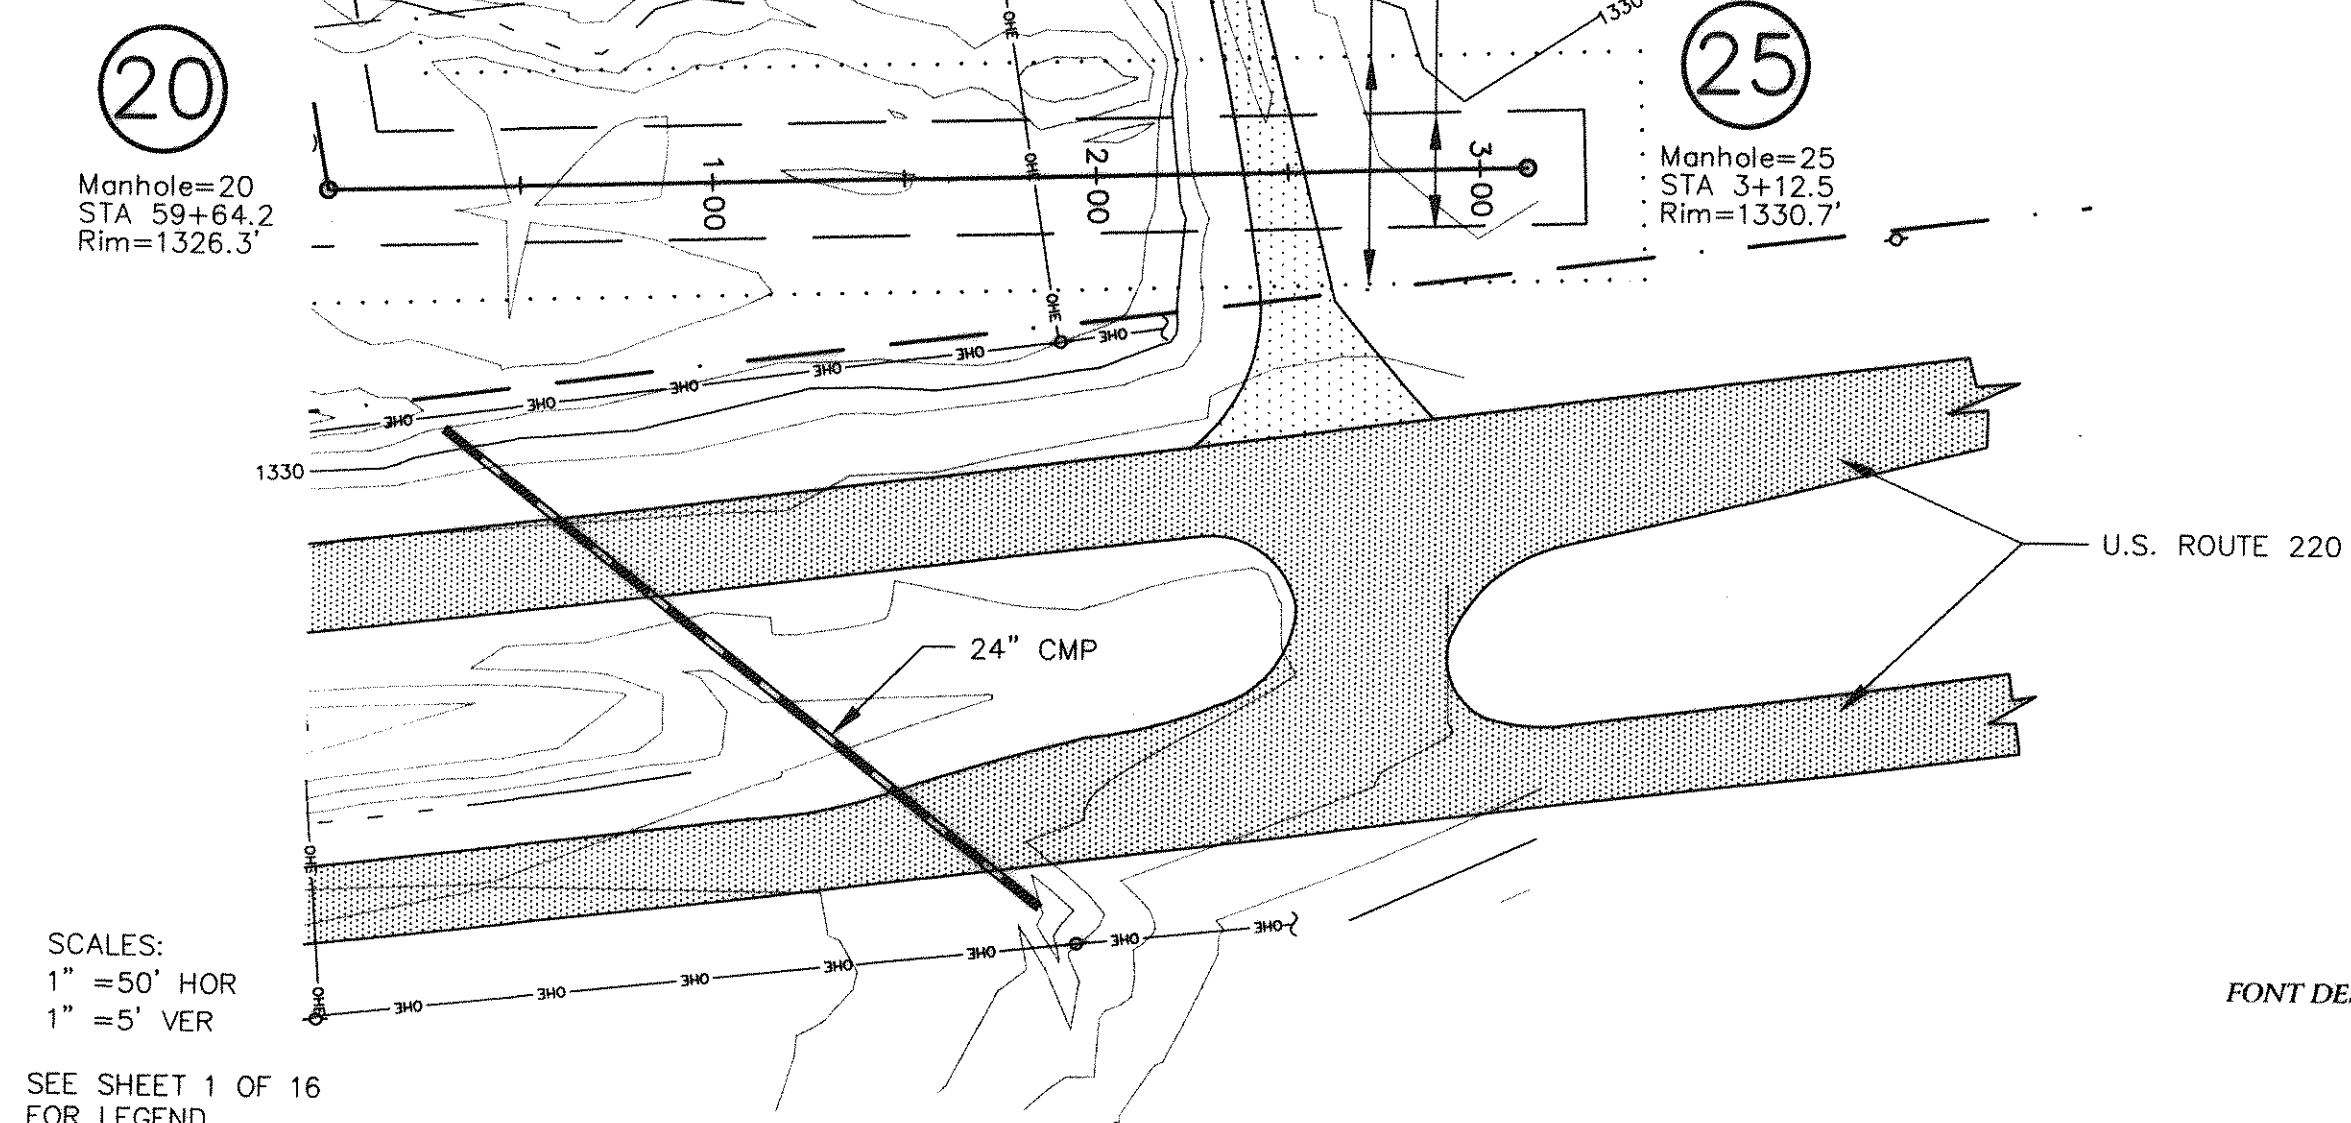


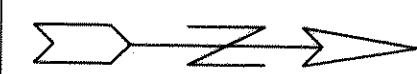

ENGINEERING CONCEPTS, INC.
20 S. ROANOKE ST., PO BOX 619
FINCASTLE, VIRGINIA 24090
540.473.1253 FAX: 540.473.1254

AS-BUILT

No.	Revision	By	Appd.	Date	Drawn
1	Revised Manhole 20 Invert Out	SCG	WPJ	6/30/97	JHG
					Designed SCG
					Checked WPJ/JST
					Approved WPJ

**GREENFIELD COLLECTOR EXTENSION
SANITARY SEWER PROJECT**

**PLAN & PROFILES
SUBMAIN "K" STA 0+00 - 3+12.5**

HOR: 1"=50' VER: 1"=5'
MAY 1997
PROJECT: 97024
10 of 16