



WATERTIGHT


STANDARD

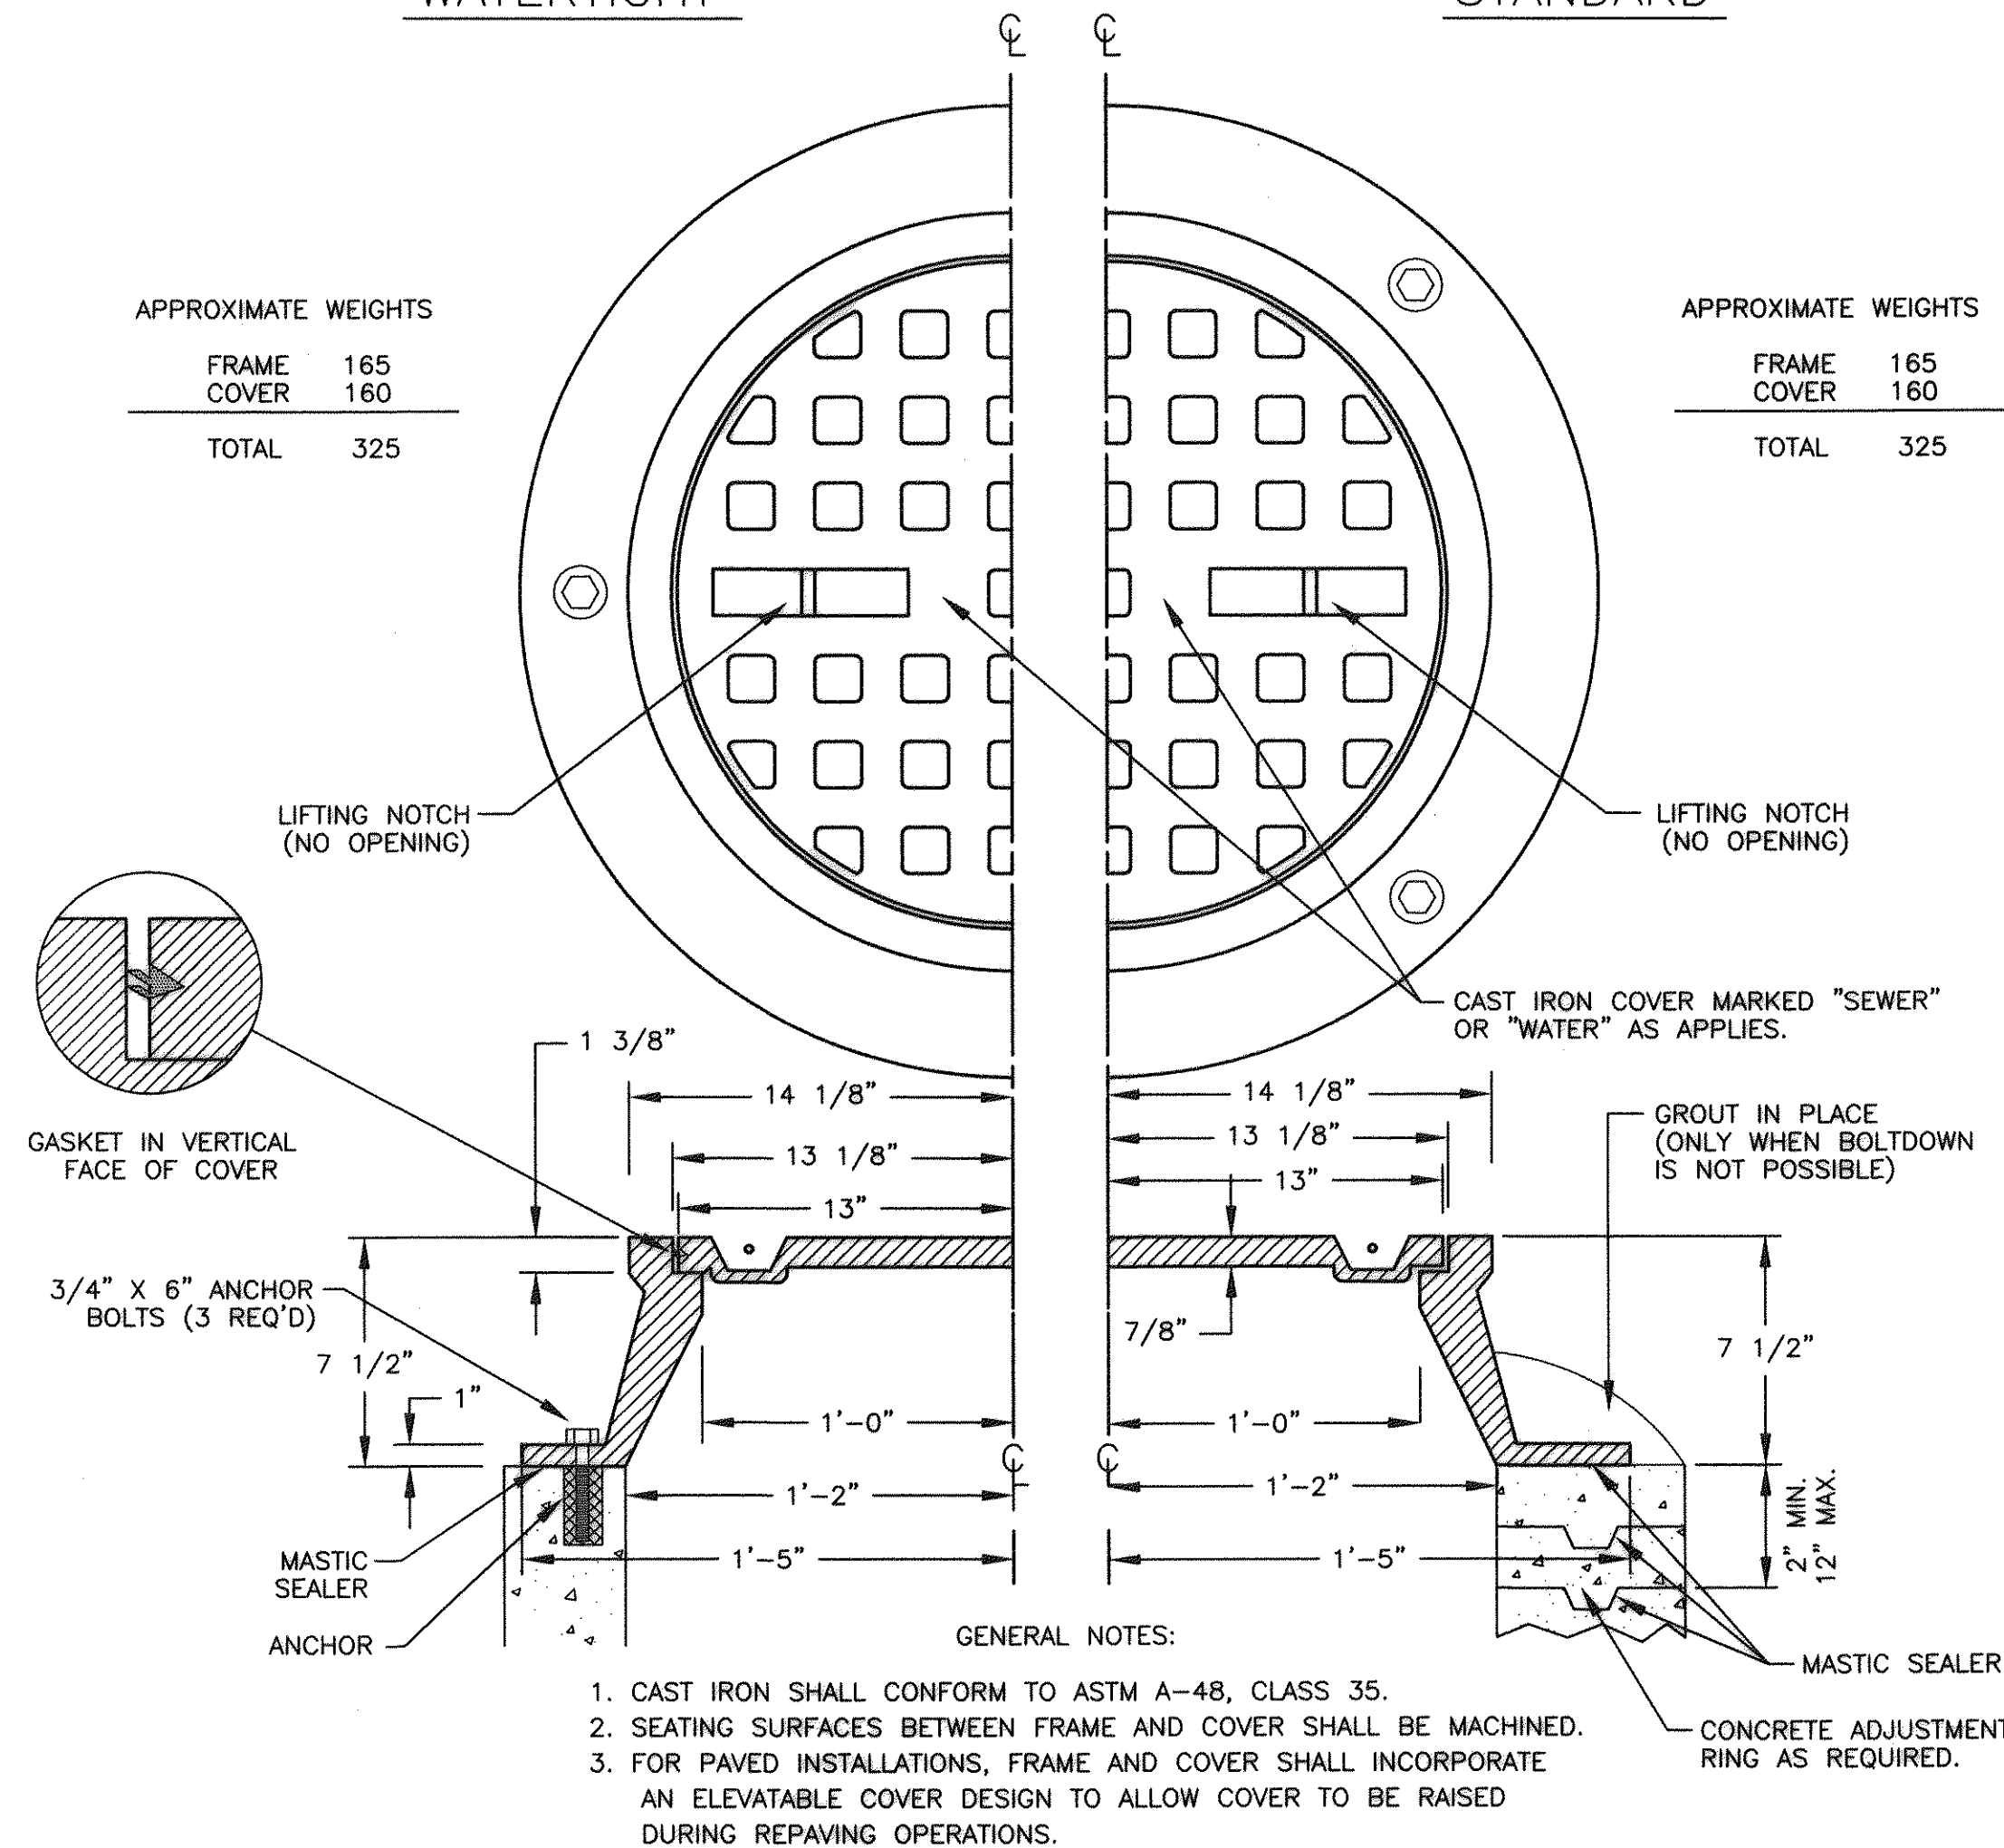


MANHOLE FRAME AND COVER

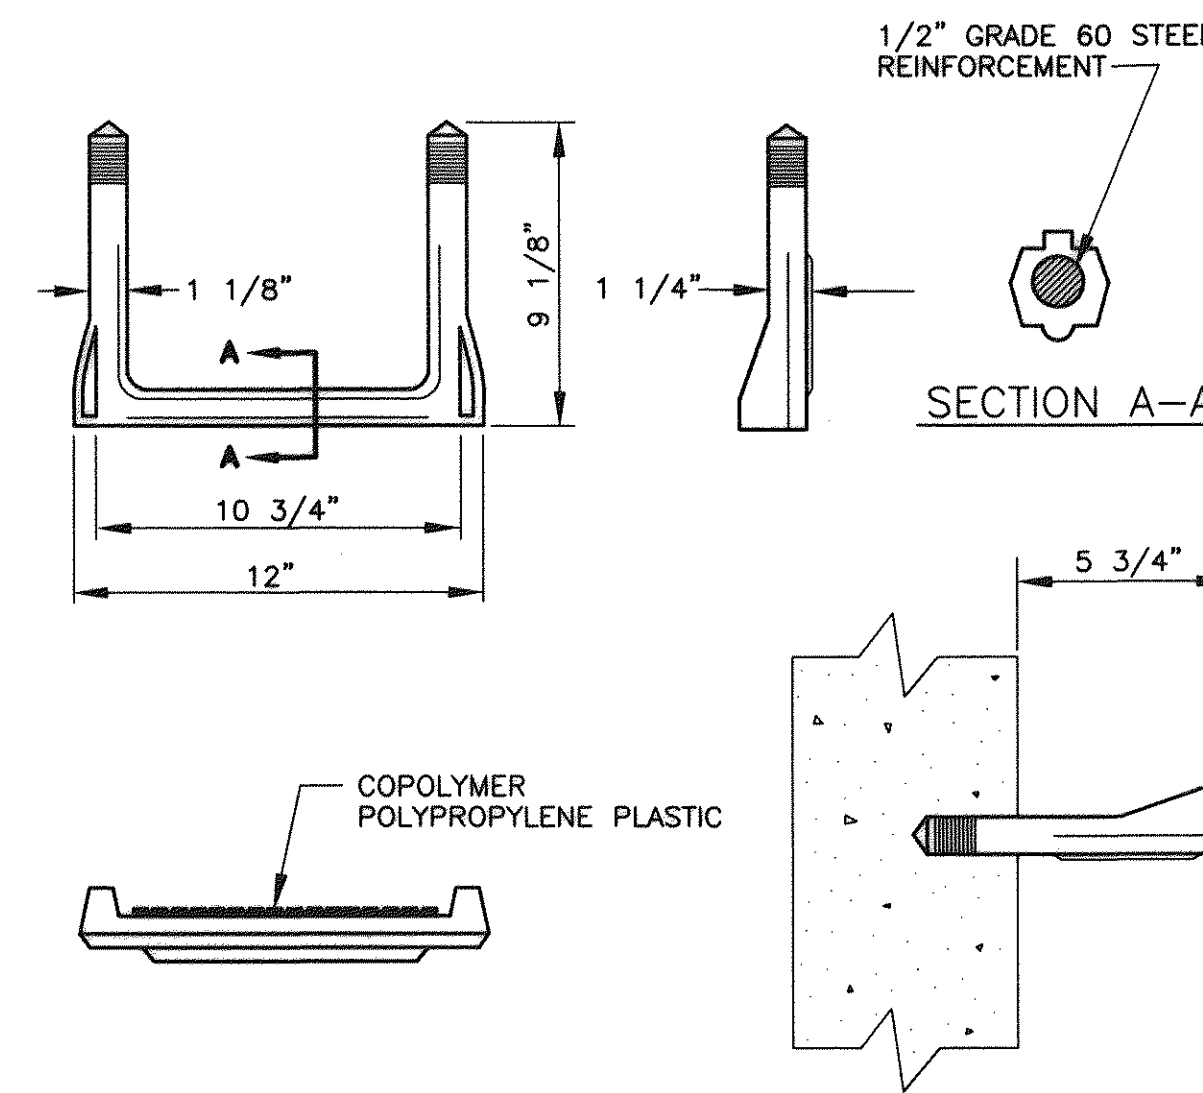


MANHOLE STEP DETAIL

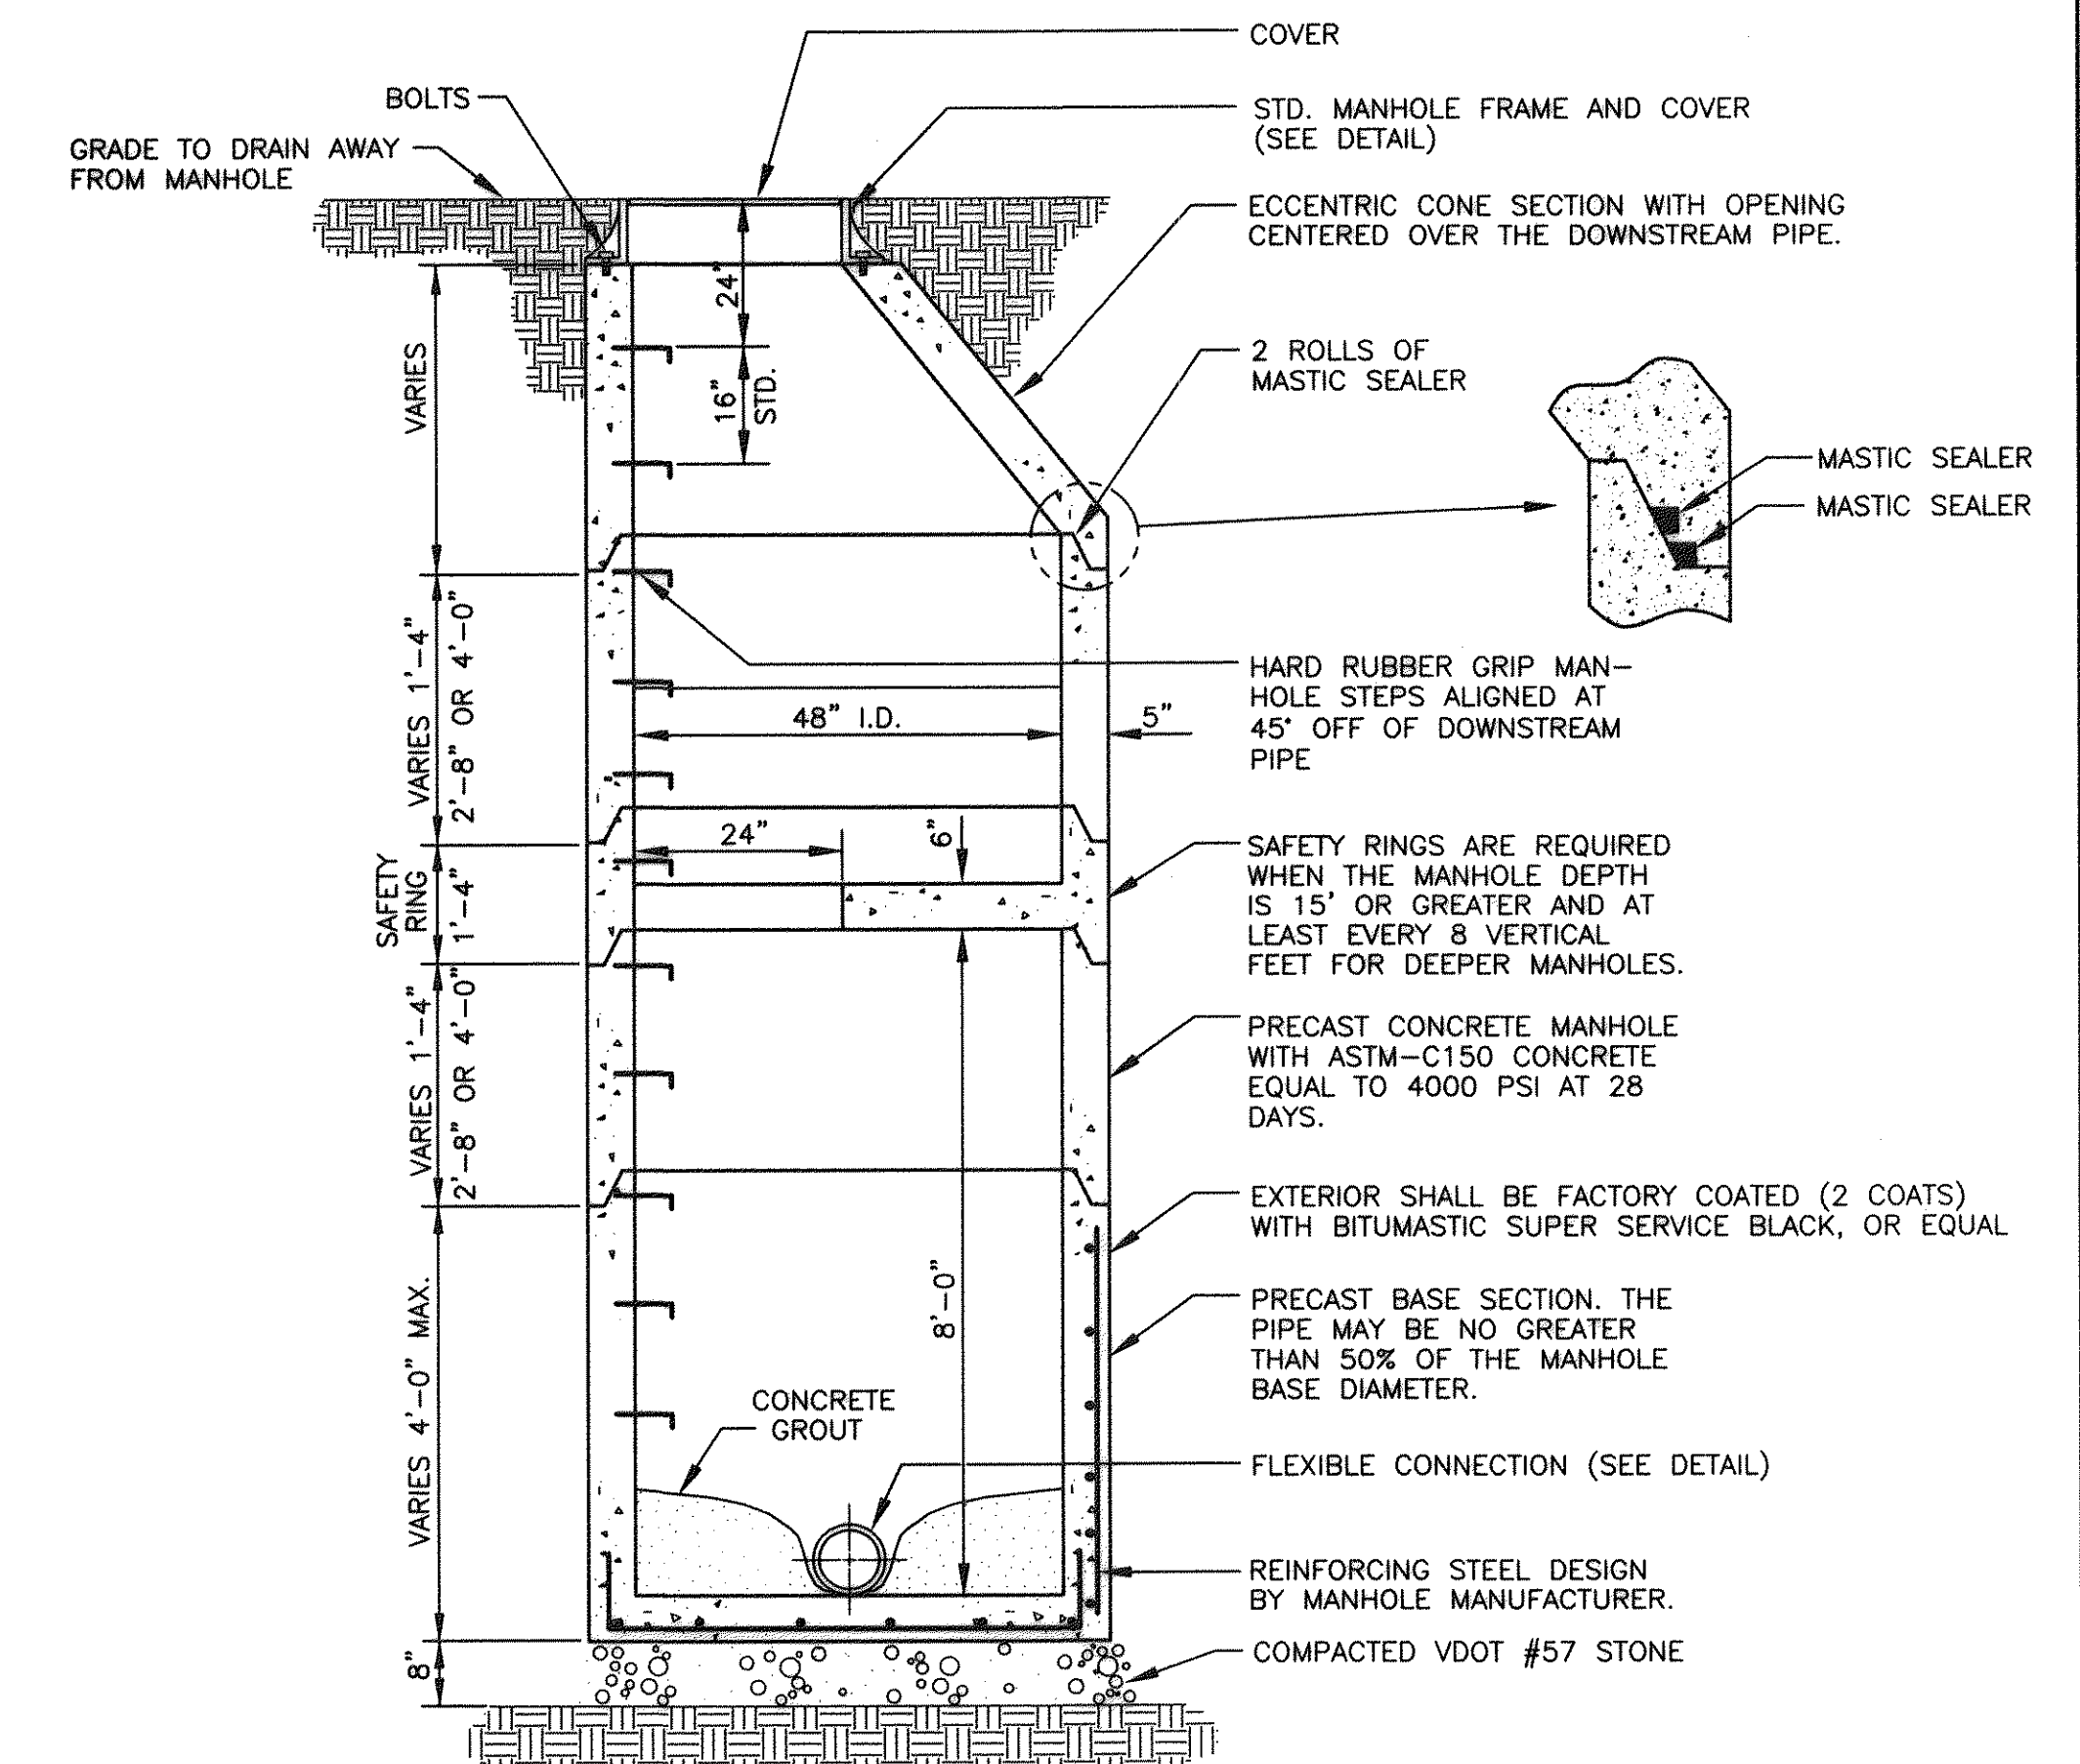

PRECAST ECCENTRIC MANHOLE

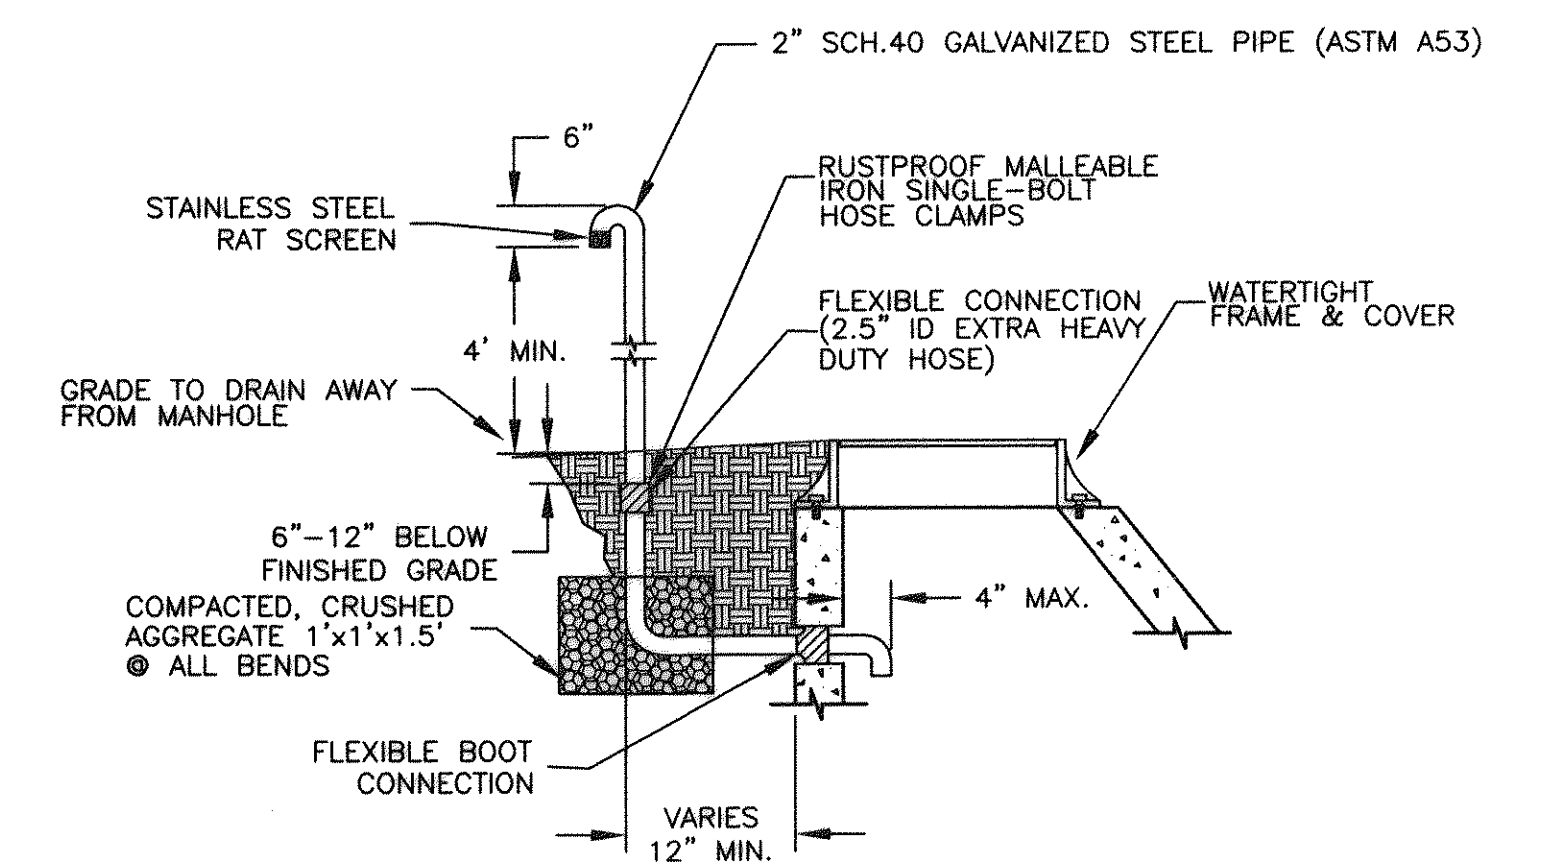

MANHOLE VENT DETAIL

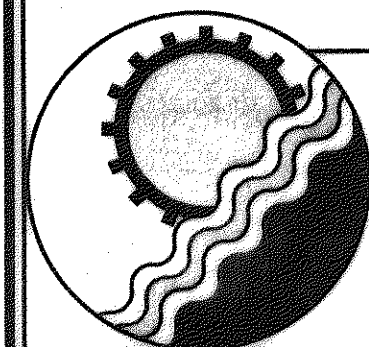

ENGINEERING CONCEPTS, INC.

20 S. ROANOKE ST., PO BOX 619
FINCASTLE, VIRGINIA 24090
540.473.1253 FAX: 540.473.1254

AS-BUILT

| | | | |
|----------|---------|---|----------------|
| Drawn | JHG | GREENFIELD COLLECTOR EXTENSION SANITARY SEWER PROJECT SANITARY SEWER DETAILS | SCALE: NONE |
| Designed | SCG | | MAY 1997 |
| Checked | WPJ/JST | | PROJECT: 97024 |
| Approved | WPJ | | 12 of 16 |