
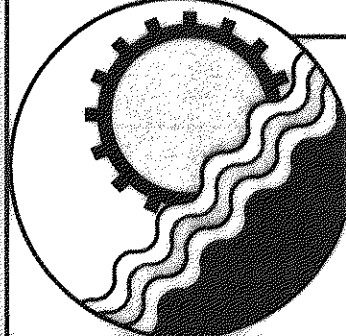
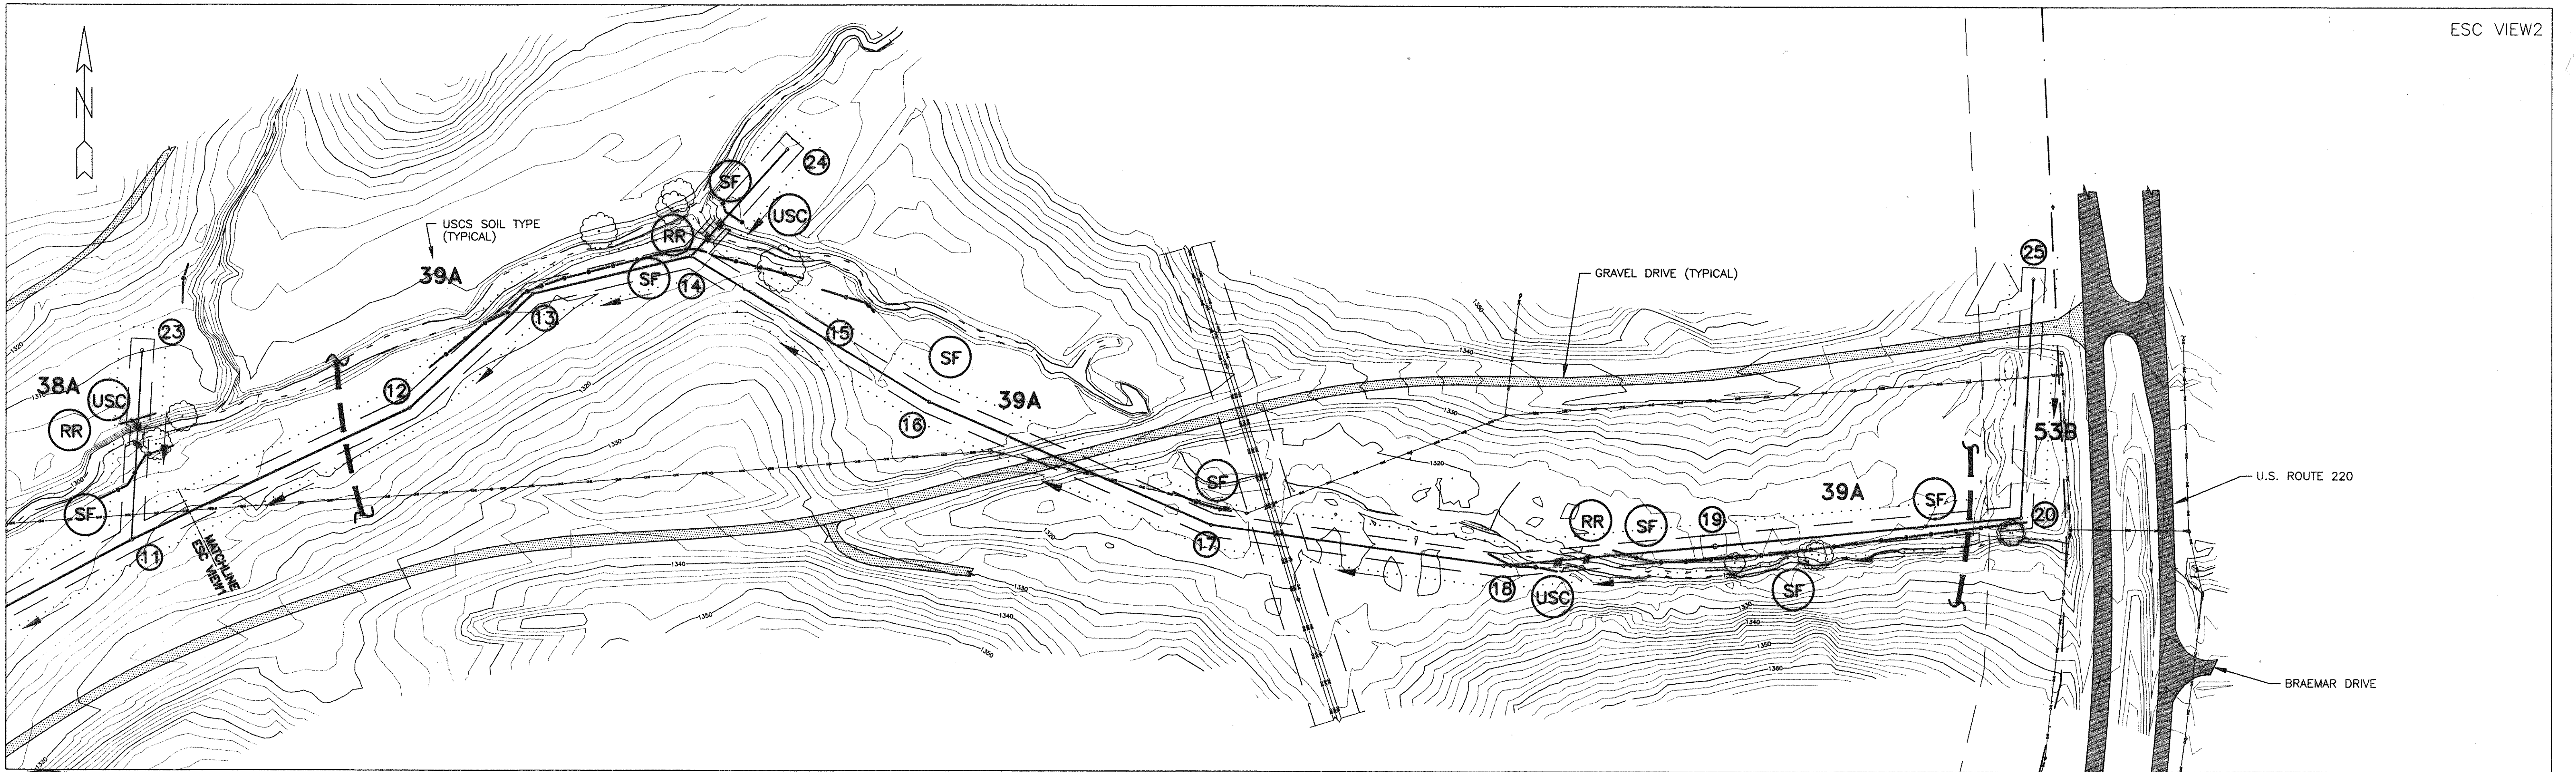


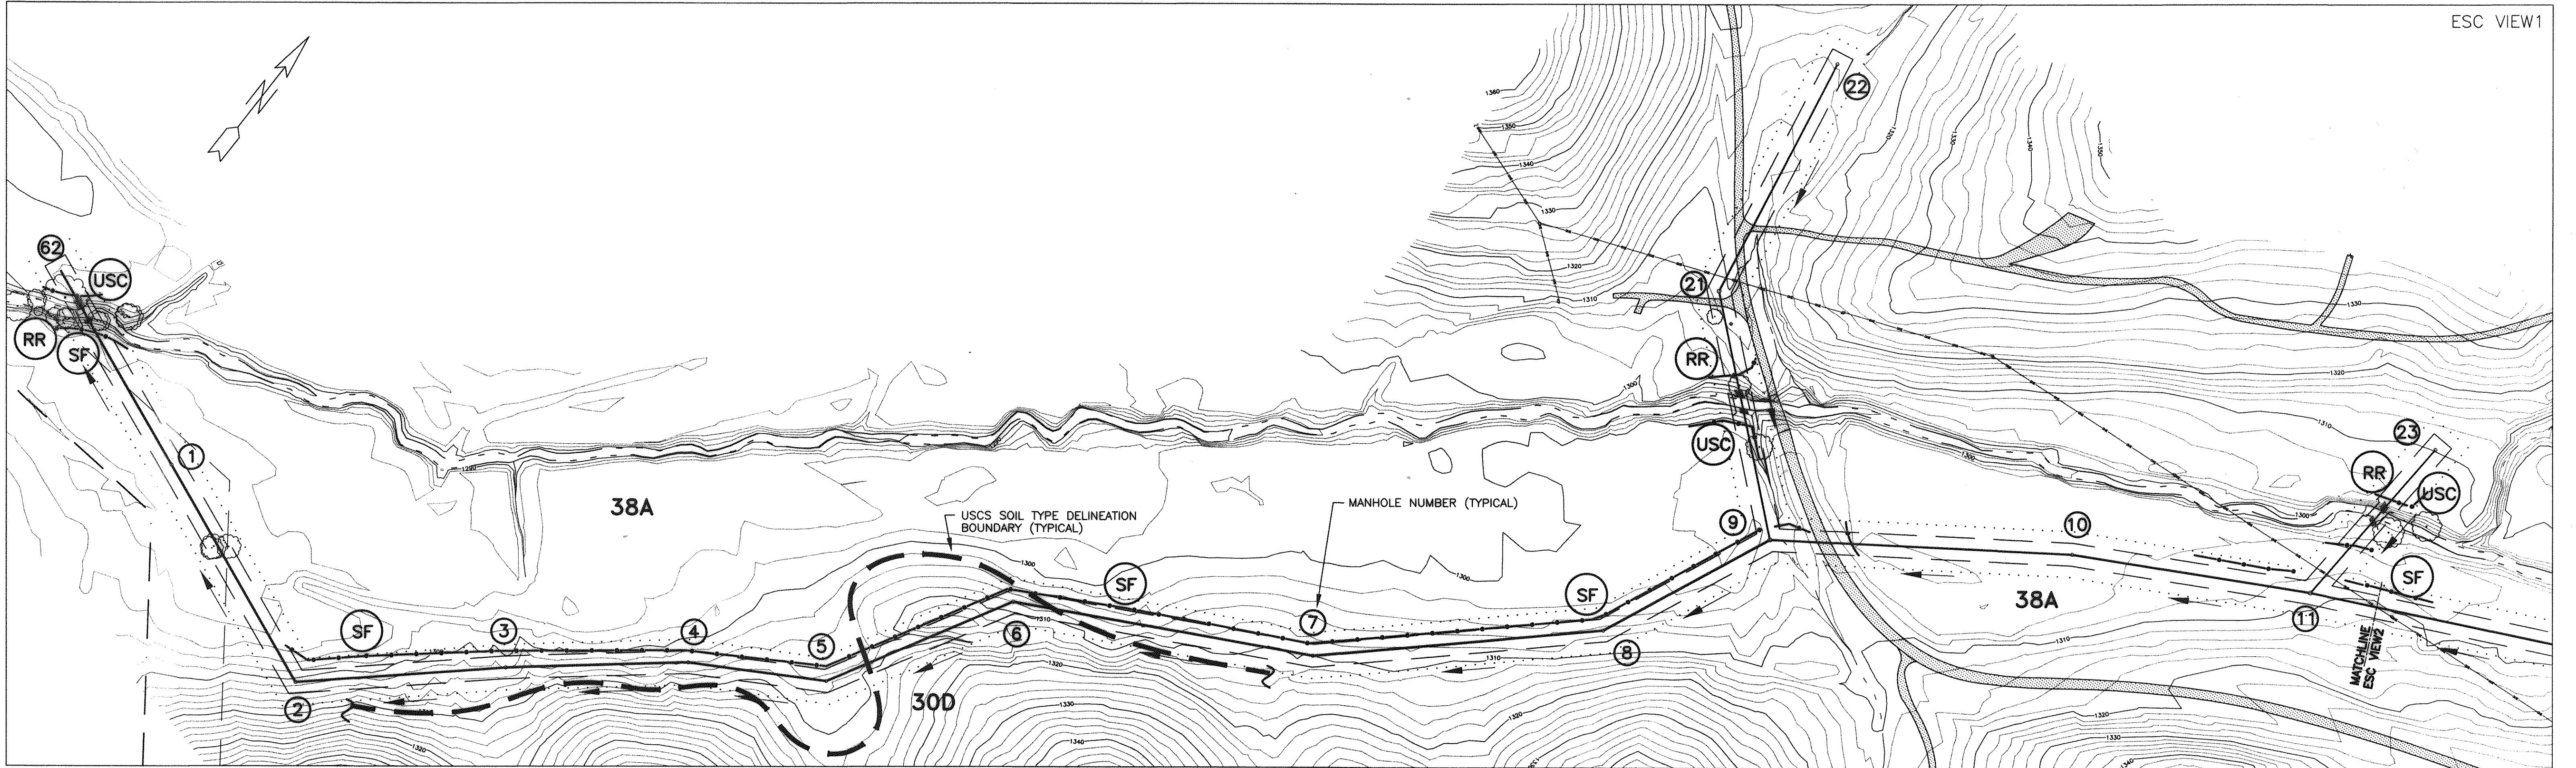

ENGINEERING CONCEPTS, INC.

20 S. ROANOKE ST., PO BOX 619
FINCASTLE, VIRGINIA 24090
540.473.1253 FAX: 540.473.1254

AS-BUILT

Drawn JHG
Designed SCG
Checked WPJ/UST
Approved WPU

**GREENFIELD COLLECTOR EXTENSION
SANITARY SEWER PROJECT**
**EROSION & SEDIMENT
CONTROL PLAN**

1"=100'
MAY 1997
PROJECT: 97024
14 of 16