


GREENFIELD PARKWAY - PHASE 1

(INTERNATIONAL PARKWAY)


BOTETOURT COUNTY DEPARTMENT OF PUBLIC FACILITIES AND PROGRAMS

BOTETOURT COUNTY, VIRGINIA


JUNE 10, 1998

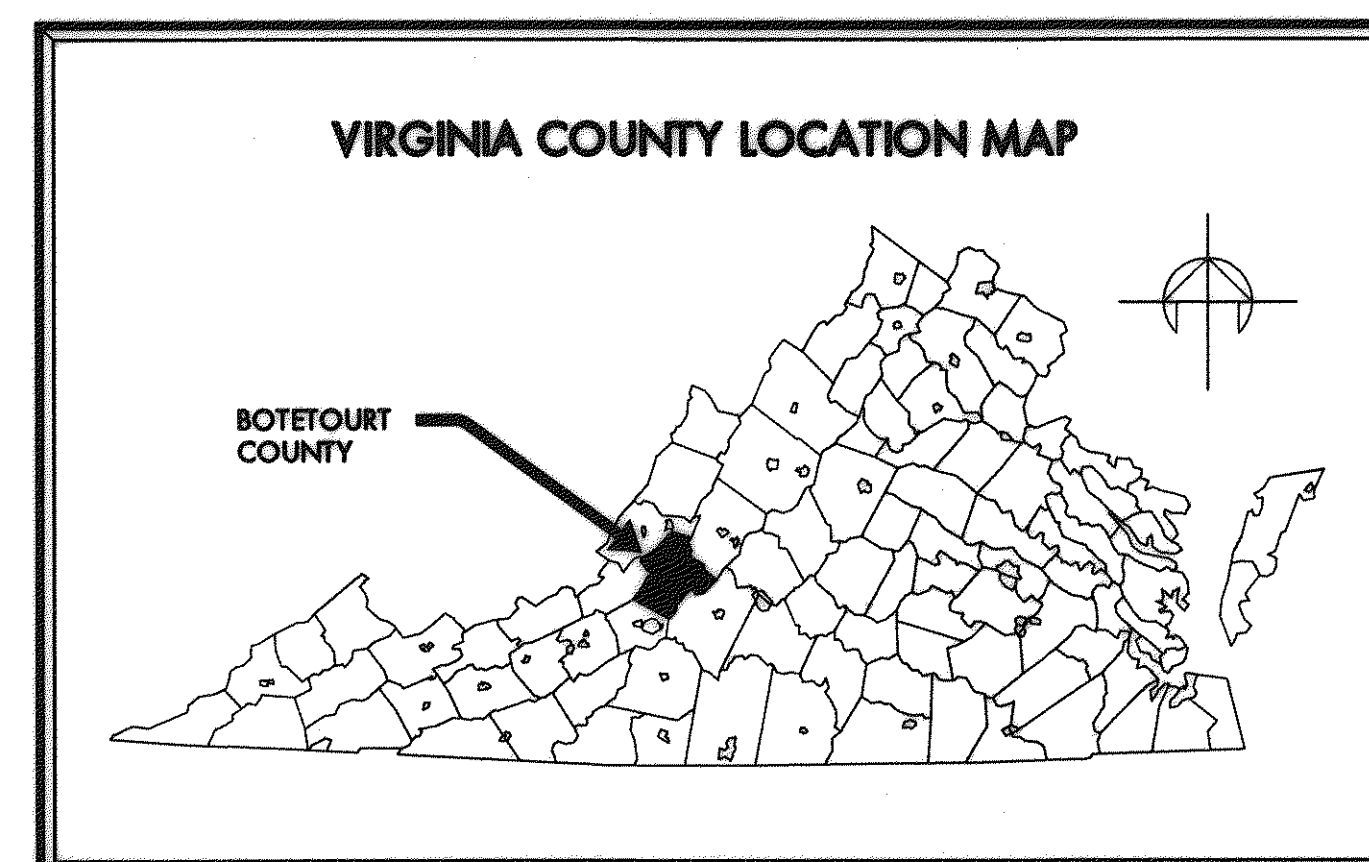

AS-BUILT
FEBRUARY 16, 2000

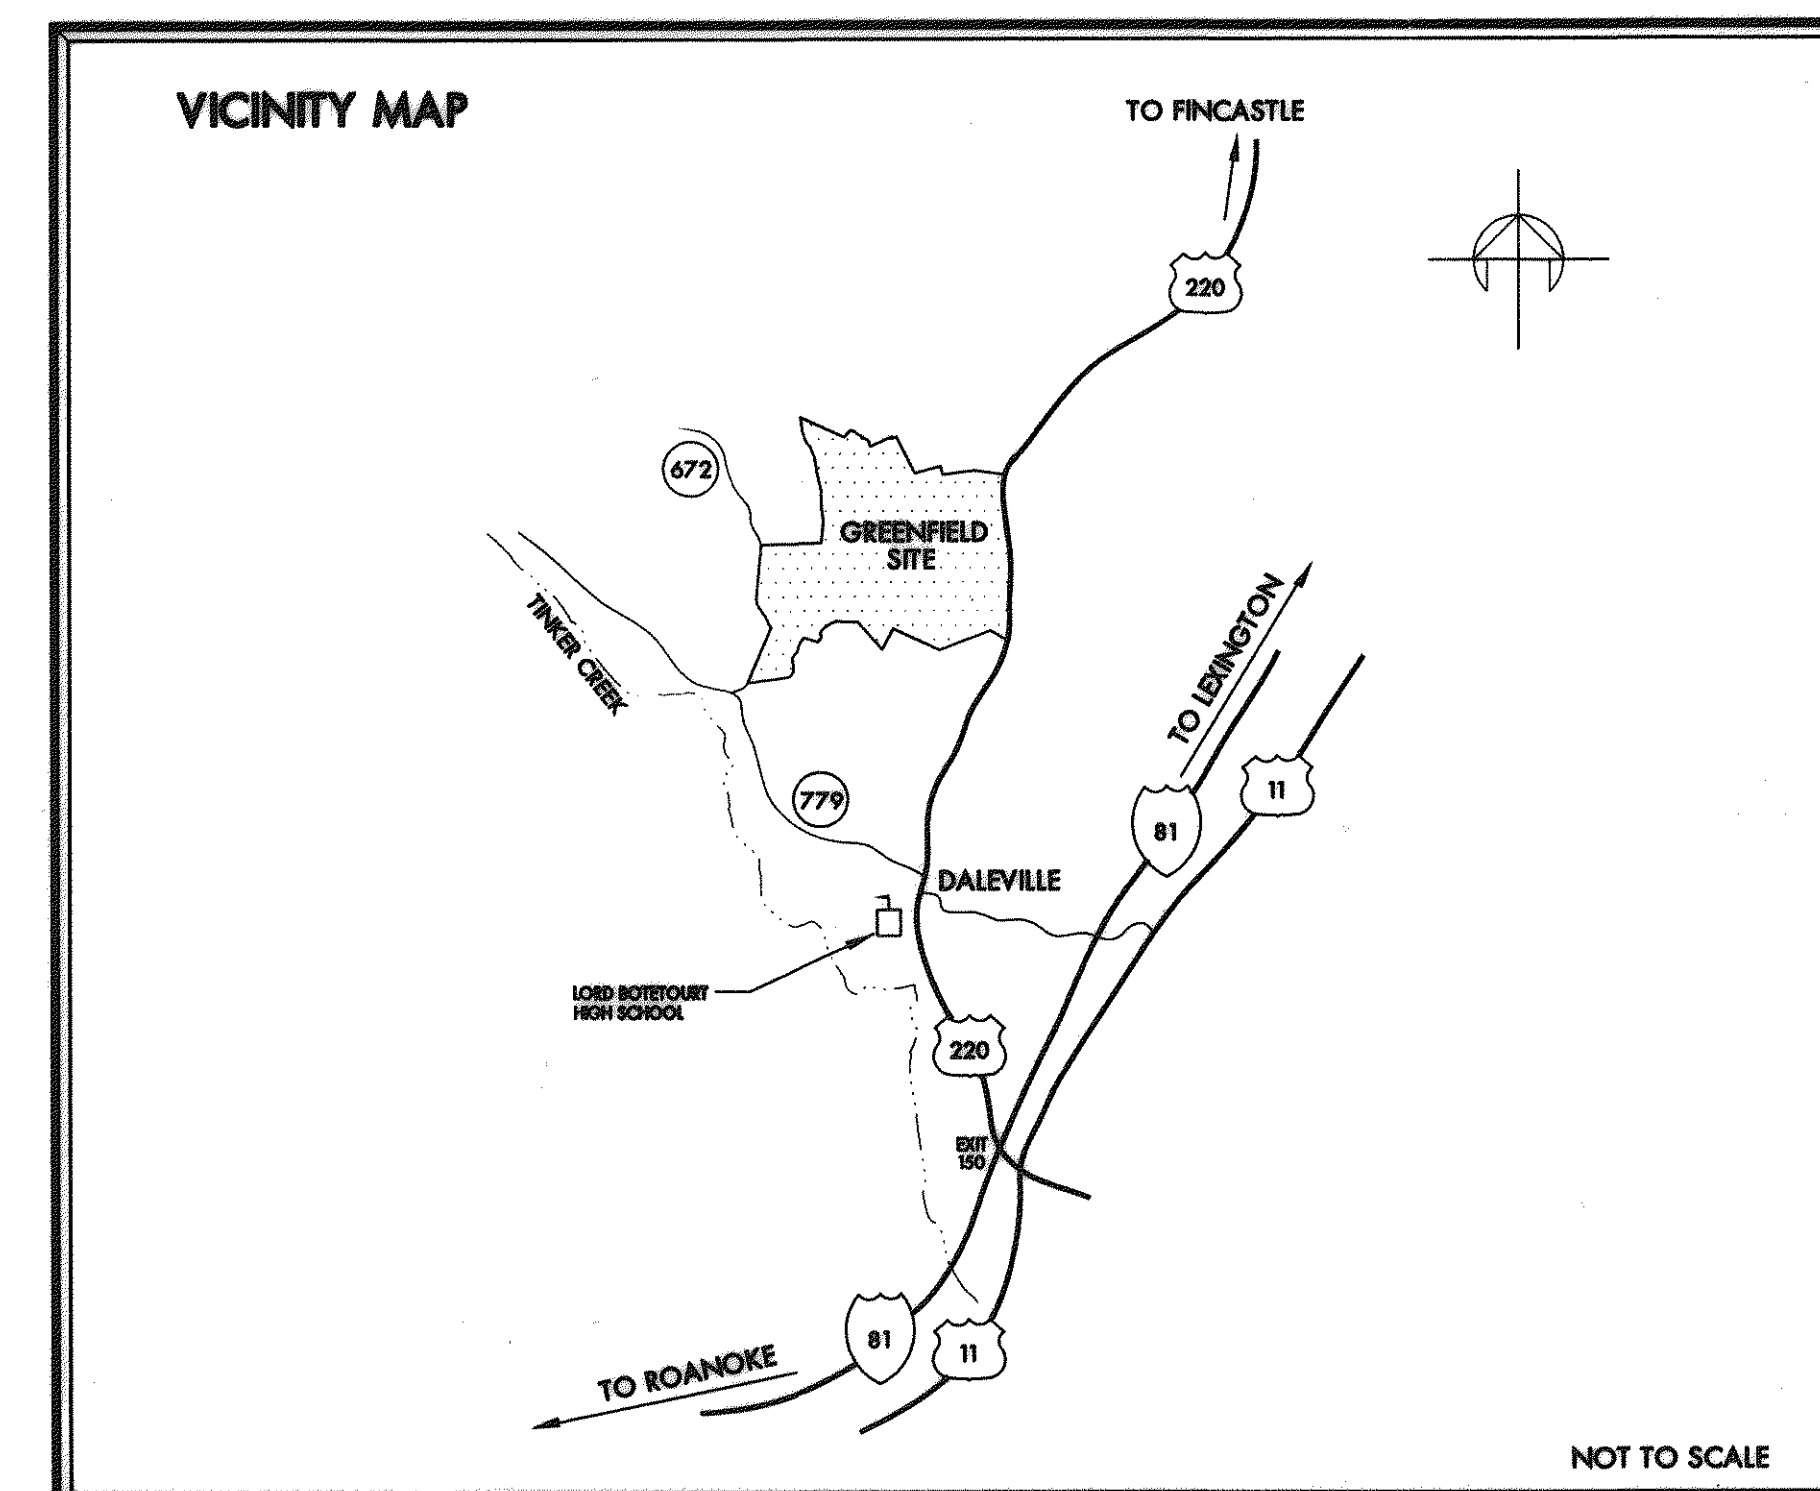

VDOT PROJECT: 0839-011-239, M501
BOTETOURT CENTER AT GREENFIELD INDUSTRIAL ACCESS
DESIGN SPEED = 40MPH
RURAL LOCAL ROAD

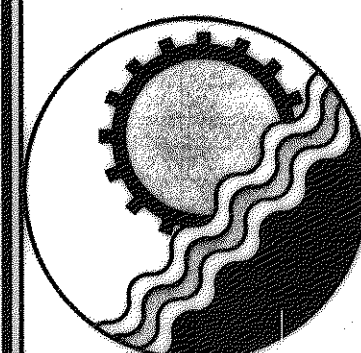


ENGINEERING CONCEPTS, INC.

20 S. ROANOKE ST., PO BOX 619
FINCASTLE, VIRGINIA 24090
540.473.1253 FAX: 540.473.1254

OWNER: BOTETOURT COUNTY

DEPARTMENT OF PUBLIC FACILITIES AND PROGRAMS
1 WEST MAIN ST., BOX 4
FINCASTLE, VIRGINIA 24090
540.473.8316

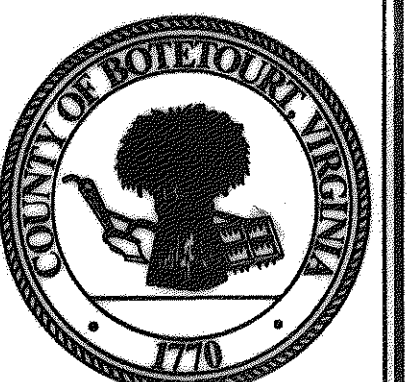

PROJECT NAME:	GREENFIELD Parkway	DATE:	7/98
DATE:	Phase 1	DATE:	7/98
TYPE:	Phase 1	DATE:	7/98
LOCATION:	Greenfield / Daleville	DATE:	7/98
TOTAL # SHEETS:	34	DATE:	7/98
AE FIRM:	ECI	DATE:	7/98
# OF SETS:	1	DATE:	7/98