


VIEW 1

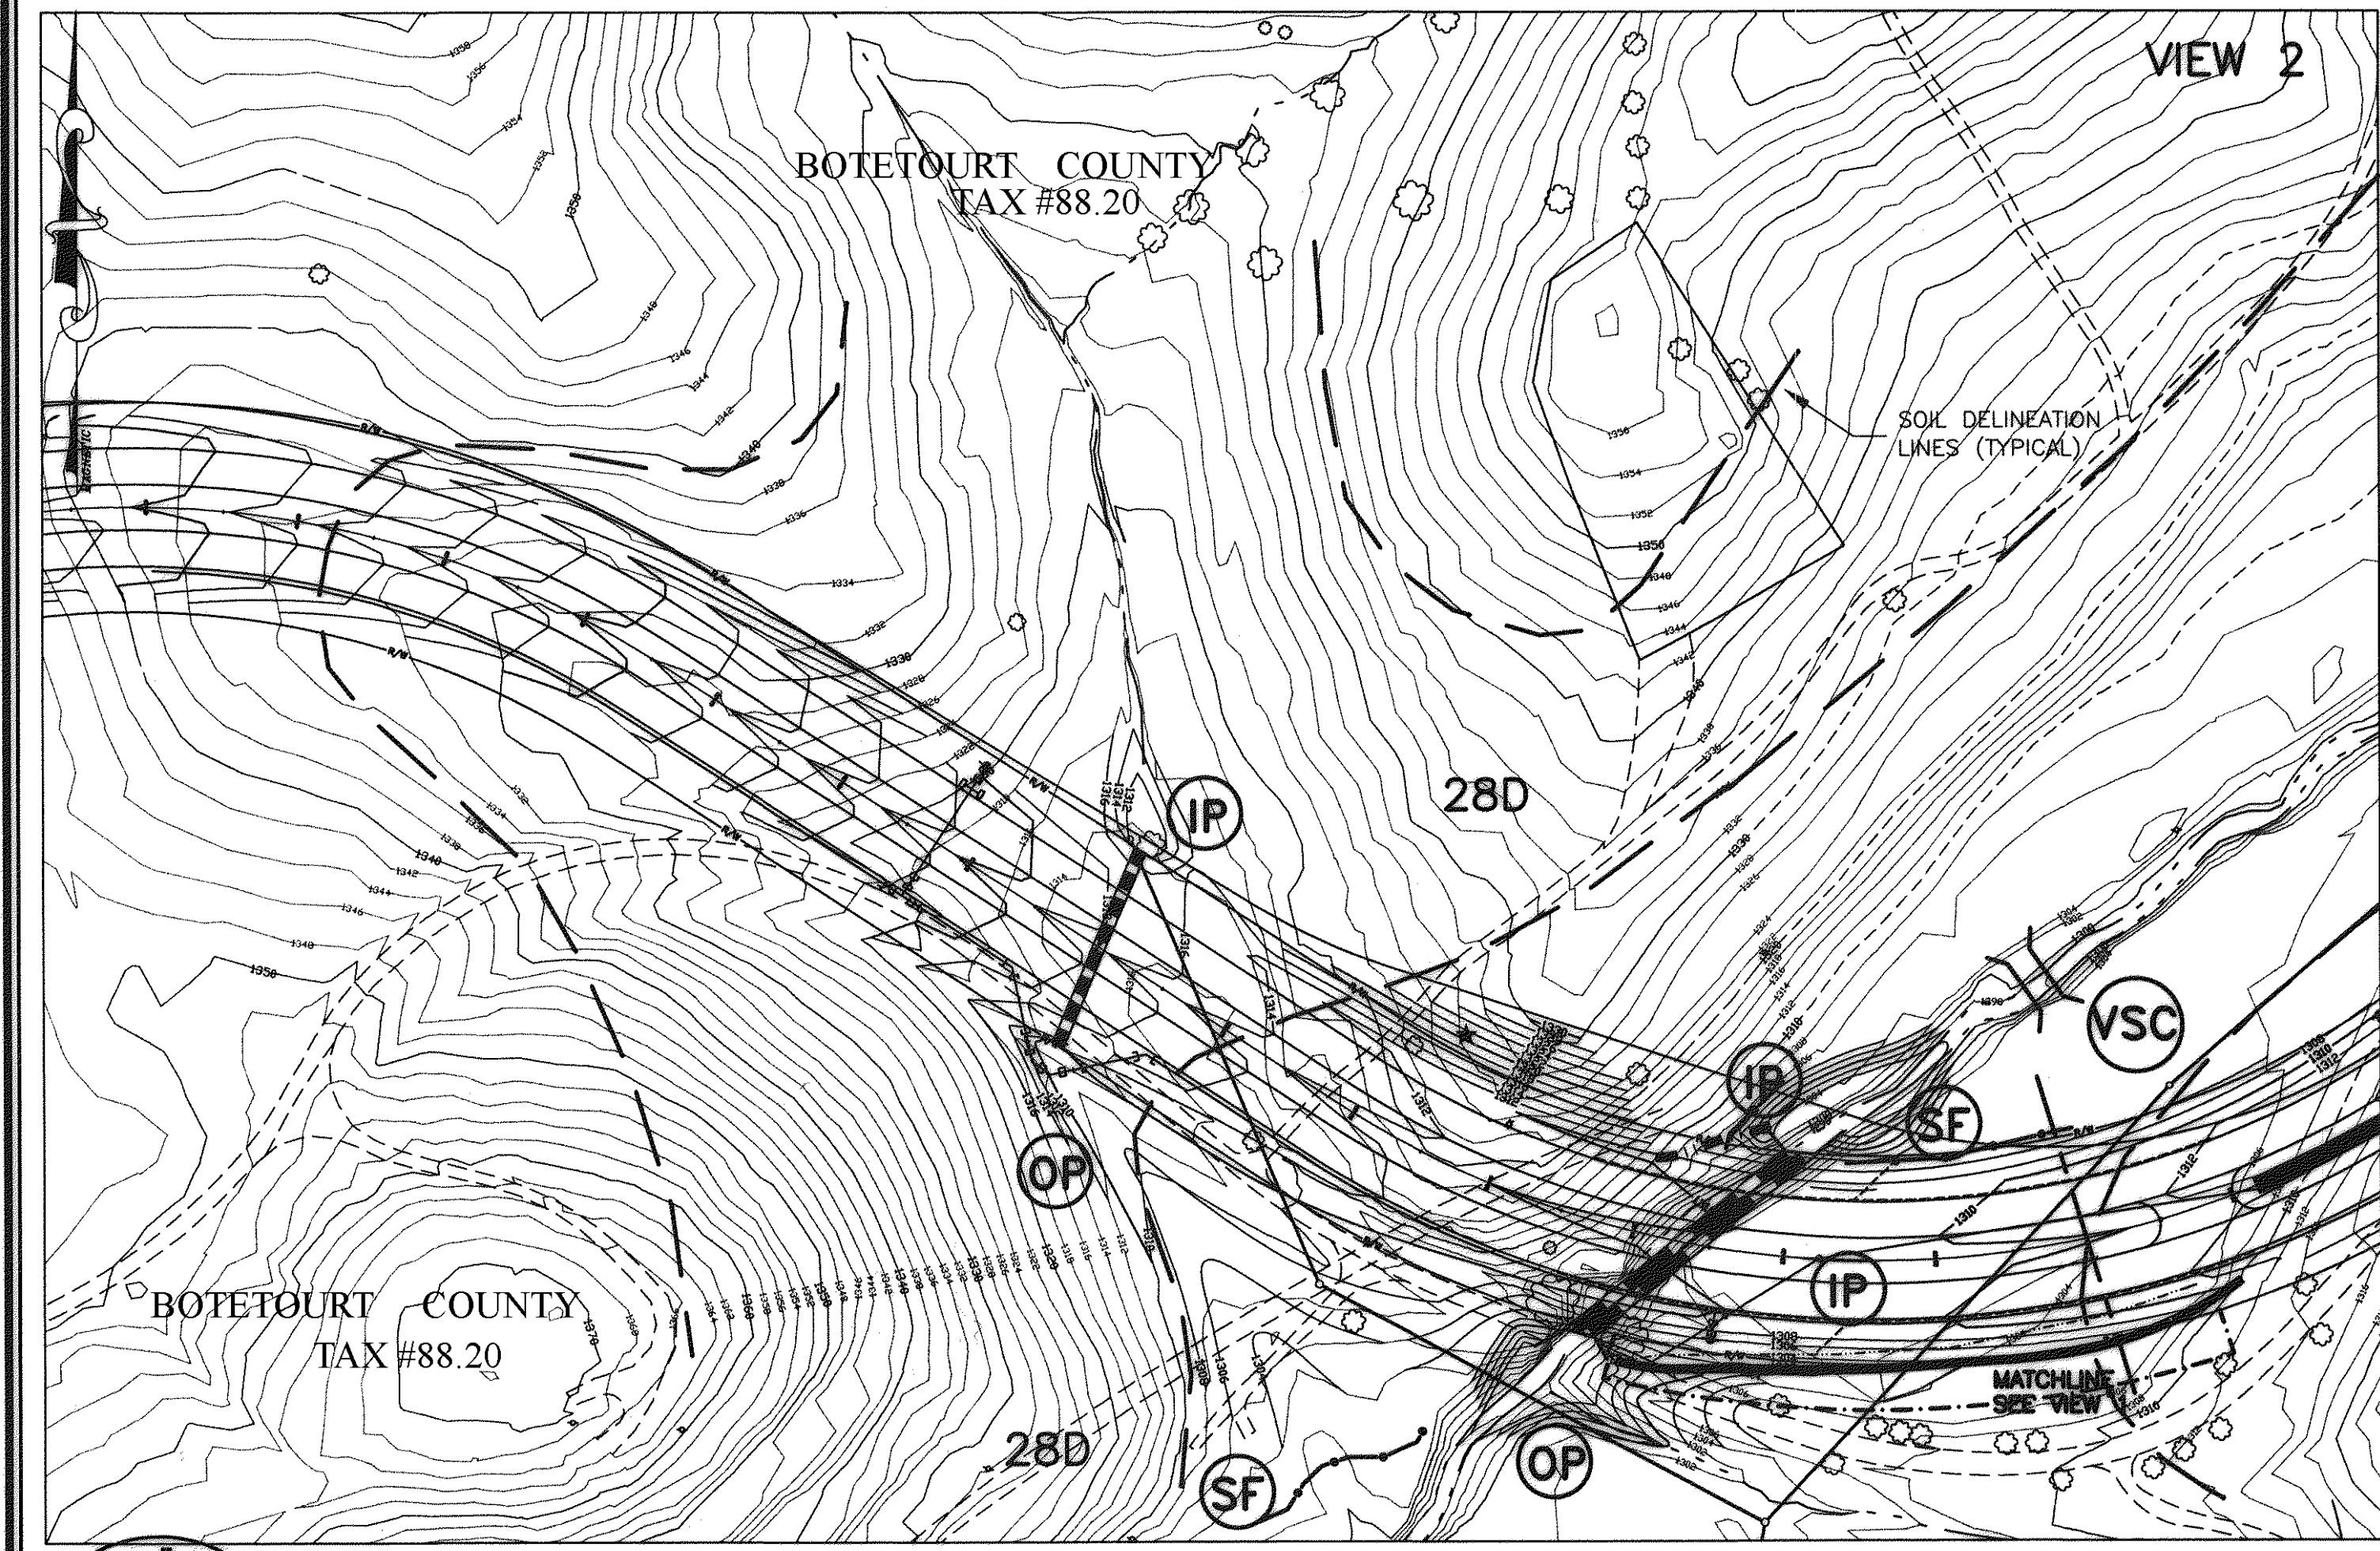

VIEW 2

SEE SHEETS 4 & 5 FOR NARRATIVE AND DETAILS.

ENGINEERING CONCEPTS, INC.
 20 S. ROANOKE ST., PO BOX 619
 FINCASTLE, VIRGINIA 24090
 540.473.1253 FAX: 540.473.1254

THE NAME OF THIS ROAD: INTERNATIONAL PARKWAY
 THE PROPERTY IS OWNED BY BOTETOURT COUNTY - TAX #88.20

AS-BUILT

Drawn	SCG
Designed	SCG
Checked	WPJ
Approved	JST

**GREENFIELD PARKWAY
 PHASE 1
 EROSION & SEDIMENT CONTROL
 PLAN**

1"=100'
NOVEMBER 12, 1997
PROJECT: 97024
3 of 34